

RESOLUTION NO. R-2025-130

A RESOLUTION OF THE CITY COMMISSION OF THE CITY OF HOLLYWOOD FLORIDA, AUTHORIZING THE APPROPRIATE CITY OFFICIALS TO EXECUTE AMENDMENT NUMBER SEVENTEEN TO THE STATE OF FLORIDA DEPARTMENT OF TRANSPORTATION ("FDOT") LANDSCAPE INCLUSIVE MAINTENANCE MEMORANDUM OF AGREEMENT, WITH FDOT FOR MAINTAINING THE LANDSCAPE IMPROVEMENTS ON STATE ROAD A1A FROM THE SOUTHERN CITY LIMITS TO HOLLYWOOD BOULEVARD.

WHEREAS, the City together with the Hollywood Community Redevelopment Agency desire certain additional beautification improvements to State Road A1A to enhance the corridor aesthetic and improve the pedestrian experience; and

WHEREAS, the City will maintain the new landscape and hardscape improvements such as new sidewalks, pavers, asphalt patterned crosswalks and irrigation system; and

WHEREAS, on February 6, 2013, the City Commission passed and adopted Resolution No. R-2013-027, which authorized the execution of a Landscape Inclusive Maintenance Memorandum of Agreement ("MOA") with the Florida Department of Transportation ("FDOT") for the purpose of maintaining the landscape improvements by the City on various roads, including State Road A1A; and

WHEREAS, the MOA has been amended 16 times through various resolutions passed by the City Commission to include additional landscape improvements on various FDOT roads; and

WHEREAS, On September 14, 2021, the City Commission passed and adopted Resolution No. R-2021-234, which authorized the execution of amendment number 10 to the MOA with FDOT for the purpose of maintaining the landscape improvements by the City on State Road A1A from Hollywood Boulevard to Sheridan Street; and

WHEREAS, the Parties propose to again amend the MOU ("Amendment Number 17") to allow the City to construct additional landscape and hardscape improvements or modify an improvement as indicated in Exhibit "A" of the proposed amendment entitled "Landscape Improvements and Maintenance Boundaries," in accordance with the plans indicated in Exhibit "B" of the proposed amendment entitled "Landscape Improvement Plans"; and

WHEREAS, in order to include the modifications to the landscape improvements it is necessary to execute the Proposed Amendment; and

WHEREAS, funding for the landscape and maintenance improvements is available in account number 163.638507.55200.531170.000000.000.000.


NOW, THEREFORE, BE IT RESOLVED BY THE CITY OF HOLLYWOOD, FLORIDA.

Section 1: That the forgoing "WHEREAS" clauses are ratified and confirmed as being true and correct and are incorporated in this Resolution.

Section 2: That it approves and authorizes the execution, by the appropriate City officials, of the attached Amendment Number 17 to the State of Florida Landscape Inclusive Maintenance MOA with FDOT, together with such non-material changes as may be subsequently agreed to by the City Manager and approved as to form by the City Attorney.


Section 3: That this Resolution shall be in full force and effect immediately upon its passage and adoption.

PASSED AND ADOPTED this 16 day of April, 2025.

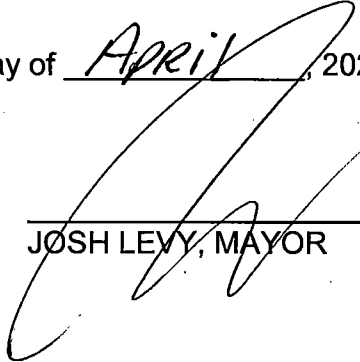


JOSH LEVY, MAYOR

ATTEST:

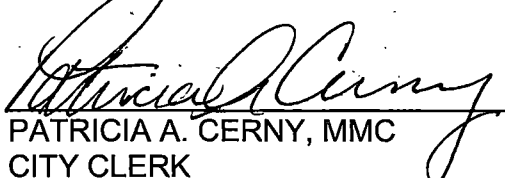

PATRICIA A. CERNY, MMC
CITY CLERK

APPROVED AS TO FORM:

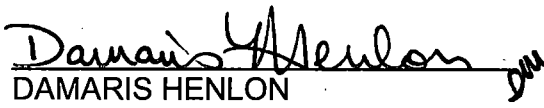

DAMARIS HENLON
INTERIM CITY ATTORNEY

SECTION NO.(s): 86030000
STATE ROAD(s): A1A
PERMIT NO: 2023-L-491-00009
COUNTY: BROWARD

**AMENDMENT NUMBER SEVENTEEN (17) TO
STATE OF FLORIDA DEPARTMENT OF TRANSPORTATION
DISTRICT FOUR (4)
LANDSCAPE INCLUSIVE MEMORANDUM OF AGREEMENT**

THIS AMENDMENT Number Seventeen (17) to the Agreement dated February 26, 2013 made and entered into this _____ day of _____ 2025 by and between the Department of Transportation hereinafter called the DEPARTMENT and the **CITY OF HOLLYWOOD**, a municipal corporation of the State of Florida, hereinafter called the AGENCY.

WITNESSETH

WHEREAS, the parties entered into the Landscape Inclusive Maintenance of Agreement dated, February 26, 2013 ("Original Agreement") for the purpose of maintaining the landscape and hardscape improvements by the AGENCY on various roads including A1A; and,

WHEREAS, the DEPARTMENT and the AGENCY have agreed to have additional landscape and hardscape installed by permit within the City of Hollywood on A1A / So. Ocean Drive in accordance with the above referenced Agreement; and,

NOW THEREFORE, for and in consideration of mutual benefits that flow each to the other, the parties covenant and agree as follows:

1. Per section 8, page 6 of the Original Agreement, the DEPARTMENT will allow THE AGENCY to construct additional landscape and hardscape improvements or to modify an improvement located as indicated in **Exhibit "A"**, on **A1A (South Ocean Drive) from M.P. 0.774 to M.P. 2.615**, in accordance with the plans as attached as **Exhibit "B"**.
2. The AGENCY shall agree to maintain the additional landscape and hardscape improvements described above according to Section I of **Exhibit "C"** Maintenance Plan of the Original Agreement.
3. **SECTION II: SPECIFIC PROJECT SITE MAINTENANCE REQUIREMENTS AND RECOMMENDATIONS**
 - Fallen palm fronds shall be removed from walking surface within 24 hours.
 - Sabal Palms, Thatch Palms, Royal Palms and Date Palms shall be pruned as needed to remove dead and/or damaged fronds only. Healthy green fronds are not to be removed.
 - Do not remove fronds from self-cleaning palms, unless damaged. Palms with persistent fronds shall only have dead fronds removed, do not remove any green fronds. If it is deemed necessary to prune a palm's fronds, no fronds shall be trimmed above 3 o'clock and 9 o'clock on the horizontal plane.
 - Canopy Trees are intended to be maintained mature height of 30' to 35', and a mature spread of 30' to 35'.

SECTION NO.(s): 86030000
STATE ROAD(s): A1A
PERMIT NO: 2023-L-491-00009
COUNTY: BROWARD

- Groundcover and shrub horizontal growth shall be maintained to prevent foliage from growing beyond the limits of the planting areas shown on the plan. Maintain a 12" setback from the foliage to the edge of curb, pavement, sidewalk and/or other hardscape improvements.
 - Groundcover and shrub vertical height shall be maintained as follows:
 - Horizontal Cocoplum - between 18" and 24", (full to ground)
 - Silver Buttonwood - between 24" and 30", (full to ground)
 - Sand Cordgrass - between 24" and 30", (full to ground)
 - Emerald Blanket Natal Plum - between 12" and 18", (full to ground)
 - Golden Creeper - between 12" and 18", (full to ground)
 - Beach Sunflower - between 6 and 12" (full to ground)
 - Evaluate plant material on a quarterly basis for pests, diseases, drought stress or general decline. If required, follow the integrated pest management program established by the Agency to ensure healthy plants.
 - Canopy Trees are intended to be maintained mature height of 30', and a mature spread of 30'.
 - Sidewalk pavers shall be pressure cleaned at once annually.
 - Concrete pavers shall be inspected on a quarterly basis for the aesthetic appearance and safety conditions. Address any issues identified by repairing or replacing those specific locations. To maintain the overall aesthetic appearance and safety of the concrete pavers they shall be cleaned on a yearly basis to prevent mold, dirt, oil, and gum build up. Joints and cracks in concrete, patterned concrete or asphalt, concrete pavers, concrete curbs, expansion joints, catch basins, gutter areas, etc. shall be inspected on a quarterly to keep those areas free of weeds.
 - Concrete Tree Grates shall be inspected on a quarterly basis for the aesthetic appearance and safety conditions. Address any issues identified by repairing or replacing those specific locations. To maintain the overall aesthetic appearance and safety of the tree grates, they shall be cleaned on a yearly basis to prevent mold, dirt, oil, and gum build up.
 - Inspect the irrigation system performance on a quarterly basis to ensure the system is providing 100% coverage, does not have sections of low pressure, heads and valves are clean and clear of debris and any damaged irrigation components (i.e., spray nozzles, spray heads, valve boxes, etc.) are repaired or replaced.
4. Except as modified by this Amendment, all terms and conditions of the original Agreement and all Amendments thereto shall remain in full force and effect.

LIST OF EXHIBITS FOR AMENDMENT #17

Exhibit A - Landscape Improvements and Maintenance Boundaries
Exhibit B - Landscape Improvement Plans
Exhibit C - Resolution

SECTION NO.(s): 86030000
STATE ROAD(s): A1A
PERMIT NO: 2023-L-491-00009
COUNTY: BROWARD

In Witness whereof, the parties hereto have executed with this Amendment effective the day and year written and approved.

CITY OF HOLLYWOOD

a municipal corporation of the State of Florida

Attest:

By: _____
Josh Levy, Mayor

Patricia A. Cerny, MMC
City Clerk

Date: _____

Approved as to Form;

Damaris Henlon,
Interim City Attorney

**STATE OF FLORIDA
DEPARTMENT OF TRANSPORTATION**

By: _____
John P. Krane (or designee)
Director Development Transportation

Date: _____

Attest: _____
Alia Chanel (or designee)
Executive Secretary

Legal Review: _____
Pamela Eidemberg (or designee)
Office of the General Counsel

SECTION NO.(s): 86030000
STATE ROAD(s): A1A
PERMIT NO: 2023-L-491-00009
COUNTY: BROWARD

EXHIBIT A

LANDSCAPE IMPROVEMENTS AND MAINTENANCE BOUNDARIES

**I. INCLUSIVE LIMITS OF MAINTENANCE ON
STATE ROAD A1A (SOUTH OCEAN DRIVE) :**


Section 86030000

(SR 858 / Hallandale Beach Blvd.) M.P. 0.79 to (Dania Beach Blvd.) M.P. 5.380 except; (600' north of SR 858 / Hallandale Beach Blvd.) M.P. 0.90 to (100' north of Diplomat Property) M.P. 1.220 which will continue to be maintained under separate agreement.

II. PERMIT LANDSCAPE MAINTENANCE LIMITS FOR AMENDMENT #17:


A1A (South Ocean Drive) from North of Hallandale Beach Blvd. (M.P.0.774) to South of Hollywood Blvd. (2.615)

**See Attached Map*

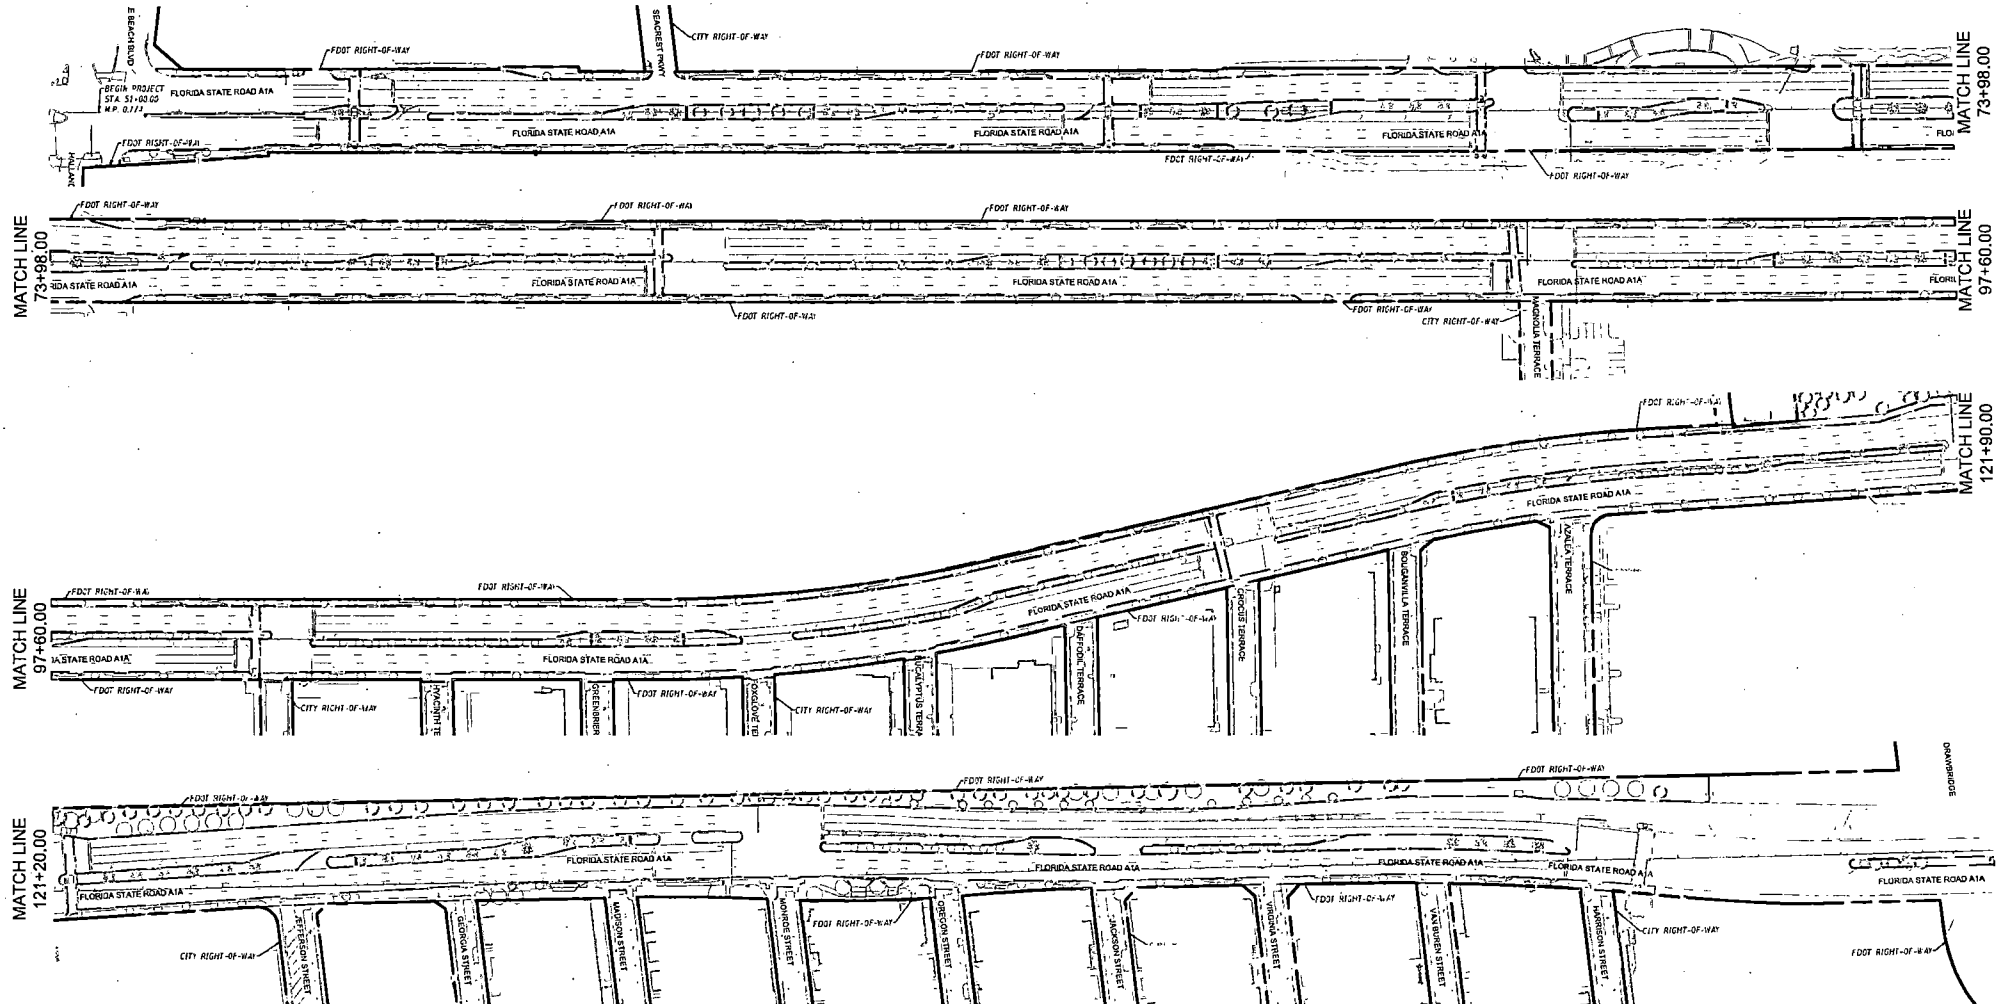

**LIMITS OF MAINTENANCE BY HOLLYWOOD
COMMUNITY REDEVELOPMENT AGENCY (CRA)**

**LANDSCAPE IMPROVEMENTS
MAINTENANCE BOUNDARY MAP**
CITY OF HOLLYWOOD
STATE ROAD A1A
FDOT PERMIT #2023-L-491-00009
(12/06/2024)

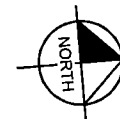

SECTION NO.(s): 86030000
STATE ROAD(s): A1A
PERMIT NO: 2023-L-491-00009
COUNTY: BROWARD

EXHIBIT B

LANDSCAPE IMPROVEMENT PLANS

The AGENCY agrees to install the landscape improvements in accordance with the plans and specifications attached hereto and incorporated herein.

Please see attached plans prepared by: Jonathan D. Haigh, PLA, ASLA
Kimely-Horn and Associates, Inc.
1920 Wekiva Way
West Palm Beach, FL 33411

Dated: December 6, 2024

CITY OF HOLLYWOOD
COMMUNITY REDEVELOPMENT AGENCY (CRA)

CONTRACT PLANS


STATE ROAD NO. A1A
SOUTH OCEAN DR (SR A1A)
FROM NORTH OF HALLANDALE BEACH BLVD
TO
SOUTH OF HOLLYWOOD BLVD
HOLLYWOOD, FL

LANDSCAPE PLANS



INDEX OF LANDSCAPE PLANS

SHEET NO.	SHEET DESCRIPTION
21	LANDSCAPE COVER SHEET
22	FDOT GENERAL NOTES
23 - 41	HARDSCAPE PLANS
42 - 60	FREE-DISPOSITION PLANS- NOT INCLUDED
61 - 78	LANDSCAPE PLANS
79 - 95	IRRIGATION PLANS

PROJECT LIMITS
BEGIN MP: 0.774
END MP: 2.615

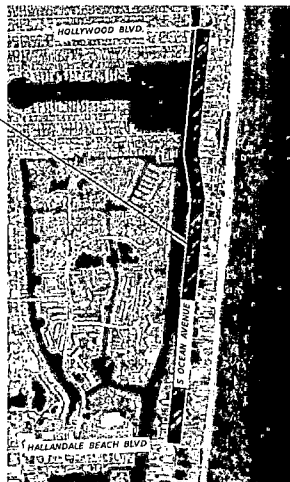

LOCATION OF PROJECT

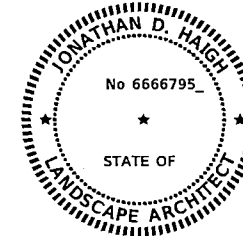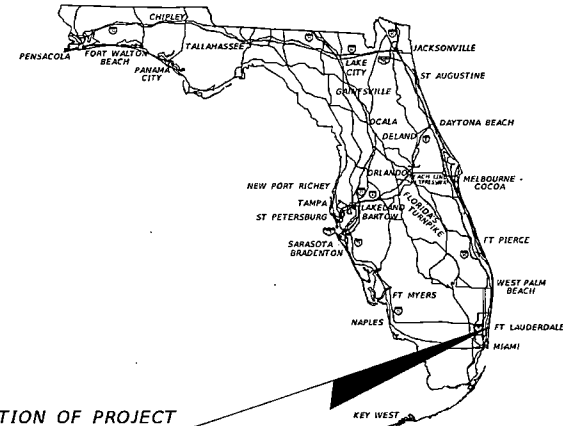

THIS ITEM HAS BEEN DIGITALLY
SIGNED AND SEALED BY

ON THE DATE ADJACENT TO THE SEAL

PRINTED COPIES OF THIS DOCUMENT ARE
NOT CONSIDERED SIGNED AND SEALED
AND THE SIGNATURE MUST BE VERIFIED
ON ANY ELECTRONIC COPIES.

LANDSCAPE PLANS
LANDSCAPE ARCHITECT
OF RECORD:

JONATHAN D. HAIGH, PLA. NO.: 6666795
KIMLEY-HORN AND ASSOCIATES, INC.
CONSULTING LANDSCAPE ARCHITECT
1920 WEKIVA WAY, SUITE 200
WEST PALM BEACH, FL 33411
(561) 845-0665

PERMIT NUMBER: #2023-L-491-00009
SECTION NUMBER: 06170
STATE ROAD: SR-A1A

PLANS REFERENCE 2023 FDOT DESIGN MANUAL, FY 2022-23 STANDARD PLANS

REFER TO APPROVED DESIGN VARIANCE MEMORANDUM (PERMIT #2023-L-491-00009) FOR THE
PROPOSED AND EXISTING ROADSIDE TREES (EXPECTED DIAMETER GREATER THAN 4" AT 6"
ABOVE GROUND LEVEL) WITHIN THE 15' LATERAL OFFSET FROM FACE OF CURB PER FDOT
CHAPTER 215. THE CONVENTIONAL LIGHT POLES WITHIN THE 15' LATERAL OFFSET FROM FACE
OF CURB PER FDOT CHAPTER 215, AND THE EXISTING TREES WITHIN THE LIMITS OF CLEAR
SIGHT TRIANGLE PER FDOT CHAPTER 215.

POSTED SPEED: 35 M.P.H.
DESIGN SPEED: 35 M.P.H.

FDOT PERMIT #2023-L-491-00009

FDOT PERMIT RECORD SET
DECEMBER 2024

MMOA EXHIBIT SET - NOT FOR CONSTRUCTION


KIMLEY-HORN		DATE	BY
1920 WEKIVA WAY, SUITE 200 WEST PALM BEACH, FL 33411 PHONE: 561-845-0665 FAX: 561-845-0675 WWW.KIMLEY-HORN.COM			
LANDSCAPE COVER SHEET		REVISIONS	
PHASE IV SR A1A UNDERGROUNDING OF OVERHEAD UTILITIES AND STREETSCAPE BEAUTIFICATION PREPARED FOR HOLLYWOOD CRA		No.	
HOLLYWOOD FL		DATE	
SHEET NUMBER 21			

THE OFFICIAL RECORD OF THIS SHEET IS THE ELECTRONIC FILE DIGITALLY SIGNED AND SEALED UNDER RULE 61G10-11.011, F.A.C.

1. ANY PLANT MATERIAL SUBSTITUTION WITHIN OR IMPACTING THE FDOT RIGHT-OF-WAY WHETHER REQUESTED BY THE CONTRACTOR, OWNER, LANDSCAPE ARCHITECT OR OTHER WILL NEED TO GET APPROVAL FROM THE FDOT DISTRICT LANDSCAPE ARCHITECT.
2. PATTERNED PAVEMENT INSTALLATION SHALL COMPLY WITH CURRENT FDOT STANDARD SPECIFICATION 523. FRICTION TESTING WILL BE REQUIRED AT INTERVALS IN ACCORDANCE WITH FDOT FM 5-592, ASTM E274, OR ASTM E1911. ALL COSTS FOR FRICTION TESTING WITHIN TRAVEL WAY ARE THE RESPONSIBILITY OF THE AGENCY.
3. CONTRACTOR SHALL REPAIR ANY AND ALL DAMAGE DONE TO FDOT PROPERTY DURING DEMOLITION, RELOCATION AND/OR INSTALLATION ACTIVITIES AT HIS SOLE EXPENSE.
4. OWNERSHIP OF ALL SUITABLE EXCAVATED MATERIALS, AS DETERMINED BY THE DEPARTMENT, SHALL REMAIN IN THE DEPARTMENT UNTIL A FINAL ACCEPTANCE OF THE PERMITTED PROJECT IS FULFILLED. EXCAVATED MATERIALS SHALL BE HAULED BY THE PERMITTEE, AT THEIR COST AND EXPENSE FROM THE SITE TO THE BROWARD OPERATIONS CENTER OR STOCKPILED IN THOSE AREAS AS DIRECTED BY THE DEPARTMENT, INCLUDING ASPHALT MILLINGS.
5. PERMITTEE WILL RESTORE THE RIGHT OF WAY AS A MINIMUM, TO ITS ORIGINAL CONDITION OR BETTER IN ACCORDANCE WITH FDOT LATEST STANDARD SPECIFICATION FOR ROAD AND BRIDGE CONSTRUCTION OR AS DIRECTED BY THE RESIDENT OPERATIONS ENGINEER.
6. RESTRICTED HOURS OF OPERATION FOR LANE CLOSURES WILL BE FROM 9:00 AM TO 3:30 PM, (MONDAY-FRIDAY), UNLESS OTHERWISE APPROVED BY THE OPERATIONS ENGINEER, OR DESIGNEE.
7. PERMITTEE WILL COORDINATE (I.E. PRE-CONSTRUCTION MEETINGS, INSPECTIONS, FINAL ACCEPTANCE OF WORK, ETC.) WITH FDOT BROWARD OPERATIONS CENTER PERMITTING DEPARTMENT. COORDINATION WILL INCLUDE PRE-CONSTRUCTION, CERTIFICATION ACCEPTANCE AND FINAL APPROVAL IS CONTINGENT UPON CONFORMITY OF ALL WORK COMPLETED ACCORDING TO THIS PERMIT AND THE RESTORATION OF THE RIGHT OF WAY.
8. ALL MATERIALS AND CONSTRUCTION WITHIN THE FLORIDA DEPARTMENT OF TRANSPORTATION DESIGN (FDOT) RIGHT-OF-WAY SHALL CONFORM TO THE "LATEST VERSION OF FDOT STANDARD PLANS FOR ROADS AND BRIDGE CONSTRUCTION AND LATEST VERSION OF THE STANDARD SPECIFICATIONS FOR ROAD AND BRIDGE CONSTRUCTION.
9. ALL MAINTENANCE OF TRAFFIC M.O.T. FOR THIS PROJECT WILL BE IN COMPLIANCE WITH THE DEPARTMENTS CURRENT EDITION OF THE FDOT STANDARD PLANS FOR ROAD AND BRIDGE CONSTRUCTION INDICES, (102-600 SERIES) AND THE LATEST EDITION OF THE MANUAL ON UNIFORM TRAFFIC CONTROL DEVICES (MUTCD). THE OPERATIONS ENGINEER OR HIS DESIGNEE RESERVES THE RIGHT TO DIRECT THE REMOVAL/RELOCATION/MODIFICATION OF ANY TRAFFIC DEVICE(S) AT THE PERMITTEE'S SOLE EXPENSE. SPECIAL ATTENTION WILL BE GIVE TO INDICES 102-611, 102-612, 102-613, 102-614, 102-615, 102-616, AND 102-660.
10. IT IS THE PERMITTEE'S RESPONSIBILITY TO OBTAIN FINAL ACCEPTANCE OF PERMITTED WORK (COMPLETED) AND THE RESTORATION OF THE RIGHT-OF-WAY FROM THE FDOT PRIOR TO USAGE.
11. GOVERNING STANDARD PLANS
FLORIDA DEPARTMENT OF TRANSPORTATION, FY 2023-24 STANDARD PLANS FOR ROAD AND BRIDGE CONSTRUCTION AND APPLICABLE INTERIM REVISIONS (IRs) ARE AVAILABLE AT THE FOLLOWING WEBSITE:
[HTTPS://WWW.FDOT.GOV/DESIGN/STANDARDPLANS](https://www.fdot.gov/design/standardplans)
12. GOVERNING STANDARD SPECIFICATIONS
FLORIDA DEPARTMENT OF TRANSPORTATION, FY 2023-24 STANDARD SPECIFICATIONS FOR ROAD AND BRIDGE CONSTRUCTION AT THE FOLLOWING WEBSITE:
[HTTPS://WWW.FDOT.GOV/PROGRAMMANAGEMENT/IMPLEMENTED/SPECBOOKS](https://www.fdot.gov/programmanagement/implemented/specbooks)
13. ARCHITECTURAL PAVERS INSTALLATION FOR SIDEWALKS, MEDIANS, DRIVEWAYS, OR ROADWAYS WITHIN THE FDOT RIGHT OF WAY SHALL COMPLY WITH CURRENT FDOT STANDARD SPECIFICATION 526 ONLINE REFERENCE:
[HTTPS://FDOT.WV.BLOG.CORES.WINDOWS.NET/SITEFINITY/DOCS/DEFAULT-SOURCE/PROGRAMMANAGEMENT/IMPLEMENTED/SPECBOOKS/FY-2023-24/FY2023-24FEB00K.PDF?SFVRSN=6B69941D_6](https://fdot.wv.blog.cores.windows.net/sitefinity/docs/default-source/programmanagement/implemented/specbooks/fy-2023-24/fy2023-24feb00k.pdf?sfvrsn=6b69941d_6)


1. FDOT REQUIRES 24-HOUR EMERGENCY ACCESS TO WATER SOURCE.
2. CONTRACTOR SHALL PROVIDE FDOT DISTRICT OPERATIONS MANAGER WITH A SET OF "AS-BUILT" IRRIGATION PLANS.
3. CUTTING/PATCHING THE ROADWAY SURFACE IS PROHIBITED AS A PART OF THE SCOPE OF THIS PROJECT.
4. PERMITTEE'S REPRESENTATIVE & AN FDOT INSPECTOR MUST BE ON SITE DURING ALL BORING ACTIVITIES. UPON COMPLETION OF THE BORING ACTIVITIES, PERMITTEE SHALL PROVIDE ALL DOCUMENTATION TO BE IN ACCORDANCE WITH FDOT STANDARD SPECIFICATIONS, SECTION 555 OR 556, WHICHEVER IS APPLICABLE.
5. PERMITTEE'S CONTRACTORS THAT ARE PERFORMING DIRECTIONAL DRILLING AND/OR JACK AND BORE ACTIVITIES SHALL PROVIDE THE DEPARTMENT (PERMITS OFFICE) PROOF OF A PROPER STATE CONTRACTOR'S LICENSE AND CERTIFICATE OF LIABILITY INSURANCE PRIOR TO ANY COMMENCEMENT OF PERMITTED WORK.
6. PERMITTEE WILL ENSURE THAT ALL LOCATES HAVE BEEN PERFORMED PRIOR TO SCHEDULING OF ANY BORING ACTIVITIES. THIS SHALL INCLUDE SOFT DIGS TO VERIFY VERTICAL & HORIZONTAL ALIGNMENT.
7. SLEEVING MUST BE 36" BELOW THE ROADWAY, VERIFY WITH FDOT MAINTENANCE THAT SLEEVING/DIRECTIONAL BORE IS PERMITTED AT THIS TIME. A NEWLY RESURFACED ROAD CANNOT BE DISTURBED FOR 5 YEARS.

1. FOR THE PORTION OF LANDSCAPE PLANT MATERIAL THAT WILL BE INSTALLED WITHIN THE FOOT RIGHT OF WAY REFER TO THE LANDSCAPE INSTALLATION SHALL COMPLY WITH CURRENT APPLICABLE FOOT MAINTENANCE SPECIFICATION NO. ONLINE REFERENCE:
SSMS00000WD-722-17992.PDF(WINDOWS.NET)
2. FOR THE PORTION OF LANDSCAPE PLANT MATERIAL THAT WILL BE INSTALLED WITHIN THE FOOT RIGHT OF WAY REFER TO THE FOOT STANDARD PLANS INDEX 580-001 LANDSCAPE INSTALLATION.
ONLINE REFERENCE:
HTTPS://FOOTWWW.BLOB.CORE.WINDOWS.NET/SITEFINITY/DOCS/DEFAULT-SOURCE/DESIGN/STANDARDPLANS/2023/10X/580-001.PDF?
3. CYPRESS MULCH IS NOT PERMITTED ON FOOT RIGHT OF WAY. HULCH PERMITTED TO BE USED ARE HARDWOOD MULCH (CONTAINING NO CYPRESS PRODUCTS), RECYCLED MULCH OR APPROVED EQUAL, CERTIFIED BY THE MULCH AND SOIL COUNCIL (MSC). SUBMIT PROOF OF CERTIFICATION TO THE FOOT DISTRICT OPERATIONS PERMIT LANDSCAPE INSPECTOR UPON INSPECTION.
4. IT IS RECOMMENDED TO VERIFY THE EXISTING SOIL CONDITIONS FOR THE MEDIANS TO BE PLANTED PRIOR TO FINALIZING THE CONSTRUCTION DOCUMENTS. IF THE EXISTING SUB-GRADE IS COMPACTED ROAD BASE, IT IS RECOMMENDED TO SPECIFY REPLACING WITH PLANTING SOIL AS FOLLOWS:
 - a. CONTRACTOR SHALL PRESERVE A CONTINUOUS BAND OF UNDISTURBED COMPACTED SUB-BASE 18" FROM THE BACK OF CURB (SEE DETAIL BELOW).
 - b. THE CONTRACTOR SHALL INSURE THAT ALL UNSUITABLE SOIL INCLUDING CONCRETE, PAVEMENT, ROAD BASE, STONES OVER 3" DIAMETER AND ALL CONSTRUCTION DEBRIS, IS REMOVED FROM MEDIAN AREA TO BE PLANTED AND REPLACED WITH SPECIFIED PLANTING SOIL, E.G., 60% SAND AND 40% MUCK.
 - c. AREAS TO BE PLANTED WITH SHRUBS AND/ OR GROUND COVERS: REMOVE COMPACTED SOIL TO A DEPTH OF 12" AND REPLACE WITH SPECIFIED PLANTING SOIL. PLANTING SOIL SHALL COME UP TO 4" FROM TOP OF CURB, RESERVING SPACE FOR 3" COMPACTED MULCH AND 1" CLEAR FROM TOP OF CURB.
 - d. PLANTING PITS FOR TREES AND PALMS: REMOVE COMPACTED SOIL WITHIN THE AREA OF EACH PLANTING PIT TO A DEPTH OF 24" FROM THE TOP OF CURB. PLANTING SOIL SHALL COME UP TO 4" FROM TOP OF CURB. RESERVING SPACE FOR 3" COMPACTED MULCH, AND 1" CLEAR FROM TOP OF CURB.

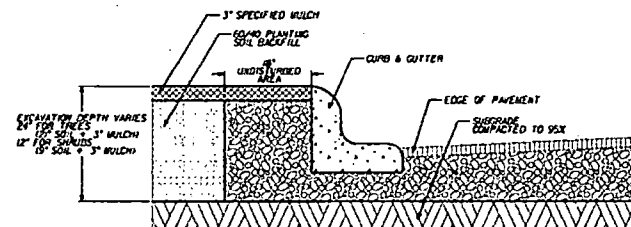


8. THE IRRIGATION SYSTEM SHALL USE THE LOWEST QUALITY WATER AVAILABLE WHICH ADEQUATELY AND SAFELY MEETS THE WATER NEEDS OF THE SYSTEM. STORM WATER, RECLAIM WATER, OR GREY WATER IRRIGATION SHALL BE USED WHENEVER POSSIBLE.
9. THE CONTRACTOR SHALL PROVIDE FDOT DISTRICT OPERATIONS MANAGER WITH A SET OF "AS-BUILT" IRRIGATION PLANS.
10. SHOULD THE EXISTING IRRIGATION SYSTEM NOT BE FUNCTIONAL FOR A PERIOD OF TIME DURING CONSTRUCTION, ENSURE THAT MEASURES ARE TAKEN TO WATER THE EXISTING PLANT MATERIAL AND SOIL. THIS MAY INCLUDE PORTIONS OF THE RIGHT OF WAY OUTSIDE OF THE RENOVATION AREA DEPENDING HOW THE SYSTEM IS ZONED.
11. 100% COVERAGE MUST BE ACHIEVED WITHIN THE RIGHT OF WAY WHERE IRRIGATION MODIFICATIONS OCCUR.
12. TO ENSURE THE ENTIRE EXISTING IRRIGATION SYSTEM IS RESTORED TO FULLY FUNCTIONAL CONDITION, THE CONTRACTOR AND MAINTAINING AGENCY ARE TO PERFORM A PRE-CONSTRUCTION VISUAL INSPECTION AND PERFORMANCE TEST TO DOCUMENT THE CONDITION OF THE EXISTING SYSTEM, ANY REPAIRS THAT ARE REQUIRED TO THE EXISTING SYSTEM TO REMAIN WILL BE PERFORMED BY THE MAINTAINING AGENCY PRIOR TO CONSTRUCTION. ANY EXISTING OR PROPOSED COMPONENTS THAT ARE DAMAGED DURING CONSTRUCTION OR THE WARRANTY PERIOD WILL BE THE RESPONSIBILITY OF THE CONTRACTOR. THE ENTIRE SYSTEM MUST BE RESTORED TO THE SAME CONDITION IT WAS IN BEFORE THE START OF CONSTRUCTION.

SCALE: 1"=20'

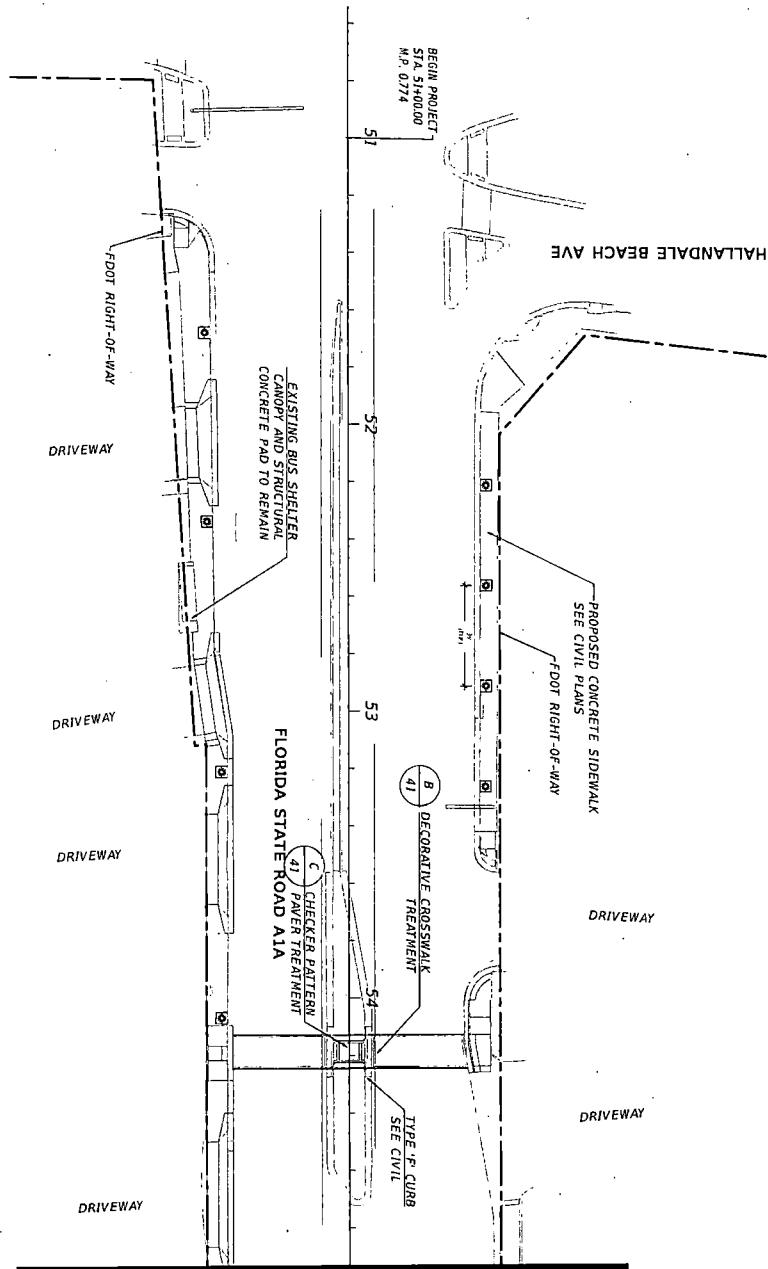


SHEET NUMBER 23	PHASE IV SR A1A UNDERGROUNDING OF OVERHEAD UTILITIES AND STREETSCAPE BEAUTIFICATION PREPARED FOR HOLLYWOOD CRA HOLLYWOOD FL	HARDSCAPE PLAN	KHA PROJECT 044241032 DATE DECEMBER 2024 SCALE AS SHOWN DESIGNED BY JH DRAWN BY JC/TH/RC CHECKED BY TR DATE 12/19/2024	LICENSED PROFESSIONAL JONATHAN D. HAIGH, P.E. FL LICENSE NUMBER #6665795	Kimley»Horn © 2021 KIMLEY-HORN AND ASSOCIATES, INC. 1920 WEST PALM BEACH BLVD SUITE 200 WEST PALM BEACH, FL 33411 PHONE: 561-843-0565 FAX: 561-893-8175 WWW.KIMLEY-HORN.COM REGISTRY NO. 35106	VMOA EXHIBIT DRAWINGS 12.19.2024 NS
			No.	REVISIONS	DATE	BY

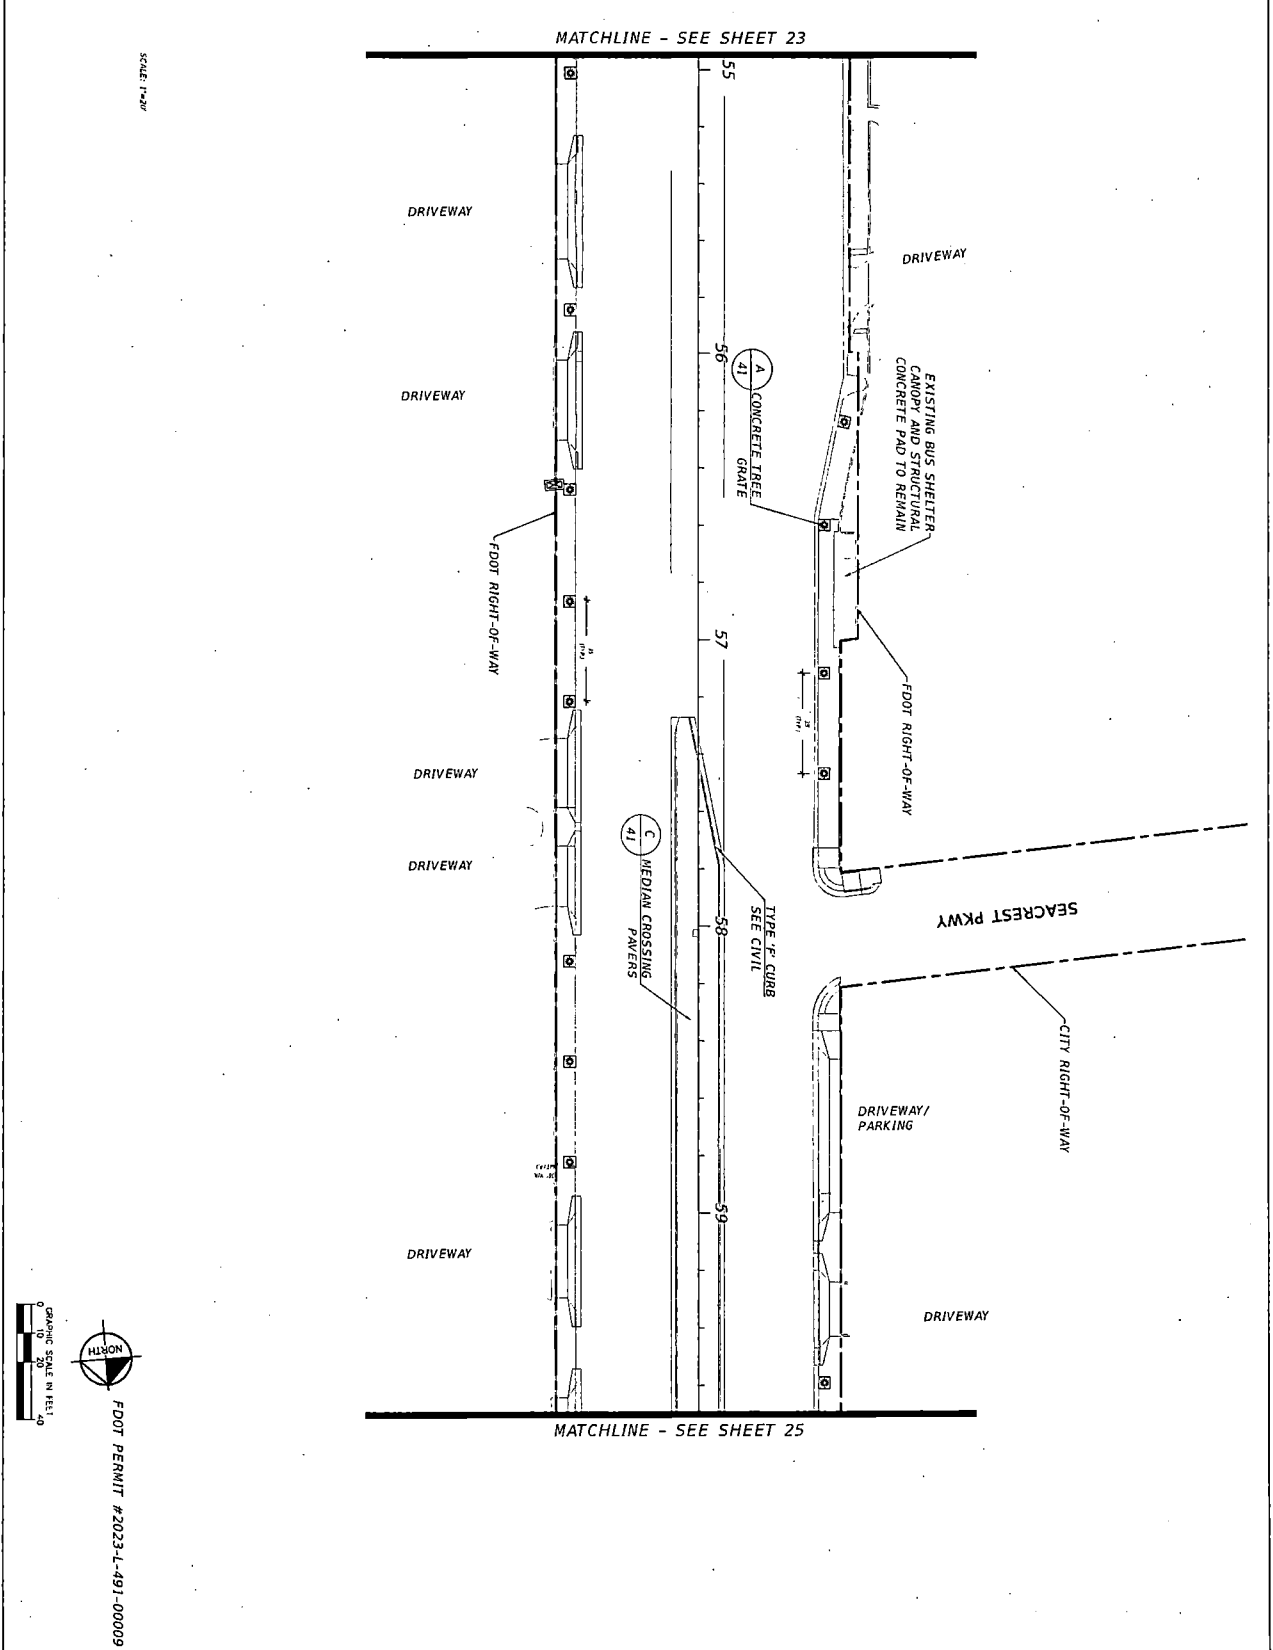


MATCHLINE - SEE SHEET 24

SCALE: 1"=20'

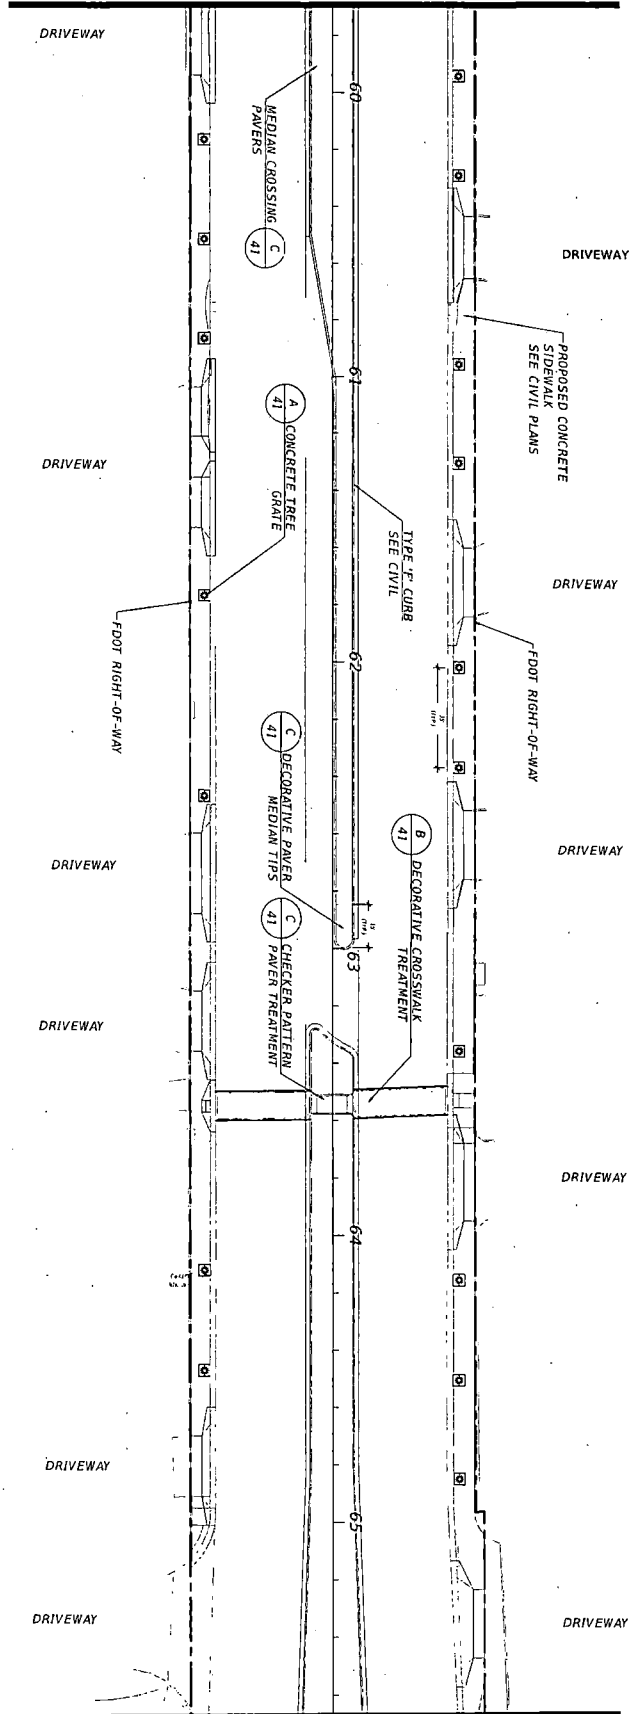

MATCHLINE - SEE SHEET 26

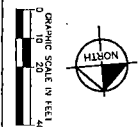

FDOT PERMIT #2023-L-491-00009

PHASE IV SR A1A UNDERGROUNDING OF
OVERHEAD UTILITIES AND
STREETSCAPE BEAUTIFICATION
PREPARED FOR
HOLLYWOOD CRA
LLYWOOD


HARDSCAPE PLAN

KHA PROJECT 044241032	LICENSED PROFESSIONAL
DATE DECEMBER 2024	JONATHAN D. HAIGH, PLA
SCALE AS SHOWN	
DESIGNED BY JH -	PL LICENSE NUMBER #5666795
DRAWN BY JC/TH/RC	
CHECKED BY TR	DATE: 2/19/2024

Kimley»Horn
© 2021 KIMLEY-HORN AND ASSOCIATES, INC.
1920 WEDIVA WAY SUITE 200, WEST PALM BEACH, FL 33411
PHONE: 561-845-0685 FAX: 561-853-8175
WWW.KIMLEY-HORN.COM REGISTRY NO. 35105

[illegible]

This document, together with the concepts and designs presented herein, is an instrument of service, to be used only for the specific purpose and client for which it was prepared. Review of and reliance on this document without written authorization and adaptation by Kimley-Horn and Associates, Inc. shall be without liability to Kimley-Horn and Associates, Inc.

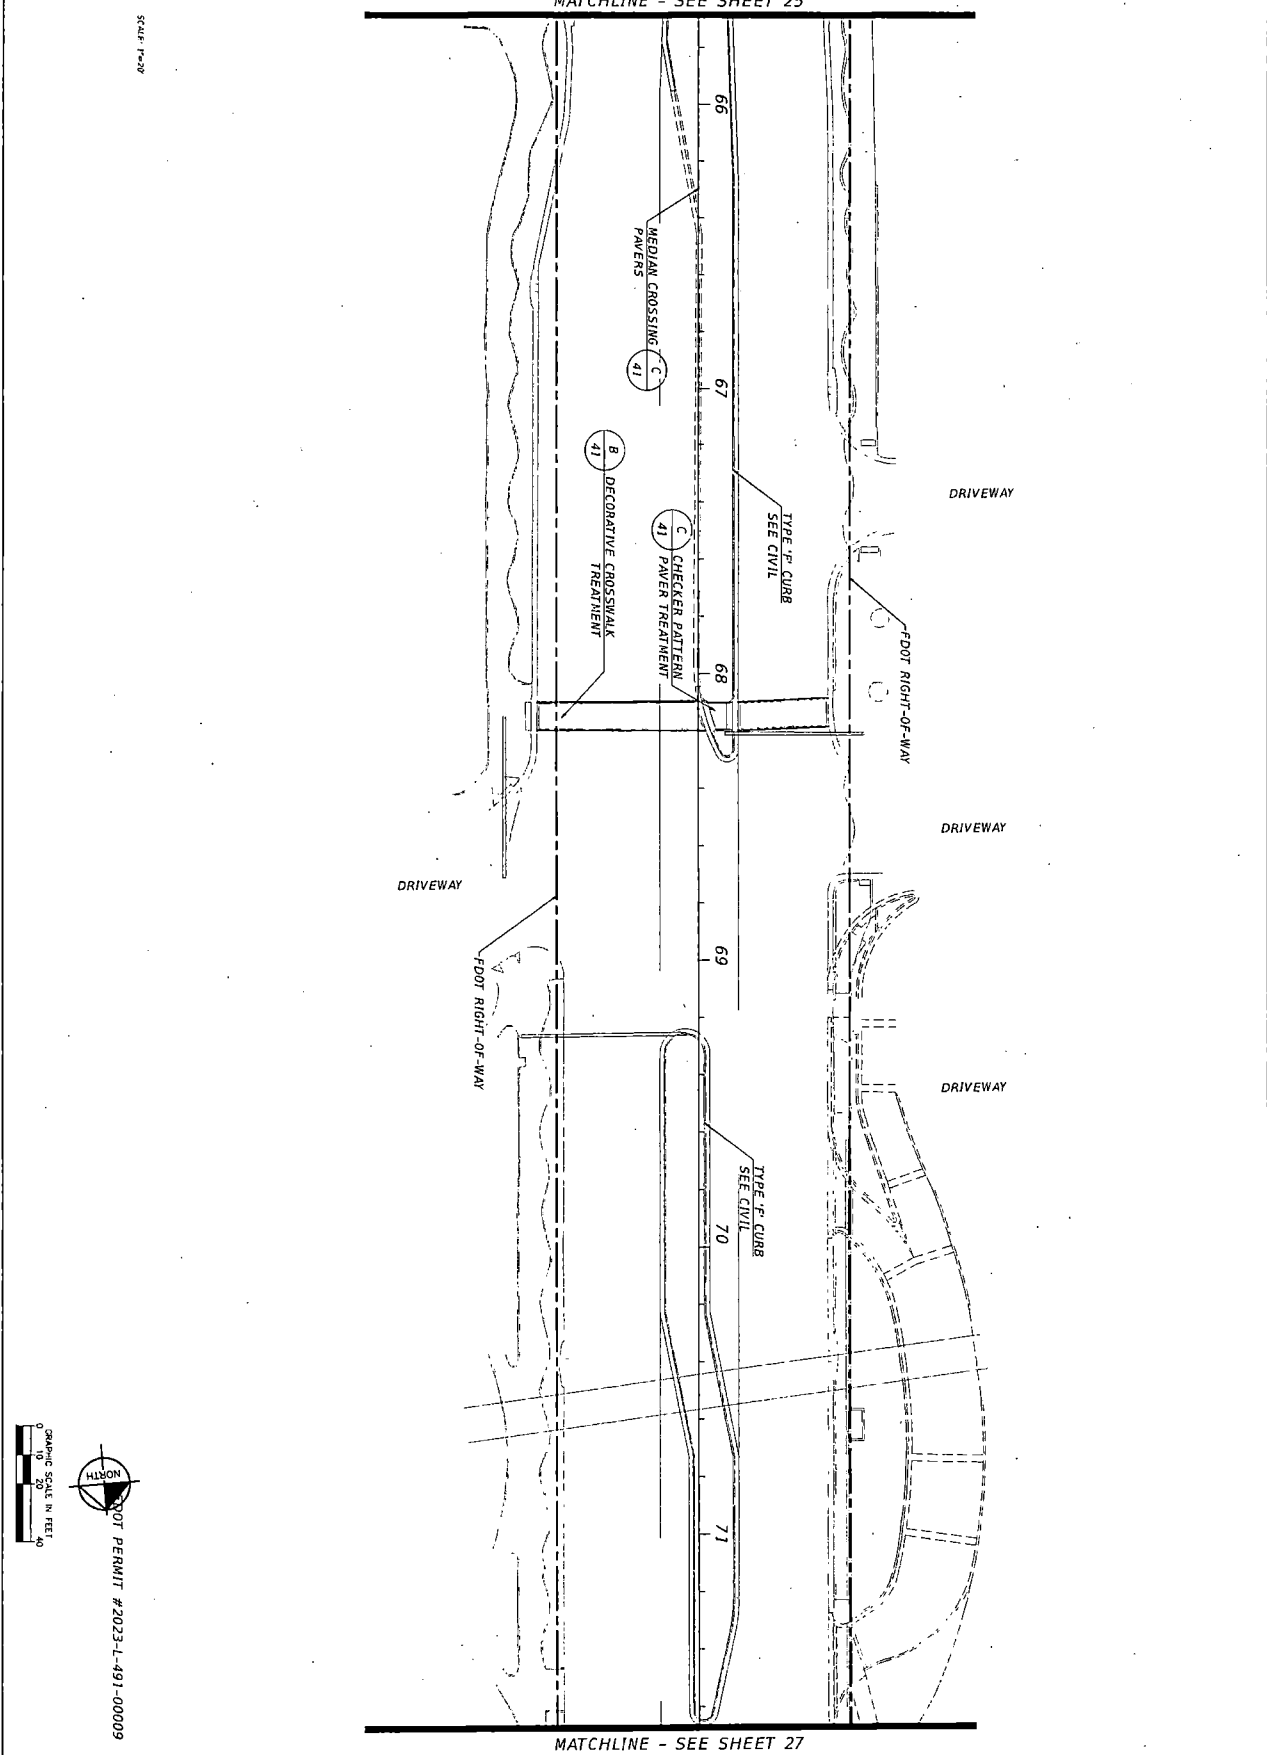

26 SHEET NUMBER	PHASE IV SR A1A UNDERGROUNDING OF OVERHEAD UTILITIES AND STREETSCAPE BEAUTIFICATION PREPARED FOR HOLLYWOOD CRA HOLLYWOOD FL	HARDSCAPE PLAN	KHA PROJECT 044241032	LICENSED PROFESSIONAL JONATHAN D. HAIGH, PLA	Kimley»Horn © 2021 KIMLEY-HORN AND ASSOCIATES, INC. 1020 REDOUBT WAY SUITE 200, WEST PALM BEACH, FL 33411 PHONE: 561-845-0555 FAX: 561-853-8175 WWW.KIMLEY-HORN.COM REGISTRY NO. 35106	MUGA EXHIBIT DRAWINGS	12.19.2024	NS
			DATE DECEMBER 2024	FL LICENSE NUMBER #6666795		NO.	REVISIONS	DATE

DRIVEWAY

✓ FDOT RIGHT-OF-WAY

TYPE 'F' CURE
SEE CIVIL

DRIVEWAY

FDOT RIGHT-OF-WAY

DRIVEWAY

PROPOSED CONCRETE SIDEWALK
SEE CIVIL PLANS

DRIVEWAY

DRIVEWAY

DRIVEWAY

MATCHLINE - SEE SHEET 28

FDOT PERMIT #2023-L-491-00005

PHASE IV SR A1A UNDERGROUNDING OF
OVERHEAD UTILITIES AND
STREETSCAPE BEAUTIFICATION
PREPARED FOR
HOLLYWOOD CRA
HOLLYWOOD

HARDSCAPE PLAN

KHA PROJECT 044241032
DATE DECEMBER 202
SCALE AS SHOWN
DESIGNED BY JH
DRAWN BY JC/TH/R
CHECKED BY TR

LICENCED PROFESSIONAL

JONATHAN D. HAIGH, PLA



FL LICENSE NUMBER
#6666795

DATE: 2/19/2024

Kimley»Horn
© 2021 KIMLEY-HORN AND ASSOCIATES, INC.
1920 WOKIVA WAY SUITE 200, WEST PALM BEACH, FL 33411
PHONE: 561-845-0885 FAX: 561-863-8175
WWW.KIMLEY-HORN.COM REGISTRY NO. 35106

	MMQA EXHIBIT DRAWINGS	12.19.2024	NS
No.	REVISIONS	DATE	BY

SCALE: 1"=20'

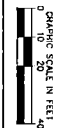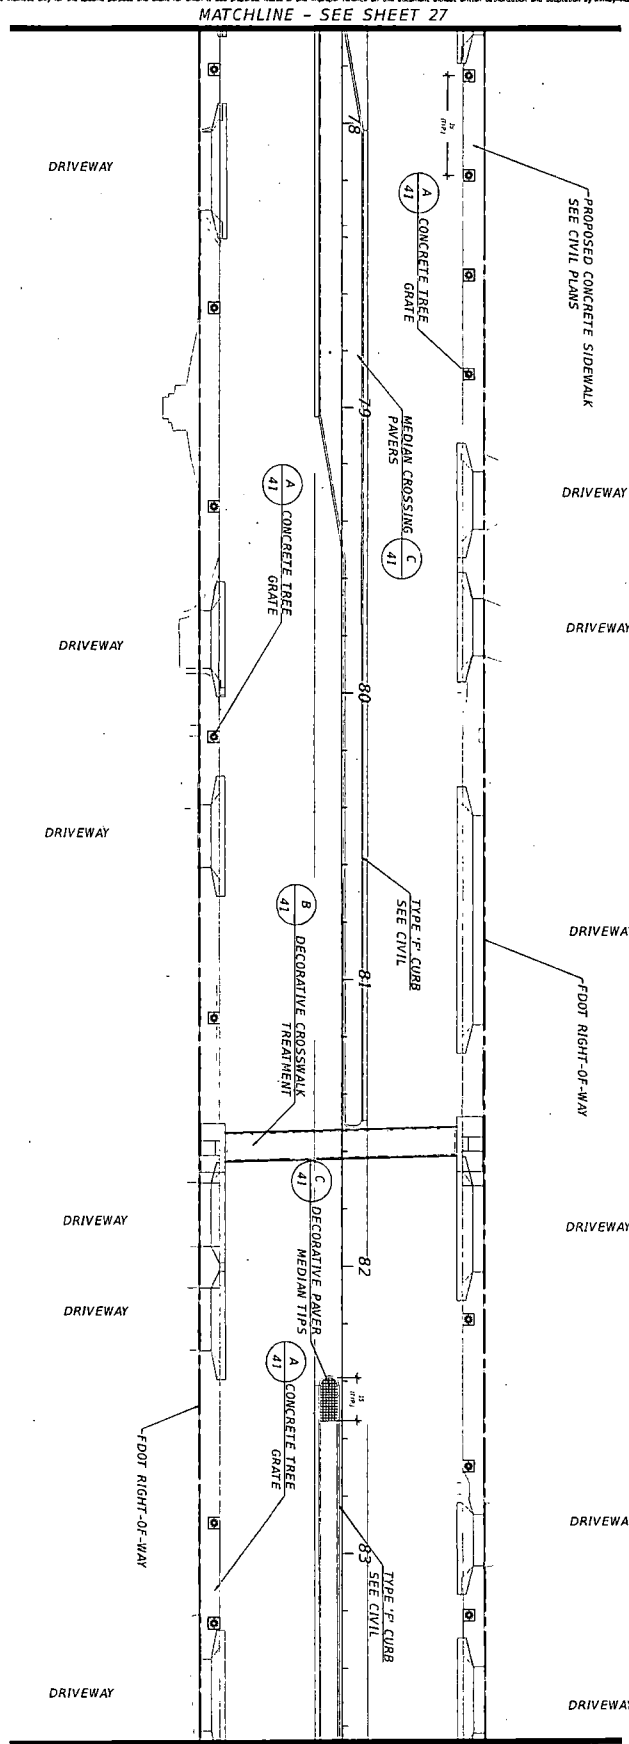

FDOT PERMIT #2023-L-491-00009

PHASE IV SR A1A UNDERGROUNDING OF
OVERHEAD UTILITIES AND
STREETSCAPE BEAUTIFICATION
PREPARED FOR
HOLLYWOOD CRA
HOLLYWOOD FL

HARDSCAPE PLAN


KHA PROJECT
044241032
DATE
DECEMBER 2024
SCALE AS SHOWN
DESIGNED BY JH
DRAWN BY JC/DH/RG
CHECKED BY TR

LICENSED PROFESSIONAL
JONATHAN D. HATCH, P.E.
FL LICENSE NUMBER
#6666795
DATE: 2/19/2024

Kimley»Horn
© 2021 KIMLEY-HORN AND ASSOCIATES, INC.
1620 WOODLAW WAY SUITE 200 WEST PALM BEACH, FL 33411
PHONE: 561-843-0555 FAX: 561-813-8175
WWW.KIMLEY-HORN.COM REGISTRY NO. 35106

MGA EXHIBIT DRAWINGS		12.19.2024 NS
No.	REVISIONS	DATE BY

GRAPHIC SCALE IN FEET



A horizontal scale bar with alternating black and white segments. The segments are labeled 0, 10, 20, and 40, representing feet.



SHEET NUMBER
29

HARDSCAPE PLAN


Kimley»Horn
© 2021 KIMLEY-HORN AND ASSOCIATES, INC.
1920 WEXIVA WAY SUITE 200, WEST PALM BEACH, FL 33411
PHONE: 561-845-0565 FAX: 561-863-8175
WWW.KIMLEY-HORN.COM REGISTRY NO. 35106

	MMA EXHIBIT DRAWINGS	12.19.2024	NS
No.	REVISIONS	DATE	BY

This document, together with the concepts and design presented herein, are an instrument of service, to be retained only for the specific purpose and client for which it was prepared. Review of and reliance on this document without written authorization and adoption by Kimley-Horn and Associates, Inc. shall be without liability to Kimley-Horn and Associates, Inc.

MATCHLINE - SEE SHEET 29

SCALE: 1"=20'

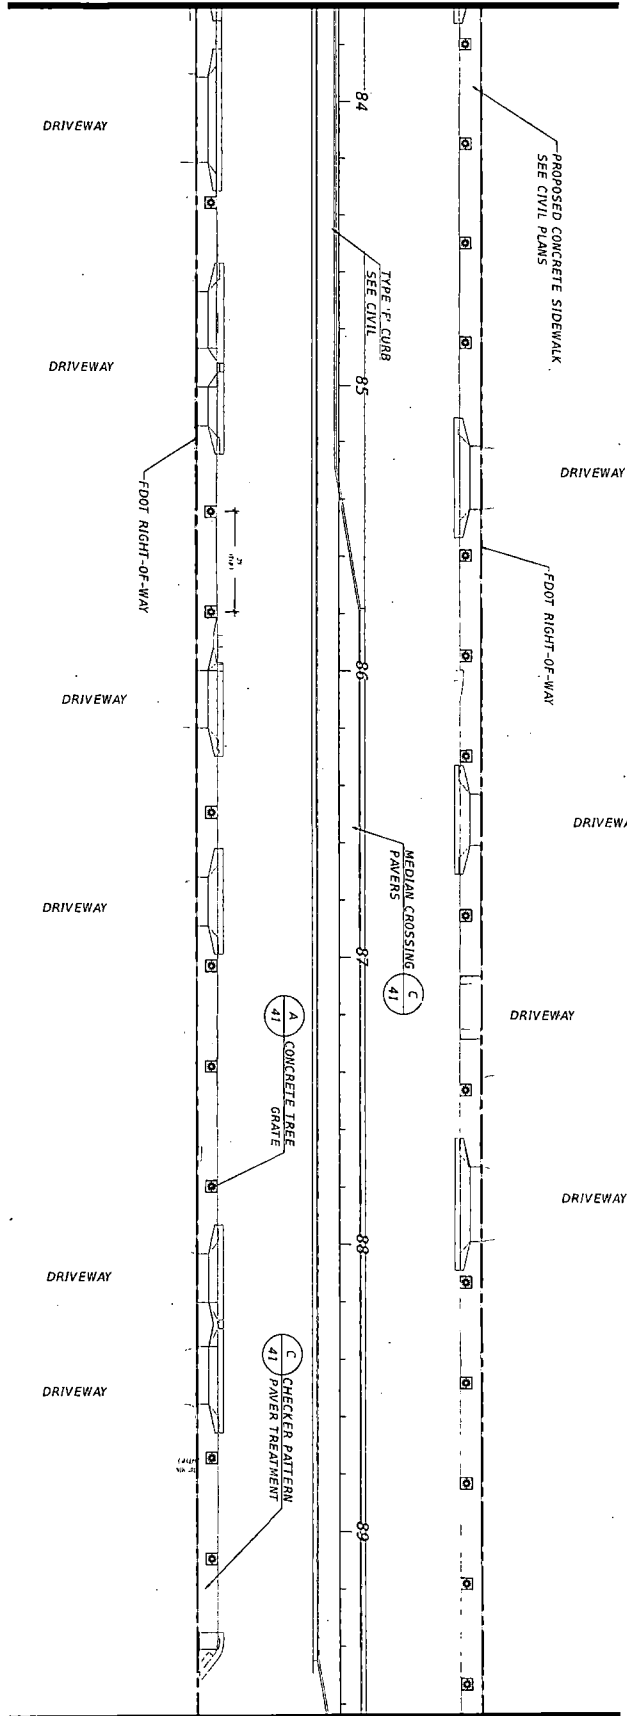

MATCHLINE - SEE SHEET 31



FDOT PERMIT #2023-L-491-00009

PHASE IV SR A1A UNDERGROUNDING OF
OVERHEAD UTILITIES AND
STREETSCAPE BEAUTIFICATION
PREPARED FOR
HOLLYWOOD CRA
HOLLYWOOD FL

HARDSCAPE PLAN

KHA PROJECT
044241032
DATE
DECEMBER 2024
SCALE AS SHOWN
DESIGNED BY
#5666795
CHECKED BY
TR
DATE 2/19/2024

LICENSED PROFESSIONAL
JONATHAN D. HAIGH, P.E.
FL LICENSE NUMBER
#5666795

Kimley»Horn
© 2021 KIMLEY-HORN AND ASSOCIATES, INC.
1820 WESTVA WAY SUITE 200 WEST PALM BEACH, FL 33411
PHONE: 561-845-0865 FAX: 561-863-8175
WWW.KIMLEY-HORN.COM REGISTRY NO. 35106


MUDA EXHIBIT DRAWINGS		52.19.2024 NS
No.	REVISIONS	DATE BY

SHEET NUMBER
30

This document, together with the concepts and designs presented herein, is an instrument of service, to be used only for the specific purpose and client for which it was prepared. Review of and reliance on this document without written authorization and signature by Kimley-Horn and Associates, Inc. shall be without liability to Kimley-Horn and Associates, Inc.

SCALE: 1"=20'

MATCHLINE - SEE SHEET 30

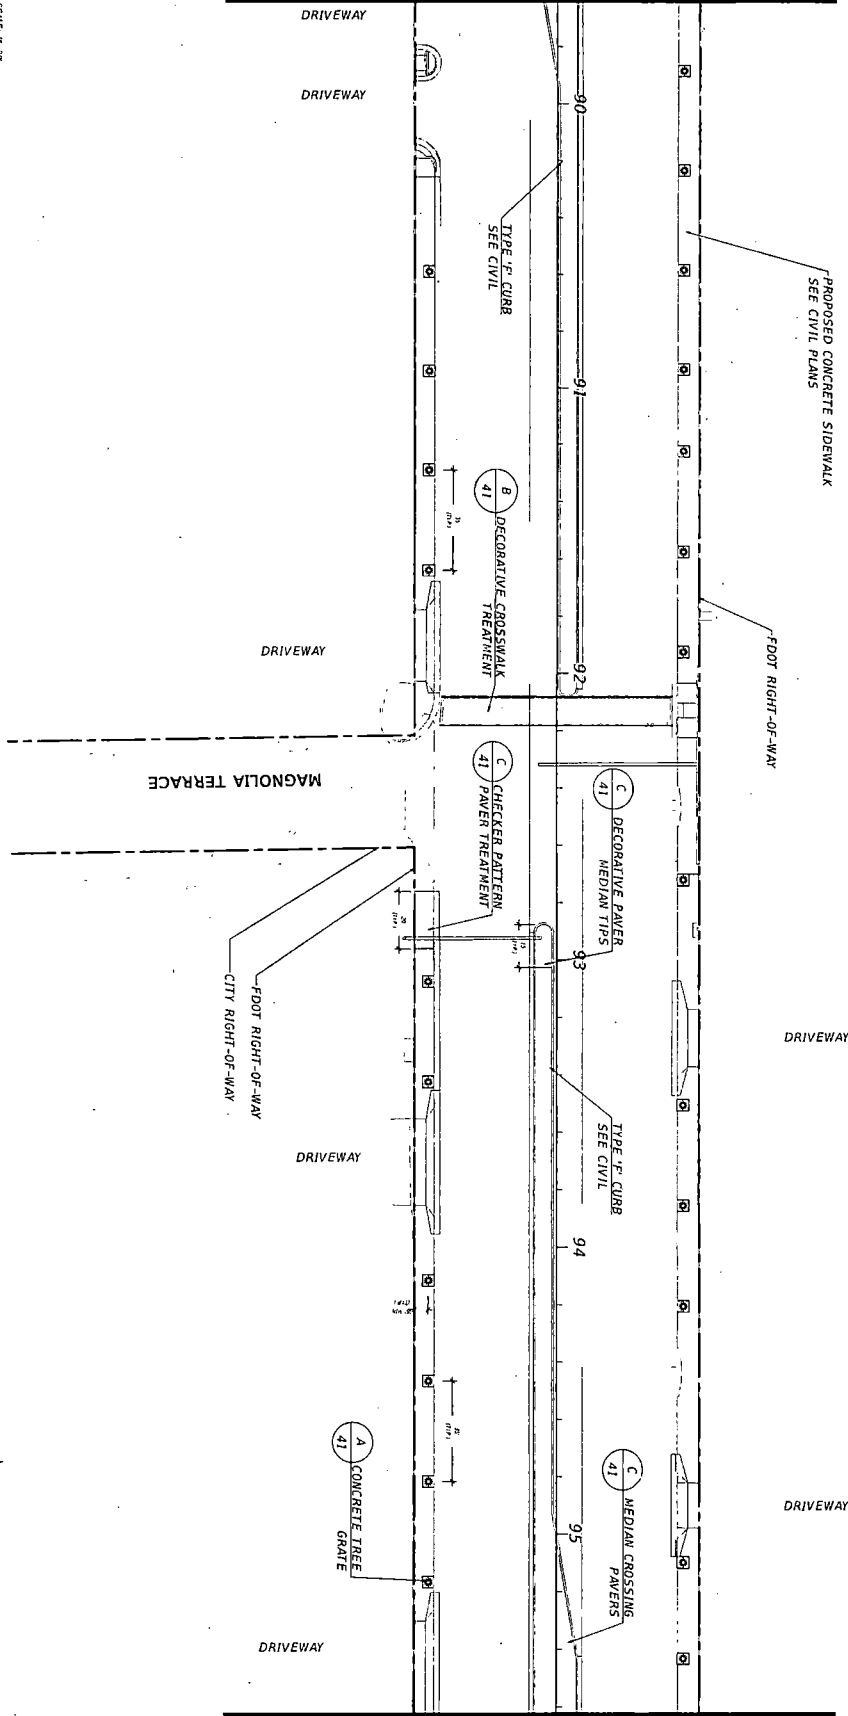

MATCHLINE - SEE SHEET 32



DOT PERMIT #2023-L-491-00009

PHASE IV SR A1A UNDERGROUNDING OF
OVERHEAD UTILITIES AND
STREETSCAPE BEAUTIFICATION
PREPARED FOR
HOLLYWOOD CRA
HOLLYWOOD FL


HARDSCAPE PLAN

KH&A PROJECT
044241032
DATE
DECEMBER 2024
SCALE AS SHOWN
DESIGNED BY JH
DRAWN BY JLC/TH/RC
CHECKED BY TR
DATE 12/19/2024
LICENSED PROFESSIONAL
JONATHAN D. HADJI, P.E.
FL LICENSE NUMBER
#6666795

Kimley-Horn
© 2021 KIMLEY-HORN AND ASSOCIATES, INC.
1920 NEMPA WAY SUITE 200 WEST PALM BEACH, FL 33411
PHONE: 561-845-0565 FAX: 561-863-8175
WWW.KIMLEY-HORN.COM REGISTRY NO. 35106

UNGA EXHIBIT DRAWINGS		12/19/2024	NS
No.	REVISIONS	DATE	BY

SHEET NUMBER
31

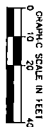

FL

KMA PROJECT 044241032	LICENCED PROFESSIONAL
DATE DECEMBER 2024	JONATHAN D. HAIGH, PL
SCALE AS SHOWN	
DESIGNED BY JH	PL LICENSE NUMBER
DRAWN BY JC/TH/RC	#6666795
CHECKED BY TER	DATE: 12/19/2024

Kimley»Horn
© 2021 KIMLEY-HORN AND ASSOCIATES, INC.
1920 MEDIVA WAY SUITE 200, WEST PALM BEACH, FL 33411
PHONE: 561-845-0585 FAX: 561-853-8175
WWW.KIMLEY-HORN.COM REGISTRY NO. 35105

MMA EXHIBIT DRAWINGS		12.19.2024	NS
No.	REVISIONS	DATE	BY




FDOT PERMIT #2023-L-491-00009

MATCHLINE - SEE SHEET 34

MMQA EXHIBIT DRAWINGS		12.19.2024	NS
No.	REVISIONS	DATE	BY


This document, together with the concepts and designs presented herein, are an instrument of service, to be used only for the specific purpose and client for which it was prepared. Review of and reliance on this document without authorization and adaptation by Kimley-Horn and Associates, Inc. shall be without liability to Kimley-Horn and Associates, Inc.

MATCHLINE - SEE SHEET 33

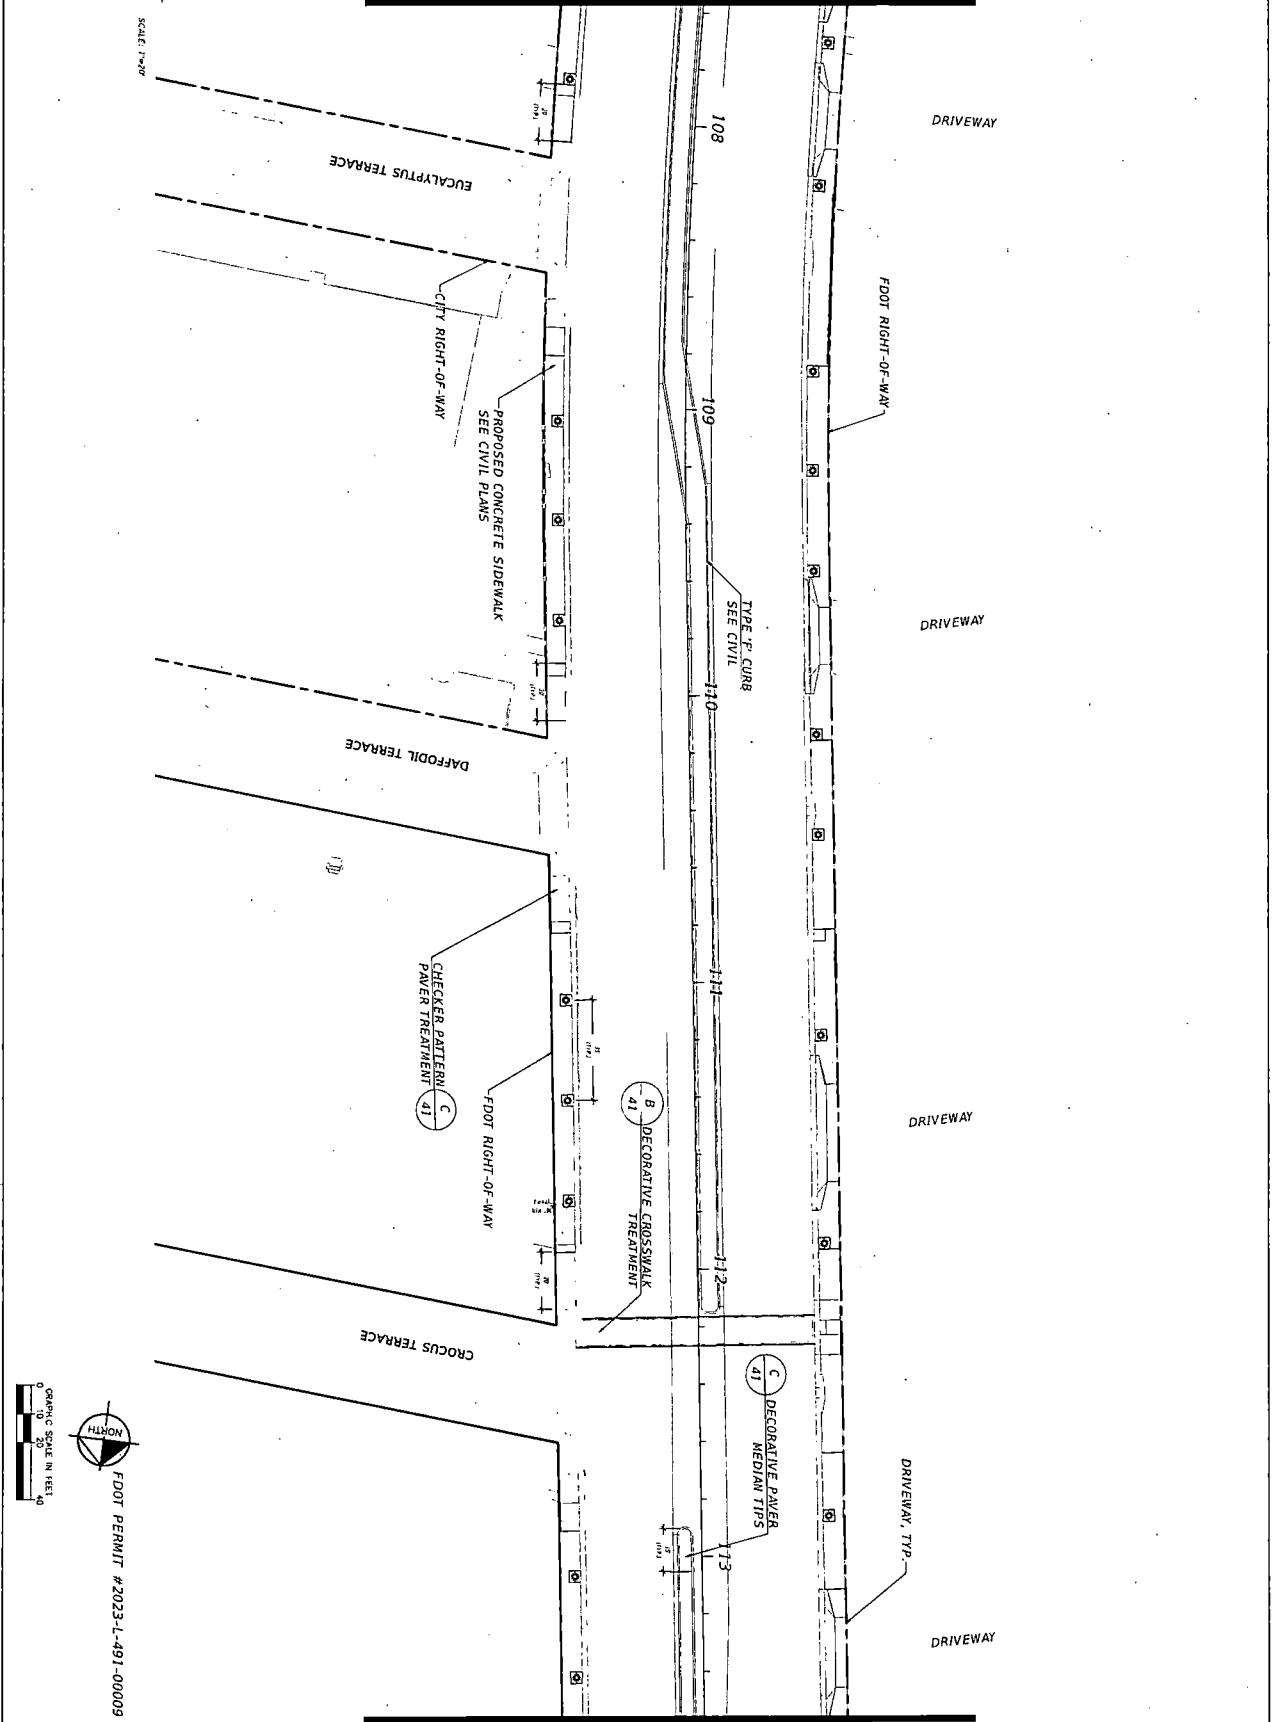



FDOT PERMIT #2023-L-491-00009

MATCHLINE - SEE SHEET 35

SHEET NUMBER 34	PHASE IV SR A1A UNDERGROUNDING OF OVERHEAD UTILITIES AND STREETSCAPE BEAUTIFICATION PREPARED FOR HOLLYWOOD CRA HOLLYWOOD FL	HARDSCAPE PLAN	KHA PROJECT 044241032	LICENSED PROFESSIONAL	 © 2021 KIMLEY-HORN AND ASSOCIATES, INC. 1920 MONROE WAY SUITE 200, WEST PALM BEACH, FL 33411 PHONE: 561-845-0552 FAX: 561-853-8175 WWW.KIMLEY-HORN.COM REGISTRY NO. 35106	MMDA EXHIBIT DRAWINGS	12.19.2024	MS	
			DATE DECEMBER 2024	JONATHAN D. HAICH, PLA					
			SCALE AS SHOWN						
			DESIGNED BY JH	FL LICENSE NUMBER #6666795					
			DRAWN BY JC/TH/RIC						
			CHECKED BY TR	DATE 12/19/2024					
						No.	REVISIONS	DATE	BY

This document, together with the concepts and designs presented herein, is an instrument of service, is intended only for the specific purpose and client for which it was prepared, and no other reliance on this document without written authorization and signature by Kimley-Horn and Associates, Inc. shall be without liability to Kimley-Horn and Associates, Inc.


MATCHLINE - SEE SHEET 34

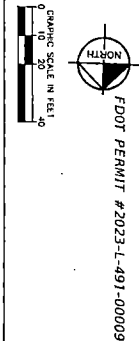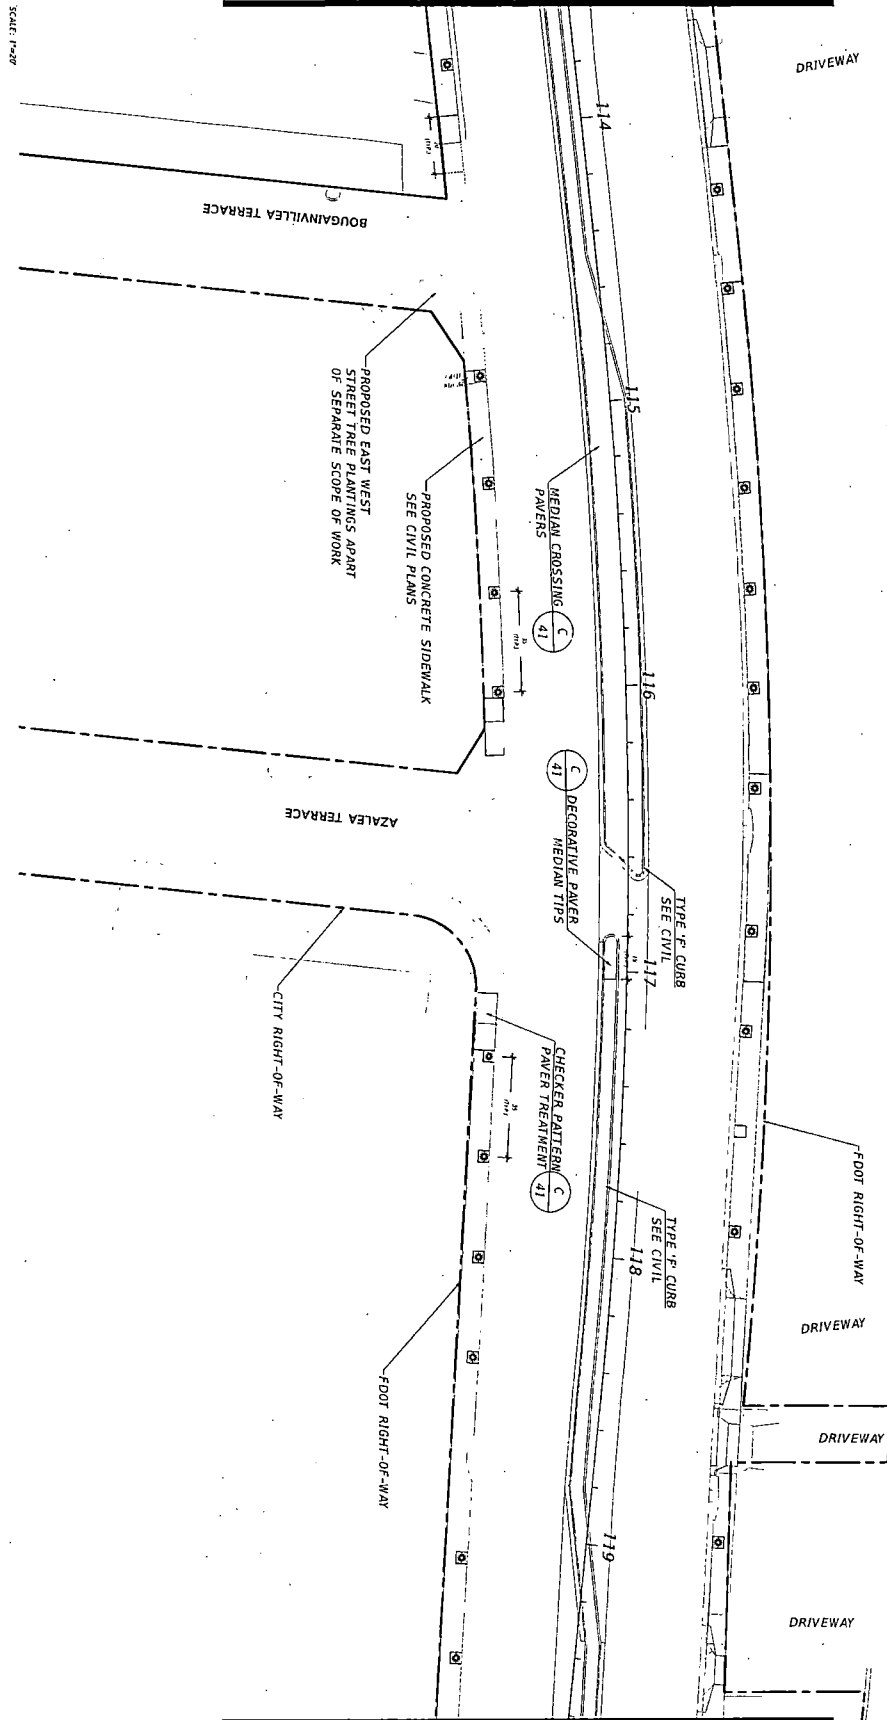

SHEET NUMBER 35	PHASE IV SR A1A UNDERGROUNDING OF OVERHEAD UTILITIES AND STREETSCAPE BEAUTIFICATION PREPARED FOR HOLLYWOOD CRA HOLLYWOOD FL		HARDSCAPE PLAN	KHA PROJECT 044241032 DATE DECEMBER 2024 SCALE AS SHOWN DESIGNED BY JH DRAWN BY JC/TH/RC CHECKED BY TR	LICENSED PROFESSIONAL JONATHAN D. HAIGH, PLA FL LICENSE NUMBER #6666795 DATE 2/19/2024	<div>Kimley»Horn</div> <div>© 2021 KIMLEY-HORN AND ASSOCIATES, INC. 1920 WOODLA WAY SUITE 200, WEST PALM BEACH, FL 33411 PHONE: 561-845-0663 FAX: 561-843-8175 WWW.KIMLEY-HORN.COM REGISTRY NO. 35105</div>	VMOA EXHIBIT DRAWINGS	12.19.2024	NS	
							NO.	REVISIONS	DATE	BY

MATCHLINE - SEE SHEET 35

SCALE: 1"=20'

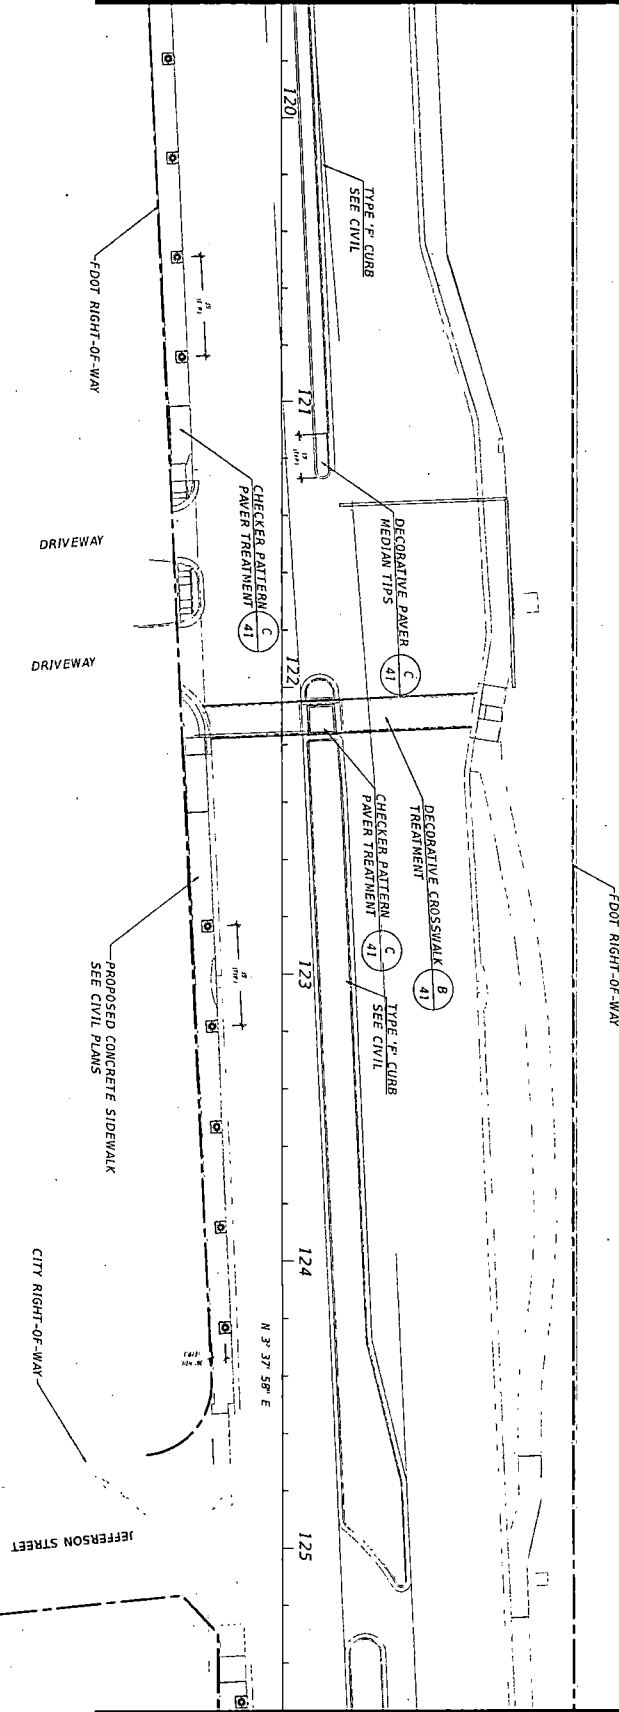


MATCHLINE - SEE SHEET 37

SHEET NUMBER 36	PHASE IV SR A1A UNDERGROUNDING OF OVERHEAD UTILITIES AND STREETSCAPE BEAUTIFICATION PREPARED FOR HOLLYWOOD CRA HOLLYWOOD FL	HARDSCAPE PLAN	KHA PROJECT 044241032	LICENSED PROFESSIONAL JONATHAN D. HORN, P.E.	<div>Kimley»Horn</div> <div>© 2021 KIMLEY-HORN AND ASSOCIATES, INC. 1920 KODIVA WAY SUITE 200, WEST PALM BEACH, FL 33411 PHONE: 561-845-0885 FAX: 561-853-8170 WWW.KIMLEY-HORN.COM REGISTRY NO. 35106</div>	MUDA EXHIBIT DRAWINGS 2.19.2024		NS	
			DATE DECEMBER 2024						
			SCALE AS SHOWN						
			DESIGNED BY JH	FL LICENSE NUMBER #5666795					
			DRAWN BY JC/TH/RG						
			CHECKED BY TR	DATE 12/19/2024					
						No.	REVISIONS	DATE	BY

MATCHLINE - SEE SHEET 36

SCALE: 1"=20'

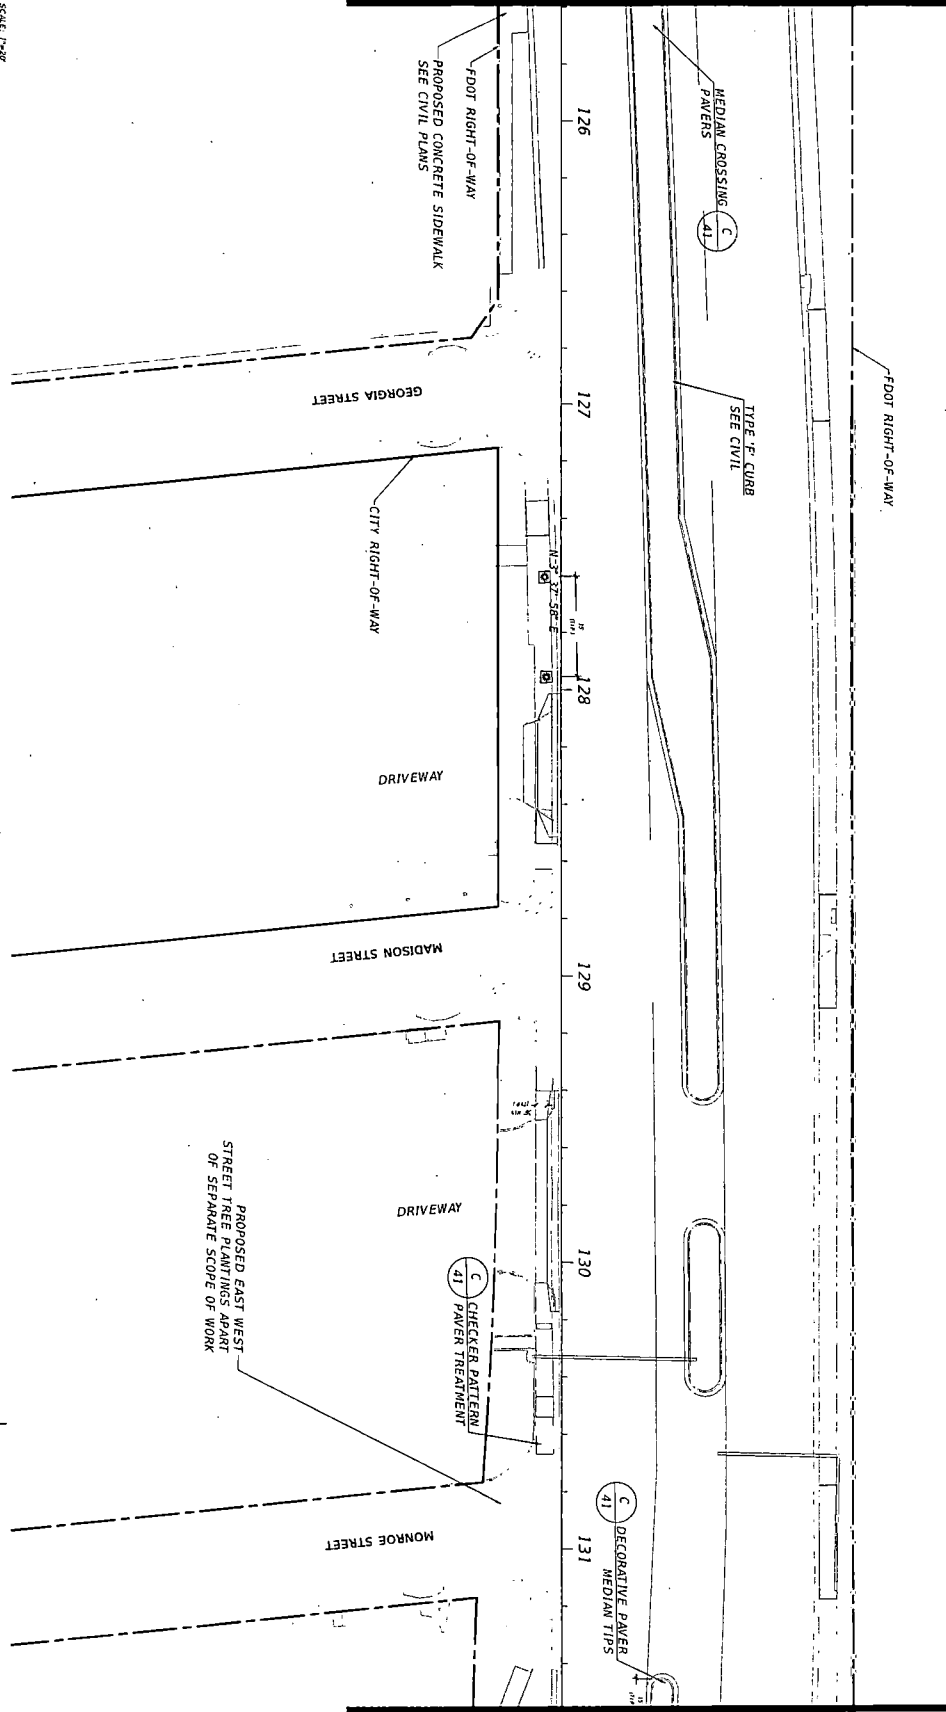

FDOT PERMIT #2023-L-491-00009

MATCHLINE - SEE SHEET 38

SHEET NUMBER
37

PHASE IV SR A1A UNDERGROUNDING OF
OVERHEAD UTILITIES AND
STREETSCAPE BEAUTIFICATION
PREPARED FOR
HOLLYWOOD CRA
HOLLYWOOD FL

HARDSCAPE PLAN

KHA PROJECT
044241032
DATE
DECEMBER 2024
SCALE AS SHOWN
DESIGNED BY JH
DRAWN BY JC/TH/RC
CHECKED BY TR
DATE 12/19/2024

FL LICENSE NUMBER
#6666795

LICENSED PROFESSIONAL
JONATHAN D. HORN, P.E.


Kimley»Horn

© 2021 KIMLEY-HORN AND ASSOCIATES, INC.
1920 WOODA WAY SUITE 200, WEST PALM BEACH, FL 33411
PHONE: 561-845-0655 FAX: 561-853-8175
WWW.KIMLEY-HORN.COM REGISTRY NO. 35106

No.	REVISIONS	DATE	BY

MUDA EXHIBIT DRAWINGS	12.19.2024	NS


THIS DOCUMENT, INCLUDING ANY AND ALL ATTACHMENTS, IS THE PROPERTY OF KIMLEY-HORN AND ASSOCIATES, INC. (K&A). IT IS TO BE USED ONLY FOR THE PROJECT AND SITE SPECIFICALLY IDENTIFIED HEREIN. NO PART OF THIS DOCUMENT IS TO BE REPRODUCED OR TRANSMITTED IN ANY FORM OR BY ANY MEANS, ELECTRONIC OR MECHANICAL, INCLUDING PHOTOCOPYING, RECORDING, OR BY ANY INFORMATION STORAGE AND RETRIEVAL SYSTEM, WITHOUT THE WRITTEN PERMISSION OF K&A. K&A ASSUMES NO LIABILITY FOR NEGLIGENCE OR FOR ANY OTHER CAUSE OF ACTION, INCLUDING NEGLIGENCE, IN THE PERFORMANCE OF ITS PROFESSIONAL SERVICES. K&A'S LIABILITY IS LIMITED TO THE EXTENT OF THE FEE RECEIVED FOR THE SERVICES PROVIDED. K&A'S LIABILITY IS LIMITED TO THE EXTENT OF THE FEE RECEIVED FOR THE SERVICES PROVIDED. K&A'S LIABILITY IS LIMITED TO THE EXTENT OF THE FEE RECEIVED FOR THE SERVICES PROVIDED.

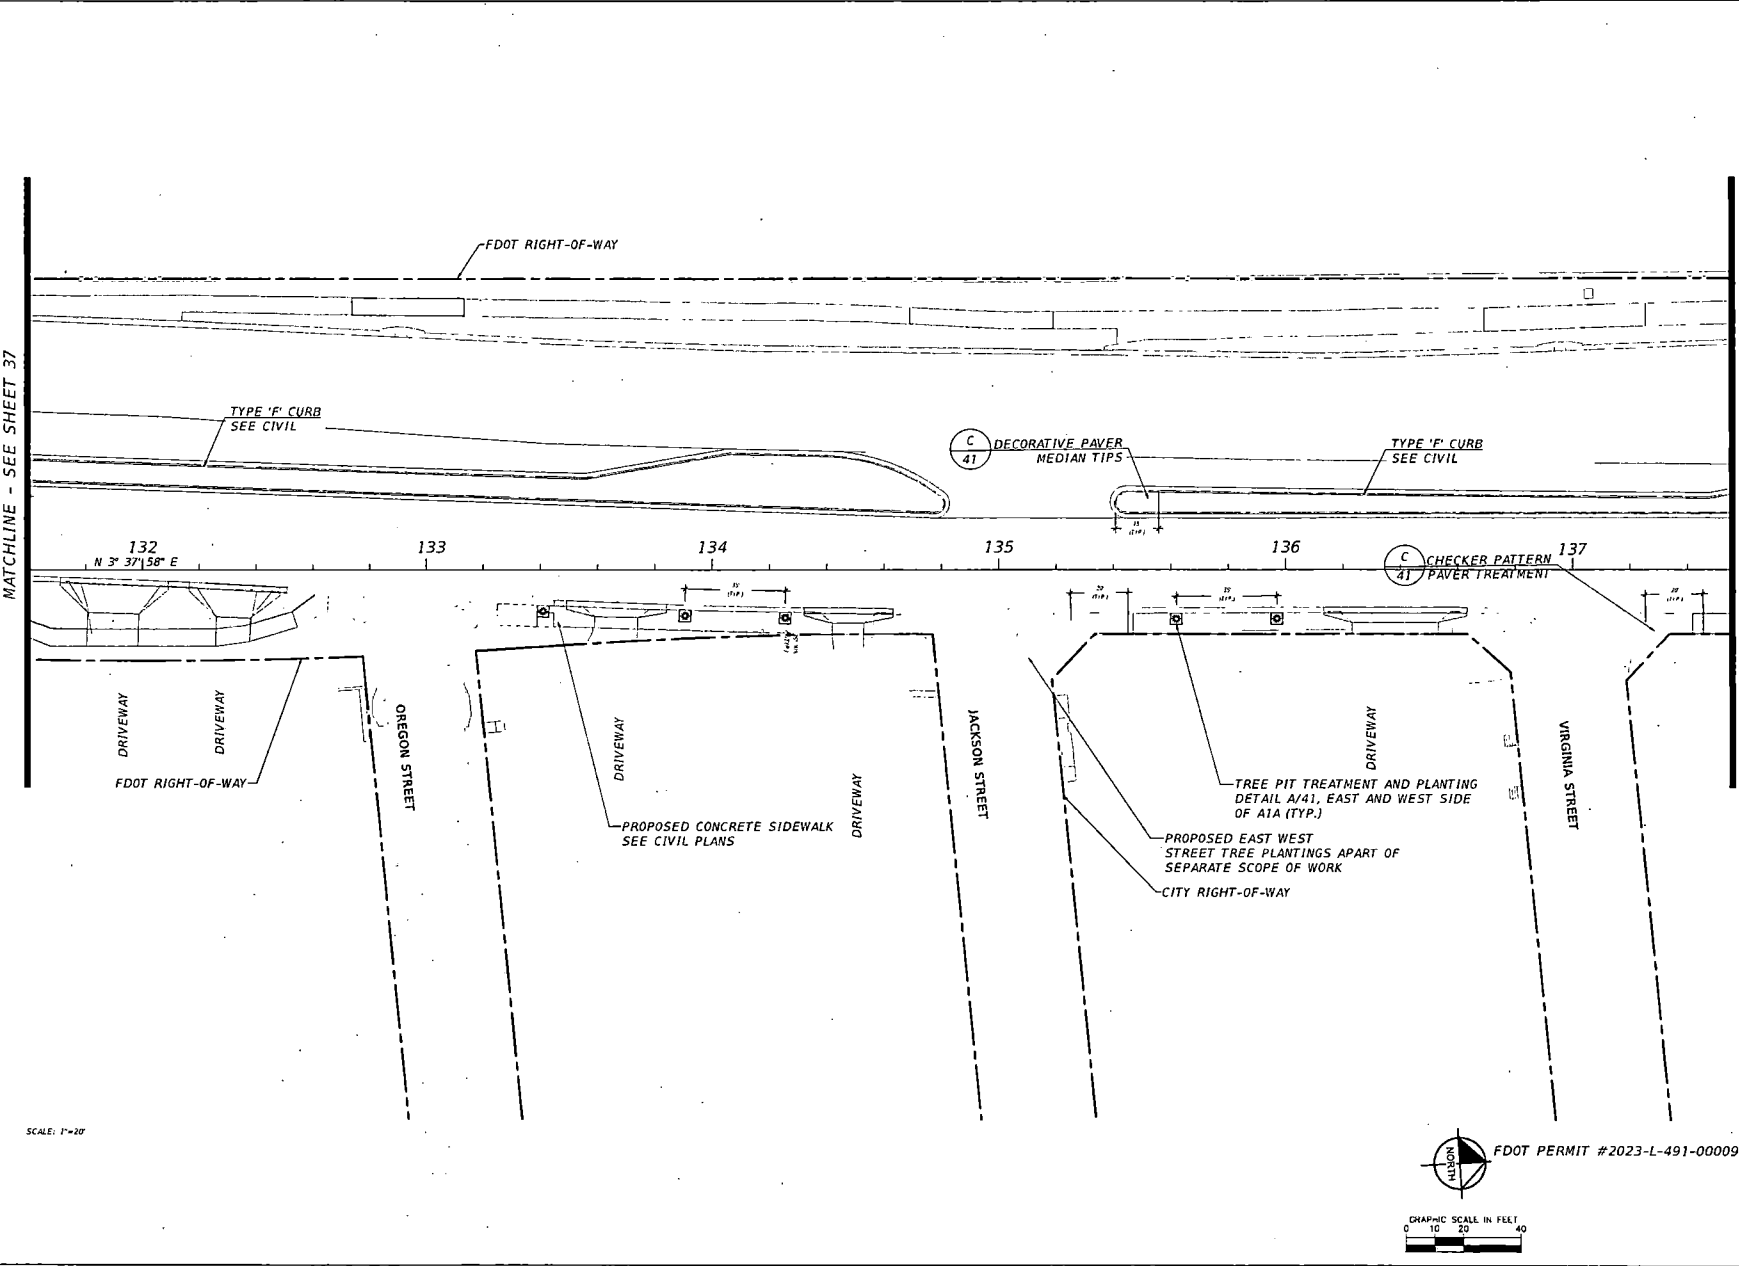

MATCHLINE - SEE SHEET 37

KIMLEY-HORN & ASSOCIATES, INC. 1030 MONA WAY SUITE 200, WEST PALM BEACH, FL 33411 PHONE: 561-845-0665 FAX: 561-852-8975 WWW.KIMLEY-HORN.COM LICENSE NO. 35124		NO. 12/19/2024	
PROJECT: PHASE IV SR A1A UNDERGROUNDING OF OVERHEAD UTILITIES AND STREETScape BEAUTIFICATION PREPARED FOR HOLLYWOOD CRA HOLLYWOOD FL		SHEET NUMBER 38	
K&A PROJECT: 044241032 DESIGNED BY: J. H. H. H. CHECKED BY: J. H. H. H. DATE: 12/19/2024		MATCHLINE - SEE SHEET 39	
HARDSCAPE PLAN		KIMLEY-HORN & ASSOCIATES, INC.	


FDOT PERMIT #2023-L-491-00009

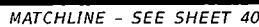



MMGA EXHIBIT DRAWINGS		12.19.2024	NS
No.	REVISIONS	DATE	BY

MATCHLINE - SEE SHEET 39

SCALE 1"=20'


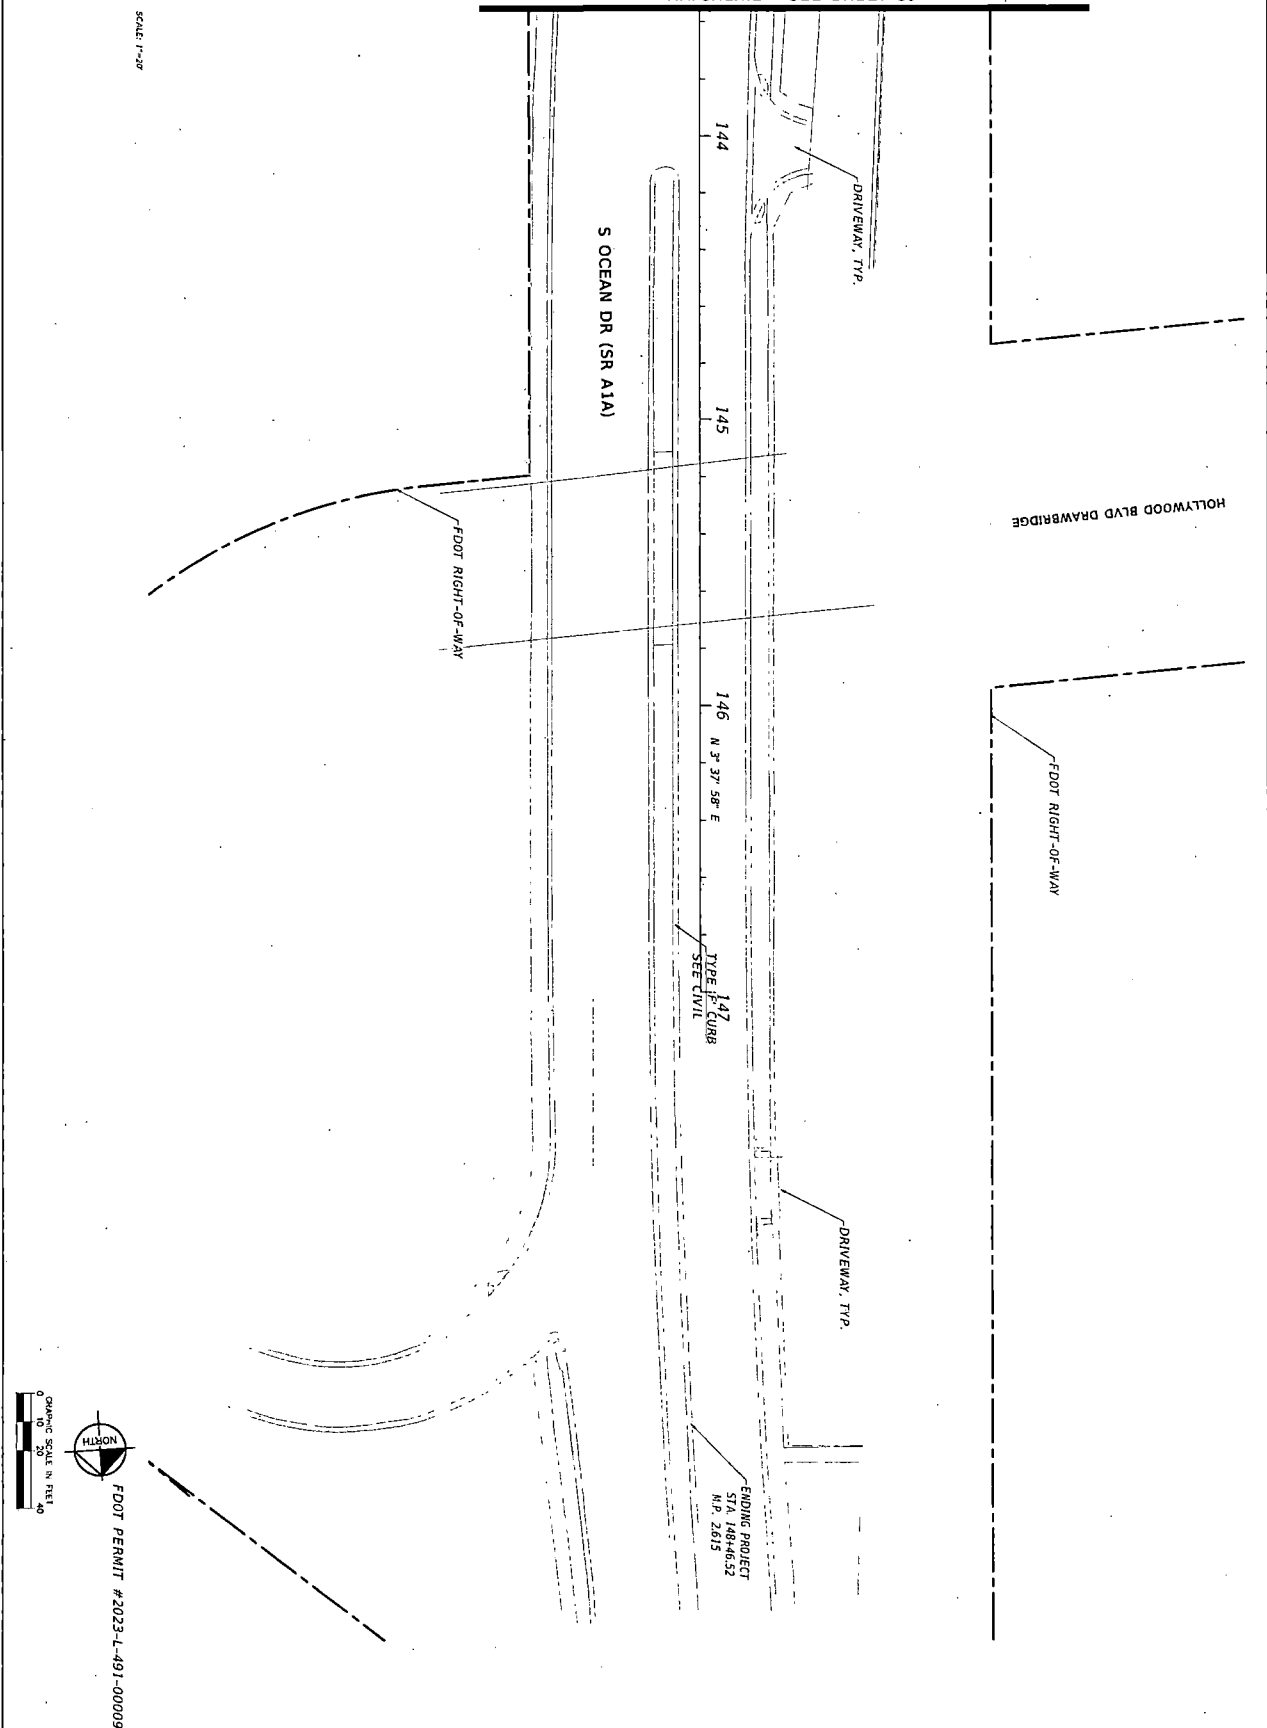


SHEET NUMBER 40	PHASE IV SR A1A UNDERGROUNDING OF OVERHEAD UTILITIES AND STREETSCAPE BEAUTIFICATION PREPARED FOR HOLLYWOOD CRA HOLLYWOOD FL	HARDSCAPE PLAN	KHA PROJECT 044241032	LICENSED PROFESSIONAL JONATHAN D. HATCH, P.L.A.	Kimley»Horn © 2021 KIMLEY-HORN AND ASSOCIATES, INC. 1920 MEDINA BAY SUITE 200, WEST PALM BEACH, FL 33411 PHONE: 561-843-0685 FAX: 561-843-8175 WWW.KIMLEY-HORN.COM REGISTRY NO. 35105	MWOA EXHIBIT DRAWINGS 12.19.2024 NS			
			DATE DECEMBER 2024 SCALE AS SHOWN DESIGNED BY JH DRAWN BY JC/TH/RG CHECKED BY TR	FL LICENSE NUMBER #6666795 DATE 12/19/2024		NO.	REVISIONS	DATE	BY

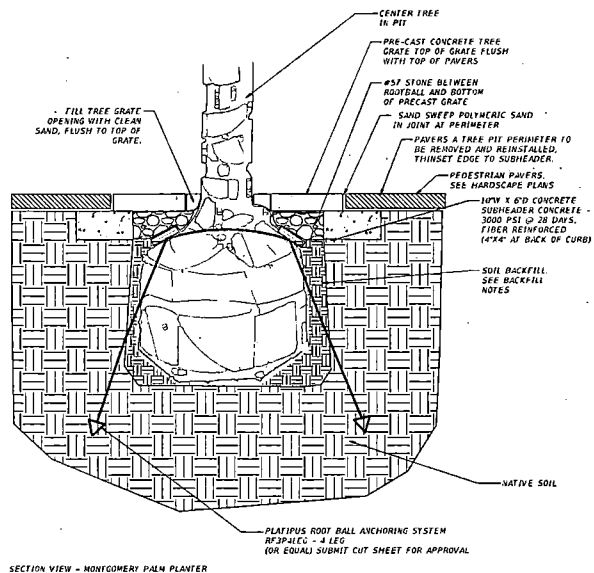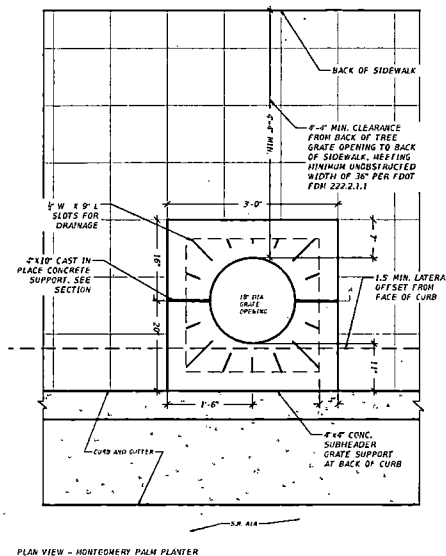


A TREE PIT TREATMENT AND PLANTING

B DECORATIVE CROSSWALK TREATMENT

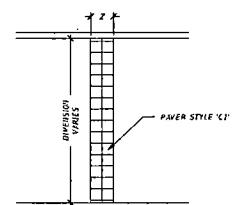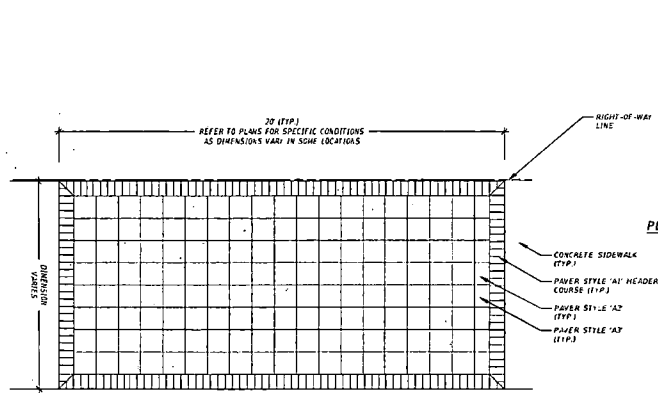

PLAN VIEW - BLUE / GREEN CHECKERED PATTERN

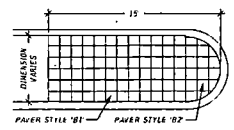

C DECORATIVE PAVER PATTERNS- MEDIAN AND ROADSIDE

CONCRETE PAVERS: ALL PAVERS TO HAVE BEVELED EDGES, MIN 8000 PSI COMPRESSIVE STRENGTH, AND INSTALLED PER FOOT SPECIFICATION 526 OR AS NOTED BELOW

PAVER A1: 4" x 8" x 2 1/2" Integral Colored Concrete Paver- Old Castle Holland Stone (or approved equal)
Color: Chestnut (Dish Brown) to match existing pavers installed on Hollywood side streets.

PAVER A2 & A3: 12" x 12" x 2 1/2" Integral Colored Concrete Paver with Specialty Shell Aggregate - Artistic Paver (or approved equal)
Colors: Hollywood Signature Blue with Caguana Shell and Mirror Roadlock Paver (model: 22C0H-350L-M112)
Hollywood Signature Green with Caguana Shell and Mirror Roadlock Paver (model: 22C0H-350R-M112)

PAVER B1 & B2: 12" x 12" x 2 1/2" Integral Colored Concrete Paver with Specialty Shell Aggregate - Artistic Paver (or approved equal)
Colors: Hollywood Signature Blue with Caguana Shell and Mirror Roadlock Paver (model: 22C0H-350L-M112)
Hollywood Signature Green with Caguana Shell and Mirror Roadlock Paver (model: 22C0H-350R-M112)

PAVER C1: 12" x 12" x 2 1/2" Integral Colored Concrete Paver with Specialty Shell Aggregate - Artistic Paver (or approved equal)
Colors: Adobe with Caguana Shell and Mirror Roadlock Paver (model: 22C0H-350L-M112)

ALL 12X12 PAVERS TO USE INORGANIC CONCRETE COLORANTS.
ALL 12X12 PAVERS TO BE 9000 PSI COMPRESSIVE STRENGTH OR GREATER.
REPRESENTATIVE SAMPLES OF ALL 12X12 PAVER COLORS ARE AVAILABLE FOR VIEWING AT CITY OF HOLLYWOOD CRA OFFICE.
PROVIDE PRODUCT DATA FOR JOINT SAND, SEALANT, AND PAVERS SHOP DRAWINGS AND COLOR SAMPLES FOR ENGINEER AND CITY OF HOLLYWOOD APPROVAL PRIOR TO CONSTRUCTION.

PAVERS SHALL BE SWEEPED WITH TECHNISOL POLYMERIC SAND AND SEALED WITH A WATER-BASED SEALANT.
REFER TO ICPI TECHNICAL SPECIFICATION NUMBER 2 'CONSTRUCTION OF INTERLOCKING CONCRETE PAVEMENTS' FOR INSTALLATION PROCEDURES.

ARCHITECTURAL PAVERS INSTALLATION FOR SIDEWALKS AND/OR DRIVEWAYS WITHIN THE FOOT RIGHT OF WAY SHALL COMPLY WITH CURRENT FOOT STANDARD SPECIFICATION 526.

WHERE PAVERS DO NOT ADJUT BUILDING, WALL OR CURB, INSTALL 18" WIDE CONTINUOUS CONCRETE SUBHEADER (MIN 3000 PSI @ 28 DAYS, FIBER REINFORCED) WITH SAWCUT JOINTS AT 5' AND GROUT PAVERS TO TOP OF SUBHEADER USING AN EPOXY PORTLAND CEMENT MORTAR.

PAVERS ADJUT CONCRETE RAMP OR CURB: FDOT PERMIT #2023-L-491-00009

CONCRETE PAVERS - INSTALL PER SPECIFICATIONS

1" MAX SAND BRIDGING LATER HEETING REQUIREMENTS OF ASTM C33 WITH MAX 1% PASSING NO. 200 SIEVE

PAVERS ADJUT CONCRETE RAMP OR CURB: FDOT PERMIT #2023-L-491-00009

6" DECOMPOSED CONCRETE OR CRUSHED Limestone - L80100

COMPACTED SUBGRADE (95% STANDARD PROCTOR)

SLOPE FOR POSITIVE DRAINAGE TO STORMWATER CONVEYANCE SYSTEMS, PER CIVIL PLANS

CONCRETE PAVERS - INSTALL PER SPECIFICATIONS

1" MAX SAND BRIDGING LATER HEETING REQUIREMENTS OF ASTM C33 WITH MAX 1% PASSING NO. 200 SIEVE

PAVERS ADJUT CONCRETE RAMP OR CURB: FDOT PERMIT #2023-L-491-00009

6" DECOMPOSED CONCRETE OR CRUSHED Limestone - L80100

COMPACTED SUBGRADE (95% STANDARD PROCTOR)

CALL 48 HOURS BEFORE YOU DIG
IT'S THE LAW! DIAL 811
Know what's below. Call before you dig.
811
FLORIDA
WASHINGTON STATE ONE CALL OF FLORIDA INC.


Kimley»Horn
1800 N. W. 10th Ave., Suite 200, Fort Lauderdale, FL 33311
PHONE: 954-561-0000 FAX: 954-561-0075
WWW.KIMLEY-HORN.COM REGISTRY NO. 3016

HARDSCAPE DETAILS
HOLLYWOOD CRA

PHASE IV SR A1A UNDERGROUNDING OF OVERHEAD UTILITIES AND STREETSCAPE BEAUTIFICATION PREPARED FOR
HOLLYWOOD


SHEET NUMBER
41

THIS DOCUMENT, INCLUDING ALL INFORMATION, IS THE PROPERTY OF KIMLEY-HORN & ASSOCIATES, INC. (KHA) AND IS NOT TO BE REPRODUCED, COPIED, OR TRANSMITTED IN ANY FORM OR BY ANY MEANS, ELECTRONIC OR MECHANICAL, WITHOUT THE WRITTEN PERMISSION OF KHA. KHA AND ITS EMPLOYEES SHALL NOT BE LIABLE FOR ANY DAMAGE OR LOSS OF ANY KIND, INCLUDING BUT NOT LIMITED TO, DIRECT, INDIRECT, SPECIAL, INCIDENTAL, OR CONSEQUENTIAL DAMAGES, ARISING OUT OF OR IN CONNECTION WITH THE USE OF THIS DOCUMENT, REGARDLESS OF THE TYPE OF NEGLIGENCE, WHETHER ACTIVE, PASSIVE, OR IN THE LINE OF DUTY. KHA AND ITS EMPLOYEES SHALL NOT BE LIABLE FOR ANY DAMAGE OR LOSS OF ANY KIND, INCLUDING BUT NOT LIMITED TO, DIRECT, INDIRECT, SPECIAL, INCIDENTAL, OR CONSEQUENTIAL DAMAGES, ARISING OUT OF OR IN CONNECTION WITH THE USE OF THIS DOCUMENT, REGARDLESS OF THE TYPE OF NEGLIGENCE, WHETHER ACTIVE, PASSIVE, OR IN THE LINE OF DUTY.

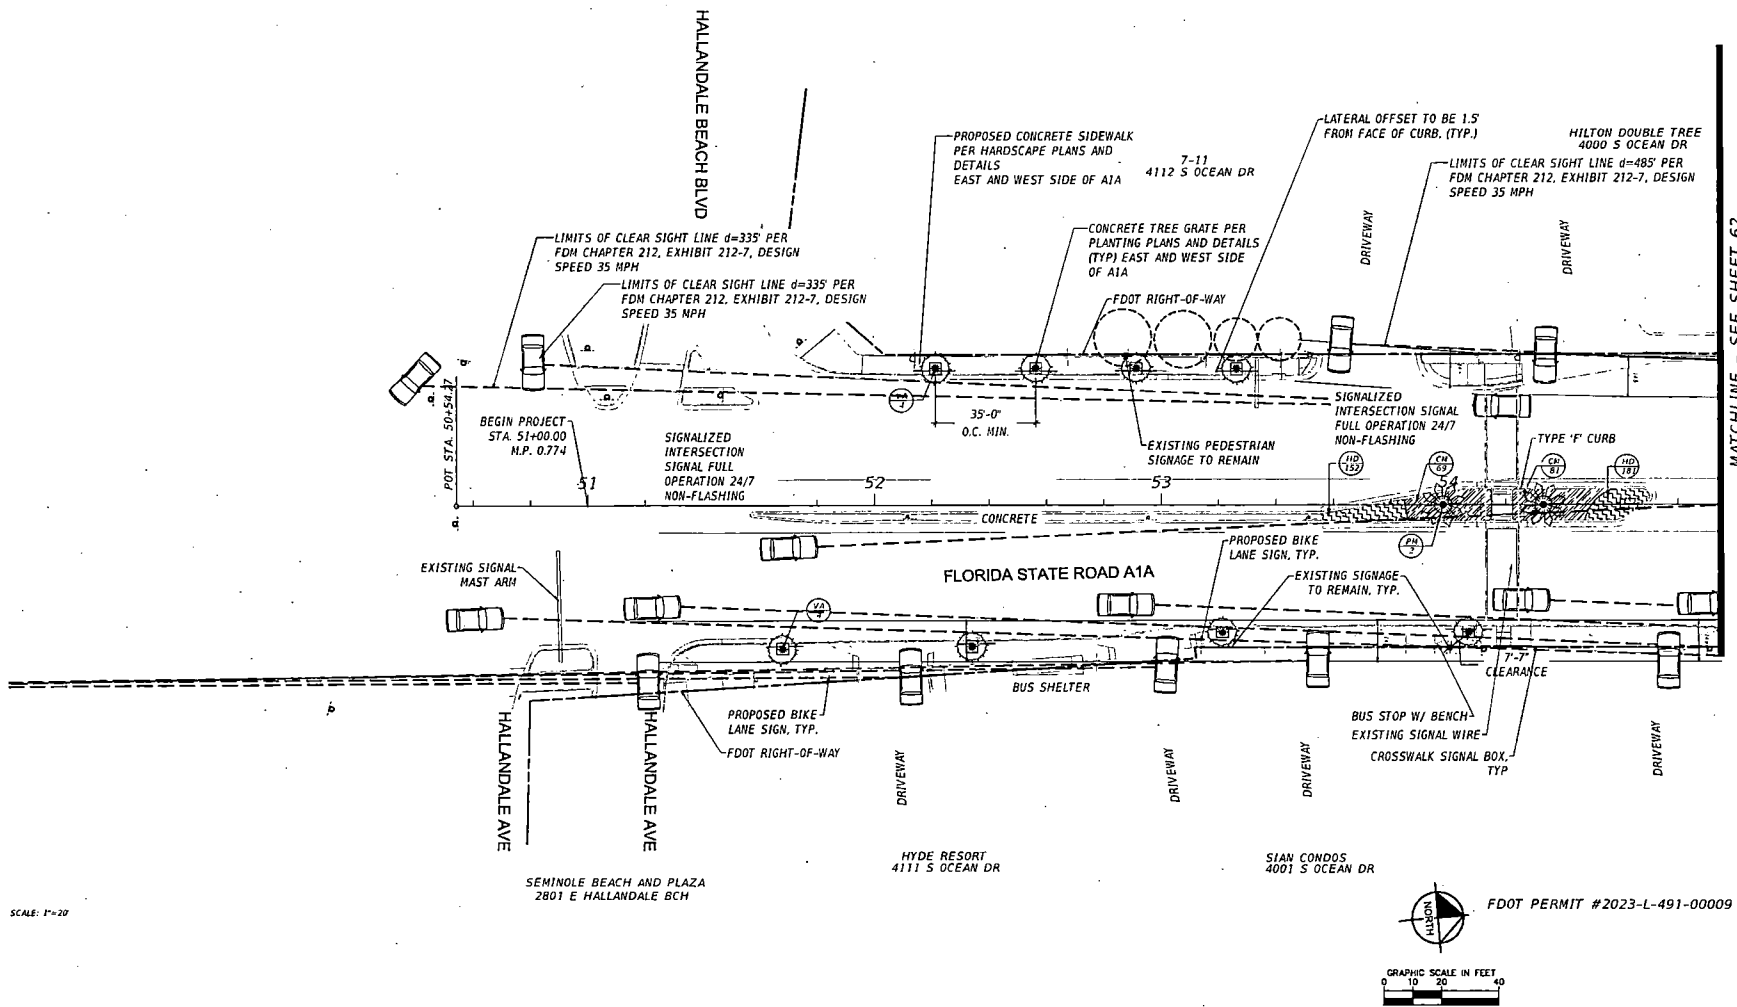


KIMLEY-HORN & ASSOCIATES, INC.		12.13.2024	
PROJECT: PHASE IV SR A1A UNDERGROUNDING OF OVERHEAD UTILITIES AND STREETSCAPE BEAUTIFICATION		SHEET NUMBER: 61	
PREPARED FOR: HOLLYWOOD CRA		DATE: 12/19/2024	
HOLLYWOOD, FL		BY: [Signature]	
DRAWN BY: [Signature]		CHECKED BY: [Signature]	
SCALE: AS SHOWN		DATE: 12/19/2024	
PROJECT NO: 2023-L-491-00009		SHEET NO: 61	
KIMLEY-HORN & ASSOCIATES, INC.		12.13.2024	
1800 PALM BLVD, SUITE 200, WEST PALM BEACH, FL 33411		PHONE: 561-845-8665 FAX: 561-852-8975	
WWW.KIMLEY-HORN.COM		REGISTRY NO. 30106	

THIS DOCUMENT, TOGETHER WITH THE CONTRACT AND ANY SUPPLEMENTAL AGREEMENTS, IS THE SOLE AND EXCLUSIVE PROPERTY OF KIMLEY-HORN AND ASSOCIATES, INC. NO PART OF THIS DOCUMENT IS TO BE REPRODUCED OR TRANSMITTED IN ANY FORM OR BY ANY MEANS, ELECTRONIC OR MECHANICAL, WITHOUT PERMISSION IN WRITING FROM KIMLEY-HORN AND ASSOCIATES, INC.

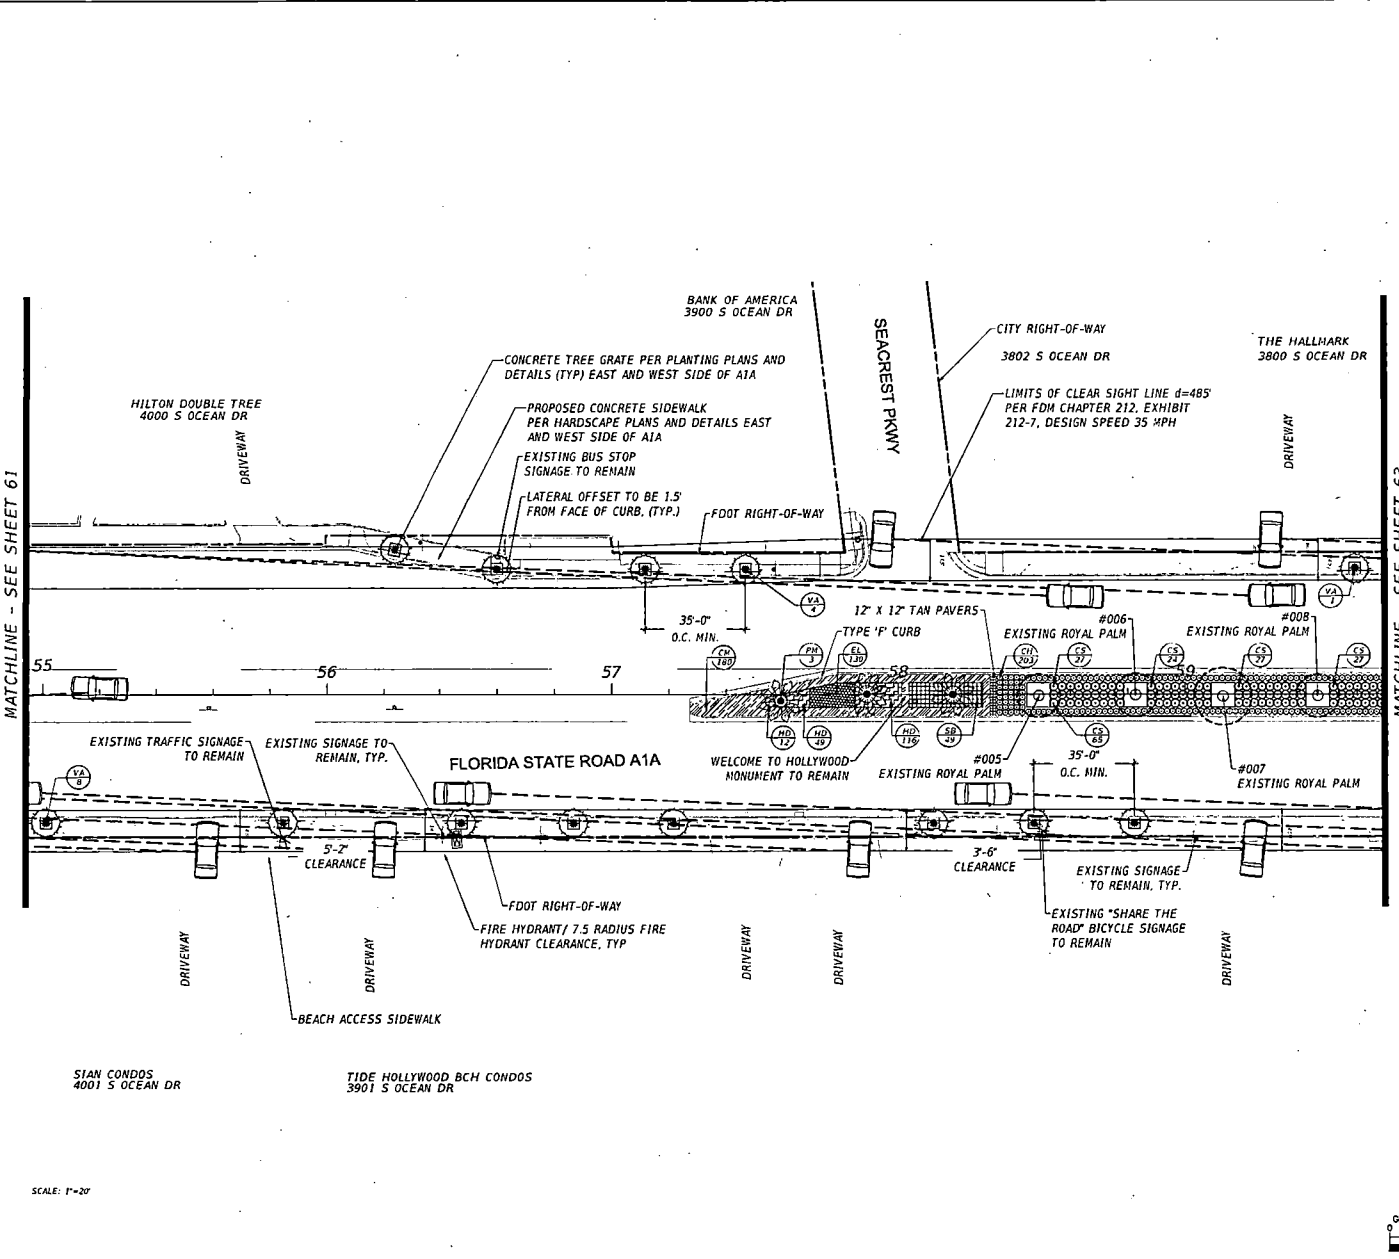


SCALE: 1"=20'

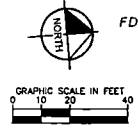


FDOT PERMIT #2023-L-491-00009

Kimley-Horn LANDSCAPE ARCHITECTS 1830 MCNAY WAY, SUITE 200, WEST PALM BEACH, FL 33411 PHONE: 561-844-8665 FAX: 561-844-8715 WWW.KIMLEY-HORN.COM RECEIPT NO. 3006		LUDIA EXHIBIT DRAWINGS 12.19.2024 NS
LANDSCAPE PLAN		NO. _____ REVISIONS _____ DATE _____ BY _____
PHASE IV SR A1A UNDERGROUNDING OF OVERHEAD UTILITIES AND STREETScape BEAUTIFICATION PREPARED FOR HOLLYWOOD CRA HOLLYWOOD, FL		KHA PROJECT 044241032 DATE 04/20/24 SCALE 1/8"=1'-0" DESIGNED BY JH DRAWN BY JAC/TH/MS CHECKED BY TR
SHEET NUMBER 62		12.19.2024 NS

THIS DOCUMENT, TOGETHER WITH THE PRELIMINARY AND FINAL PLANS, IS TO BE USED FOR THE PURPOSES OF PERMITTING AND CONSTRUCTION OF THE PROJECT ONLY. IT IS NOT TO BE USED FOR ANY OTHER PURPOSE. ANY REVISIONS TO THIS DOCUMENT SHALL BE INDICATED BY A REVISION TABLE. THE USER SHALL BE RESPONSIBLE FOR OBTAINING ALL NECESSARY PERMITS AND APPROVALS FROM THE APPROPRIATE AGENCIES. THE USER SHALL BE RESPONSIBLE FOR OBTAINING ALL NECESSARY PERMITS AND APPROVALS FROM THE APPROPRIATE AGENCIES. THE USER SHALL BE RESPONSIBLE FOR OBTAINING ALL NECESSARY PERMITS AND APPROVALS FROM THE APPROPRIATE AGENCIES.

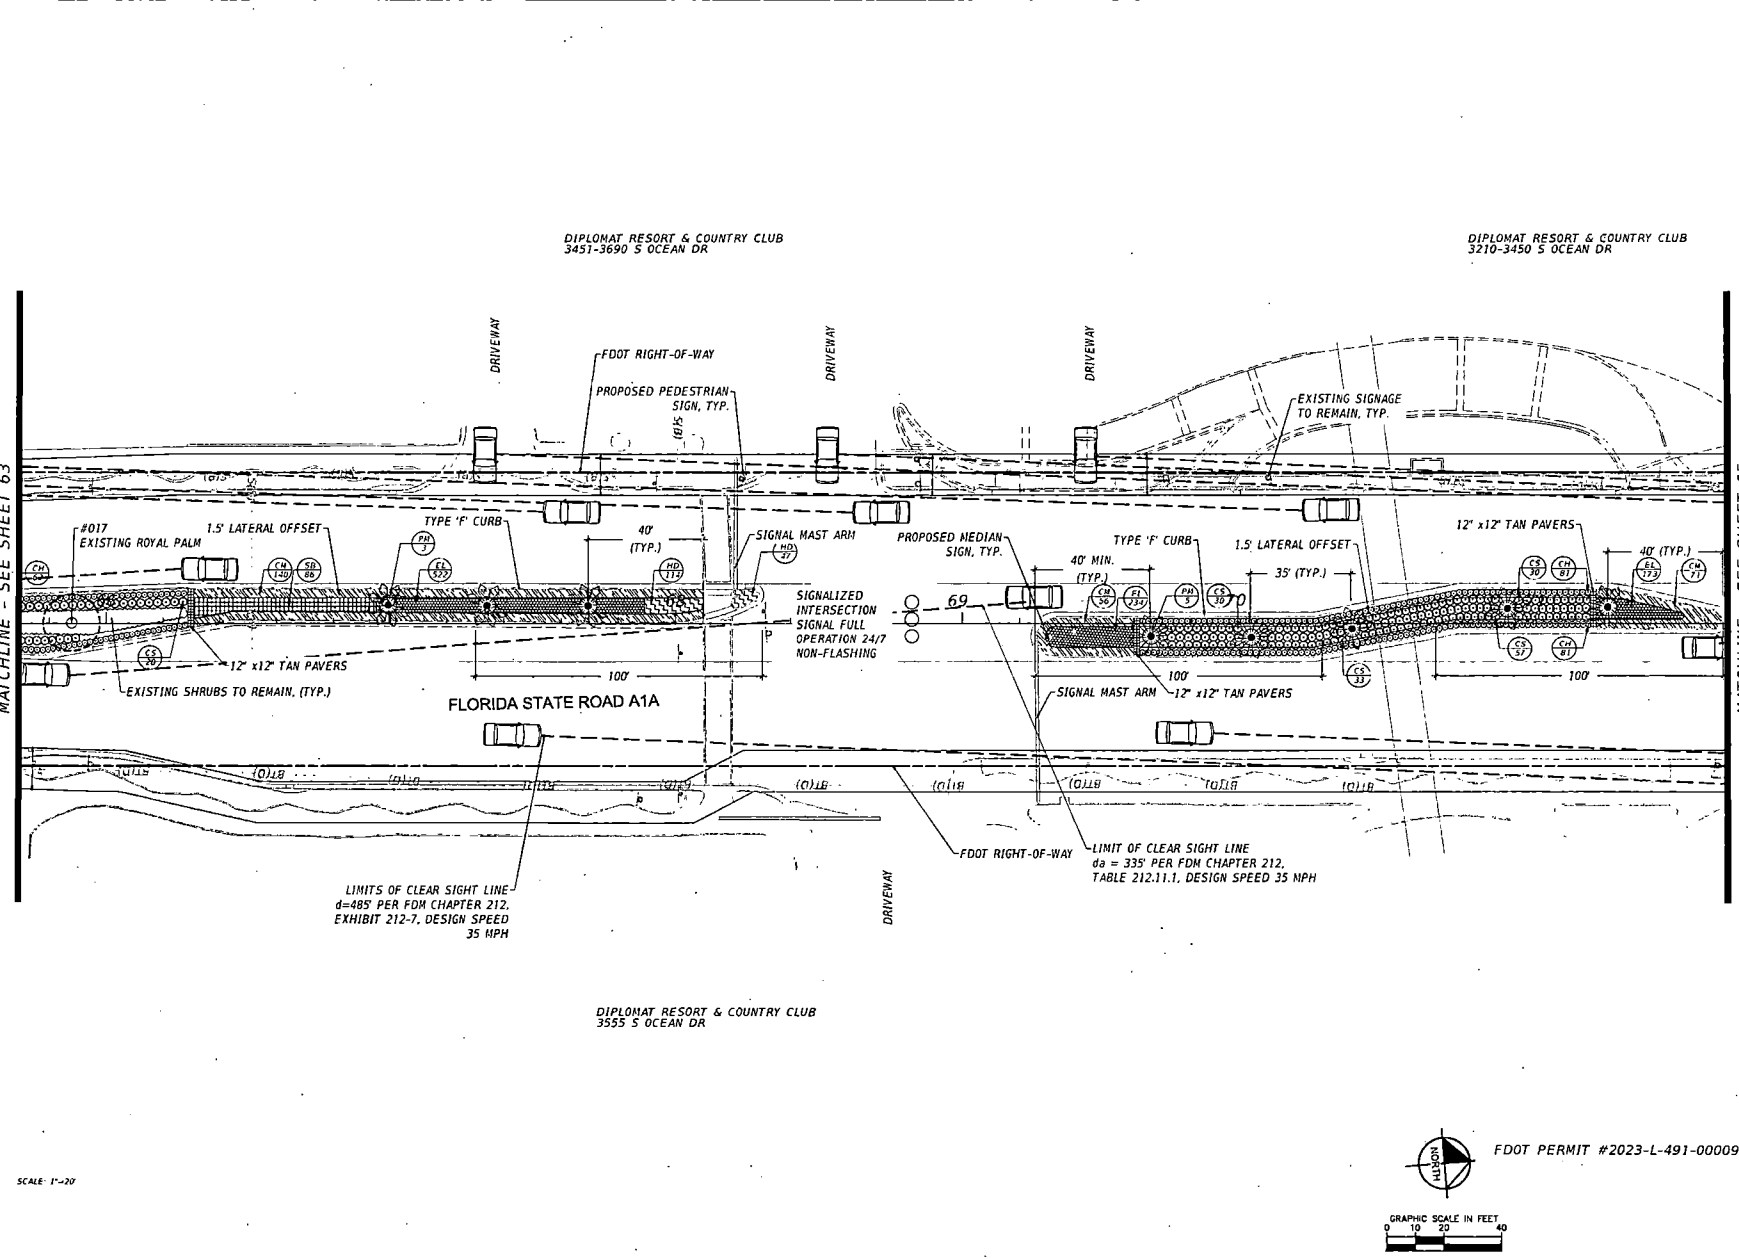

SCALE: 1"=20'

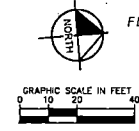


FDOT PERMIT #2023-L-491-00009

Kimley-Horn 200 N. W. 10th Ave., Suite 200, Fort Lauderdale, FL 33441 PHONE: 561-444-0000 FAX: 561-444-0001 WWW.KIMLEY-HORN.COM		MADA EXHIBIT DRAWINGS 12.19.2024 NS
LANDSCAPE PLAN		REVISIONS NO. DATE BY
PHASE IV SR A1A UNDERGROUNDING OF OVERHEAD UTILITIES AND STREETSCAPE BEAUTIFICATION PREPARED FOR HOLLYWOOD CRA HOLLYWOOD FL		64
HVA PROJECT 044241032 DATE: DECEMBER 2024 SCALE: AS SHOWN DESIGNED BY: JH DRAWN BY: JH/RL CHECKED BY: TR DATE: 12/19/2024		100%


THIS DOCUMENT, INCLUDING ALL THE CONTENTS AND ANY REVISIONS, IS THE PROPERTY OF KIMLEY-HORN AND ASSOCIATES, INC. IT IS TO BE USED ONLY FOR THE PROJECT AND SITE SPECIFIC PURPOSES AND SHALL BE RETURNED TO KIMLEY-HORN AND ASSOCIATES, INC. UPON COMPLETION OF THE PROJECT. NO PART OF THIS DOCUMENT IS TO BE REPRODUCED OR TRANSMITTED IN ANY FORM OR BY ANY MEANS, ELECTRONIC OR MECHANICAL, INCLUDING PHOTOCOPYING, RECORDING, OR BY ANY INFORMATION STORAGE AND RETRIEVAL SYSTEM, WITHOUT PERMISSION IN WRITING FROM KIMLEY-HORN AND ASSOCIATES, INC.

MATCHLINE - SEE SHEET 64

MATCHLINE - SEE SHEET 66

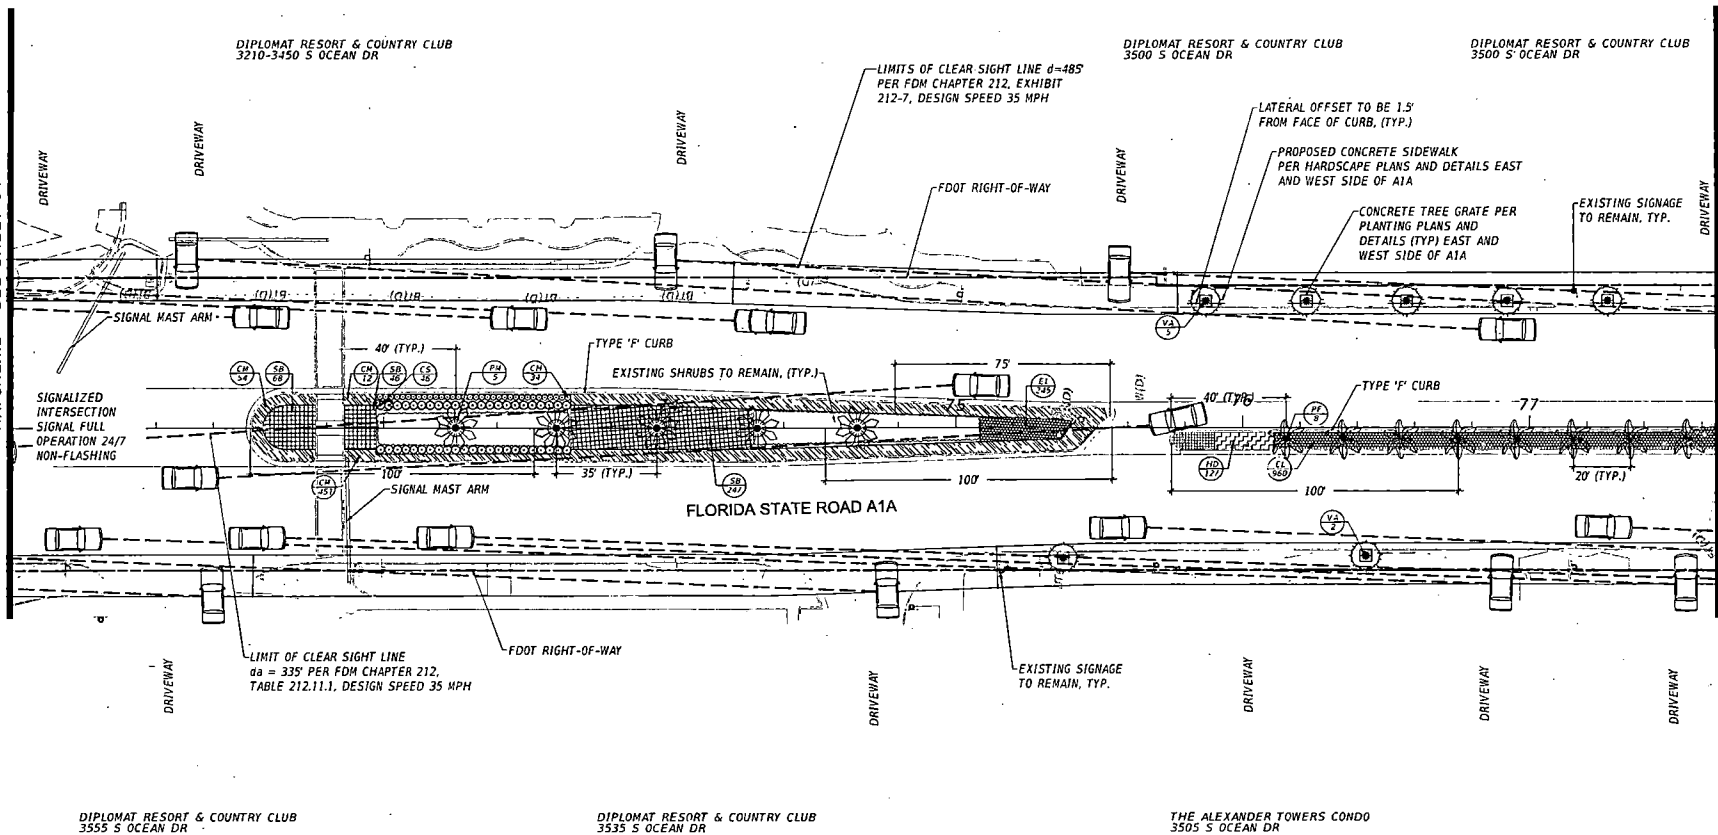


SCALE: 1"=20'

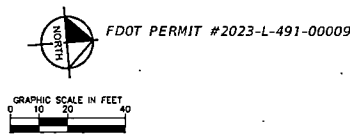

KIMLEY-HORN & ASSOCIATES, INC. 1920 MONROE WAY, SUITE 200, WEST PALM BEACH, FL 33411 PHONE: 561-845-0843 FAX: 561-852-8933 WWW.KIMLEY-HORN.COM ACCOUNT NO. 3090		NO.	DATE
REVISIONS			
MADA EXHIBIT DRAWINGS		12.19.2024	NS

PHASE IV SR A1A UNDERGROUNDING OF OVERHEAD UTILITIES AND STREETSCAPE BEAUTIFICATION PREPARED FOR	LANDSCAPE PLAN	FL
HOLLYWOOD CRA		


SHEET NUMBER	65
--------------	----

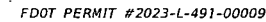


SHEET NUMBER
67

THIS DOCUMENT, TOGETHER WITH THE CONTRACT AND ALL OTHER DOCUMENTS, IS THE PROPERTY OF KIMLEY-HORN. IT IS TO BE USED ONLY FOR THE PROJECT AND SITE SPECIFICALLY IDENTIFIED HEREIN. IT IS NOT TO BE REPRODUCED, COPIED, OR TRANSMITTED IN ANY FORM OR BY ANY MEANS, ELECTRONIC OR MECHANICAL, INCLUDING PHOTOCOPYING, RECORDING, OR BY ANY INFORMATION STORAGE AND RETRIEVAL SYSTEM, WITHOUT THE WRITTEN PERMISSION OF KIMLEY-HORN. ANY UNAUTHORIZED USE OF THIS DOCUMENT IS PROHIBITED AND WILL BE AT THE USER'S SOLE RISK. KIMLEY-HORN ASSUMES NO LIABILITY FOR NEGLIGENCE OR OTHERWISE.

MATCHLINE - SEE SHEET 67

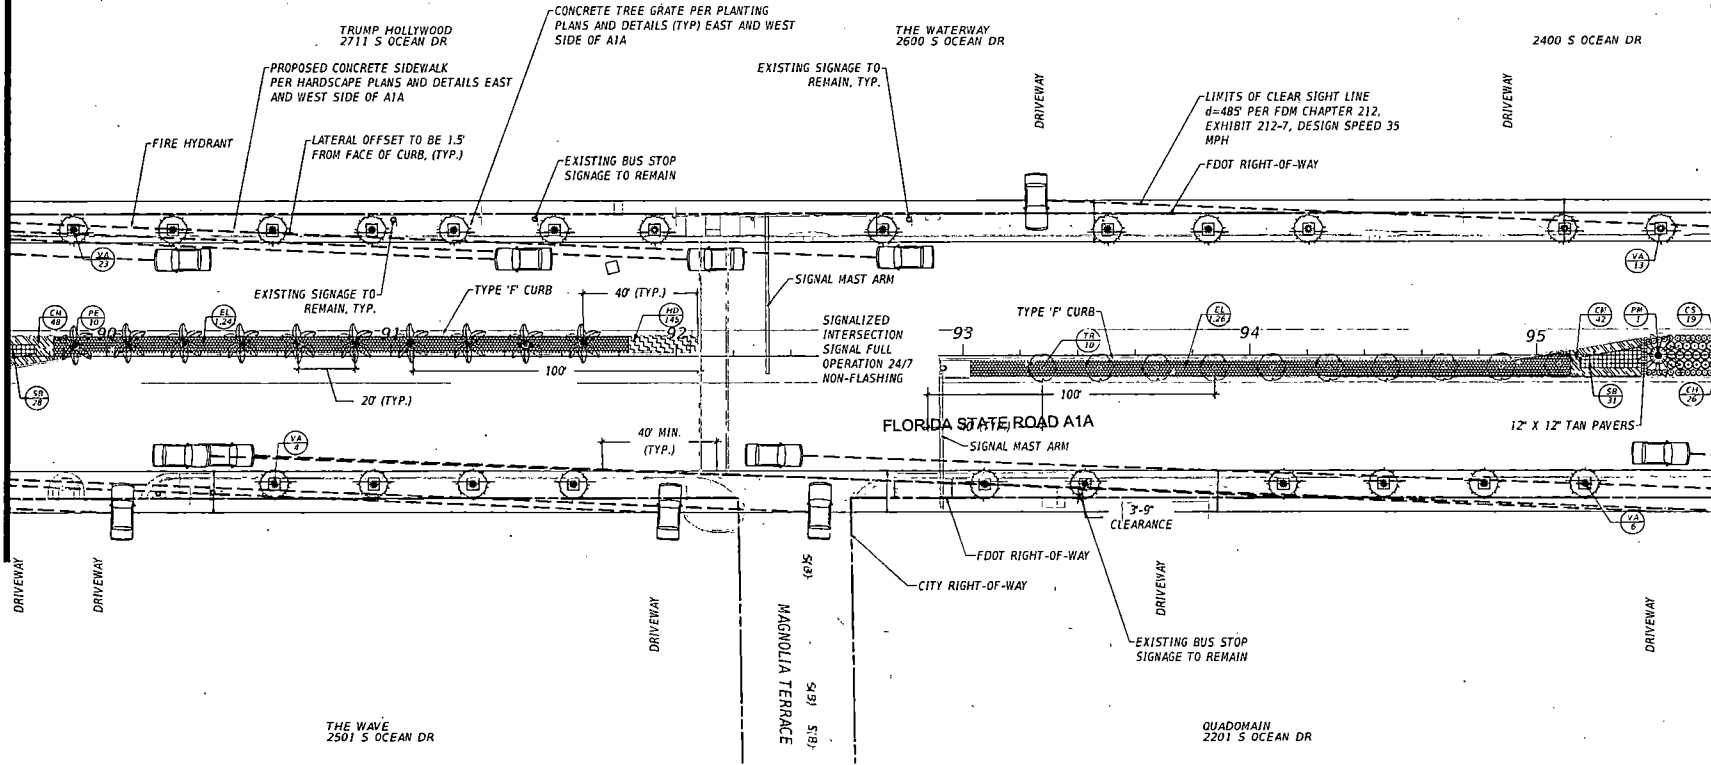


SCALE: 1"=20'

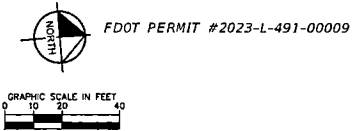

MATCHLINE - SEE SHEET 69

PHASE IV SR 1A UNDERROUNDING OF OVERROAD UTILITIES AND STREETScape BEAUTIFICATION PREPARED FOR HOLLYWOOD CRA		FL	
SHEET NUMBER		68	
LANDSCAPE PLAN		Kimley-Horn	
KIMLEY-HORN & ASSOCIATES, INC.		1000 N. W. 10th Ave., Suite 200, Fort Lauderdale, FL 33411	
PHONE: 561-445-5555 FAX: 561-445-5555		WWW.KIMLEY-HORN.COM	
DESIGNED BY		TR	
CHECKED BY		JH	
DATE		12/19/2024	
PROJECT NO.		2023-00009	
SHEET NO.		68	
REVISIONS			
NO.			
DATE			
BY			

THIS DOCUMENT, TOGETHER WITH THE SPECIFICATIONS, SHALL BE KEPT TOGETHER AND TREATED AS ONE. IT IS THE RESPONSIBILITY OF THE USER TO OBTAIN ALL NECESSARY PERMITS AND TO OBTAIN ALL NECESSARY INFORMATION FROM THE LOCAL AUTHORITIES. THE USER SHALL BE RESPONSIBLE FOR OBTAINING ALL NECESSARY INFORMATION FROM THE LOCAL AUTHORITIES. THE USER SHALL BE RESPONSIBLE FOR OBTAINING ALL NECESSARY INFORMATION FROM THE LOCAL AUTHORITIES.

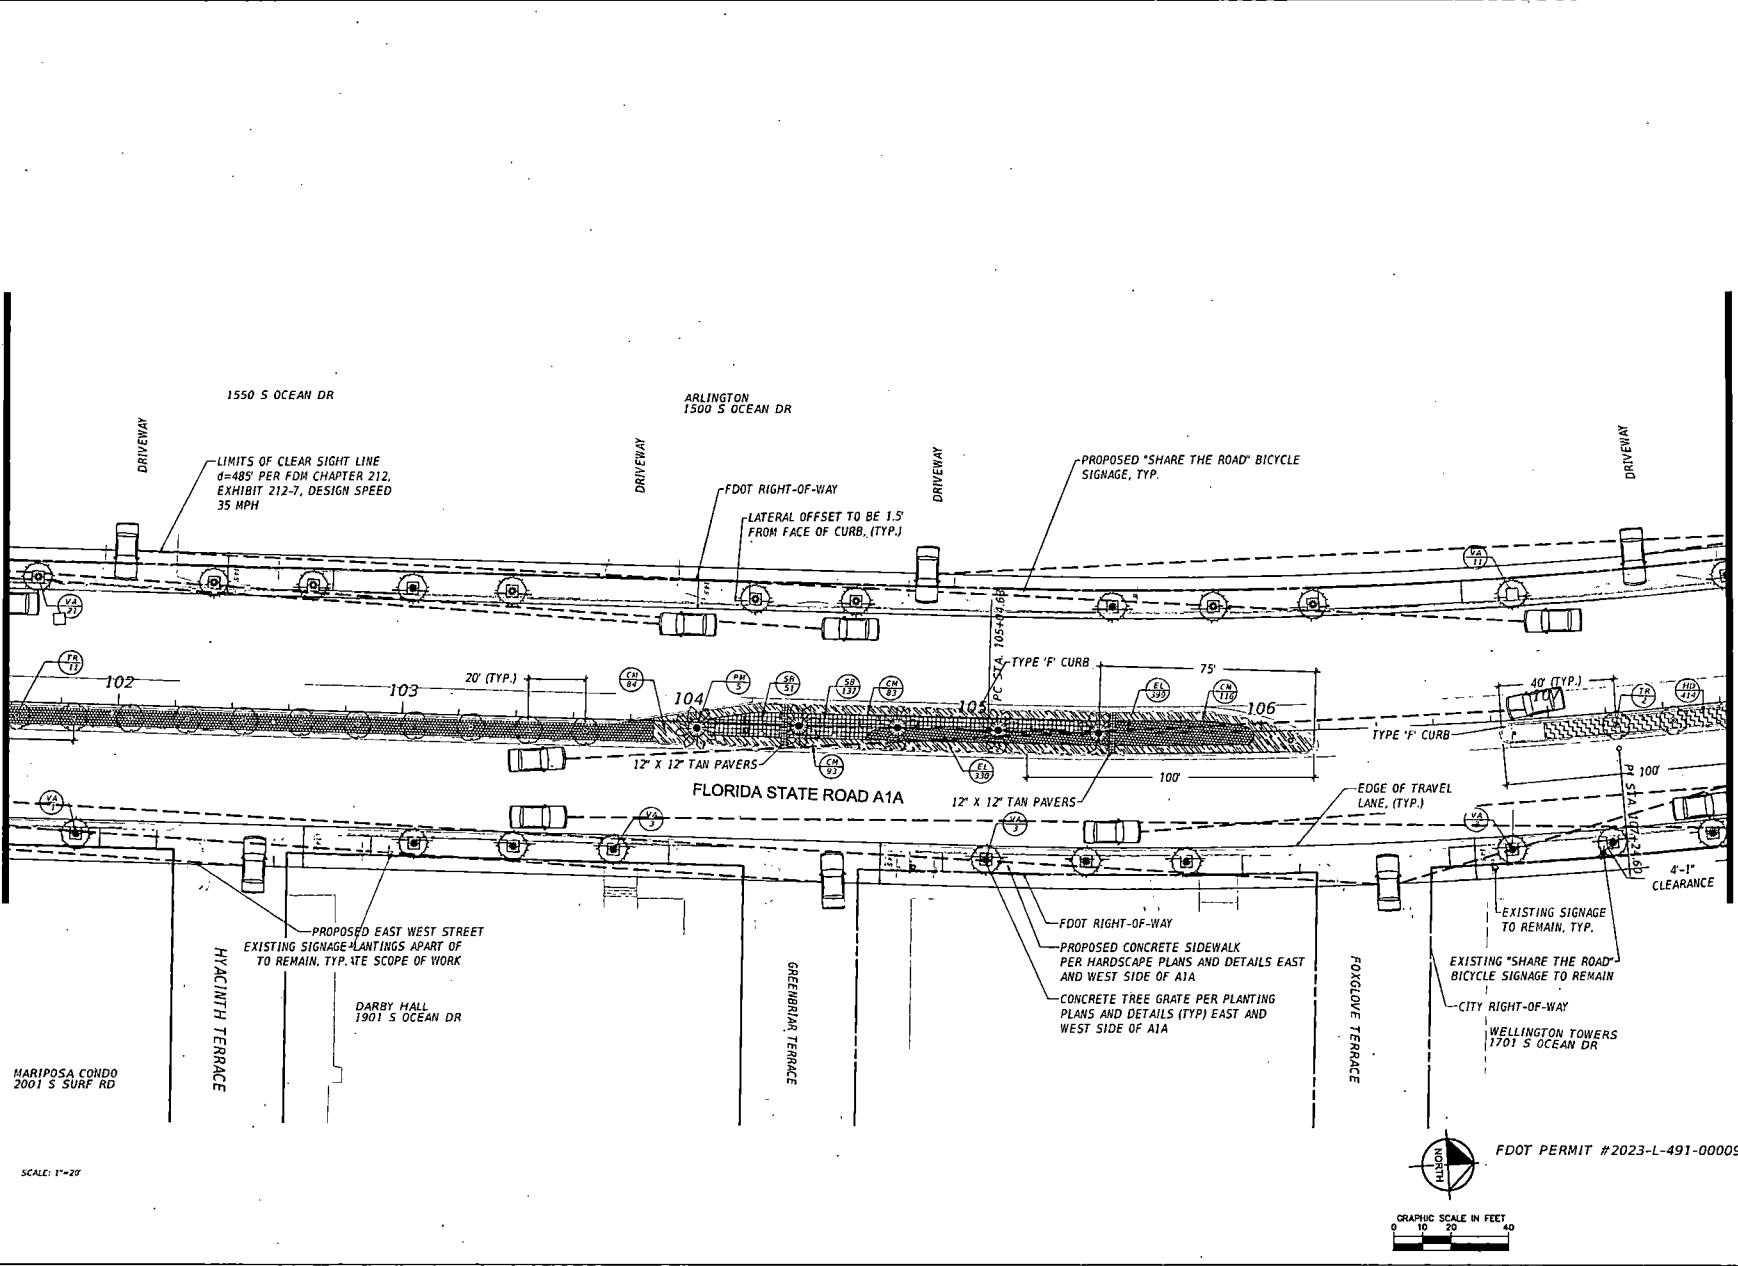

LANDSCAPE PLAN

PHASE IV SR A1A UNDERGROUNDING OF OVERHEAD UTILITIES AND STREETScape BEAUTIFICATION PREPARED FOR HOLLYWOOD CRA HOLLYWOOD FL

Kimley»Horn

© 2024 KIMLEY-HORN AND ASSOCIATES, INC. 33441
1900 PINEHURST, SUITE 200, FORT MYERS, FL 33901
PHONE: 888-888-8888 FAX: 888-888-8888
WWW.KIMLEY-HORN.COM REGISTRY NO. 33015

PROJECT: 044241032
DATE: 2024
SCALE: AS SHOWN
DESIGNED BY: JH
DRAWN BY: JH
CHECKED BY: JH
DATE: 12/19/2024

REVISIONS

No.	REVISIONS	DATE
1		
2		
3		
4		
5		
6		
7		
8		
9		
10		

GRAPHIC SCALE IN FEET



0 10 20 40

FDOT PERMIT #2023-L-491-00009

SCALE: 1"=20'

MATCHLINE - SEE SHEET 69

THIS DOCUMENT, TOGETHER WITH THE CONTRACT AND SPECIFICATIONS, SHALL BE KEPT ON THE PROJECT SITE AT ALL TIMES. IT IS THE RESPONSIBILITY OF THE ENGINEER TO PROVIDE ADEQUATE INFORMATION AND INSTRUCTIONS TO THE CONTRACTOR. THE ENGINEER SHALL BE RESPONSIBLE FOR THE ACCURACY OF THE INFORMATION AND INSTRUCTIONS PROVIDED. THE ENGINEER SHALL BE RESPONSIBLE FOR THE ACCURACY OF THE INFORMATION AND INSTRUCTIONS PROVIDED. THE ENGINEER SHALL BE RESPONSIBLE FOR THE ACCURACY OF THE INFORMATION AND INSTRUCTIONS PROVIDED.

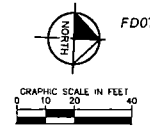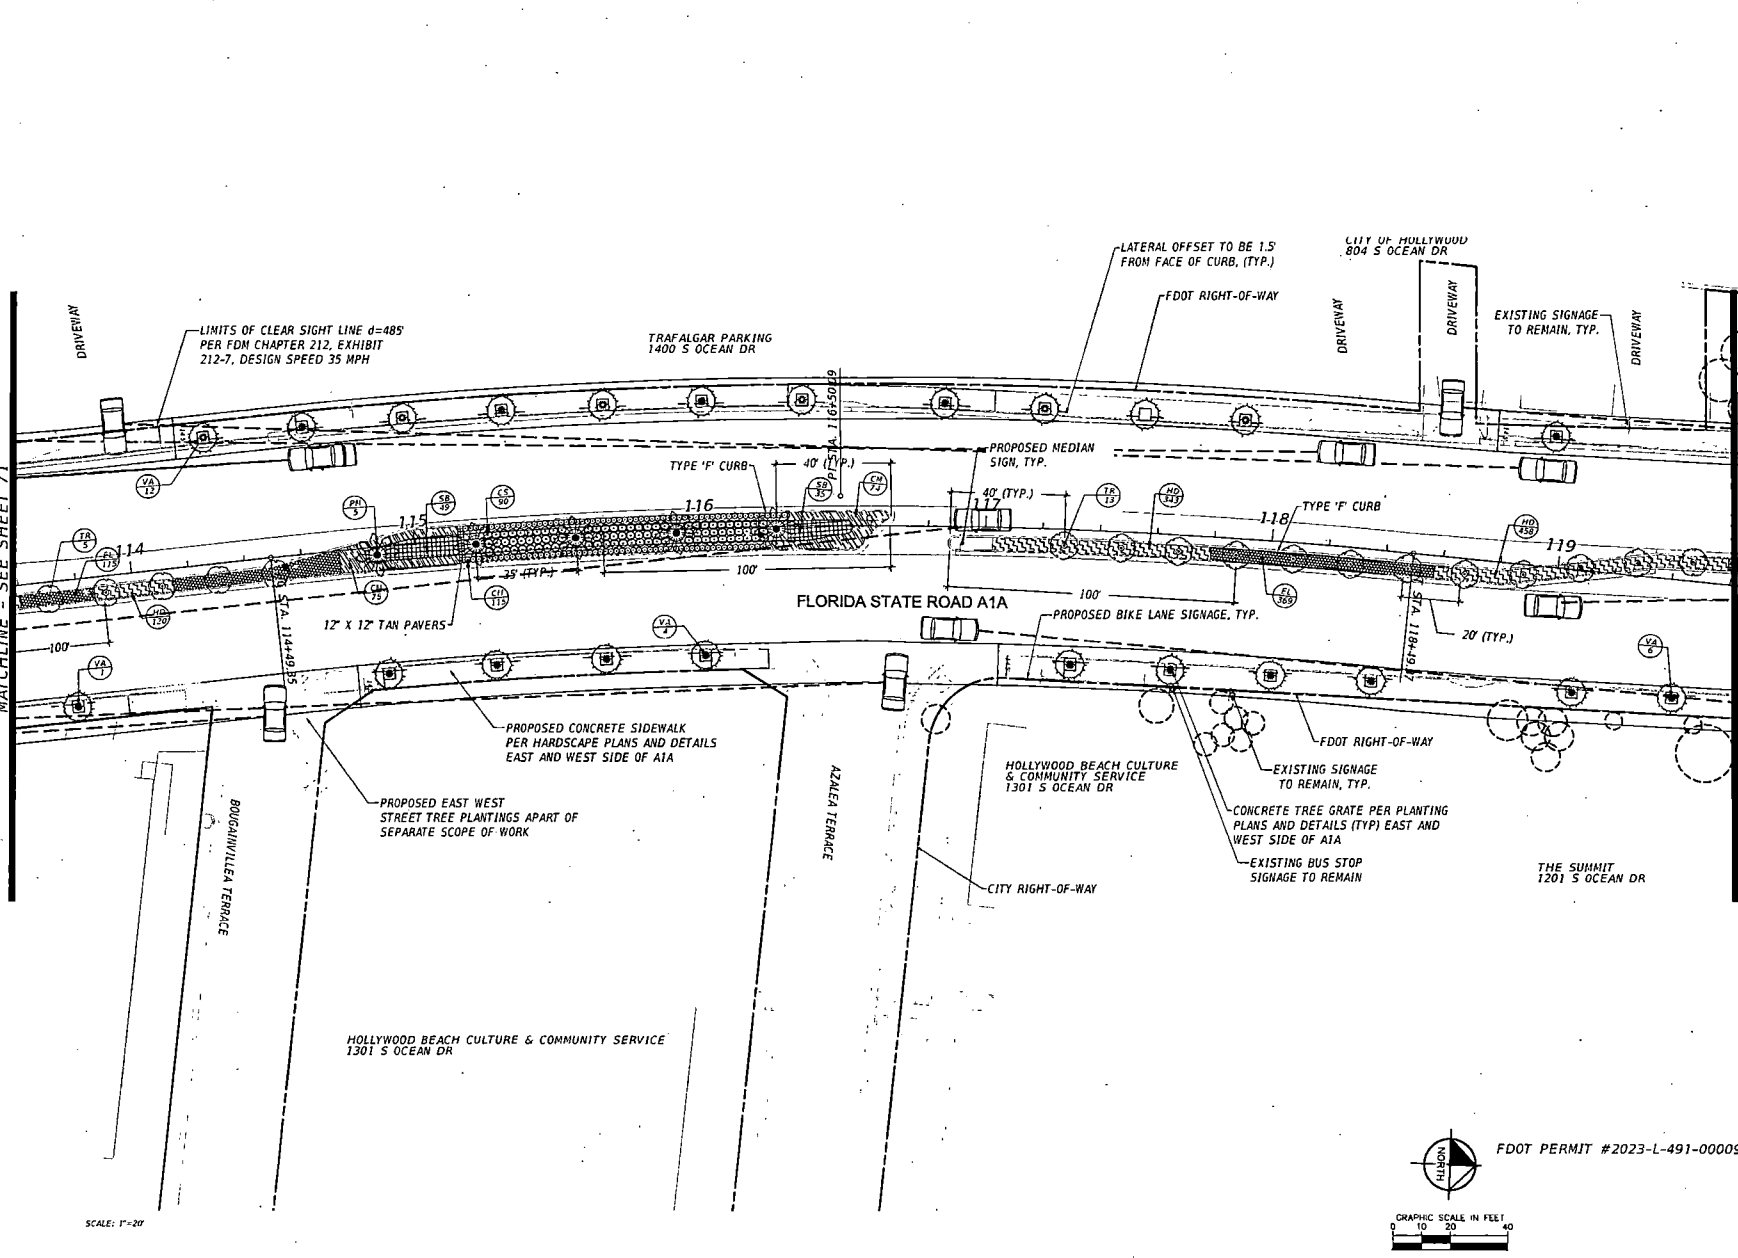

PHASE IV SR A1A UNDERGROUNDING OF OVERHEAD UTILITIES AND STREETScape BEAUTIFICATION PREPARED FOR HOLLYWOOD CRA HOLLYWOOD

LANDSCAPE PLAN

FL

DATE: 08/24/2022
SCALE: 1"=20'
DESIGNED BY: J.D.
CHECKED BY: J.D.
PREPARED BY: J.D.

PROJECT: 044241032
SHEET: 004
SCALE: 1"=20'
DESIGNED BY: J.D.
CHECKED BY: J.D.
PREPARED BY: J.D.

DATE: 08/24/2022
SCALE: 1"=20'
DESIGNED BY: J.D.
CHECKED BY: J.D.
PREPARED BY: J.D.

Kimley»Horn


1000 N. WILSON ROAD, SUITE 100, FORT MYERS, FL 33901
PHONE: 888-845-0845 FAX: 888-845-0845
WWW.KIMLEY-HORN.COM REGISTRY NO. 3518

LOCAL EXHIBIT DRAWINGS 12/19/2024 NS

REVISIONS

DATE

BY

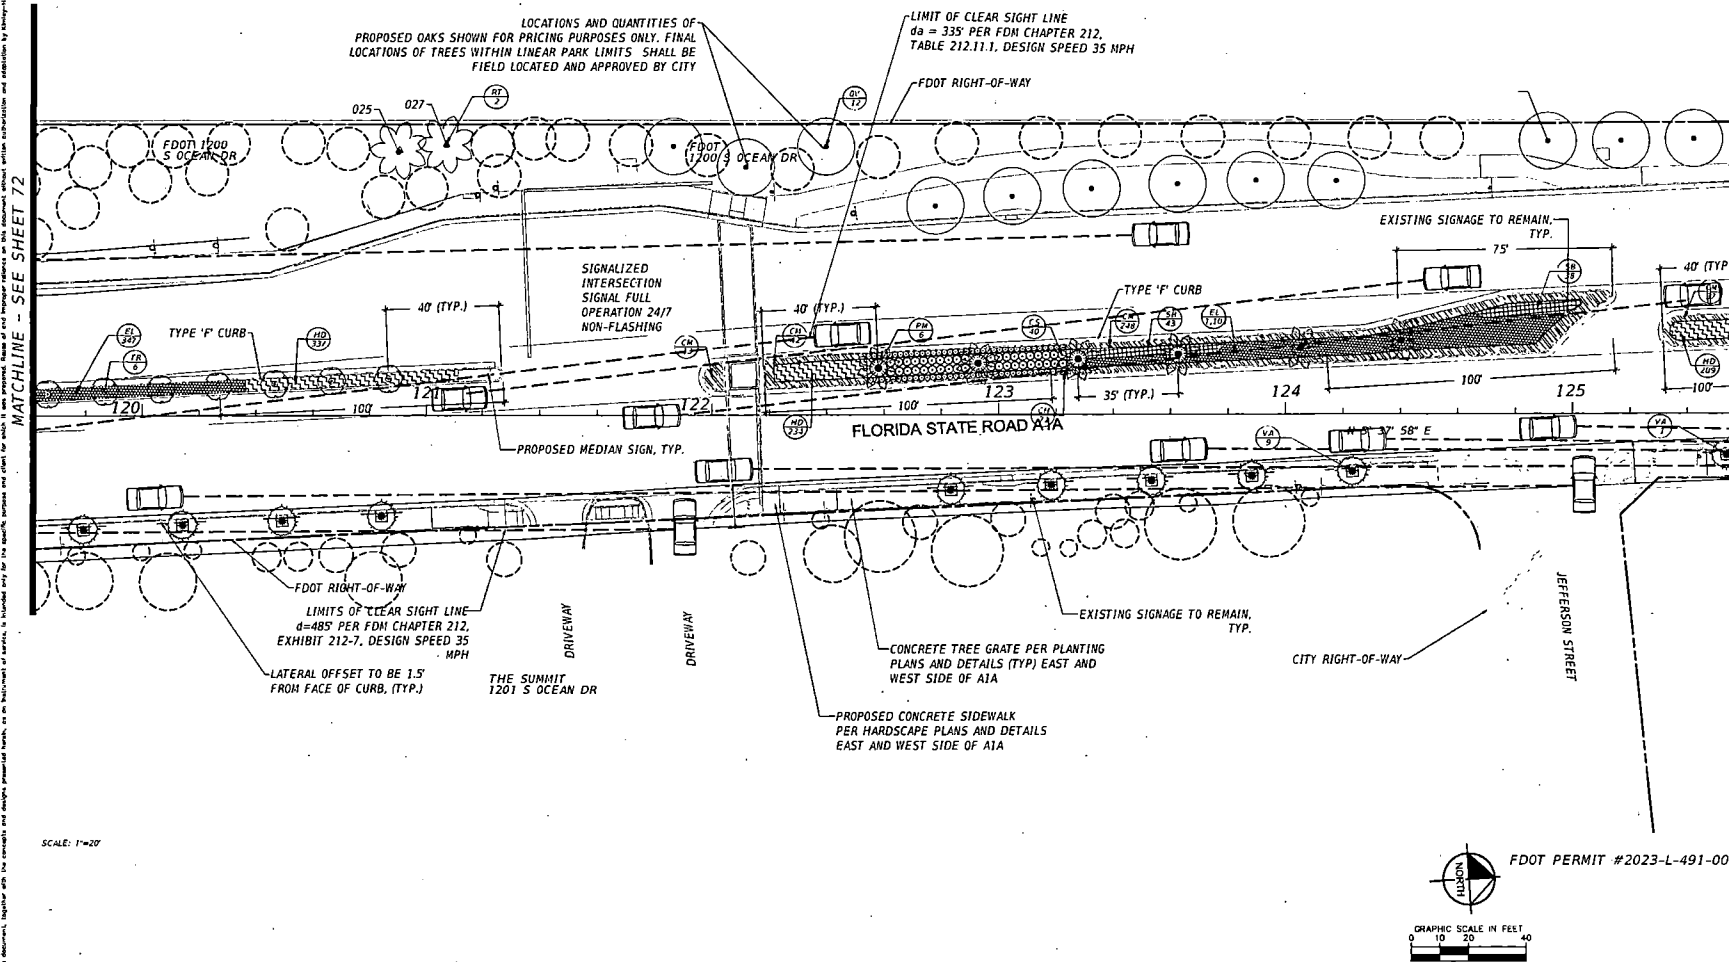

FDOT PERMIT #2023-L-491-00009

GRAPHIC SCALE IN FEET
0 10 20

MATCHLINE - SEE SHEET 74


Kimley»»Horn
© 2021 KIMLEY-HORN AND ASSOCIATES, INC.
1920 HODIVA WAY SUITE 200, WEST PALM BEACH, FL 33411
PHONE: 561-845-0855 FAX: 561-853-8175
WWW.KIMLEY-HORN.COM REGISTRY NO. 35106

LANDSCAPE PLAN


PHASE IV SR 174 UNDERGROUNDING OF
OVERHEAD UTILITIES AND
STREETSCAPE BEAUTIFICATION
PREPARED FOR
HOLLYWOOD CRA

SHEET NUMBER
73

THIS DOCUMENT, INCLUDING ALL THE CONTENTS AND ANY PART THEREOF, IS THE PROPERTY OF KIMLEY-HORN AND ASSOCIATES, INC. IT IS TO BE USED ONLY FOR THE PROJECT AND SITE SPECIFICALLY IDENTIFIED HEREON. IT IS NOT TO BE REPRODUCED, COPIED, OR TRANSMITTED IN ANY FORM OR BY ANY MEANS, ELECTRONIC OR MECHANICAL, INCLUDING PHOTOCOPYING, RECORDING, OR BY ANY INFORMATION STORAGE AND RETRIEVAL SYSTEM, WITHOUT THE WRITTEN PERMISSION OF KIMLEY-HORN AND ASSOCIATES, INC.

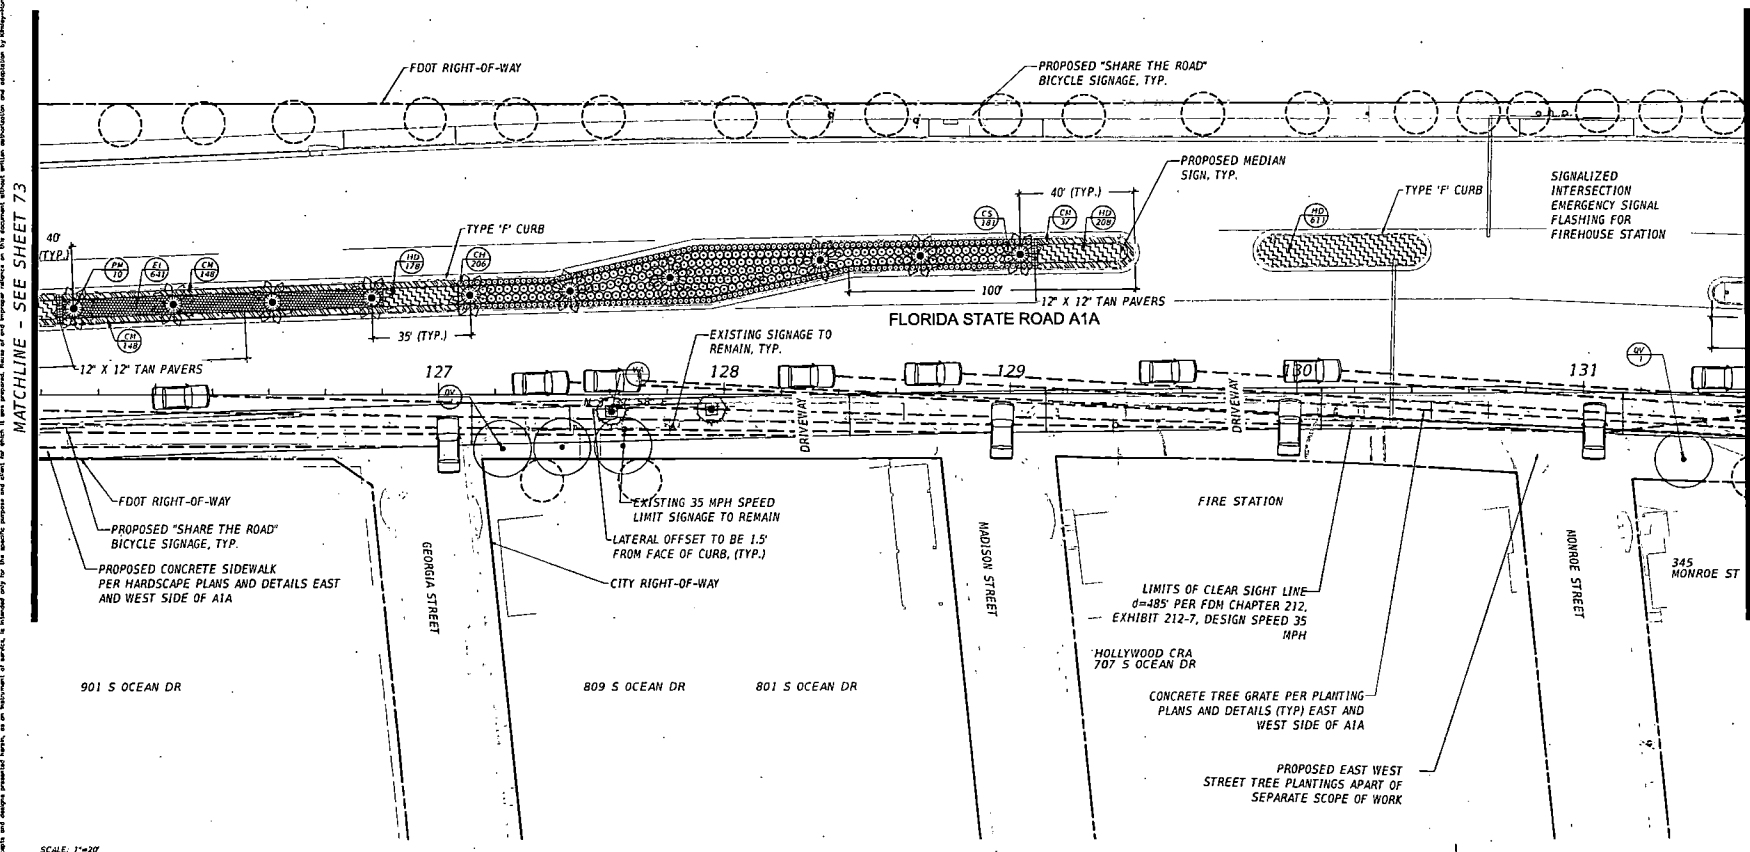

SCALE: 1"=20'

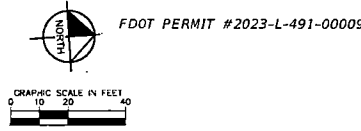

FDOT PERMIT #2023-L-491-00009

MATCHLINE - SEE SHEET 73

MATCHLINE - SEE SHEET 75


Kimley-Horn KIMLEY-HORN AND ASSOCIATES, INC. 1000 MONROE AVE. SUITE 200, WEST PALM BEACH, FL 33411 PHONE: 561-845-0000 FAX: 561-852-8178 WWW.KIMLEY-HORN.COM REGISTRY NO. 3006		MADA EXHIBIT DRAWINGS 12.03.2024 NS	
PROJECT: K1A PROJECT 044141032		LOANED PROFESSIONAL	
DATE: 02/02/2024		AUTHORITY: T. HUGH, P.E.	
SCALE: AS SHOWN		RECORD BY: JH	
DRAWN BY: JH/RE		CHECKED BY: TR	
DATE: 02/19/2024		REVISIONS	
DATE		BY	

PHASE IV SR 1A UNDERGROUNDING OF OVERHEAD UTILITIES AND STREETSCAPE BEAUTIFICATION PREPARED FOR HOLLYWOOD CRA HOLLYWOOD FL

SHEET NUMBER 74

THESE PLANS AND SPECIFICATIONS ARE THE PROPERTY OF KIMLEY-HORN & ASSOCIATES, INC. AND ARE NOT TO BE REPRODUCED OR TRANSMITTED IN ANY FORM OR BY ANY MEANS, ELECTRONIC OR MECHANICAL, INCLUDING PHOTOCOPYING, RECORDING, OR BY ANY INFORMATION STORAGE AND RETRIEVAL SYSTEM, WITHOUT THE WRITTEN PERMISSION OF KIMLEY-HORN & ASSOCIATES, INC. ANY UNAUTHORIZED USE OF THESE PLANS OR SPECIFICATIONS IS PROHIBITED AND WILL BE AT THE USER'S SOLE RISK. KIMLEY-HORN & ASSOCIATES, INC. IS NOT RESPONSIBLE FOR ANY ERRORS OR OMISSIONS IN THESE PLANS OR SPECIFICATIONS. THE USER SHALL BE RESPONSIBLE FOR OBTAINING ALL NECESSARY PERMITS AND APPROVALS FROM THE APPROPRIATE AGENCIES. THE USER SHALL BE RESPONSIBLE FOR OBTAINING ALL NECESSARY PERMITS AND APPROVALS FROM THE APPROPRIATE AGENCIES. THE USER SHALL BE RESPONSIBLE FOR OBTAINING ALL NECESSARY PERMITS AND APPROVALS FROM THE APPROPRIATE AGENCIES.

MATCHLINE - SEE SHEET 74

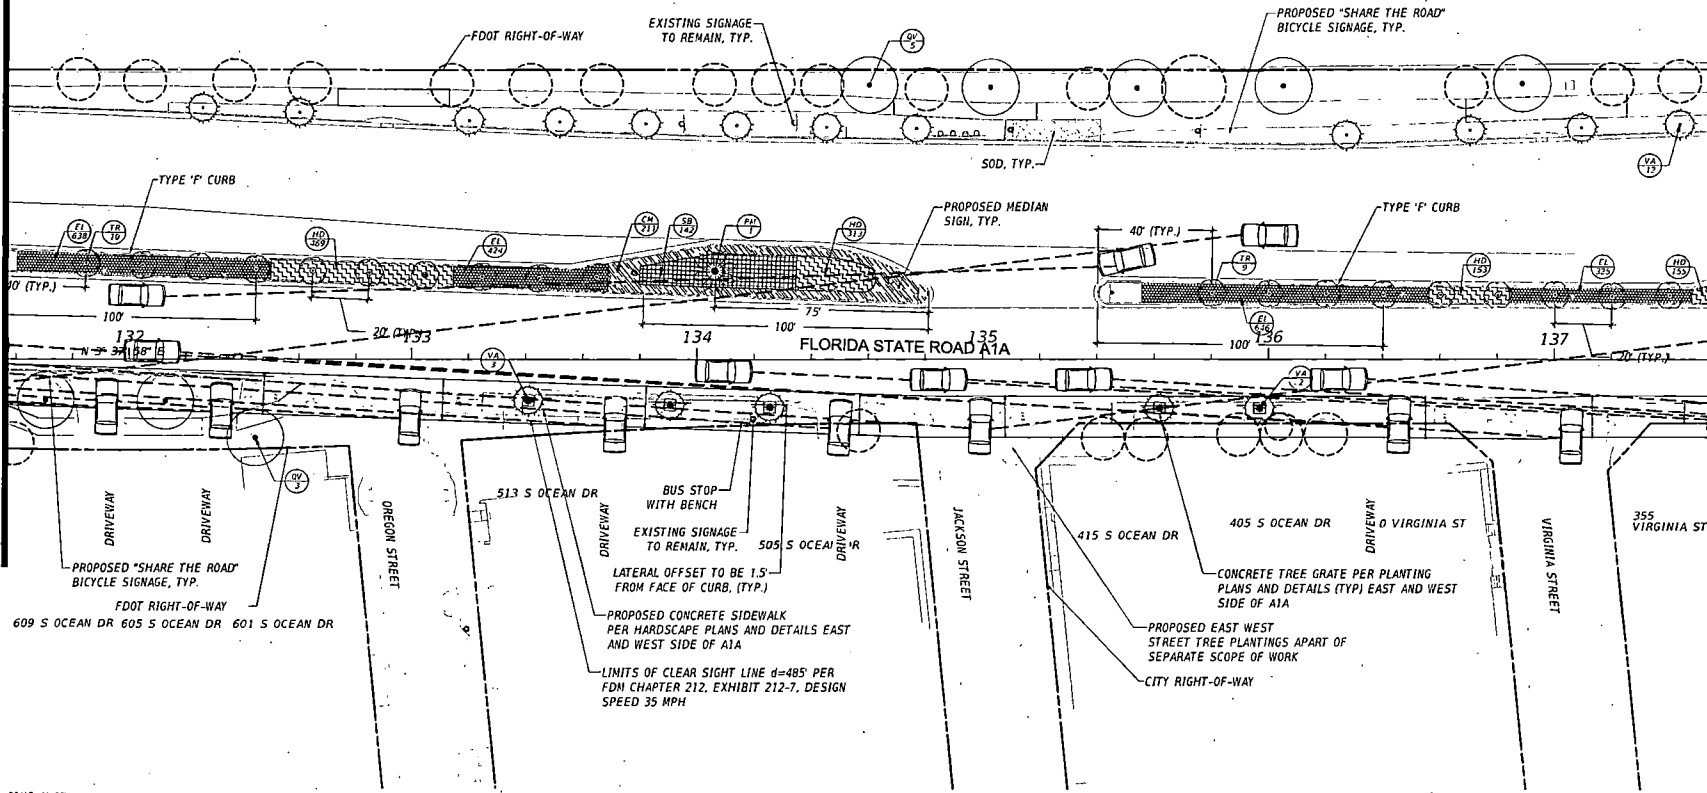

SCALE: 1"=20'




FDOT PERMIT #2023-L-491-00009

MATCHLINE - SEE SHEET 76

KIMLEY-HORN & ASSOCIATES, INC.		12/19/2024	
PROJECT: PHASE IV SR 1A UNDERGROUNDING OF OVERHEAD UTILITIES AND STREETScape BEAUTIFICATION PREPARED FOR HOLLYWOOD CRA HOLLYWOOD		SHEET NUMBER 75	
N/A PROJECT 044241032		DATE 2024	
DESIGNED BY JH		CHECKED BY JH	
SCALE AS SHOWN		DRAWN BY JH	
NAME RUC/TH/RE		DATE 12/19/2024	
REVISIONS		DATE	
NO.		BY	

SCALE: 1"=20'

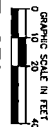


LANDSCAPE PLAN

Kimley»Horn
© 2021 KIMLEY-HORN AND ASSOCIATES, INC.
1920 WEXIVA WAY SUITE 200, WEST PALM BEACH, FL 33411
PHONE: 561-843-0565 FAX: 561-863-8175
WWW.KIMLEY-HORN.COM REGISTRY NO. 35106

MMA EXHIBIT DRAWINGS		12.19.2024	NS
No.	REVISIONS	DATE	BY

- GENERAL LANDSCAPE SPECIFICATIONS AND NOTES
1. THE WORK CONSISTS OF: FURNISHING ALL LABOR, MATERIALS, EQUIPMENT, TOOLS, AND SUPPLIES NECESSARY FOR THE COMPLETION OF THE LANDSCAPE DESIGN AND CONSTRUCTION OF THE LANDSCAPE ARCHITECT'S DESIGN.
 2. THE CONTRACTOR SHALL BE RESPONSIBLE FOR OBTAINING ALL NECESSARY PERMITS AND APPROVALS FROM THE APPROPRIATE AGENCIES AND AGENCIES.
 3. THE CONTRACTOR SHALL BE RESPONSIBLE FOR OBTAINING ALL NECESSARY PERMITS AND APPROVALS FROM THE APPROPRIATE AGENCIES AND AGENCIES.
 4. THE CONTRACTOR SHALL BE RESPONSIBLE FOR OBTAINING ALL NECESSARY PERMITS AND APPROVALS FROM THE APPROPRIATE AGENCIES AND AGENCIES.
 5. THE CONTRACTOR SHALL BE RESPONSIBLE FOR OBTAINING ALL NECESSARY PERMITS AND APPROVALS FROM THE APPROPRIATE AGENCIES AND AGENCIES.
 6. THE CONTRACTOR SHALL BE RESPONSIBLE FOR OBTAINING ALL NECESSARY PERMITS AND APPROVALS FROM THE APPROPRIATE AGENCIES AND AGENCIES.
 7. THE CONTRACTOR SHALL BE RESPONSIBLE FOR OBTAINING ALL NECESSARY PERMITS AND APPROVALS FROM THE APPROPRIATE AGENCIES AND AGENCIES.
 8. THE CONTRACTOR SHALL BE RESPONSIBLE FOR OBTAINING ALL NECESSARY PERMITS AND APPROVALS FROM THE APPROPRIATE AGENCIES AND AGENCIES.
 9. THE CONTRACTOR SHALL BE RESPONSIBLE FOR OBTAINING ALL NECESSARY PERMITS AND APPROVALS FROM THE APPROPRIATE AGENCIES AND AGENCIES.
 10. THE CONTRACTOR SHALL BE RESPONSIBLE FOR OBTAINING ALL NECESSARY PERMITS AND APPROVALS FROM THE APPROPRIATE AGENCIES AND AGENCIES.

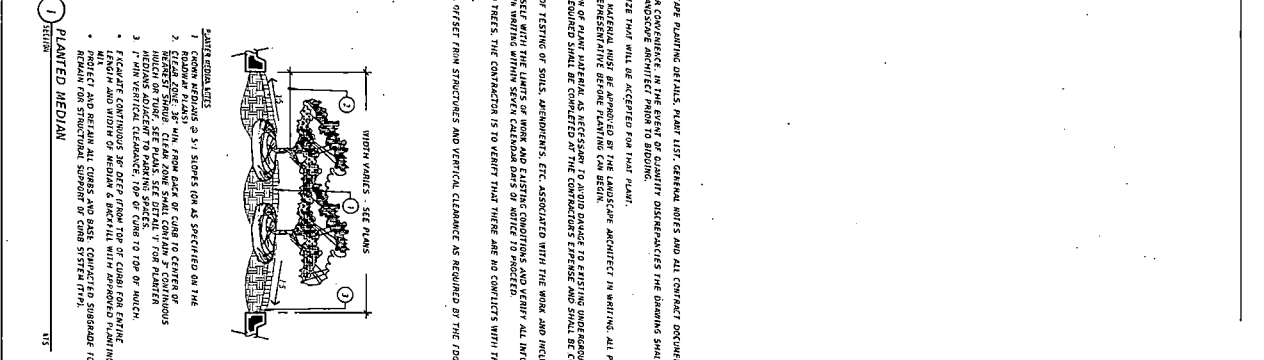



- PLANTED MEDIAN
1. THE PLANTING SHALL BE DONE IN ACCORDANCE WITH THE FOLLOWING SPECIFICATIONS:
 2. THE PLANTING SHALL BE DONE IN ACCORDANCE WITH THE FOLLOWING SPECIFICATIONS:
 3. THE PLANTING SHALL BE DONE IN ACCORDANCE WITH THE FOLLOWING SPECIFICATIONS:
 4. THE PLANTING SHALL BE DONE IN ACCORDANCE WITH THE FOLLOWING SPECIFICATIONS:
 5. THE PLANTING SHALL BE DONE IN ACCORDANCE WITH THE FOLLOWING SPECIFICATIONS:
 6. THE PLANTING SHALL BE DONE IN ACCORDANCE WITH THE FOLLOWING SPECIFICATIONS:
 7. THE PLANTING SHALL BE DONE IN ACCORDANCE WITH THE FOLLOWING SPECIFICATIONS:
 8. THE PLANTING SHALL BE DONE IN ACCORDANCE WITH THE FOLLOWING SPECIFICATIONS:
 9. THE PLANTING SHALL BE DONE IN ACCORDANCE WITH THE FOLLOWING SPECIFICATIONS:
 10. THE PLANTING SHALL BE DONE IN ACCORDANCE WITH THE FOLLOWING SPECIFICATIONS:

- GENERAL LANDSCAPE SPECIFICATIONS AND NOTES
1. THE WORK CONSISTS OF: FURNISHING ALL LABOR, MATERIALS, EQUIPMENT, TOOLS, AND SUPPLIES NECESSARY FOR THE COMPLETION OF THE LANDSCAPE DESIGN AND CONSTRUCTION OF THE LANDSCAPE ARCHITECT'S DESIGN.
 2. THE CONTRACTOR SHALL BE RESPONSIBLE FOR OBTAINING ALL NECESSARY PERMITS AND APPROVALS FROM THE APPROPRIATE AGENCIES AND AGENCIES.
 3. THE CONTRACTOR SHALL BE RESPONSIBLE FOR OBTAINING ALL NECESSARY PERMITS AND APPROVALS FROM THE APPROPRIATE AGENCIES AND AGENCIES.
 4. THE CONTRACTOR SHALL BE RESPONSIBLE FOR OBTAINING ALL NECESSARY PERMITS AND APPROVALS FROM THE APPROPRIATE AGENCIES AND AGENCIES.
 5. THE CONTRACTOR SHALL BE RESPONSIBLE FOR OBTAINING ALL NECESSARY PERMITS AND APPROVALS FROM THE APPROPRIATE AGENCIES AND AGENCIES.
 6. THE CONTRACTOR SHALL BE RESPONSIBLE FOR OBTAINING ALL NECESSARY PERMITS AND APPROVALS FROM THE APPROPRIATE AGENCIES AND AGENCIES.
 7. THE CONTRACTOR SHALL BE RESPONSIBLE FOR OBTAINING ALL NECESSARY PERMITS AND APPROVALS FROM THE APPROPRIATE AGENCIES AND AGENCIES.
 8. THE CONTRACTOR SHALL BE RESPONSIBLE FOR OBTAINING ALL NECESSARY PERMITS AND APPROVALS FROM THE APPROPRIATE AGENCIES AND AGENCIES.
 9. THE CONTRACTOR SHALL BE RESPONSIBLE FOR OBTAINING ALL NECESSARY PERMITS AND APPROVALS FROM THE APPROPRIATE AGENCIES AND AGENCIES.
 10. THE CONTRACTOR SHALL BE RESPONSIBLE FOR OBTAINING ALL NECESSARY PERMITS AND APPROVALS FROM THE APPROPRIATE AGENCIES AND AGENCIES.

- GENERAL LANDSCAPE SPECIFICATIONS AND NOTES
1. THE WORK CONSISTS OF: FURNISHING ALL LABOR, MATERIALS, EQUIPMENT, TOOLS, AND SUPPLIES NECESSARY FOR THE COMPLETION OF THE LANDSCAPE DESIGN AND CONSTRUCTION OF THE LANDSCAPE ARCHITECT'S DESIGN.
 2. THE CONTRACTOR SHALL BE RESPONSIBLE FOR OBTAINING ALL NECESSARY PERMITS AND APPROVALS FROM THE APPROPRIATE AGENCIES AND AGENCIES.
 3. THE CONTRACTOR SHALL BE RESPONSIBLE FOR OBTAINING ALL NECESSARY PERMITS AND APPROVALS FROM THE APPROPRIATE AGENCIES AND AGENCIES.
 4. THE CONTRACTOR SHALL BE RESPONSIBLE FOR OBTAINING ALL NECESSARY PERMITS AND APPROVALS FROM THE APPROPRIATE AGENCIES AND AGENCIES.
 5. THE CONTRACTOR SHALL BE RESPONSIBLE FOR OBTAINING ALL NECESSARY PERMITS AND APPROVALS FROM THE APPROPRIATE AGENCIES AND AGENCIES.
 6. THE CONTRACTOR SHALL BE RESPONSIBLE FOR OBTAINING ALL NECESSARY PERMITS AND APPROVALS FROM THE APPROPRIATE AGENCIES AND AGENCIES.
 7. THE CONTRACTOR SHALL BE RESPONSIBLE FOR OBTAINING ALL NECESSARY PERMITS AND APPROVALS FROM THE APPROPRIATE AGENCIES AND AGENCIES.
 8. THE CONTRACTOR SHALL BE RESPONSIBLE FOR OBTAINING ALL NECESSARY PERMITS AND APPROVALS FROM THE APPROPRIATE AGENCIES AND AGENCIES.
 9. THE CONTRACTOR SHALL BE RESPONSIBLE FOR OBTAINING ALL NECESSARY PERMITS AND APPROVALS FROM THE APPROPRIATE AGENCIES AND AGENCIES.
 10. THE CONTRACTOR SHALL BE RESPONSIBLE FOR OBTAINING ALL NECESSARY PERMITS AND APPROVALS FROM THE APPROPRIATE AGENCIES AND AGENCIES.

This document, together with the concepts and designs presented herein, is an instrument of service, to be used only for the specific purpose and client for which it was prepared. Review of and improper reliance on this document without written authorization and attestation by Kimley-Horn and Associates, Inc. shall be without liability to Kimley-Horn and Associates, Inc.

SCALE: 1"=40'

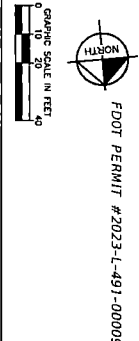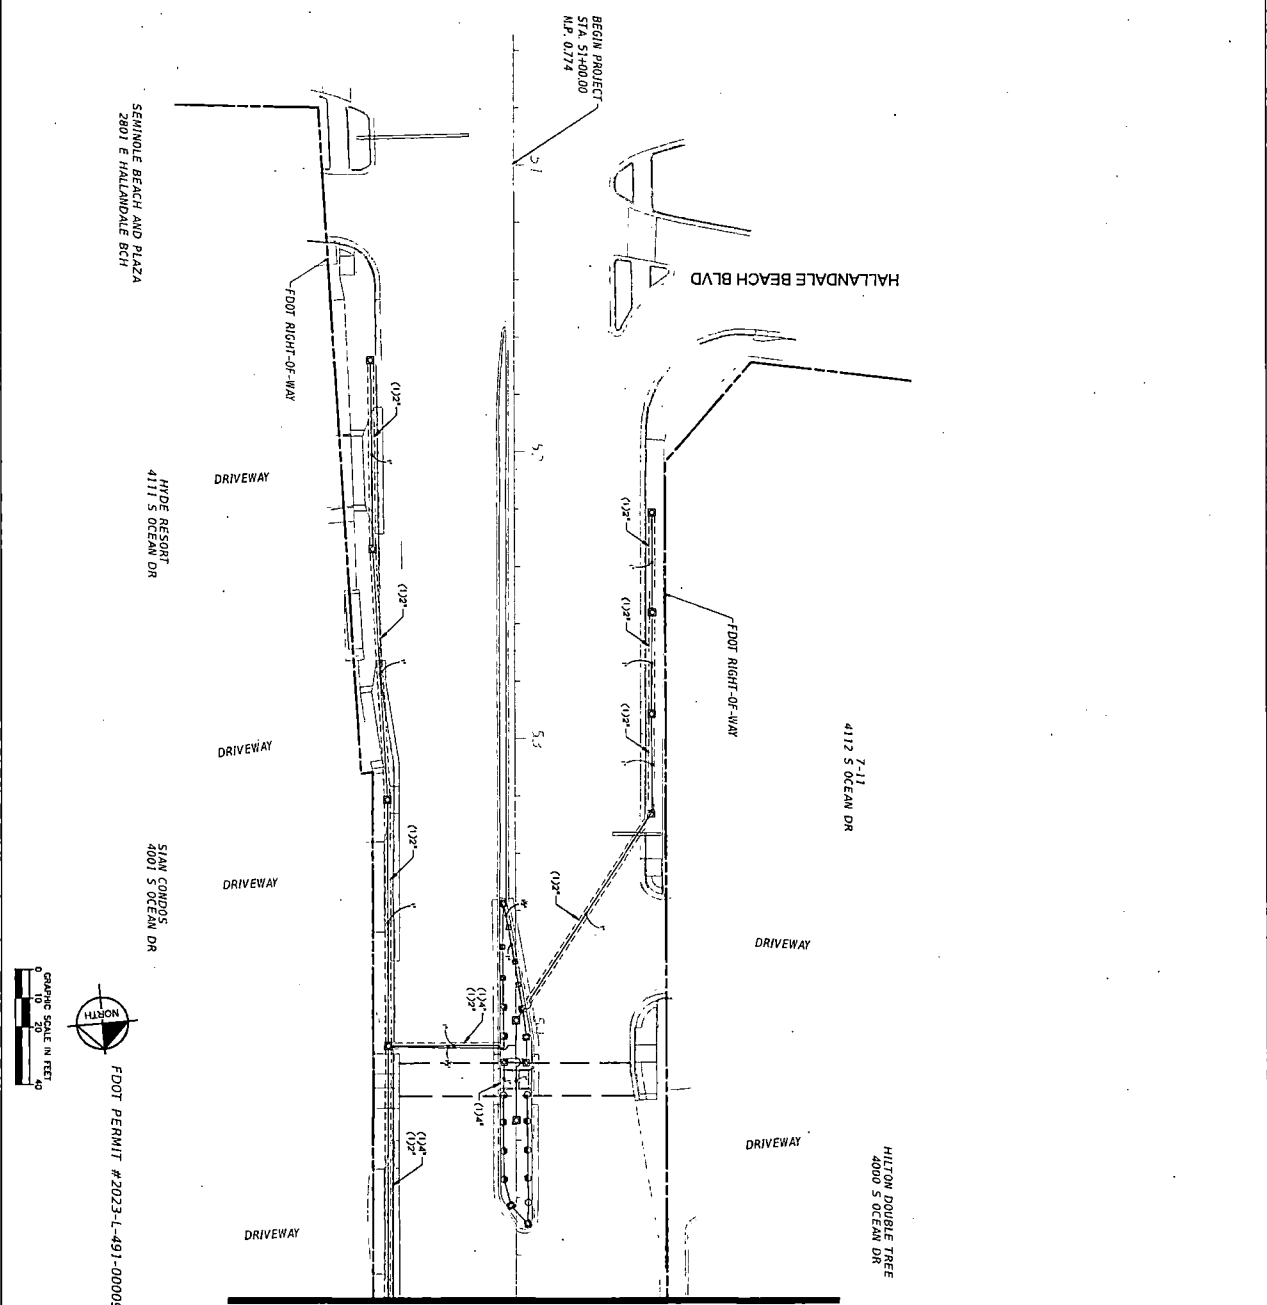


FOOT PERMIT #2023-L-491-00009

MATCHLINE - SEE SHEET 80

PHASE IV SR A1A UNDERGROUNDING OF OVERHEAD UTILITIES AND STREETSCAPE BEAUTIFICATION PREPARED FOR HOLLYWOOD CRA FL	IRRIGATION PLAN	KHA PROJECT 044241032 DATE DECEMBER 2024 SCALE: AS SHOWN DESIGNED BY: JH DRAWN BY: JC/TH/RC CHECKED BY: TR DATE: 2/19/2024	LICENSED PROFESSIONAL JONATHAN D. HAIGH, P.E. P. LICENSE NUMBER #6666795	Kimley»Horn © 2021 KIMLEY-HORN AND ASSOCIATES, INC. 1620 WORLDWAY SUITE 200, WEST PALM BEACH, FL 33411 PHONE: 561-843-0665 FAX: 561-863-8175 WWW.KIMLEY-HORN.COM REGISTRY NO. 35106	MUDA EXHIBIT DRAWINGS 12.19.2024 NS		
					No.	REVISIONS	DATE BY

This document, together with the contracts and design presented hereto, is an instrument of service, to be held only for the specific purpose and class for which it was prepared. None of and no separate reliance on this document without written authorization and signature by Kimley-Horn and Associates, Inc. shall be without liability to Kimley-Horn and Associates, Inc.

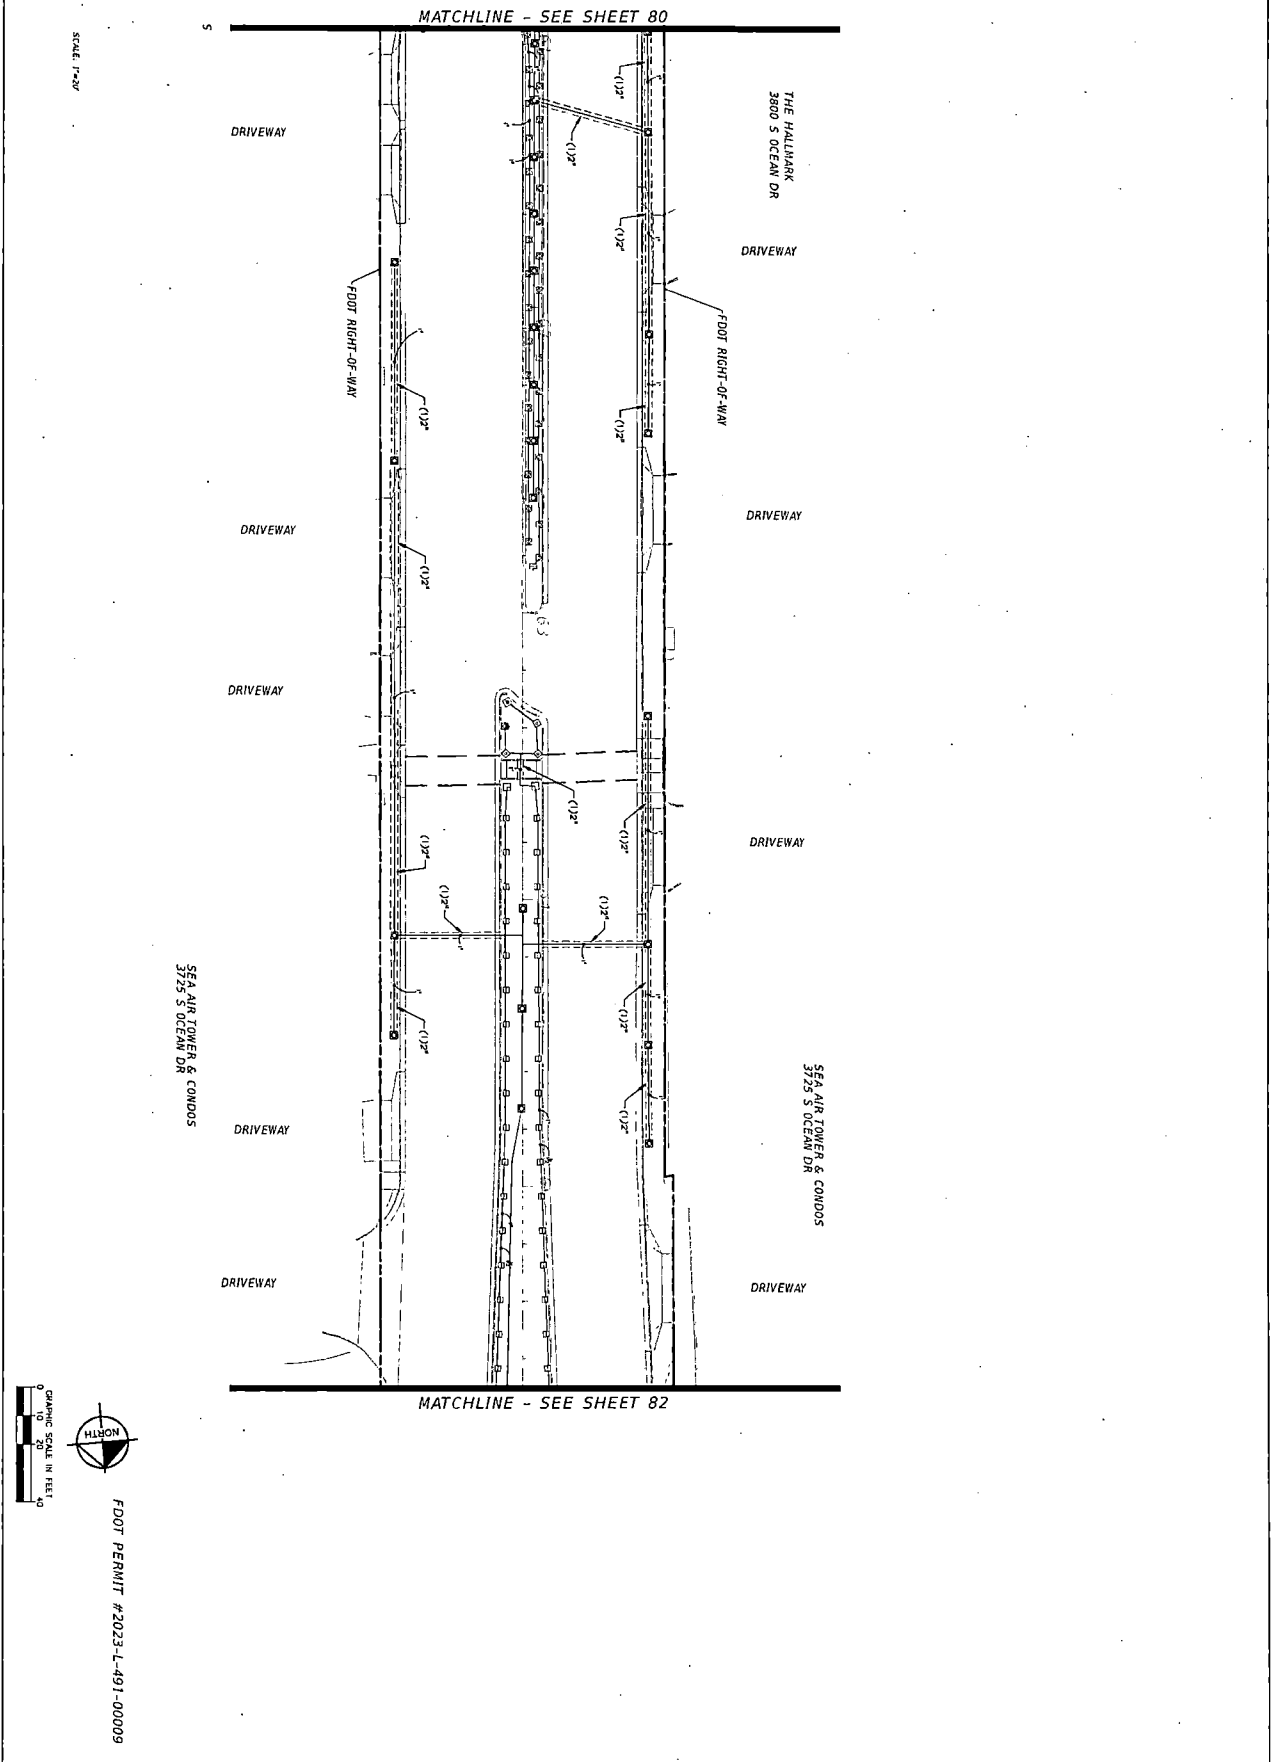


SCALE: 1"=20'


GRAPHIC SCALE IN FEET
0 10 20 40

NORTH

FDOT PERMIT #2023-L-491-00009

SHEET NUMBER 81	PHASE IV SR A1A UNDERGROUNDING OF OVERHEAD UTILITIES AND STREETSCAPE BEAUTIFICATION PREPARED FOR HOLLYWOOD CRA HOLLYWOOD FL	IRRIGATION PLAN	KHA PROJECT 044241032 DATE DECEMBER 2024 SCALE AS SHOWN DESIGNED BY JH DRAWN BY JC/TH/RC CHECKED BY TR	LICENSED PROFESSIONAL JONATHAN D. HAIGH, PLA FL LICENSE NUMBER #6666795 DATE 12/19/2024	 © 2021 KIMLEY-HORN AND ASSOCIATES, INC. 1920 REDIVA WAY SUITE 200, WEST PALM BEACH, FL 33411 PHONE: 561-845-0555 FAX: 561-863-8175 WWW.KIMLEY-HORN.COM REGISTRY NO. 35106	MUDA EXHIBIT DRAWINGS	12.19.2024	NS	
						No.	REVISIONS	DATE	BY

SCALE: 1"=20'

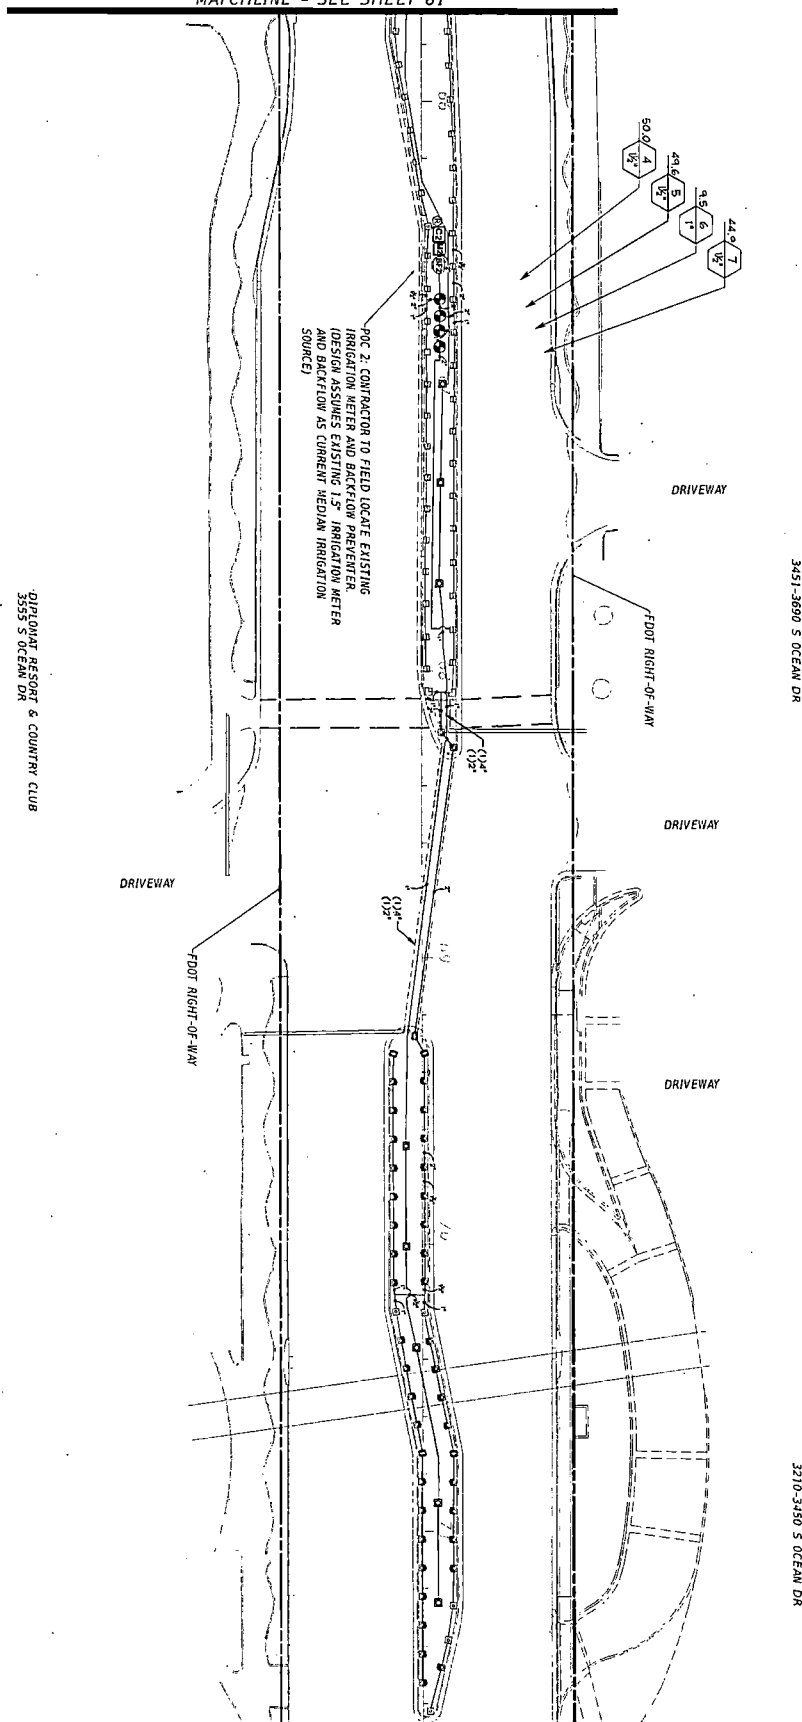

MATCHLINE - SEE SHEET 83

PHASE IV SR A1A UNDERGROUNDING OF
OVERHEAD UTILITIES AND
STREETSCAPE BEAUTIFICATION
PREPARED FOR
HOLLYWOOD CRA
HOLLYWOOD

IRRIGATION PLAN


KYA PROJECT
044241032
DATE
DECEMBER 202
SCALE AS SHOWN
DESIGNED BY JH
DRAWN BY JC/TH/R
CHECKED BY TR

LICENSED PROFESSIONAL
JONATHAN D. HAIGH, PL.
PL. LICENSE NUMBER
#6666795
DATE 12/19/2024


Kimley»»Horn

© 2021 KIMLEY-HORN AND ASSOCIATES, INC.
1920 WOKIVA WAY SUITE 200, WEST PALM BEACH, FL 33411
PHONE: 561-845-0665 FAX: 561-863-8175
WWW.KIMLEY-HORN.COM REGISTRY NO. 35106

MMQA EXHIBIT DRAWINGS		12.19.2024	NS
No.	REVISIONS	DATE	BY

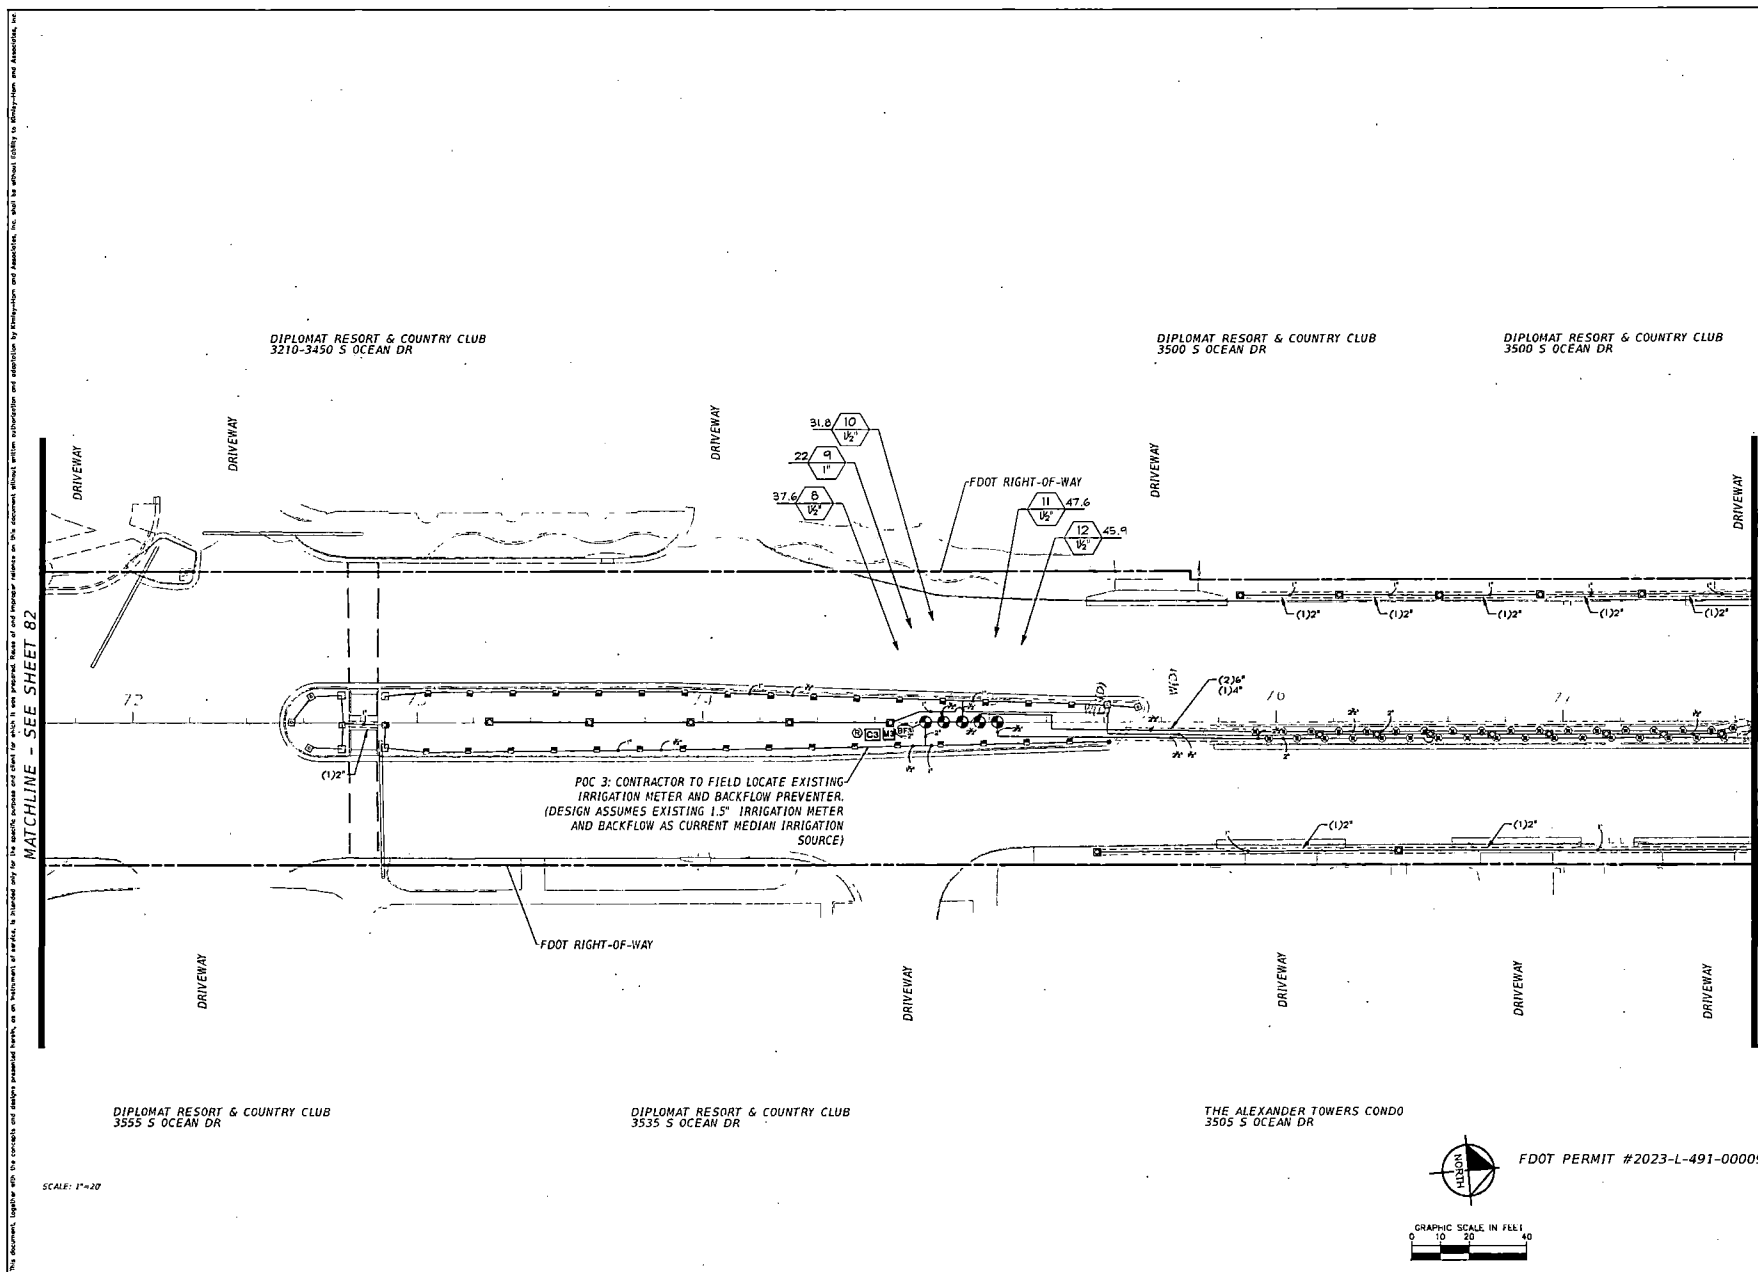

PHASE IV SR A1A UNDERGROUNDING OF OVERHEAD UTILITIES AND STREETScape BEAUTIFICATION PREPARED FOR HOLLYWOOD CRA	SHEET NUMBER 83	
	IRRIGATION PLAN	
NHA PROJECT 04/21/12	LICENSED PROFESSIONAL JONATHAN D. HORN, P.E. 1520 MONTELEONE AVENUE, SUITE 200, WEST PALM BEACH, FL 33411 PHONE: 561-642-5555 FAX: 561-643-8775 WWW.KIMLEY-HORN.COM REGISTRY NO. 35105	KIMLEY»HORN
DATE DECEMBER 2024	IN CHARGE ENGINEER DESIGNED BY JH DRAWN BY JZ/TH/PL	SCALE AS SHOWN REVISION BY JH #666795
MAPA DROBE DRAWINGS 12-19-2024 JKH		

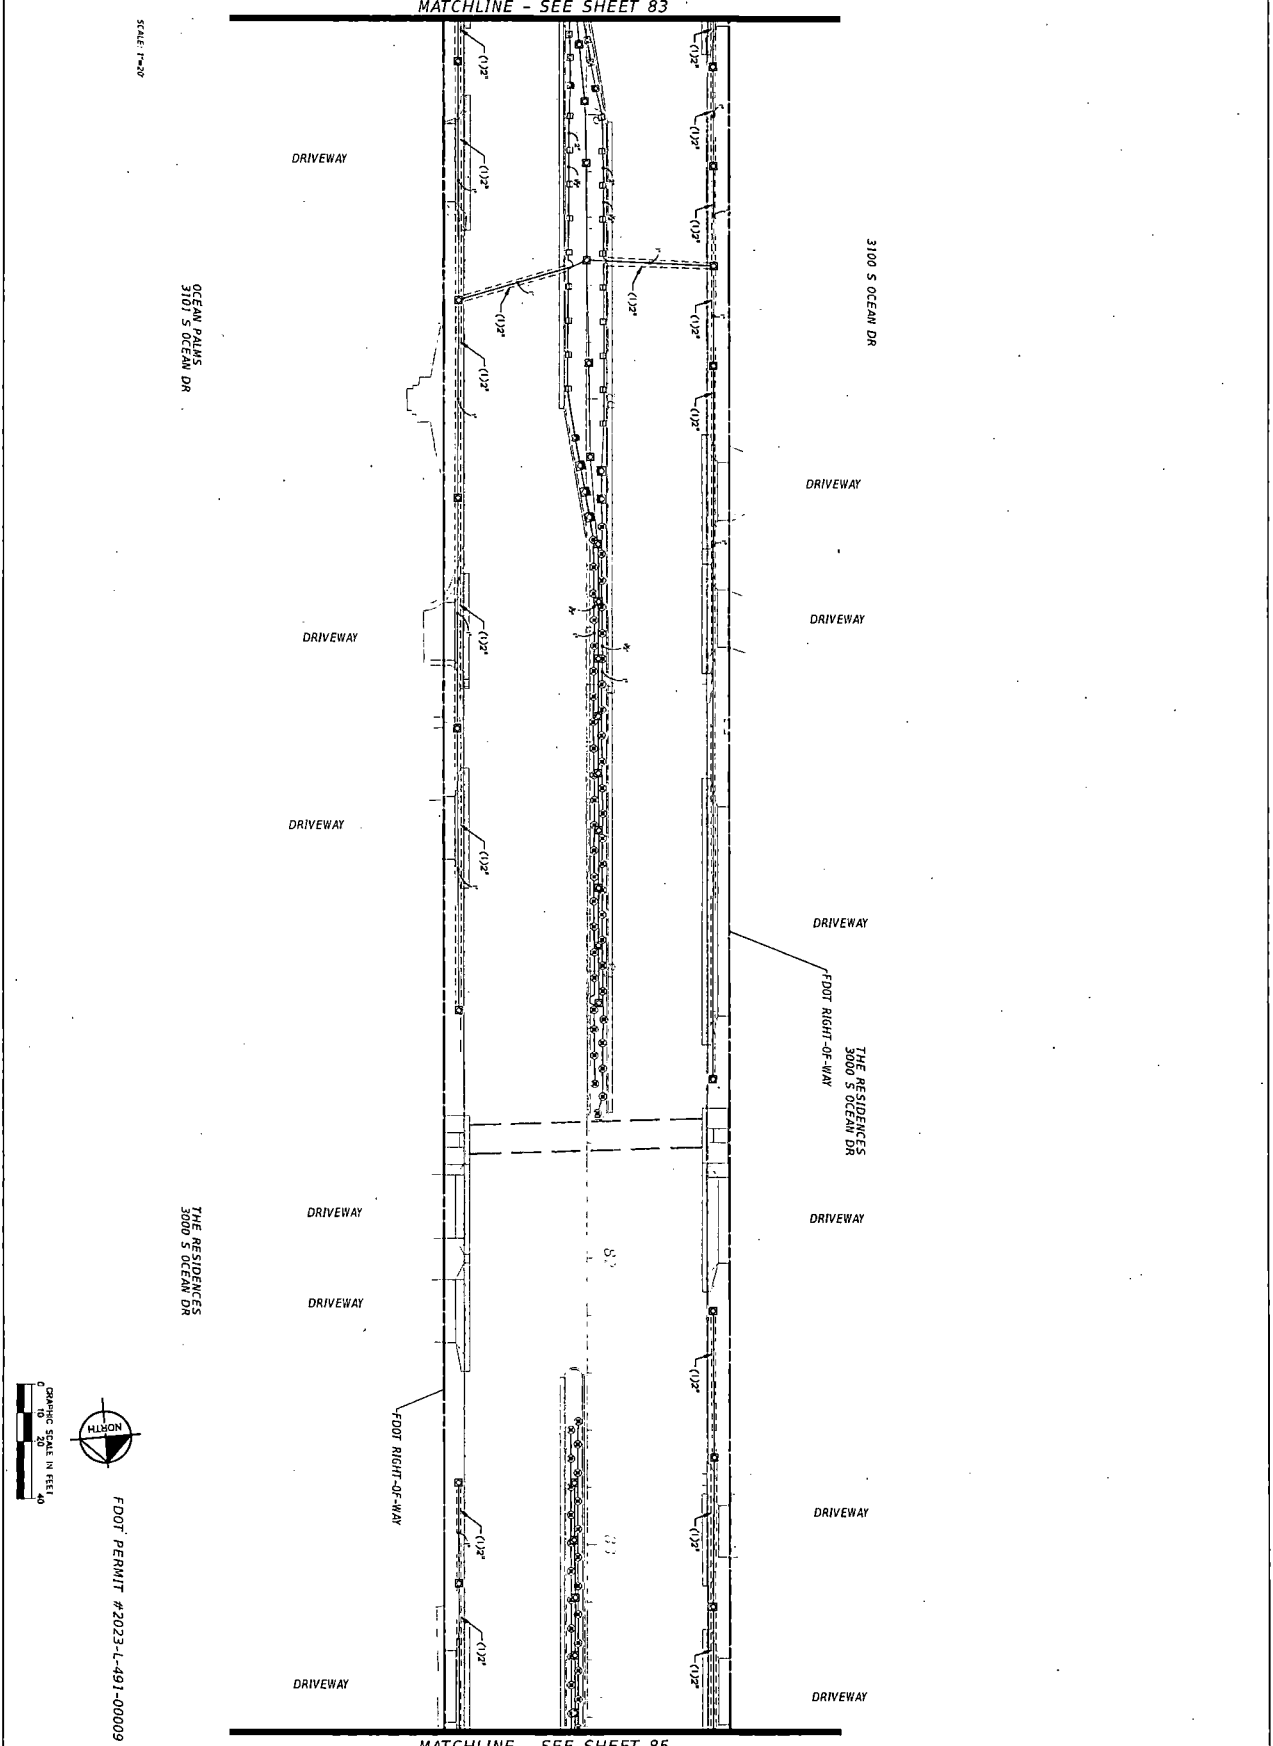


<p>PHASE IV SR A1A UNDERGROUNDING OF OVERHEAD UTILITIES AND STREETSCAPE BEAUTIFICATION</p> <p>PREPARED FOR</p> <p>HOLLYWOOD CRA</p> <p>HOLLYWOOD FL</p>	<p>IRRIGATION PLAN</p>	<p>KHA PROJECT 044241032</p> <p>DATE DECEMBER 2024</p> <p>SCALE AS SHOWN</p> <p>DESIGNED BY JH</p> <p>DRAWN BY JJC/TH/RG</p> <p>CHECKED BY TR</p>	<p>LICENSED PROFESSIONAL</p> <p>JONATHAN D. HAIGH, P.E.</p> <p>FL LICENSE NUMBER #5566795</p> <p>DATED 2/19/2024</p>	<p>Kimley»Horn</p> <p>© 2021 KIMLEY-HORN AND ASSOCIATES, INC.</p> <p>1920 NOBIA WAY SUITE 200 WEST PALM BEACH, FL 33411</p> <p>PHONE: 561-845-0853 FAX: 561-863-8175</p> <p>WWW.KIMLEY-HORN.COM REGISTRY NO. 35108</p>	<p>MUQA EXHIBIT DRAWINGS 12.19.2024 NS</p>
		<p>NO. REVISIONS DATE BY</p>			
		<p>84</p>			
		<p>FDOT PERMIT #2023-L-491-00009</p>			




MWDA EXHIBIT DRAWINGS		12.19.2024	NS
No.	REVISIONS	DATE	BY

This document, together with the concepts and design presented herein, is an instrument of service, to be used only for the specific purpose and client for which it was prepared. None of the Engineer's reliance on this document without written authorization and signature by Kimley-Horn and Associates, Inc. shall be without liability to Kimley-Horn and Associates, Inc.

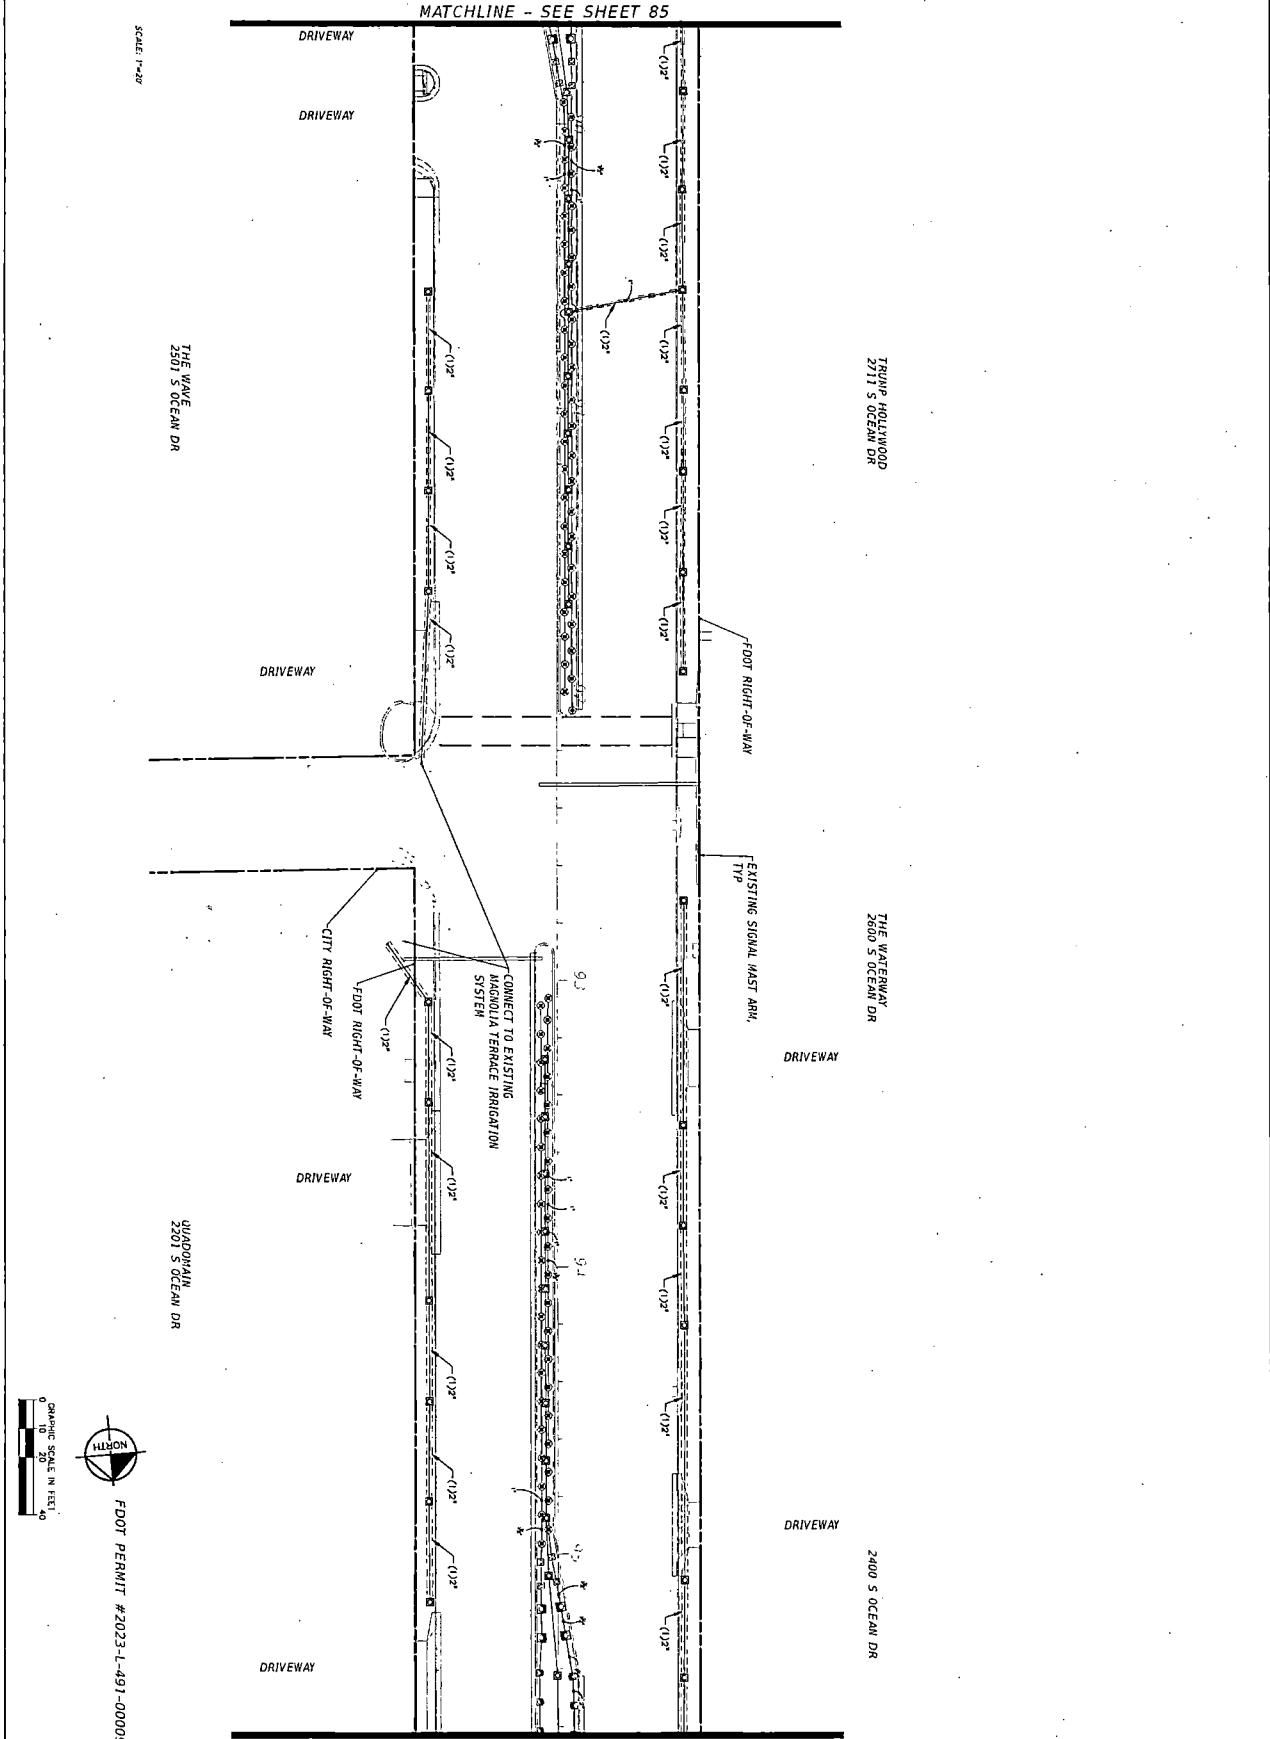

SHEET NUMBER 86	PHASE IV SR A1A UNDERGROUNDING OF OVERHEAD UTILITIES AND STREETSCAPE BEAUTIFICATION PREPARED FOR HOLLYWOOD CRA HOLLYWOOD FL	IRRIGATION PLAN	KHA PROJECT 044241032	UNLICENSED PROFESSIONAL	Kimley»Horn © 2021 KIMLEY-HORN AND ASSOCIATES, INC. 1920 NW 14th AVE SUITE 200, WEST PALM BEACH, FL 33411 PHONE: 561-845-0183 FAX: 561-863-8175 WWW.KIMLEY-HORN.COM REGISTRY NO. 35108	MWDIA EXHIBIT DRAWINGS 12.19.2024 NS	
			DATE DECEMBER 2024	JONATHAN D. HAIGH, P.E.			
			SCALE AS SHOWN				
			DESIGNED BY JH	FL LICENSE NUMBER #6666795			
			DRAWN BY JC/TH/RC				
CHECKED BY TR	DATE 12/19/2024			No.	REVISIONS	DATE	BY

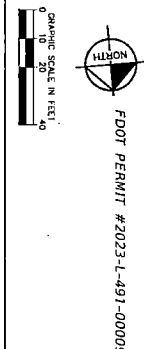

SHEET NUMBER

86

MATCHLINE - SEE SHEET 86

SCALE: 1"=20'

DRIVEWAY

2400 S OCEAN DR

DRIVEWAY

✓ FDOT RIGHT-OF-WAY

DRIVEWAY

DRIVEWAY


THE WATERWAY
2200 S OCEAN DR

DRIVEWAY

DRIVEWAY

ARLINGTON
1600 S OCEAN DR

GRAPHIC SCALE IN FEET



A horizontal scale bar with markings at 0, 10, 20, and 40 feet. The bar is divided into segments: 0-10 is white, 10-20 is black, 20-30 is white, 30-40 is black, and 40-45 is white.



FDOT PERMIT #2023-L-491-00009

CITY RIGHT-OF-WAY

IRRIGATION LATERAL LINE -
SHOWN OUTSIDE OF MEDIAN FOR GRAPHIC CLARITY
PURPOSES ONLY. ALL IRRIGATION EQUIPMENT SHALL
BE LOCATED WITHIN MEDIAN LANDSCAPE AREA.
(TYP.)

MATCHLINE - SEE SHEET 88

PHASE IV SR A1A UNDERGROUNDING OF
OVERHEAD UTILITIES AND
STREETSCAPE BEAUTIFICATION
PRÉPARED FOR
HOLLYWOOD CRA
HOLLYWOOD

IRRIGATION PLAN


KHA PROJECT 044241032
DATE DECEMBER 202
SCALE AS SHOW
DESIGNED BY JH
DRAWN BY JC/TH/7
CHECKED BY TH

LICENSED PROFESSIONAL
JONATHAN D. HAIGH, PLA
FL LICENSE NUMBER
#6566795
DATE: 12/19/2024

Kimley»Horn
© 2021 KIMLEY-HORN AND ASSOCIATES, INC.
1920 MOJAVE WAY SUITE 200, WEST PALM BEACH, FL 33411
PHONE: 561-845-0665 FAX: 561-863-0175
WWW.KIMLEY-HORN.COM REGISTRY NO. 35106

	WJDA EXHIBIT DRAWINGS	12.19.2024	NS
No.	REVISIONS	DATE	BY

THIS DOCUMENT, TOGETHER WITH THE CONTRACT AND SPECIFICATIONS, SHALL BE KEPT BY THE CONTRACTOR AS A PART OF THE RECORD DRAWINGS FOR THIS PROJECT. NO PART OF THIS DOCUMENT SHALL BE REPRODUCED OR TRANSMITTED IN ANY FORM OR BY ANY MEANS, ELECTRONIC OR MECHANICAL, INCLUDING PHOTOCOPYING, RECORDING, OR BY ANY INFORMATION STORAGE AND RETRIEVAL SYSTEM, WITHOUT THE WRITTEN PERMISSION OF KIMLEY-HORN.

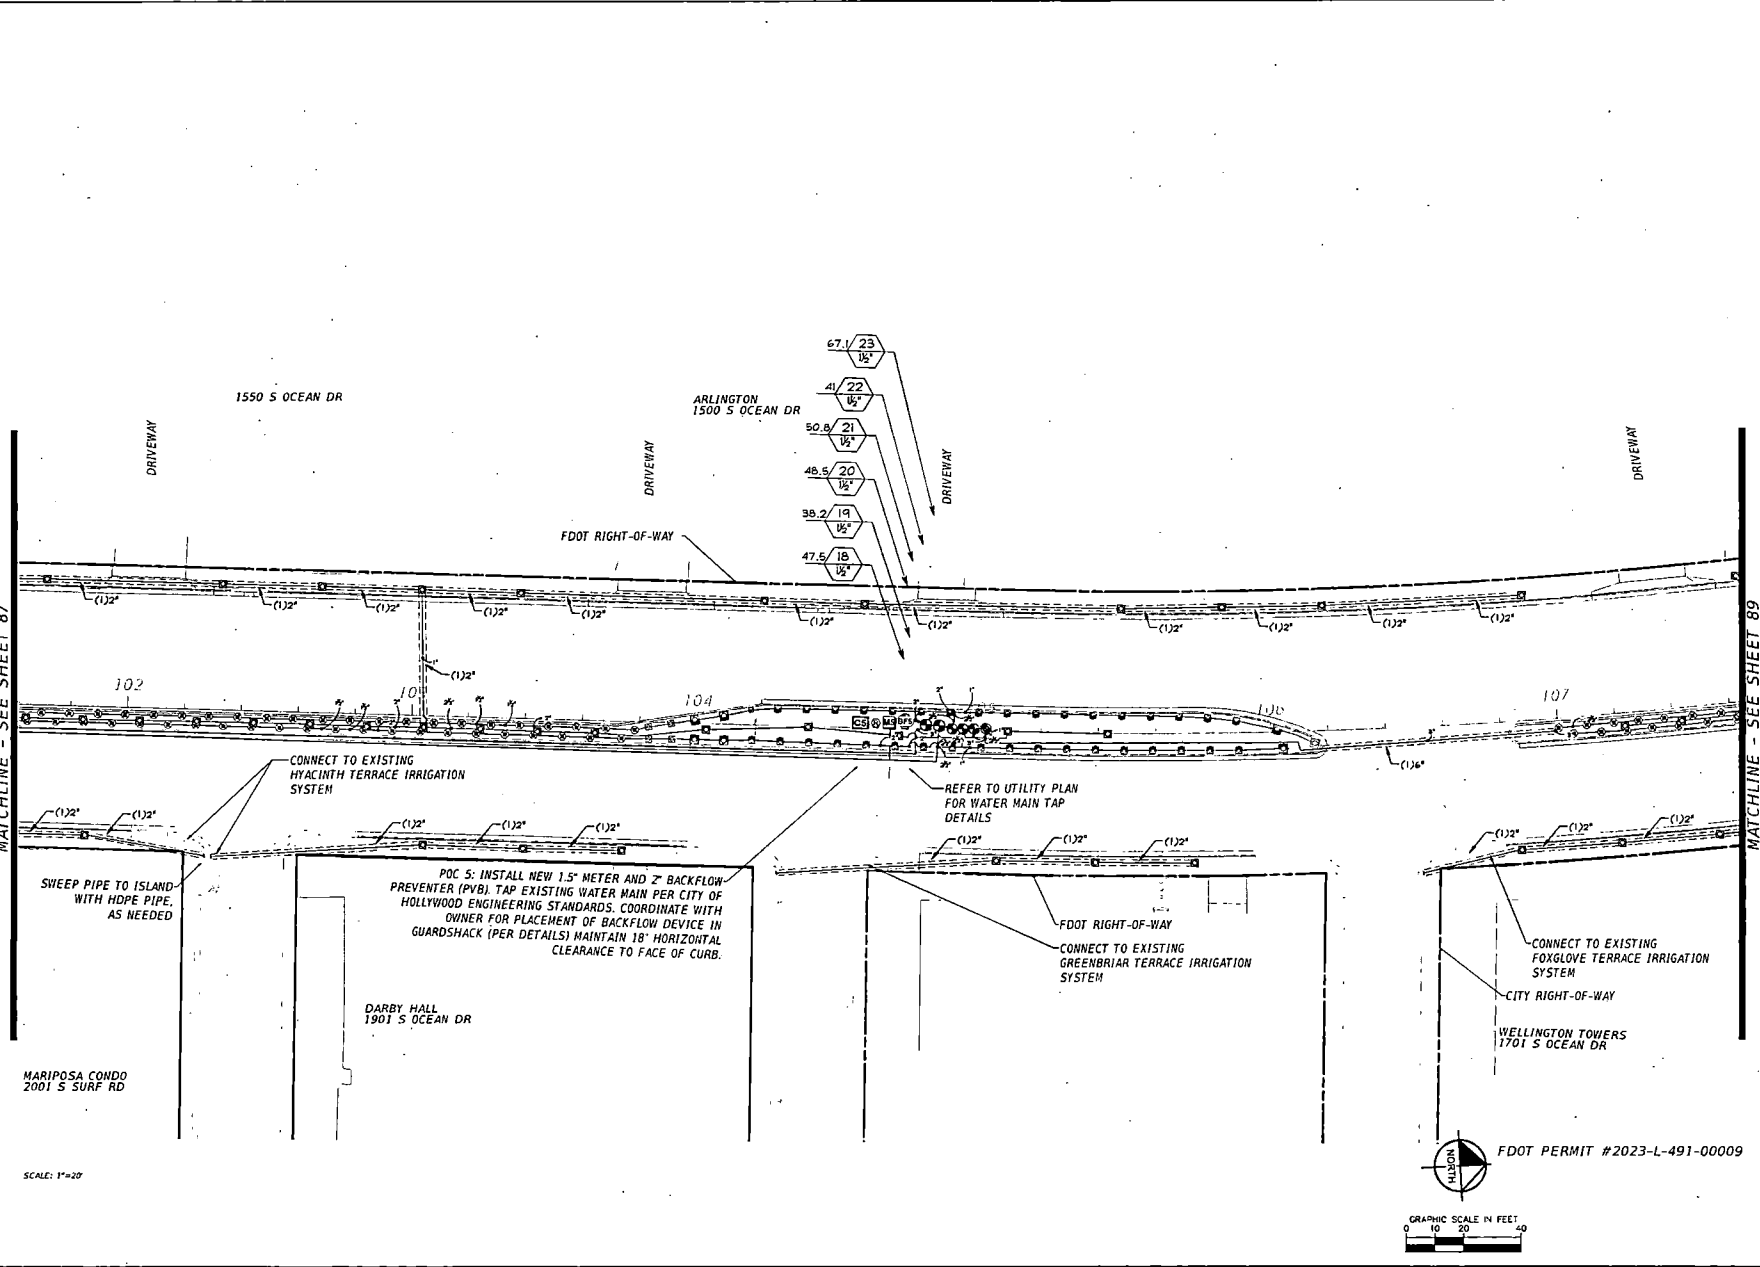

SCALE: 1"=20'

FDOT PERMIT #2023-L-491-00009
 GRAPHIC SCALE IN FEET
 0 10 20 30

Kimley-Horn

500 N. W. 10th Ave., Suite 200
 Fort Lauderdale, FL 33411
 PHONE: 561-444-0500 FAX: 561-444-0501
 WWW.KIMLEY-HORN.COM

NO.	REVISIONS	DATE	BY
1	ISSUED FOR PERMIT	12/15/2024	NE

PHASE IV SR 171A UNDERGROUNDING OF OVERHEAD UTILITIES AND STREETSCAPE BEAUTIFICATION
PREPARED FOR
HOLLYWOOD CRA
 HOLLYWOOD, FL


KIMLEY-HORN PROJECT NO. 044241032
 DATE: 12/15/2024
 SCALE: AS SHOWN
 DESIGNED BY: JH
 DRAWN BY: JH/NE
 CHECKED BY: TR

IRRIGATION PLAN
 MATCHLINE - SEE SHEET 89


MATCHLINE - SEE SHEET 87

THIS DOCUMENT, TOGETHER WITH THE SPECIFICATIONS AND ANY OTHER DOCUMENTS REFERENCED HEREIN, IS TO BE USED IN CONNECTION WITH THE PROJECT DESCRIBED HEREIN. IT IS THE RESPONSIBILITY OF THE USER TO OBTAIN ALL NECESSARY PERMITS AND TO COMPLY WITH ALL APPLICABLE LAWS, ORDINANCES, AND REGULATIONS. THE USER SHALL BE RESPONSIBLE FOR OBTAINING ALL NECESSARY PERMITS AND TO COMPLY WITH ALL APPLICABLE LAWS, ORDINANCES, AND REGULATIONS. THE USER SHALL BE RESPONSIBLE FOR OBTAINING ALL NECESSARY PERMITS AND TO COMPLY WITH ALL APPLICABLE LAWS, ORDINANCES, AND REGULATIONS.

MATCHLINE - SEE SHEET 88

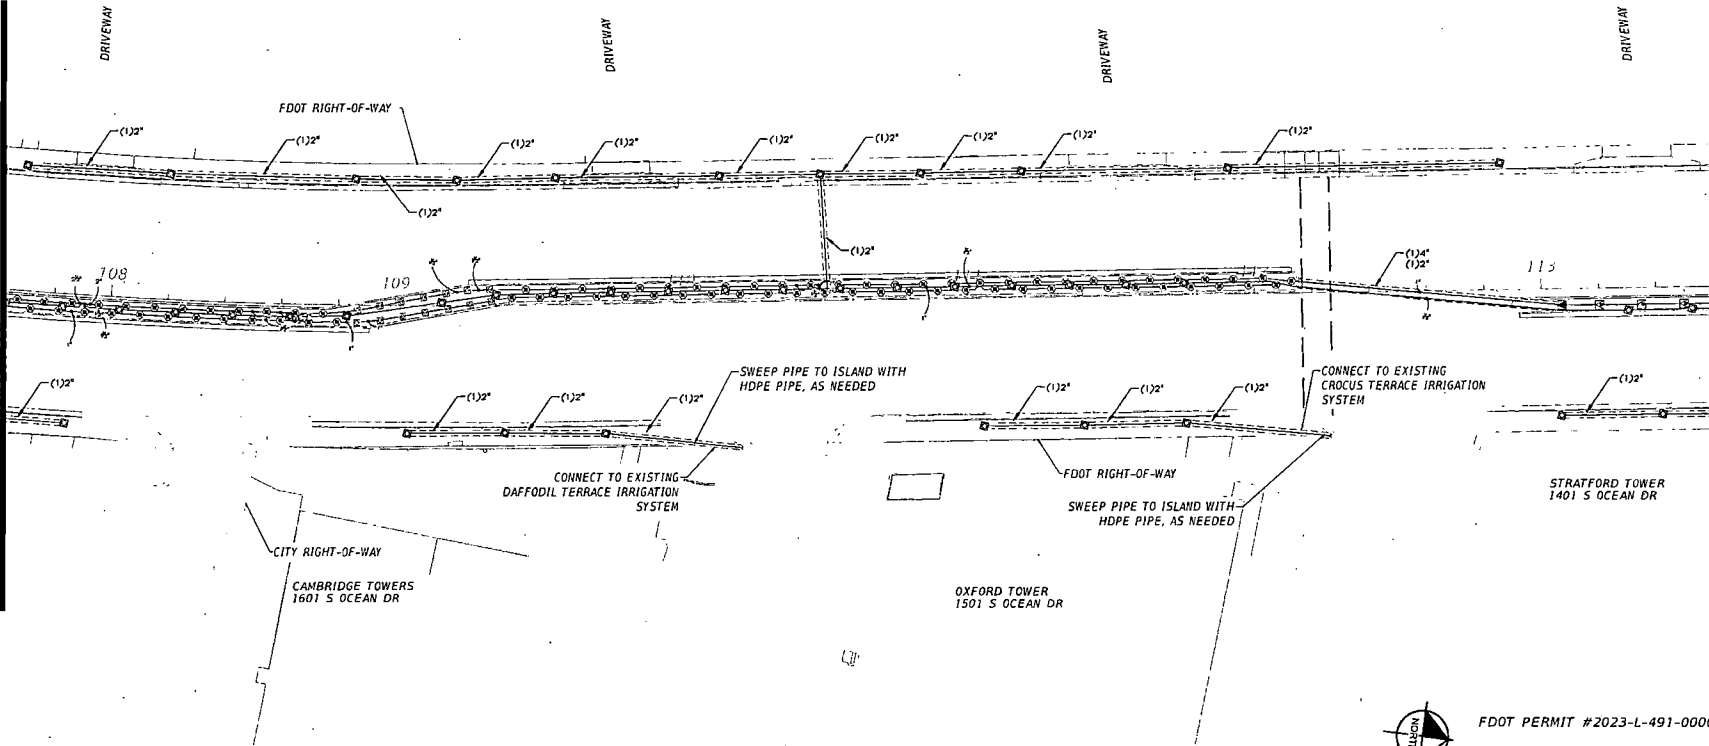

SCALE 1\"/>


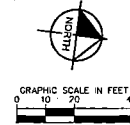


FDOT PERMIT #2023-L-491-00009

MATCHLINE - SEE SHEET 90

PHASE IV SR 1A UNDERGROUNDING OF OVERHEAD UTILITIES AND STREETSCAPE BEAUTIFICATION PREPARED FOR HOLLYWOOD CRA HOLLYWOOD		IRRIGATION PLAN		LAWSON PROFESSIONAL		Kimley»Horn		MUDA EXIST DRAWINGS 12.19.2024 NS	
SHEET NUMBER 89		DATE 12/19/2024		PROJECT 044241032		DESIGNED BY JONATHAN D. HUGH, P.E.		DATE 12/19/2024	
SCALE 1\"/>		SCALE AS SHOWN		REVISIONS		1. 12/19/2024		1. 12/19/2024	
DRAWN BY J. HUGH		CHECKED BY J. HUGH		DATE 12/19/2024		1. 12/19/2024		1. 12/19/2024	
PROJECT NO. 044241032		PROJECT NO. 044241032		PROJECT NO. 044241032		PROJECT NO. 044241032		PROJECT NO. 044241032	

THIS DOCUMENT, TOGETHER WITH THE SPECIFICATIONS AND BIDDING DOCUMENTS, IS TO BE USED BY THE CONTRACTOR FOR THE CONSTRUCTION OF THE PROJECT. IT IS THE CONTRACTOR'S RESPONSIBILITY TO OBTAIN ALL NECESSARY PERMITS AND TO COMPLY WITH ALL APPLICABLE LAWS, ORDINANCES, AND REGULATIONS. THE CONTRACTOR SHALL BE RESPONSIBLE FOR OBTAINING ALL NECESSARY PERMITS AND FOR COMPLYING WITH ALL APPLICABLE LAWS, ORDINANCES, AND REGULATIONS. THE CONTRACTOR SHALL BE RESPONSIBLE FOR OBTAINING ALL NECESSARY PERMITS AND FOR COMPLYING WITH ALL APPLICABLE LAWS, ORDINANCES, AND REGULATIONS.

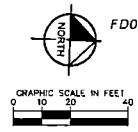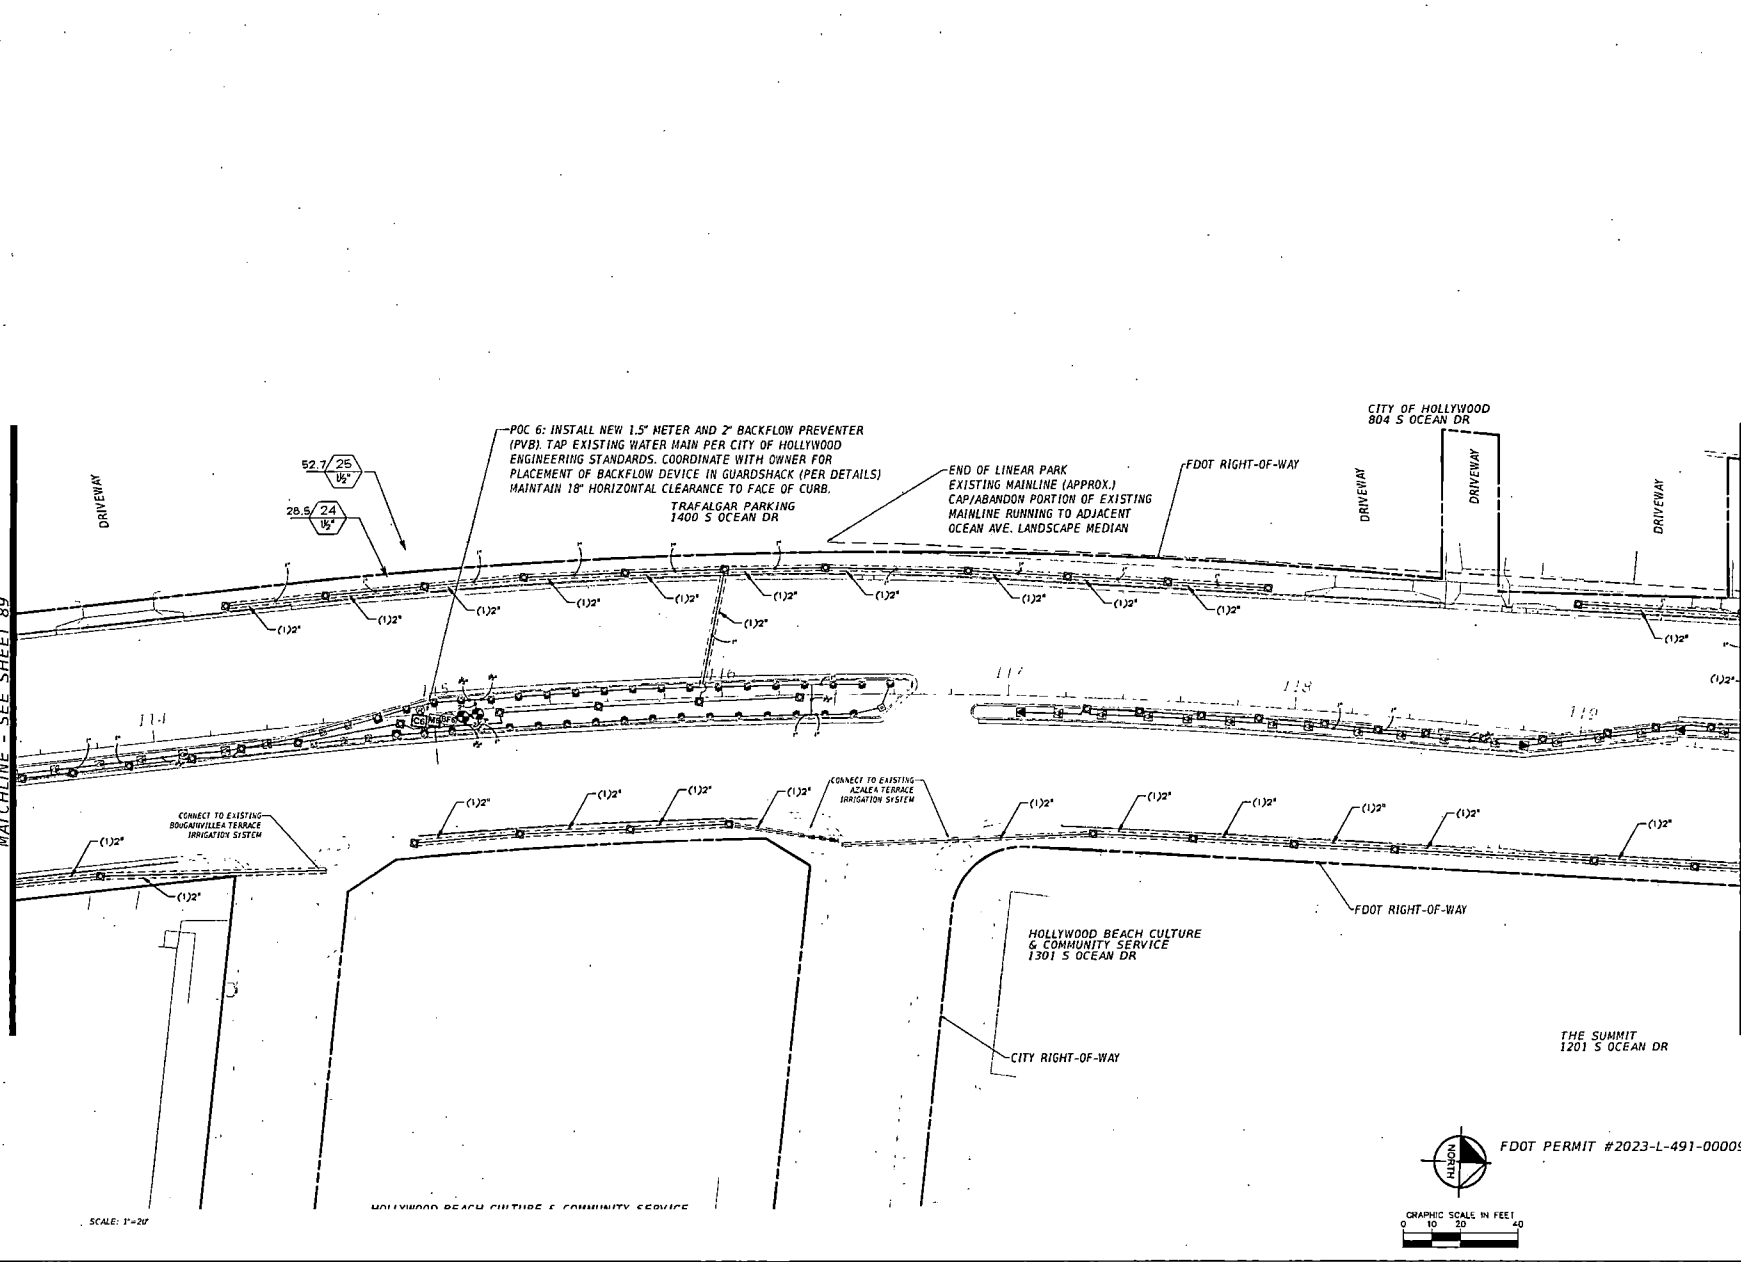

FDOT PERMIT #2023-L-491-00009

PHASE IV SR A1A UNDERGROUNDING OF
OVERHEAD UTILITIES AND
STREETSCAPE BEAUTIFICATION
PREPARED FOR
HOLLYWOOD CRA
HOLLYWOOD, FL

Kimley»Horn
1000 N. W. 10th Ave., Suite 200, Ft. Lauderdale, FL 33411
PHONE: 561-845-0665 FAX: 561-862-8173
WWW.KIMLEY-HORN.COM PROJECT NO. 3016

PROJECT NO. 044241032
DATE: 08/2024
SCALE: AS SHOWN
DRAWN BY: JH
CHECKED BY: TR
DATE: 08/12/2024

UNION PROFESSIONAL
OWANHAN D. HARRIS, P.E.
FL LICENSE NUMBER
#666795
DATE: 08/12/2024


NO. 1
DATE
REVISIONS

12/19/2024

IRRIGATION PLAN
MATCHLINE - SEE SHEET 91
SHEET NUMBER
90

MATCHLINE - SEE SHEET 90

SCALE: 1"=20'

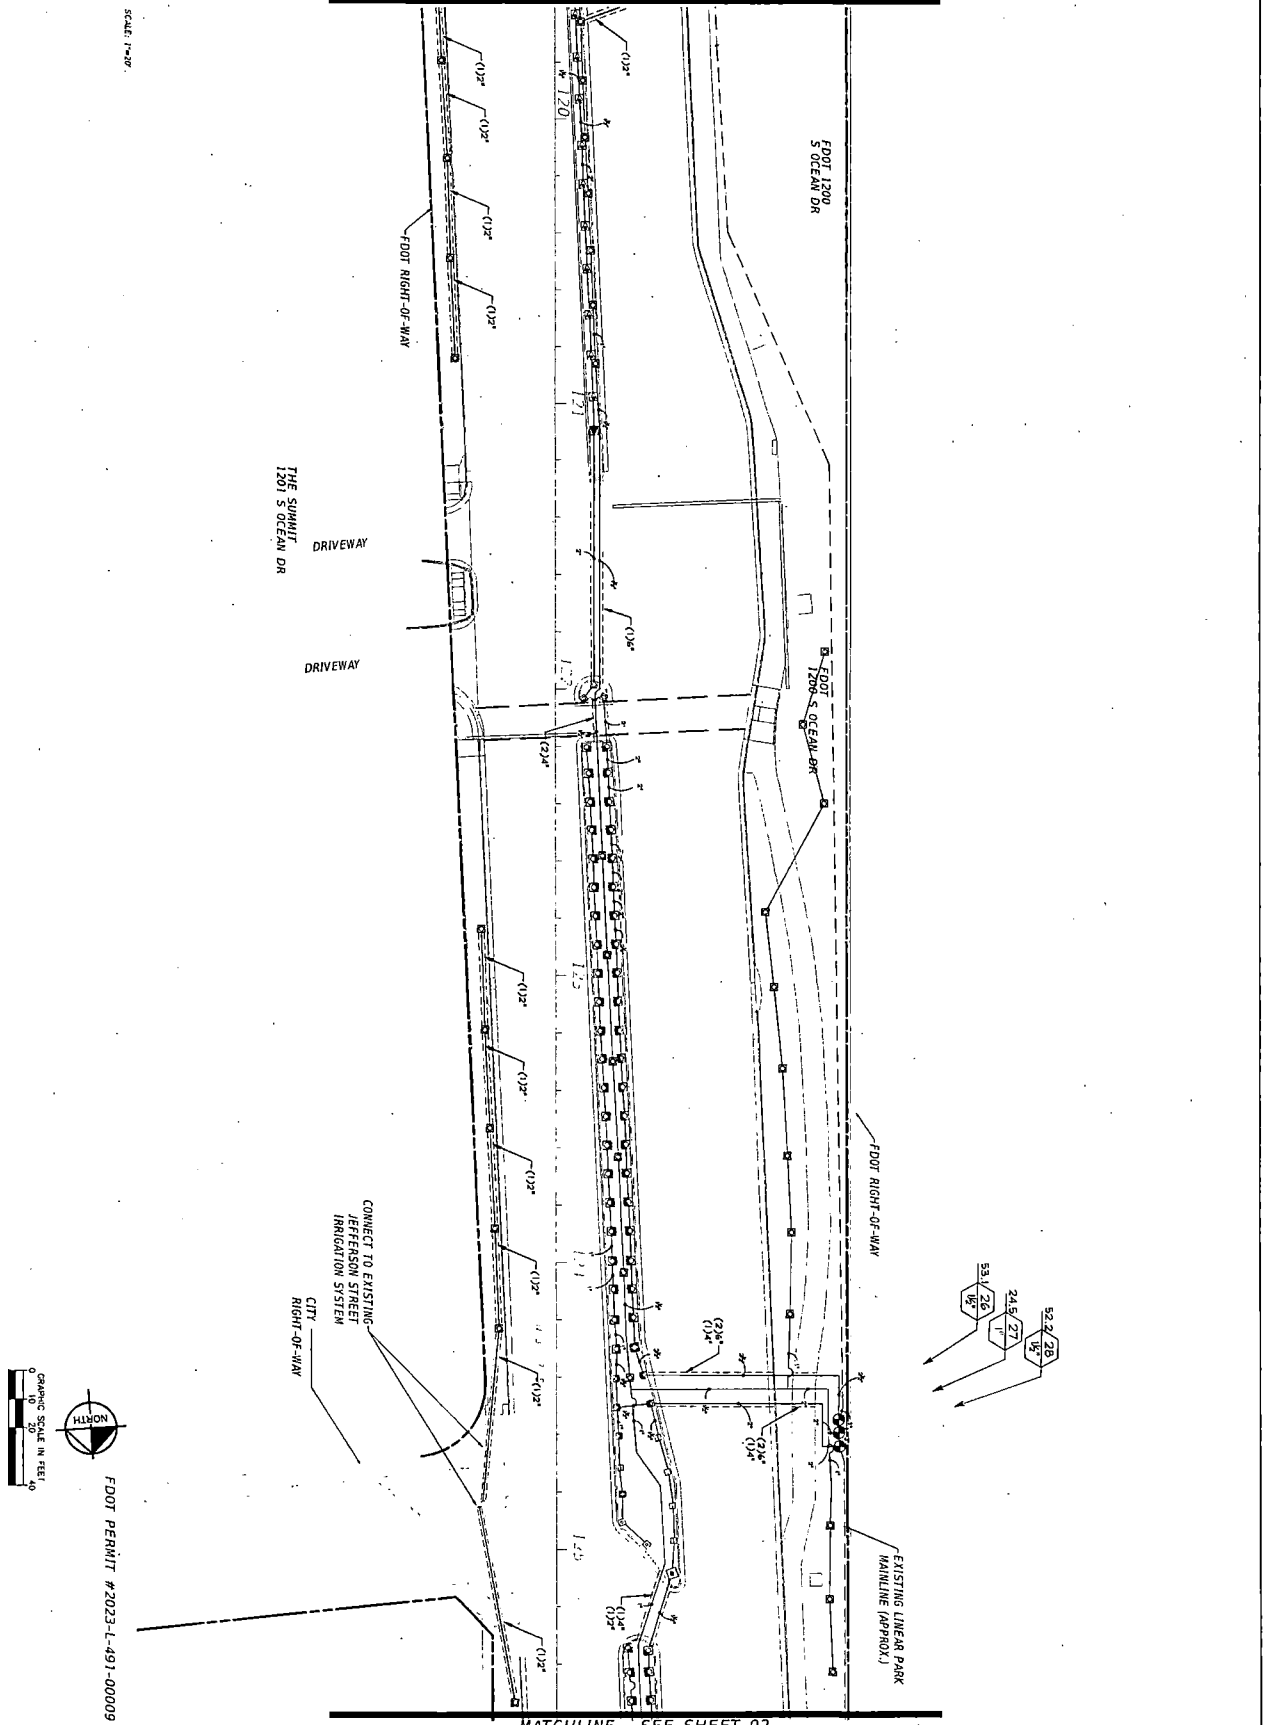


MATCHLINE - SEE SHEET 92

SHEET NUMBER 91	PHASE IV SR A1A UNDERGROUNDING OF OVERHEAD UTILITIES AND STREETSCAPE BEAUTIFICATION PREPARED FOR HOLLYWOOD CRA HOLLYWOOD FL	IRRIGATION PLAN	KHA PROJECT 044241032	LICENSED PROFESSIONAL	Kimley»Horn © 2021 KIMLEY-HORN AND ASSOCIATES, INC. 1920 NEVADA WAY SUITE 200, WEST PALM BEACH, FL 33411 PHONE: 561-845-0555 FAX: 561-863-8175 WWW.KIMLEY-HORN.COM REGISTRY NO. 35106	MUDA EXHIBIT DRAWINGS		2.19.2024	NS
			DATE	ONATHAN D. HAIG, PLA					
			DECEMBER 2024						
			SCALE AS SHOWN						
			DESIGNED BY JH	FL LICENSE NUMBER #5566795					
			DRAWN BY JUC/TH/AND						
			CHECKED BY TR	DATE 2/19/2024					
						No.	REVISIONS	DATE	BY


SHEET NUMBER
91

This document, together with the contracts and design presentation, is the property of Kimley-Horn and Associates, Inc. and shall be returned to Kimley-Horn and Associates, Inc. upon completion of the project. No part of this document shall be reproduced or transmitted in any form or by any means electronic or mechanical, including photocopying, recording, or by any information storage and retrieval system, without permission in writing from Kimley-Horn and Associates, Inc.

MATCHLINE - SEE SHEET 91

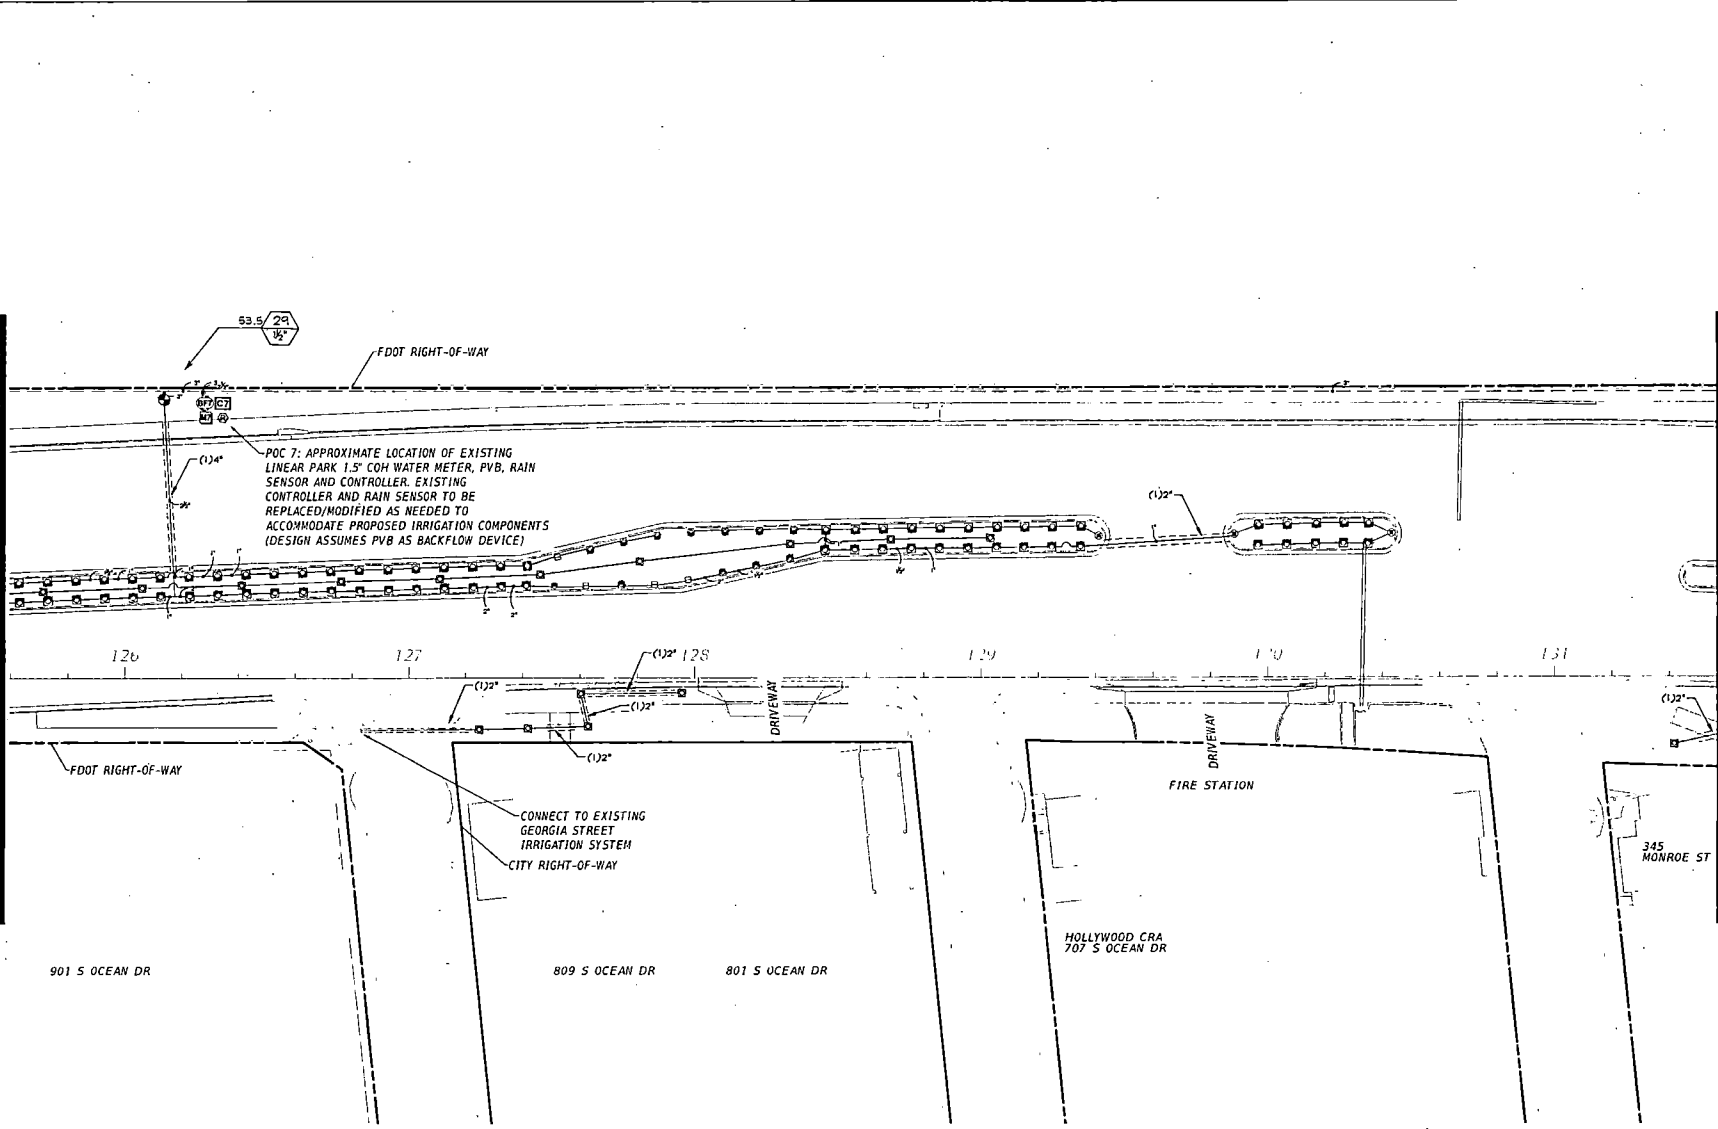

SCALE: 1"=20'

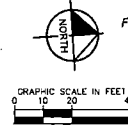


FDOT PERMIT #2023-L-491-00009


MATCHLINE - SEE SHEET 93

PHASE IV SR A1A UNDERGROUNDING OF OVERHEAD UTILITIES AND STREETSCAPE BEAUTIFICATION PREPARED FOR HOLLYWOOD CRA		IRRIGATION PLAN		Kimley»Horn 1930 MONROE ST., SUITE 200, WEST PALM BEACH, FL 33411 PHONE: 561-845-0863 FAX: 561-862-8175 WWW.KIMLEY-HORN.COM		MUOA EXHIBIT DRAWINGS 12.19.2024 NS
HVA PROJECT 044241032	DESIGN PROFESSIONAL CHARLIE D. HART, P.E.	DATE 2024	SCALE 1/8"=1'-0"	PROJECT NO. 24	REVIEWED BY JH	DATE 12/19/2024
SHEET NUMBER 92	FL					

MATCHLINE - SEE SHEET 92

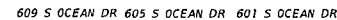


SCALE: 1"=20'

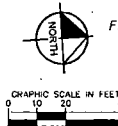


FDOT PERMIT #2023-L-491-00009

[illegible]

MATCHLINE - SEE SHEET 93

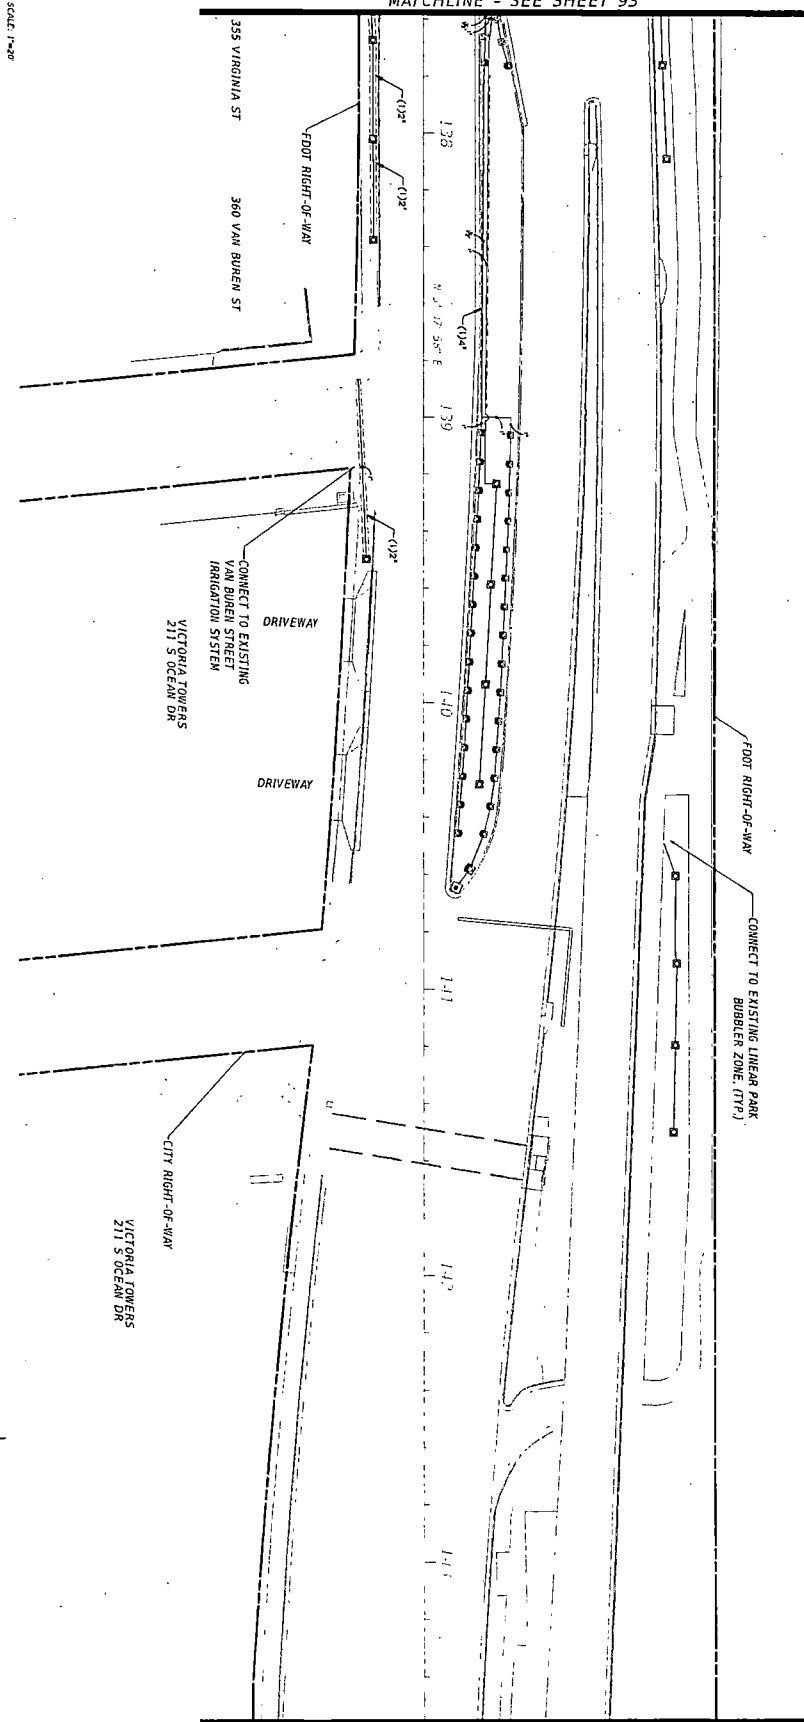

SCALE: 1"=20'

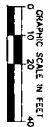

FDOT PERMIT #2023-L-491-00009

MATCHLINE - SEE SHEET 95

SHEET NUMBER
94

PHASE IV SR A1A UNDERGROUNDING OF
OVERHEAD UTILITIES AND
STREETSCAPE BEAUTIFICATION
PREPARED FOR
HOLLYWOOD CRA
HOLLYWOOD FL

IRRIGATION PLAN


NHA PROJECT
044241032
DATE
DECEMBER 2024
SCALE AS SHOWN
DESIGNED BY JA
DRAWN BY JC/DH/RG
CHECKED BY TR
DATE 12/19/2024

LICENSED PROFESSIONAL
JONATHAN B. HAIGH, P.E.
FL LICENSE NUMBER
#6666795

Kimley-Horn

© 2021 KIMLEY-HORN AND ASSOCIATES, INC.
1920 WOODWARD WAY SUITE 200, WEST PALM BEACH, FL 33411
PHONE: 561-845-0663 FAX: 561-863-8175
WWW.KIMLEY-HORN.COM REGISTRY NO. 35106

MVA EXHIBIT DRAWINGS		12.19.2024	NS
No.	REVISIONS	DATE	BY

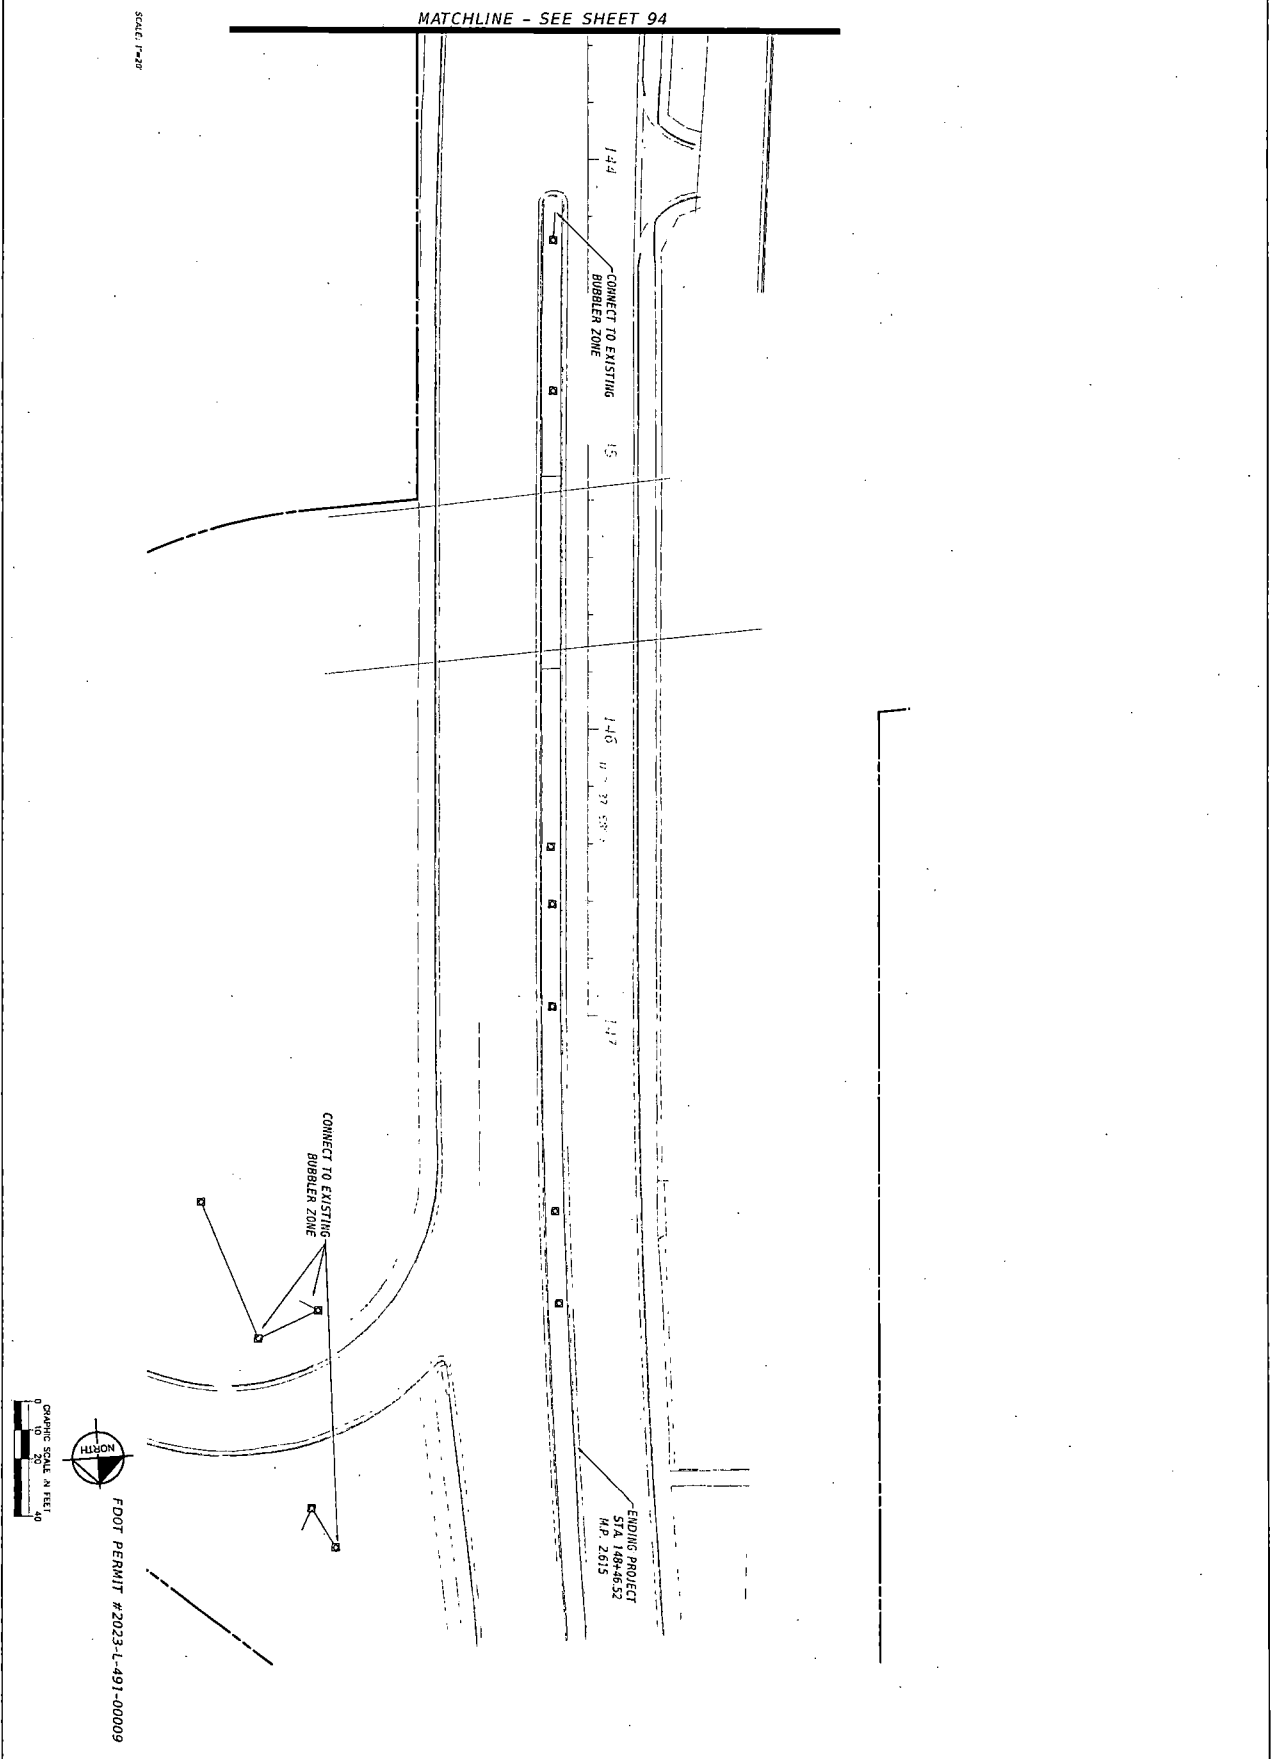

SHEET NUMBER 95	PHASE IV SR A1A UNDERGROUNDING OF OVERHEAD UTILITIES AND STREETSCAPE BEAUTIFICATION PREPARED FOR HOLLYWOOD CRA HOLLYWOOD FL	IRRIGATION PLAN		KHA PROJECT 044241032	LICENSED PROFESSIONAL JONATHAN D. HAIGH, P.E.	Kimley»Horn © 2021 KIMLEY-HORN AND ASSOCIATES, INC. 1820 NOVOA WAY SUITE 200 WEST PALM BEACH, FL 33411 PHONE: 561-845-0553 FAX: 561-853-8175 WWW.KIMLEY-HORN.COM REGISTRY NO. 35108	MUQA EXHIBIT DRAWINGS 12.19.2024 NS		
		DATE DECEMBER 2024		SCALE AS SHOWN	FL LICENSE NUMBER #5656795		DESIGNED BY JH	CHECKED BY TR	DATE 12/19/2024
		CHECKED BY TR		DATE 12/19/2024	NO.		REVISIONS	DATE	BY
		NO.		REVISIONS	DATE		BY		
		NO.		REVISIONS	DATE		BY		

SECTION NO.(s):	86030000
STATE ROAD(s):	A1A
PERMIT NO:	2023-L-491-00009
COUNTY:	BROWARD

EXHIBIT C

RESOLUTION

This Exhibit forms an integral part of the LANDSCAPE MAINTENANCE MEMORANDUM OF AGREEMENT between the FLORIDA DEPARTMENT OF TRANSPORTATION and the AGENCY.

Please see attached

RESOLUTION NO. R-2025-130

A RESOLUTION OF THE CITY COMMISSION OF THE CITY OF HOLLYWOOD FLORIDA, AUTHORIZING THE APPROPRIATE CITY OFFICIALS TO EXECUTE AMENDMENT NUMBER SEVENTEEN TO THE STATE OF FLORIDA DEPARTMENT OF TRANSPORTATION ("FDOT") LANDSCAPE INCLUSIVE MAINTENANCE MEMORANDUM OF AGREEMENT, WITH FDOT FOR MAINTAINING THE LANDSCAPE IMPROVEMENTS ON STATE ROAD A1A FROM THE SOUTHERN CITY LIMITS TO HOLLYWOOD BOULEVARD.

WHEREAS, the City together with the Hollywood Community Redevelopment Agency desire certain additional beautification improvements to State Road A1A to enhance the corridor aesthetic and improve the pedestrian experience; and

WHEREAS, the City will maintain the new landscape and hardscape improvements such as new sidewalks, pavers, asphalt patterned crosswalks and irrigation system; and

WHEREAS, on February 6, 2013, the City Commission passed and adopted Resolution No. R-2013-027, which authorized the execution of a Landscape Inclusive Maintenance Memorandum of Agreement ("MOA") with the Florida Department of Transportation ("FDOT") for the purpose of maintaining the landscape improvements by the City on various roads, including State Road A1A; and

WHEREAS, the MOA has been amended 16 times through various resolutions passed by the City Commission to include additional landscape improvements on various FDOT roads; and

WHEREAS, On September 14, 2021, the City Commission passed and adopted Resolution No. R-2021-234, which authorized the execution of amendment number 10 to the MOA with FDOT for the purpose of maintaining the landscape improvements by the City on State Road A1A from Hollywood Boulevard to Sheridan Street; and

WHEREAS, the Parties propose to again amend the MOU ("Amendment Number 17") to allow the City to construct additional landscape and hardscape improvements or modify an improvement as indicated in Exhibit "A" of the proposed amendment entitled "Landscape Improvements and Maintenance Boundaries," in accordance with the plans indicated in Exhibit "B" of the proposed amendment entitled "Landscape Improvement Plans"; and

WHEREAS, in order to include the modifications to the landscape improvements it is necessary to execute the Proposed Amendment; and

WHEREAS, funding for the landscape and maintenance improvements is available in account number 163.638507.55200.531170.000000.000.000.

NOW, THEREFORE, BE IT RESOLVED BY THE CITY OF HOLLYWOOD, FLORIDA.

Section 1: That the forgoing "WHEREAS" clauses are ratified and confirmed as being true and correct and are incorporated in this Resolution.

Section 2: That it approves and authorizes the execution, by the appropriate City officials, of the attached Amendment Number 17 to the State of Florida Landscape Inclusive Maintenance MOA with FDOT, together with such non-material changes as may be subsequently agreed to by the City Manager and approved as to form by the City Attorney.


Section 3: That this Resolution shall be in full force and effect immediately upon its passage and adoption.

PASSED AND ADOPTED this 16 day of April, 2025.




JOSH LEVY, MAYOR

ATTEST:

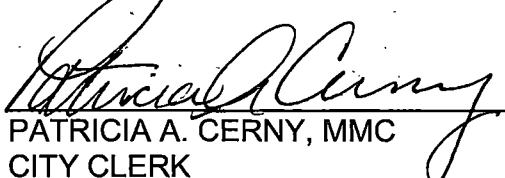

PATRICIA A. CERNY, MMC
CITY CLERK

APPROVED AS TO FORM:

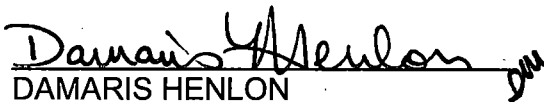

DAMARIS HENLON
INTERIM CITY ATTORNEY