




**FIRE LINE W/
FIRE RATED METER**

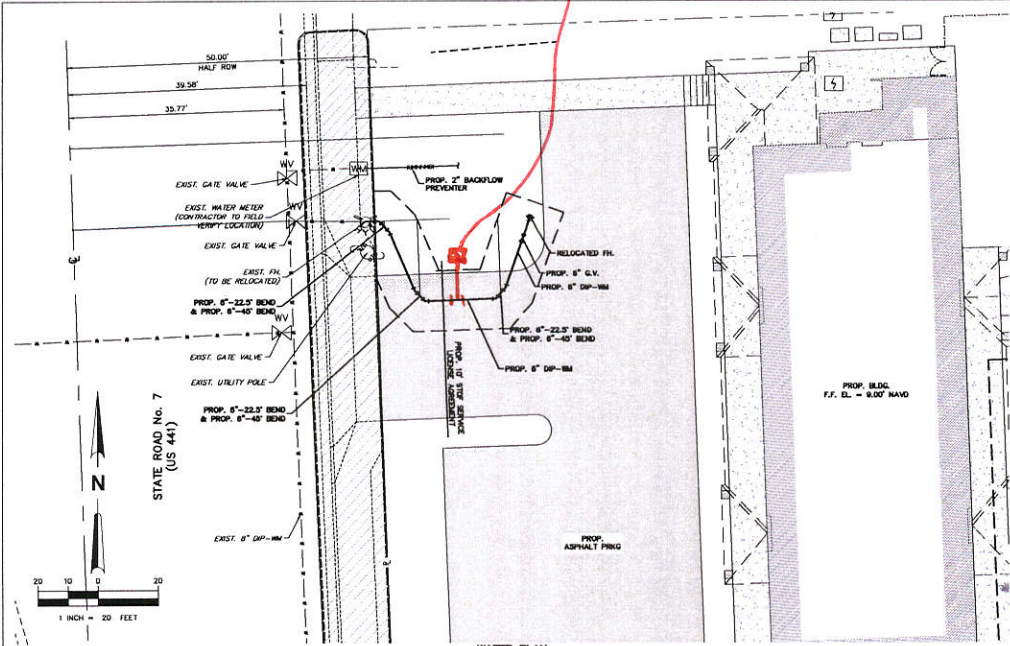

WATER PLAN
SCALE 1"=20'

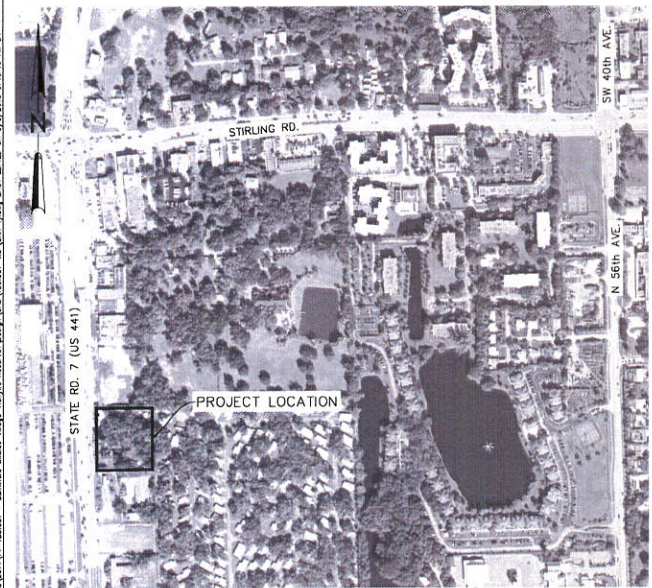

LOCATION MAP
SCALE 1"=200'

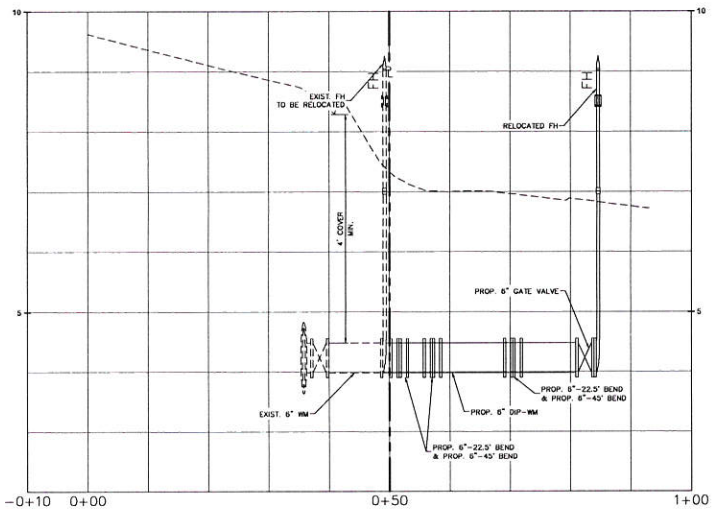

FIRE HYDRANT CONNECTION PROFILE (6" MM)
STA. 0+10.00 - STA. 0+80.00
SCALE HOR. 1"=20' - SCALE VER. 1"=2'

NOTES

- THE EXISTING CONDITIONS (EX. DRAWINGS) WERE BASED ON THE SURVEY PREPARED BY THE SEMINOLE TRIBE OF FLORIDA SURVEY AND MAPPING DEPARTMENT DATED 08/04/04. ADDITIONAL INFORMATION WAS OBTAINED FROM AS-BUILTS AND RECORD DRAWINGS PROVIDED BY UTILITY COMPANIES. VISIT INFORMATION AND FIELD VISITS.
- ALL ELEVATIONS REFER TO NAVD 1988 DATUM.
- EXISTING UTILITIES SHOWN ON UTILITY AS-BUILTS AND BEST AVAILABLE INFORMATION. CONTRACTOR TO FIELD LOCATE AND CONFIRM ALL UTILITIES. WHETHER SHOWN OR NOT. PRIOR TO ANY CONSTRUCTION & NOTIFY ENGINEER OF ANY DISCREPANCIES.

DATUM INFORMATION

ALL ELEVATIONS SHOWN ON THE CONSTRUCTION DRAWINGS ARE BASED ON NAVD 1988 DATUM. 0.00' NAVD 88 IS EQUIVALENT TO 1.300' NGVD 29.

SYMBOL LEGEND

SYMBOL	DESCRIPTION	SYMBOL	DESCRIPTION
○	CONC. POWER POLE	○	CHP / PLUG
○	WOOD POWER POLE	○	UTILITY VALVE
⌋	GUY ANCHOR	⊠	GAS METER
⊠	ELECTRICAL BOX	○	LIGHT POLE
⊠	CABLE TV BOX	○	SIGNAL MAST ARM
⊠	WATER VALVE	○	ISOLAND
⊠	SEWER VALVE	○	SPOT ELEVATION
⊠	STORM MANHOLE	○	SIGN
⊠	ELECTRIC MANHOLE	⊠	CATCH BASIN
⊠	SEWER MANHOLE	⊠	FIRE HYDRANT
⊠	MANHOLE	⊠	TEMP. SITE BENCHMARK
⊠	TELEPHONE MANHOLE	⊠	EX. TREE
⊠	REDUCER	⊠	EX. PALM TREE

LEGEND

SYMBOL	DESCRIPTION
---	PROPERTY LINE
---	RIGHT-OF-WAY LINE
---	CENTERLINE
---	LOT LINE
---	EX. OVERHEAD UTILITY LINES
---	EX. WATER MAIN
---	EX. STORMWATER PIPE
---	EX. GRAVITY SANITARY SEWER
---	EX. BURIED CABLE (COMCAST)
---	EX. COMMUNICATION/FIBER LINE
---	EX. TELEPHONE LINE
---	EX. UNDERGROUND ELECTRICAL

HATCH LEGEND

SYMBOL	DESCRIPTION
[Hatch Pattern]	PROP. ASPHALT
[Hatch Pattern]	PROP. CONC.
[Hatch Pattern]	PROP. SOIL
[Hatch Pattern]	PROP. STABILIZED SUBGRADE
[Hatch Pattern]	PROP. PATHWAY MATERIAL TO BE SELECTED BY STOP

Always call 811 two full business days before you dig to have underground utilities located and marked.

Sunshine811.com

155 S. Miami Ave., Suite PH II-A
Miami, FL 33130
Tel: (786) 497-1500
Fax: (786) 497-2300
EB 0048593

CHEN-MOORE & ASSOCIATES

CARTAYA & ASSOCIATES ARCHITECTS P.A.
3400 E. COMMERCIAL BLVD. SUITE 10
FT. LAUDERDALE, FLORIDA 33308
954777-2724 FAX 774-4280

SEMINOLE OKALEE VILLAGE HOLLYWOOD RESERVATION
3551 & 3681 N. STATE ROAD 7
HOLLYWOOD, FLORIDA 33021

PROJECT: [Blank]

WATER PLAN

DATE: JULY 20, 2015
DRAWN BY: CJP
CHECKED BY: PK / JLA

SHEET: **1342**

EXH-1.01

1 OF 2

V:\Projects\2014\14-188-001 - Seminole Okalee Village\Map\2014\188-001-MS (EX. 1).DWG, LAST EDITED ON 6/17/2015 8:42:10 AM BY [Blank]