PLANNING DIVISION




File No. (internal use only):_

GENERAL APPLICATION

2600 Hollywood Boulevard Room 315 Hollywood, FL 33022

	APPLICATION TYPE (CHECK ONE):
	Technical Advisory Committee
	City Commission Planning and Development Board
FLORIDA	Date of Application: 4/19/2023
Tel: (954) 921-3471	Location Address: 2306 Fillmore St Hollywood FL 33020
Fax: (954) 921-3347	Lot(s): <u>16</u> Block(s): <u>9</u> Subdivision: <u>Hollywood Little ranches</u> 1-26 B
	Folio Number(s): 5142 16 01 3930
	Zoning Classification: DH-2 Land Use Classification: Medium intensity Multi-Family
This application must be completed <u>in full</u> and	Existing Property Use: <u>Multi-Family</u> Sq Ft/Number of Units: <u>20,69/5 units</u>
submitted with all documents	Is the request the result of a violation notice? () Yes No If yes, attach a copy of violation.
to be placed on a Board or Committee's agenda.	Has this property been presented to the City before? If yes, check al that apply and provide File Number(s) and Resolution(s): PACO meeting 09/7/2022
The applicant is responsible	Economic Roundtable Technical Advisory Committee Historic Preservation Board City Commission Planning and Development
for obtaining the appropriate checklist for each type of	
application.	Explanation of Request: Construction of a new multi-family project on address.
Applicant(s) or their	30 units/30 bods
authorized legal agent must be present at all Board or	Number of units/rooms: <u>39 units/ 39 beds</u> Sq Ft: <u>35,105 total SF</u>
Committee meetings.	Value of Improvement: 7,500,000 Estimated Date of Completion: April 2024
	Will Project be Phased? () Yes No If Phased, Estimated Completion of Each Phase
At least one set of the	
submitted plans for each application must be signed	Name of Current Property Owner: 2306 FILLMORE ST LLC
and sealed (i.e. Architect or	Address of Property Owner: 2306 FILLMORE ST HOLLYWOOD FL 33020
Engineer).	Telephone: <u>213-254-8604</u> Fax: Email Address: <u>dekel@h-18.com</u>
Documents and forms can be	Name of Consultant/Representative/Tenant (circle one): <u>Agustina Maria Sklar</u>
accessed on the City's website	Address: 1421 NE 17th Street Fort Lauderdale FL Telephone: 954-608-9577
at	Fax: Email Address: agustina.sklar@gmail.com
http://www.hollywoodfl.org/Do cumentCenter/Home/View/21	Date of Purchase: 2021 Is there an option to purchase the Property? Yes () No (
	If Yes, Attach Copy of the Contract.
	List Anyone Else Who Should Receive Notice of the Hearing:
R X PA	Address:
	Email Address:

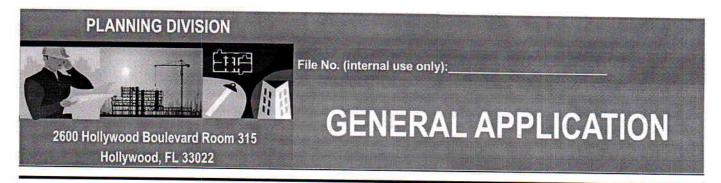

CERTIFICATION OF COMPLIANCE WITH APPLICABLE REGULATIONS

The applicant/owner(s) signature certifies that he/she has been made aware of the criteria, regulations and guidelines applicable to the request. This information can be obtained in Room 315 of City Hall or on our website at www.hollywoodfl.org. The owner(s) further certifies that when required by applicable law, including but not limited to the City's Zoning and Land Development Regulations, they will post the site with a sign provided by the Office of Planning and Development Services. The owner(s) will photograph the sign the day of posting and submit photographs to the Office of Planning and Development Services as required by applicable law. Failure to post the sign will result in violation of State and Municipal Notification Requirements and Laws.

(I)(We) certify that (I) (we) understand and will comply with the provisions and regulations of the City's Zoning and Land Development Regulations, Design Guidelines, Design Guidelines for Historic Properties and City's Comprehensive Plan as they apply to this project. (I)(We) further certify that the above statements and drawings made on any paper or plans submitted herewith are true to the best of (my)(our) knowledge. (I)(We) understand that the application and attachments become part of the official public records of the City and are not returnable.


Signature of Current Owner: Dekel muna,	Date: 01/23/2023
PRINT NAME: Dekel Emuna , Lior Emuna	Date: 01/23/2023
Signature of Consultant/Representative:	Date: 01/23/2023
PRINT NAME: AGUSTIVA SKLARK	Date:
Signature of Tenant:A	Date:
PRINT NAME:	Date:

Current Owner Power of Attorney

I am the current owner of the described real property and that I am aware of the nature and effect the request for <u>Dekel Emuna</u> to my property, which is hereby made by me or I am hereby authorizing <u>Agustina Sklar</u> to be my legal representative before the _____(Board and/or Committee) relative to all matters concerning this application.

Dekel muna Sworn to and subscribed before me aniam day of 6 Signature of Current Owner MARIA BRINGAS Notary Public - State of Florida IOR EMUNA Commission # GG 960644 EL EMUNIA My Comm. Expires Feb 20, 2024 Bonded through National Notary Assn Notan Public Print Name State of Florida My Commission Expires: Personally known to me; OR (Check One) Produced Identification 2

5300 W. HILLSBOR	O BLVD., SUITE 21 18-4940 FAX(954		Y, INC. EEEK, FLORIDA 33073 order@sfland.net
SURVEY ADDRESS: 2306 FILLMORE STREET HOLLYWOOD, FLORIDA 33020 FLOOD ZONE & ELEVATIONS: FLOOD ZONE: X(0.2%) BASE FLOOD ELEVATION: N/A CONTROL PANEL NO.: 125113-0569-H DATE OF FIRM INDEX: 08/18/14 REFERENCE BENCHMARK: BROWARD COUNTY ENGINEERING B.M. #1944 ELEVATION = 15.039' (NGVD 1929) ELEVATION = 13.441' (NAVD 1988) LECAL DESCRIPTION: LOT 16, BLOCK 9, OF "HOLLYWOOD LITTLE RANG	 6 FOOT WOOI LINES. 4 FOOT CHAIR ASPHALT PAR 5 FOOT CONC PROPERTY LI 6 FOOT WOOI EASEMENT AI 	RE ST LLC ENCROACHIM D FENCE CROSSES N LINK FENCE CRO RKWAY CROSSES (RETE WALK CROS NES. D FENCE AND 4 FO LONG THE SOUTH	OVER THE EASTERLY AND WESTERLY PROPERTY DSSES OVER THE SOUTHERLY PROPERTY LINE. OVER THE NORTHERLY PROPERTY LINE. SSES OVER THE EASTERLY AND WESTERLY OT CHAIN LINK FENCE ENCROACH INTO UTILITY ERLY PORTION OF THE SUBJECT PROPERTY.
PAGE 26, OF THE PUBLIC RECORDS OF BROWARI	O COUNTY, FLORE	DA.	
B.C.R.= BROWARD COUNTY RECORDSL.B.C.B.S.= CONCRETE BLOCK STRUCTUREL.P.CHATT.= CHATTAHOOCHEEM.H.C.O.= CLEANOUT(M)CONC.= CONCRETENAVC.L.F.= CHAIN LINK FENCENGVC.L.P.= CONCRETE LIGHT POLENO.(C)= CALCULATEDO.H.C.B.= CHORD BEARINGO.R.IC.R.= CABLE RISERO/S(D)= DEED(P)	V. = ELEVATION = ELECTRIC S & L. = FLORIDA PC = LICENSED F = LIGHT POLF = MANHOLE = MEASURED D = NORTH AMI D = NATIONAL C = NUMBER = OVERHANG B. = OFFICIAL RI = OFFSET = PLAT	I DERVICE DWER & LIGHT BUSINESS ERICAN VERTICAL GEODETIC VERTIC ECORDS BOOK	CAL DATUM T = TANGENT (TYP.) = TYPICAL U.E. = UTILITY EASEMENT W.F. = WOOD FENCE W.M. = WATER METER \triangle = DELTA OR CENTRAL ANGLE
 GENERAL NOTES: 1. TYPE OF SURVEY: BOUNDARY 2. IF THIS SURVEY HAS BEEN REVISED AS INDICATED IN BOX SHOWN HEREON, THEN ANY AND ALL PREVIOUS THIS SURVEY PREPARED BY PINNELL SURVEY, INC. A 3. PROPERTY INFORMATION REPORT (OWNERSHIP AND REPORT) PREPARED BY STEWART TITLE, FILE NO. 22- JANUARY 20, 2023 AT 8:00AM WAS REVIEWED BY PINN AND ALL PLOTTABLE MATTERS OF SURVEY CONTAIN REPORT ARE SHOWN HEREON. 4. UNLESS OTHERWISE NOTED, FIELD MEASUREMENTS. 5. ELEVATIONS SHOWN HEREON (IF ANY) ARE RELATIV 1988, UNLESS OTHERWISE NOTED. 6. UNDERGROUND IMPROVEMENTS AND UTILITIES ARE 7. FENCE AND WALL OWNERSHIP IS NOT DETERMINED. 8. THIS DRAWING IS THE PROPERTY OF PINNELL SURVE NOT BE USED OR REPRODUCED, WHOLE OR IN PART V WRITTEN PERMISSION & AUTHORIZATION FROM PINN 9. ALL EASEMENTS SHOWN ON THE ATTACHED DRAWIN RECORD PLAT (UNLESS OTHERWISE NOTED). 10. REFERENCE BENCHMARK ELEVATION DATUM WAS NGVD 1929 TO NAVD 1988 USING CORPSCON 6.0.1. 	S VERSIONS OF ARE NULL & VOID. ENCUMBRANCE FL-1180-A, DATED NELL SURVEY, INC. NED IN SAID ARE IN E TO NAVD NOT LOCATED. Y, INC. AND SHALL WITHOUT NELL SURVEY, INC. NG ARE PER THE	PROPERTY DES HAVE SET OR F SKETCH AND T ARE ACCURAT AND BELIEF. I I THE STANDARI FLORIDA ADMI STATE BOARD THIS SURVEY I	TION: TIFY THAT I HAVE RECENTLY SURVEYED THE SCRIBED IN THE FOREGOING TITLE CAPTION AND YOUND MONUMENTS AS INDICATED ON THIS HAT SAID ABOVE GROUND SURVEY AND SKETCH E AND CORRECT TO THE BEST OF MY KNOWLEDGE FURTHER CERTIFY THAT THIS SURVEY MEETS DS OF PRACTICE UNDER RULE 5J-17, NISTRATIVE CODE, ADOPTED BY THE FLORIDA OF PROFESSIONAL SURVEYORS AND MAPPERS. S NOT VALID WITHOUT THE ORIGINAL SIGNATURE A FLORIDA LICENSED SURVEYOR AND MAPPER. JASON H. PINNELL PROFESSIONAL SURVEYOR & MAPPER LICENSE NO. 5734, STATE OF FLORIDA
REVIEW AND REFLECT O&E REPORT (23-0695) REVISIONS	04/20/23 DATE	J.P. CHK'D BY	SKETCH NO.: 23-0220 DATE OF SURVEY: 02/14/23 CHECKED BY: S.A. FIELD BOOK/PAGE: 655/56 SIDE 1 OF 2

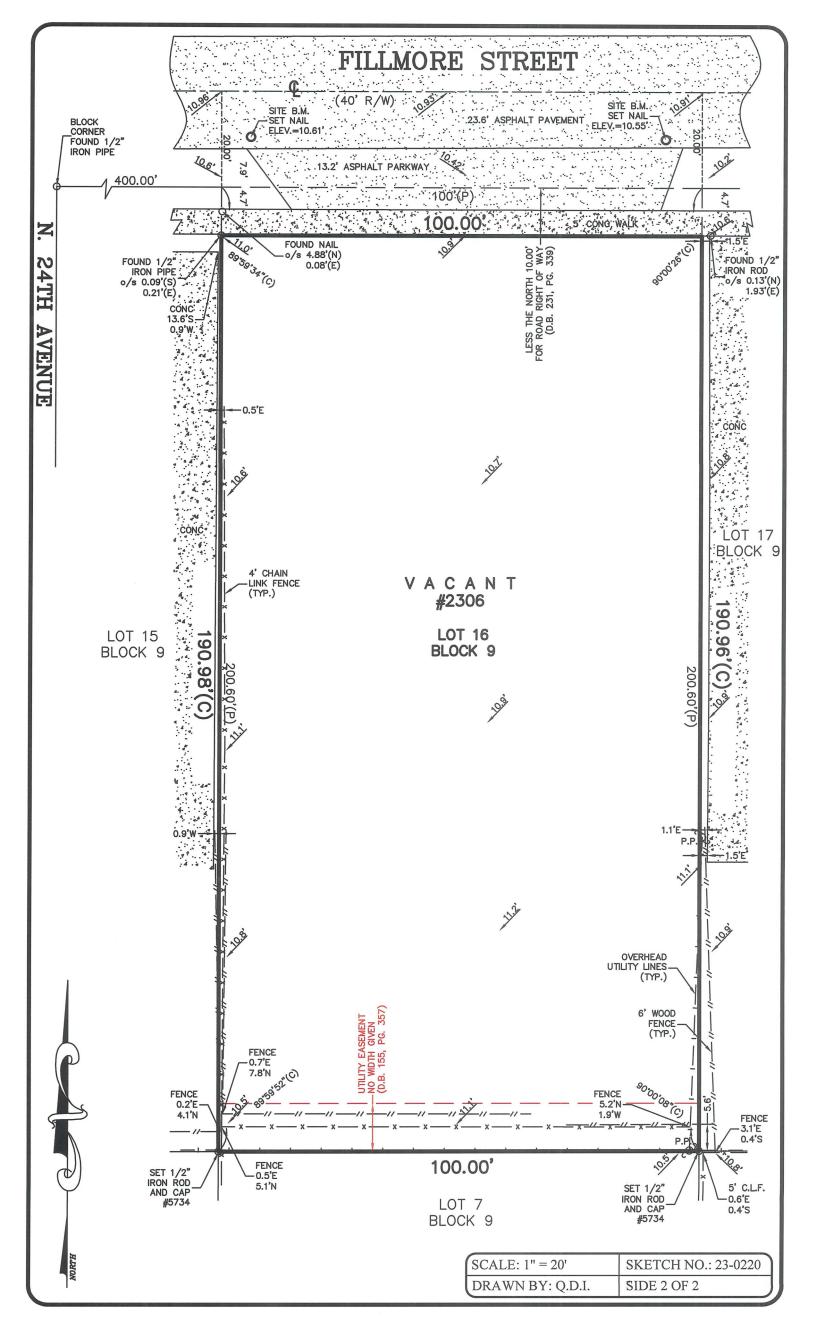



TECHNICAL ADVISORY COMMITTEE REPORT

February 6, 2023

2306 Fillmore ST LLC/Agustina Maria Sklar 1421 NE 17 Street Fort Lauderdale, FL 33305

FILE NUMBER: 23-DP-07

SUBJECT: Preliminary Site Plan and Design review for 40 Residential Units 2306 Fillmore Street.

SITE DATA

Owner/Applicant: Address/Location: Net Size of Property: Land Use: Zoning: Present Use of Land: Year Built: ADJACENT LAND USE	2306 Fillmore ST LLC 2306 Fillmore Street, Hollywood, FL 33020 20,060 sq. ft. (0.46 acres) Transit Oriented Corridor (TOC) DH-2 Multifamily (5 units) Not Applicable (Broward County Property Appraiser)
North:	Regional Activity Center (RAC)
South:	Regional Activity Center (RAC)
East:	Regional Activity Center (RAC)
West:	Regional Activity Center (RAC)
ADJACENT ZONING	
North: South: East: West:	Dixie Highway Medium Intensity Multi-Family District (DH-2) Dixie Highway Medium Intensity Multi-Family District (DH-2) Dixie Highway Medium Intensity Multi-Family District (DH-2) Dixie Highway Medium Intensity Multi-Family District (DH-2)

APPLICANTS MUST ADDRESS ALL COMMENTS AND FINDINGS AS IDENTIFIED BY MEMBERS OF THE TECHNICAL ADVISORY COMMITTEE BOTH IN WRITING (IDENTIFY PAGE NUMBER OF THE CORRECTION) AND ON THE SITE PLAN (ALL CHANGES MUST BE IDENTIFIED, I.E. BUBBLED).

A. APPLICATION SUBMITTAL

Tasheema Lewis, Associate Planner (tlewis@hollywoodfl.org) 954-921-3471

1. Provide plat determination letter from the County. Should platting be necessary, prior to Final TAC submittal County Plat comments are required. Plat shall be submitted for recordation prior to submitting for Planning and Development Board. Include several copies of plat documents in future submittals.

Response: See attached Plat Determination Letter from the County

- 2. Ownership & Encumbrance Report (O&E):
 - a. O&E Report does not indicate time of platting. Need to indicate it was searched from 1953 or time of platting (earliest of the two). O&E Report provided shows effective date of 1986.
 Response: noted. This has been fixed. New O and E report has been presented.
 - b. Must be dated within 30 days of submittal packet. **Noted**
 - Work with Engineering Division to ensure the O&E is accurate and all easements and dedications are indicated.
 noted
- 3. Alta Survey:
 - a. Shall be based on and dated after O&E. Ensure that O&E report is specifically referenced .Noted
 - Work with the Engineering Division to ensure the survey includes the appropriate elements such as all easements and dedications are indicated.
 Noted
- 4. Site Plan:
 - a. Indicate property lines on site plan. Response:See A-101 noting property lines
 - b. Driveway shall be a minimum of 11' for one-way traffic, site plan shows 9'10".
 Response:See A-101 noting driveway is now 11'
 - c. Provide dimensions for both curb cuts. Response:See A-101 noting absence of curb cuts (driveway is flush with the road) All driveway dimensions have been shown.
 - Provide bicycle racks or storage shall. 1 per 20 spaces required.
 Response Modifications were made to A-101. there is a parking stall there now.
 - e. Egress path shall have a minimum setback of 3ft, site plan shows 2ft. **Response:See egress path setbacks on A-101. This setback is now 3'**
 - f. Show length dimension of driveways.
 Response:See A-101 noting driveway length; both are 15'

- g. Ensure that all plumbing, mechanical and electrical fixtures, and equipment are indicated on Site Plan and Elevations.
 Response: Mechanical equipment is on the roof. We haven't yet coordinated with electrical and plumbing engineers.
- h. Show setbacks on site plan and provide dimensions for all balcony encroachments.
 Response:See A-101 noting setbacks and balcony lines above as well as the balcony setback line (encroachment) All balconies end at parking setbacks: 5' Side setbacks and 10' setbacks in the front.
- Show height dimensions for balcony railings.
 Response: see elevations noting railing heights as well as materials. All railings and parapets at balconies to be 42" A.F.F.
- j. Provide color material legend on elevation sheet. Response: See elevations noting materials and colors.
- Indicate fence height and material on site plan.
 Response: See Site Plan noting a 6' PVC fence and fire access gate.
- I. Indicate curbing type in the parking area. Response: No curbs proposed in parking area.
- m. Indicate the garage door opening on site plan.
 Response: Garage door has been eliminated since our last submission, the garage is now opened. See updated Elevations and Renderings.
- Need to provide Vehicle Use Area (VUA) calculation on site plan. 25% of paved vehicular use required.
 Response: Please seeA-003 noting this calculation
- o. Indicate car lift specifications in notes on site plan. **Response: Car Lifts have been abandoned.**
- 5. Site Data:
 - a. Open space requirement shall meet 20%, site plan shows 17.2%.
 Response: Please seeA-003 noting this calculation has changed. We've increased the previous surfaces in the driveway and have increased opened space on the roof as well.
- Complete and submit to Broward County School Board an impact fee application prior to submitting for Board consideration. Ensure that the application has not expired at the time of Board Consideration Website: <u>https://www.browardschools.com/cms/lib/FL01803656/Centricity/Domain/13479/PublicSchoolImpactApplication1.pdf</u>
 Response: Noted. This will be filled prior to Board Approval
- Indicate past, current and future meeting dates as they happen (not submittal dates) on Cover Sheet. Indicate specific Board/Committee (i.e. TAC, PDB, etc.) For future Board/Committee dates not known, leave blank until staff has advised of next meeting date.
 Response: Noted. See A-000 noting meeting dates.

8. A public participation outreach meeting shall be required for Land Use, Rezoning, Special Exception, and Site Plan requests. Applicants shall conduct at least one public participation outreach meeting and provide mailed written notice to all property owners and certified/registered civic and neighborhood association(s) within 500 feet of the proposed project. Fifteen days prior to the meeting, the applicant shall mail such notice and post a sign on the property, including the date, time, and place of the public participation outreach meeting. Such meeting shall occur prior to the applicable Committee, Board or City Commission submittal and the Applicant shall include in its application packet a letter certifying the date(s), time(s), location(s), a copy of the sig-in sheet, presentation material and general summary of the discussion, including comments expressed during the meeting(s).

The following Civic Association are located within 500 feet project site.

- a. Highland Gardens
- b. United Neighbors
- <u>c.</u> Downtown Parkside Royal Poinciana

Visit http://www.hollywoodfl.org/204/Neighborhood-Association-Contact-List for Contact Information.

Response: Noted. It's my understanding that these Civic Associations aren't correct. Please provide the name of Associations so we can begin scheduling this meeting.

- 9. Additional comments may be forthcoming. **Response: noted.**
- 10. Provide written responses to all comments with next submittal. **Response: responses have been provided.**

B. ZONING

Tasheema Lewis, Associate Planner (<u>tlewis@hollywoodfl.org</u>) 954-921-3471

- 1. Work with the City's Landscape Architect to ensure that all landscape requirements are met. Response: Noted. Landscape Architect has coordinated and updated all their drawings.
- Dumpster enclosure required. Show dimensioned enclosure on site plan.
 Response: Please see A-101 noting dimensions of trash enclosure. Also please see A-501 noting a detail of the dumpster enclosure.

C. ARCHITECTURE AND URBAN DESIGN

Tasheema Lewis, Associate Planner (<u>tlewis@hollywoodfl.org</u>) 954-921-3471

- All renderings shall reflect actual proposed landscape material. Work with the City's Landscape Architect to ensure species proposed are appropriate.
 Response: Renderings have been updated.
- 2. Consider different color option for garage doors as the proposed color creates strong contrast. **Response: Renderings have been updated.**

D. SIGNAGE

Tasheema Lewis, Associate Planner (<u>tlewis@hollywoodfl.ora</u>) 954-921-3471

1. For review, full signage package shall be provided. Response: Noted. Full Signage will be provided.

E. LIGHTING

Tasheema Lewis, Associate Planner (tlewis@hollywoodfl.org) 954-921-3471

1. Substantially compliant.

F. GREEN BUILDING & ENVIRONMENTAL SUSTAINABILITY

Tasheema Lewis, Associate Planner (<u>tlewis@hollywoodfl.ora</u>) 954-921-3471

- Indicate on the site plan where the infrastructure necessary for future installation of electric vehicle-charging equipment will be located. (See 151.154, Ordinance O-2016-02) Consider placing it adjacent to a handicapped space so that the future charger will be accessible from both types of spaces. Response: Please see A-101 future electric vehicle charging stations.
- Work with Building Department to ensure compliance with Green Building Ordinance. Review and adjust drawings as necessary. Indicate on drawings Green Building certification to be achieved.
 Response: Please see A-003 for this note.

G. ENGINEERING

Azita Behmardi, City Engineer (<u>abehmardi@hollywoodfl.org</u>) 954-921-3251 Clarissa Ip, Assistant City Engineer (<u>cip@hollywoodfl.org</u>) 954-921-3915 Rick Mitinger, Transportation Engineer (<u>rmitinger@hollywoodfl.org</u>) 954-921-3990

<u>Revision Procedure:</u>

-Any revisions applied to the plans shall be numbered and bubbled/clouded. -In an 8.5"x11" revision summary, identify each revision by providing the plan sheet number, revision cloud / bubble number and a narrative describing each change or how a comment is being addressed.

1. Provide and show on plans for a 10' wide right-of-way dedication along Fillmore Street as confirmation cannot be made by the survey and the title search. Identify the current property line and the property line after the dedication on plans. All features of the proposed development shall begin from the proposed property line after the right-of-way dedication.

Response:10' dedication has been provided. See modification made to all plans including Site Plan, First Floor, Second Floor, Third Floor, and Roof.

- Provide easements, agreements and lease that were identified under Items 13-17 in the O & E report. Add and indicate in the survey accordingly.
 Noted
- Provide plat determination letter from the Broward County Planning Council.
 Response: See attached Plat Determination Letter from the County
- Please identify the angle of the parking stalls as per City's Parking Lot Geometrics. Please include curb distance/depth.
 Response: Angle of parking stalls have been provided. See A-101. Please see detail 02 on A-101 for curb distance and depth.
- 5. All plans shall have a North arrow to identify the orientation of the property. **Response: North Arrow has been added to all pages**

- 6. Please identify all curbing on the plan and provide the typical standard detail. **Response: No proposed curbs in ROW or within property lines.**
- 7. Please clearly identify the property line along all sides of the site on plans. **Response: See A-101 all property lines have been labeled.**
- 8. Please provide sidewalk connectivity to existing sidewalks on the neighboring properties. Indicate and provide for a new sidewalk on Fillmore Street to connect to existing sidewalks. Please identify and dimensions the new sidewalk proposed on the site plan, 5' minimum. All sidewalks shall be ADA compliant. Please provide detectable warning at drive entrances and provide detail. Response: Please See A-101 showing new 5' sidewalk and the ADA warning and drive entrances as well as detail.
- No walkway shall be permitted to extend beyond the sidewalk. Walkways shall terminate at the sidewalk. Please provide on plans.
 Response: This has been fixed. See A-101
- 10. On Site Plan, dimension and label all features of the rights-of-way.
 - a. Dimension existing right-of-way width and show limits of the rights-of-way on both sides of Fillmore Street.
 - b. Include and show all surrounding elements of the site on plans, including adjacent alley, road, properties, limits of rights-of-way on both sides of adjacent streets or alleys including any curb cuts, edge of pavement, swale, sidewalks etc.

Response: This has been provided. See A-101

11. On Site Plan please identify all material types proposed (i.e apron, parking lot, sidewalk, and walkways, etc.)

Response: See A-101 noting materials

12. Please identify the vertical height clearance of the garage throughout and especially at the entrance and exit. Provide dimension on the elevation as well.

Response: Please see A-201 and A-202. Garage floor clearance is 14' and garage door clearance is 10'

13. Sheet A-101, a perimeter wall or fence is being shown on plan at the property lines. Please label and indicate height and material of wall/fence. Provide details such a cross-section to ensure wall/fence and its footer does not encroach to adjacent properties.

Response: What is being shown is a 6' fence. A-101 is showing this detail noting the footer does not encroach adjacent properties. See detail #06 on A-101.

14. Indicate if there will be any security gate at the driveway openings. If so, please indicate type of gate and how it operates (remote, sensor, card reader, etc.). Be sure to provide space required for gate's operation and provide sufficient vehicle queueing. All vehicle queueing shall be with in private property. If entry is not gated, minimum of one vehicle queueing space is required (8.5'x19' minimum).

Response: Garage doors have been abandoned, garage is now opened. See A-101 to see queuing space is being shown within the property line.

15. Label the elevators on plans. **Response: labeled.**

16. Applicant is required to provide a minimum of (2) ADA parking stalls. Please identify on plans with the proper pavement markings and signage per code. In addition, ADA accessible routes are required between accessibility parking and building's Lobby access as well as an accessible route to the sidewalk in the public rights-of-way. For the accessible route, identify any change in elevation or slopes. If there is no change in elevation, indicate on plans the transition is flush. Please add a note on the site plan stating any lip from 1/4" but not greater than ½" will be beveled to meet ADA requirements.Consider relocating the door near parking stall 22 to avoid having a pedestrian walking in the drive aisle. (i.e., move door to south wall).

Response: 2% of the required 43 spaces is 1 We are required to provide one ADA spot. This is being shown closest to the entrance to the lobby to minimize the egress path distance. Notes have been added in an accessible route that change in elevation is $\frac{1}{2}$ max.

- 17. Please identify the access to the Transformer Room/Meters. **Response:added,**
- 18. No doors shall open into the vehicular drive aisle (i.e., maintenance storage). **Response: fixed.**
- 19. Please identify what is being proposed next to Parking Stall 33. Please call out all unidentified structures. **Response: This has been abandoned. Bike storage is now in the SE corner.**
- 20. On Site Plan, dimension the total distance between the proposed driveways, from edge to edge. **Response: Shown.**
- 21. Sheet A-101, in the ADA and standard parking stall details, overhang should be 2', not 2'-6". Response:noted. This has been fixed.
- Applicant is showing a walkway within the required side setback. All walkways must be setback a minimum of 3 feet from the side property lines. Please revise.
 Response:Revised.
- Please show trash chute on Sheet A-101.
 Response: There is no trash chute on the garage floor. Trash Chute is on the floors above and trash falls into the trash & dumpster enclosure which can be found south of the lobby.
- 24. Provide AutoTurn analysis to show how trash trucks maneuverability through the site for pick up can be achieved. Be sure to have sufficient vertical clearance for dump truck operation to empty out dumpsters.

Response:Truck Routing Analysis (Autoturn) has been provided. Refer to sheet C-100. Dumpsters will be rolled out onto the street for pick up. Trucks are not expected to enter the parking garage. Average vehicle turn analysis in the parking garage was also provided.

25. Two one-way driveways are being proposed for the proposed development, the opening varies in widths. Also, typically the right driveway (when facing the property) is the Entrance a site while the left is the Exit a site.

Response: This has been revised.

- 26. The driveway aprons do not meet the minimum requirements for one way aisle spaces. The minimum required aisle space for a one way is 11 feet. Please adjust the aprons accordingly. Please keep in mind that this property is only allowed to have a maximum total curb cut width of 30 feet. (i.e. Driveway A + Driveway B = max. 30 feet).
 Response:This has been revised.
- 27. Please identify the length of the columns proposed near stalls 26/27 and 22/23. **Response:This has been revised.**
- Parking stalls 31/32 do not have the appropriate back out to be 90-degree stalls. Please provide a minimum clear back out of 22 feet.
 Response: This has been revised.
- 29. Visibility triangles shall be provided as per Chapter 155.12 of the City Code. View triangles are within the property lines of the site and run along the edge of the driveway and front property line. **Response:This has been revised. See A-101 showing view triangles.**
- Parking lifts specifications will be required for review and approval. Demonstrate how lifts will fit and function within the parking stalls.
 Response: This has been abandoned.
- Sheet A-003, in the Parking Calculations Table, the total number of parking provided adds up to 54, 48 is shown as the Total. The number of parking shown on plan view is 48.
 Response:This has been revised. 43 parking stalls are required. 39 one bedroom units=39 parking stalls and 4 guests=43 stalls.
- 32. Please provide a pavement marking plan that is compliant with Broward County Traffic Engineering and City of Hollywood Standards. Provide any and all applicable standard sheets in the plan. (i.e. stop bars, do not enter signs, directional arrows, wrong way signs, parking stall stripping, ADA pavement markings etc.). Response:Refer to sheet C-101 for Pavement marking & signage sheet.
- 33. For water and sanitary sewer connection in the rights-of-way, Show the full roadway restoration for Fillmore Street, from the tap in of the water main to the connection made on the site. provide full road width pavement resurfacing and indicate on civil plans. Include construction details. Response:Full roadway restoration is proposed for the lot frontage after utilities installations.
- Please add the following notes to the plans: Full road width pavement mill and resurface is required for adjacent road.
 Response:Note has been added to PGD sheet.
- Please provide a pavement marking plan for the restoration of the pavement markings in the ROW and within the site if applicable.
 Response: ROW striping will be restored per BCTED & amp; MUTCD standards. Note has been added to sheet C-400.
- 36. Applicant will need to restore the swale area of the ROW. Please provide a plan showing the removal of the existing apron and restoration of the swale from property line to edge of pavement in the ROW. The proposed aprons will need to extend to the edge of pavement in the ROW on Fillmore and the areas adjacent to them are to be restored with sod.

Response: Concrete apron and roadside swale to be restored. Refer to sheet C-200.

- 37. Provide plans for the sewer line extension shown on Sheet C-101. Plans should show continuation of the entire extension and tie in location. Indicate the path of the main and any restoration required, i.e. swale, curbing, pavement restoration, pavement mill and resurfacing, pavement markings, etc. Full road or lane width pavement mill and resurfacing is required.
 Response:Plans show sewer lateral connection to a new proposed sanitary sewer main from 2306
 Fillmore, east to an existing sewer manhole. Proposed sewer main plans are provided on sheet C-400
- Add street name to civil plans.
 Response: Fillmore Street is shown on all Civil Plans
- Show all vehicular turning radii on site and civil plans.
 Response: Vehicle routing plan is provided on sheet C-100
- 40. Elements within the rights-of-way are inconsistent between Landscape, Civil and Architectural plans. Response:All drawings have been coordinated.
- Please note that the City, in conjunction with the Downtown Community Redevelopment Agency, is working on developing a manual setting forth requirements for rights-of-way design and improvements guidelines in the RAC area. Rights-of-way improvements are to be determined and will be required. Continued coordination will be necessary.
 Response: Noted.
- 42. MOT plans required at the time of City Building Permit review. **Response: Noted.**
- 43. All outside agency permits must be obtained prior to issuance of City building permit. **Response: Noted.**
- Impact fees (inclusive of park impact fee) under the new City Ordinance PO-2022-17, effective September 21, 2022, to be paid prior to building permit issuance.
 Response: Noted.
- 45. More comments may follow upon review of the requested information. **Response: Noted.**

H. LANDSCAPING

Favio Perez, Landscape Reviewer (<u>fperez@hollywoodfl.org</u>) 954-921-3997 Clarissa Ip, Assistant City Engineer (<u>cip@hollywoodfl.org</u>) 954-921-3915

- 1. Tree survey shows 24 trees/palms on site. Landscape plan shows 8 total. **Response: Trees shown by arborist are the only trees currently on site.**
- Revise tree disposition, Norfolk island pine is a nuisance tree and exempted from mitigation.
 Response: Norfolk Island Pine has been removed from mitigation. See TD-1 with revision cloud.

- Show city approved protection detail with orange mesh.
 Response: Orange mesh tree protection has been added. See TD-1 with revision cloud.
- 4. North arrow points to wrong direction on plans. Response: North arrow is correct. See plans with revision cloud.
- Most of the sheets on the landscape plan are name L-1. Revise sheet numbering.
 Response: Landscape sheets are labeled L-1,L-2,L-3 see revision clouds on each set.
- Provide 24x36 PDF sheets on next submittal as the ones submitted are smaller than the rest of the project set.
 Response: All sheets are 24" x 36".
- Landscape data chart says: Single-Family requirements. Revise as per project zoning.
 Response: Single family has been removed from site calculations chart. SEE L-1 with revision cloud.
- Revise mitigation calculations as needed and add details of which trees/palms are being used to satisfy the mitigation.
 Response: See corrections
- Street trees required 1 per 30 lf. Provide additional tree in center swale area.
 Response: ROW has been removed no landscape area for street trees.
- West perimeter has a 2' landscape area. Provide alternative landscape buffer plants that provide a vertical coverage and move the proposed trees to another location. Proposed trees will grown into walkway and neighboring property.
 Response: Trees have been replaced to palms and shrub has been changed to green buttonwood shrub to produce vertical coverage.
- 11. Label sod areas. Response: Sod area labeled.

I. UTILITIES

Alicia Verea-Feria, Engineer (<u>averea-feria@hollywoodfl.org</u>) 954-921-3302

1. Include plan view of proposed sewer extension to point of connection 750 LF east along Fillmore to stub out across 2129 Fillmore.

Response: Refer to sheet C-400 for construction of the new Sewer main installation on Fillmore Street.

- 2. Show Water and Sewer demand calculations on proposed utilities plans. Response: Refer to water and sewer demand calcs on sheet C-300.
- 3. Sewer cleanout shall be proposed at property line within the private side of the property. Response: Sewer cleanout is added within the property line. Refer to sheet C-300.
- 4. This site resides currently within FEMA Flood Zone X. The proposed FFE = 12.50' NAVD88 is acceptable. Response:Min Lobby FFE has been revised to 11.75' NAVD. No apartment on the 1 st floor.
- Indicate FFE for all enclosed areas on the ground floor.
 Response: Min Garage Elevation is 11.00' NAVD88. Office lobby will be set at 11.75' NAVD88

6. Provide perimeter cross sections across all property limits including dimension, transition areas with 6" swales, slopes 4:1 (3:1 max) and meeting adjacent property grades.

Response:Perimeter cross-sections are provided.

7. Provide details for proposed dual chamber injection wells and catch basins including rim and invert elevations.

Response: Catch basin and injection well details are provided.

8. Ensure all stormwater is retained onsite.

Response: All stormwater will be retained on site. The proposed pipe system will collect runoff form the site, driveway, and roof and convey it to the proposed injection well system.

- Provide preliminary drainage calculations.
 Response: Drainage Calculations are provided with this submittal.
- 10. Permit approval from outside agencies will be required.

Response: Permits from Broward County EPD, Department of Health, and FDEP will be provided for drainage, sewer and water system.

- 11. Landscape plans to be submitted should coordinate with civil plans to accommodate for drainage features. **Response: All drawings have been coordinated.**
- 12. Additional comments may follow upon further review of requested items.

J. BUILDING

Russell Long, Assistant Building Official (<u>rlong@hollywoodfl.org</u>) 954-921-3490 Daniel Quintana, Electrical Plans Examiner/Inspector (<u>dquintana@hollywoodfl.org</u>) 954-921-3335

1. No comments received.

<u>K. FIRE</u>

Jorge Castano, Deputy Fire Marshal / Division Chief (<u>icastano@hollywoodfl.org</u>) 954-967-4404

Fire review for TAC is limited to fire department access and minimum fire flow requirements for water supply for firefighting purposes. A complete architectural review will be completed during formal application of architectural plans to the building department.

1. At time of submittal, water supply must meet NFPA 1, 18.4.5.3. In order to determine the minimum fire flow for firefighting purposes, a hydrant flow test will need to be scheduled through our underground utilities dept., 954-921- 3046. After the results are completed, the civil engineer shall show on civil drawings the calculations using table 18.4.5.1.2 showing that the project meets the minimum fire flow requirements for the building.

Response: There is no existing fire hydrant. A new fire hydrant is proposed to serve the new building. Fire demand calculations are provided in utility plan sheet C-300.

2. Provide a note on civil drawing all underground fire main work must be completed by fire protection contractor holding a Class I, II, or V license per FS 633.102.

Response: Note has been added to the utility sheet C-300.

3. At time of submittal civil drawings must be provided for the underground fire main. Providing location of fire department connection, fire hydrants, DDCV, and size of fire line from water supply, etc. Check with our water department engineer for city requirements in addition to fire. Ensure plans show that there is a fire hydrant within 100 feet of fire department connections.

Response: Fire Hydrant, DDCV, FDC are all provided on the plans. Refer to sheet C-300

4. Be advised that NFPA 1 (2018 edition) Chapter 11.10.1 requires that minimum radio signal strength for fire department communications be maintained at a level determined by the AHJ for all new and existing buildings including complying with NFPA 72 (2016 edition). BDA system may be required. **Response:Note will be added to the plans. MEP to confirm at a later date.**

5. Per NFPA 1, 12.3.2* a quality assurance program for the installation of devices and systems installed to protect penetration and joints shall be prepared and monitored by the registered design professional responsible for design. Inspections of fire stop systems and fire-resistive joint systems shall be in accordance with 12.3.2.1 and 12.3.2.1. Architectural plans will be required to show this information moving forward for buildings three stories or greater in height. Provide a note on the plan regarding NFPA 1, 12.3.2*. **Response:Note has been added to the plan.**

L. PUBLIC WORKS

Charles Lassiter, Assistant Public Works Director (<u>classiter@hollywoodfl.org</u>) 954-967-4207

1. No comments received.

M. PARKS, RECREATION AND CULTURAL ARTS

David Vazquez, Assistant Director (<u>dvazquez@hollywoodfl.ora</u>) 954-921-3404

2. Park Impact Fee application required.

N. COMMUNITY DEVELOPMENT

Liliana Beltran, Housing inspector (<u>lbeltran@hollywoodfl.org</u>) 954-921-2923

1. Refer to Planning comments to ensure compliance with Public Participation requirements.

O. ECONOMIC DEVELOPMENT

Raelin Storey, Director (<u>rstorey@hollywoodfl.org</u>) 954-924-2922 Herbert Conde-Parlato, Economic Development Manager (<u>hconde-parlato@hollywoodfl.org</u>) 954-924-2922

1. Substantially compliant.

P. POLICE DEPARTMENT

Christine Adamcik, Police (cadamcik@hollywoodfl.org) 954-967-4371

Steven Bolger, Police (<u>sbolger@hollywoodfl.org</u>) 954-967-4500 Doreen Avitabile, Police (<u>davitabile@hollywoodfl.org</u>) 954-967-4371

1. Substantially compliant.

Q. DOWNTOWN AND BEACH CRA

Jorge Camejo, Executive Director (jcamejo@hollywoodfl.org) 954-924-2980 Susan Goldberg, Deputy Director (sgoldberg@hollywoodfl.org) 954-924-2980 Francisco Diaz-Mendez, Project Manager (<u>fdiaz-mendez@hollywoodfl.org</u>) 954-924-2980

1. Not applicable.

R. PARKING

Jovan Douglas, Parking Operations Manager (jdouglas@hollywoodfl.org) 954-921-3548

1. No comments received.

S. ADDITIONAL COMMENTS

Tasheema Lewis, Associate Planner (<u>tlewis@hollywoodfl.org</u>) 954-921-3471

1. Additional comments may be forthcoming.

The Technical Advisory Committee does not find this application substantially compliant with all applicable regulations, therefore the Applicant must resubmit for TAC review.

Please be advised, in the future any additional review by the TAC may result in the payment of additional review fees.

If these comments have not been addressed within 120 days of this dated report the application will expire. As a result, a new application and fee will be required for additional review by the TAC.

Note that any use proposed for the site shall be consistent with Zoning and Land Development Regulations.

Should you have any questions, please do not hesitate to contact your Project Planner at 954-921-3471.

Sincerely,

Tasheema Lewis Associate Planner

C: 2306 Fillmore Street via email <u>dekel@h-18.com</u> Agustina Sklar via email <u>agustina.sklar@gmail.com</u>


PROPOSED 39-UNITS MULTI FAMILY DEVELOPMENT FOR: H-18 DEVELOPMENT, LLC AT 2306 FILLMORE STREET, HOLLYWOOD FL 33020

DRAWING INDEX

ARCHITECTURE	
A-000 COVER SHEET & LOCATION	
A-001 DESIGN INTENT	
A-002 CONTEXT VIEWS	
A-003 OVERALL SITE PLAN	
A-101 GROUND FLOOR PLAN	
A-102 SECOND FLOOR PLAN	
A-103 THIRD FLOOR PLAN	
A-104 FOURTH FLOOR PLAN	
A-105 ROOF PLAN	
A-201 BUILDING ELEVATIONS	
A-202 BUILDING ELEVATIONS	
A-501 SCHEDULES AND DETAILS	
CIVIL ENGINEERING	
C-50 DEMOLITION, SWPPP & EROSION CONTROL PLAN	
C-100 TRUCK ROUTING ANALYSIS	
C-101 PAVING MARKING & SIGNAGE PLAN	
C-200 PAVING, GRADING, DRAINAGE PLANS.	
C-300 WATER & SEWER UTILITY PLAN	
C-400 SEWER MAIN CONSTRUCTION PLAN	
C-500 WATER UTILITY DETAILS	
C-501 WATER UTILITY DETAILS	
LANDSCAPE ARCHITECTURE	
TD TREE DISPOSITION	
L-2 ROOFTOP LANDSCAPE PLAN AND NOTES	
L-3 LANDSCAPE DETAILS AND SPECIFICATIONS	
I-2 IRRIGATION DETAILS AND SPECIFIATIONS	

ABBREVIATIONS



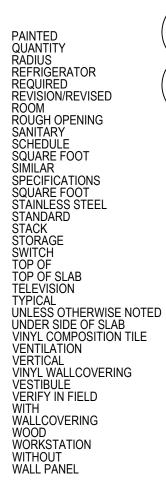

LOCATION MAP





CITY MEETING SCHEDULE

PACO PRE-TAC PRE-TAC



09/07/2022 02/06/2023 05/08/2023









STORE FRONT VS CLASSING TEXTURE







OLD HOLLYWOOD & ART DECO STYLE OF THE TIME

DESIGN INSPIRATION

_ _ _ _ _ _ _ _ _ _ _ _

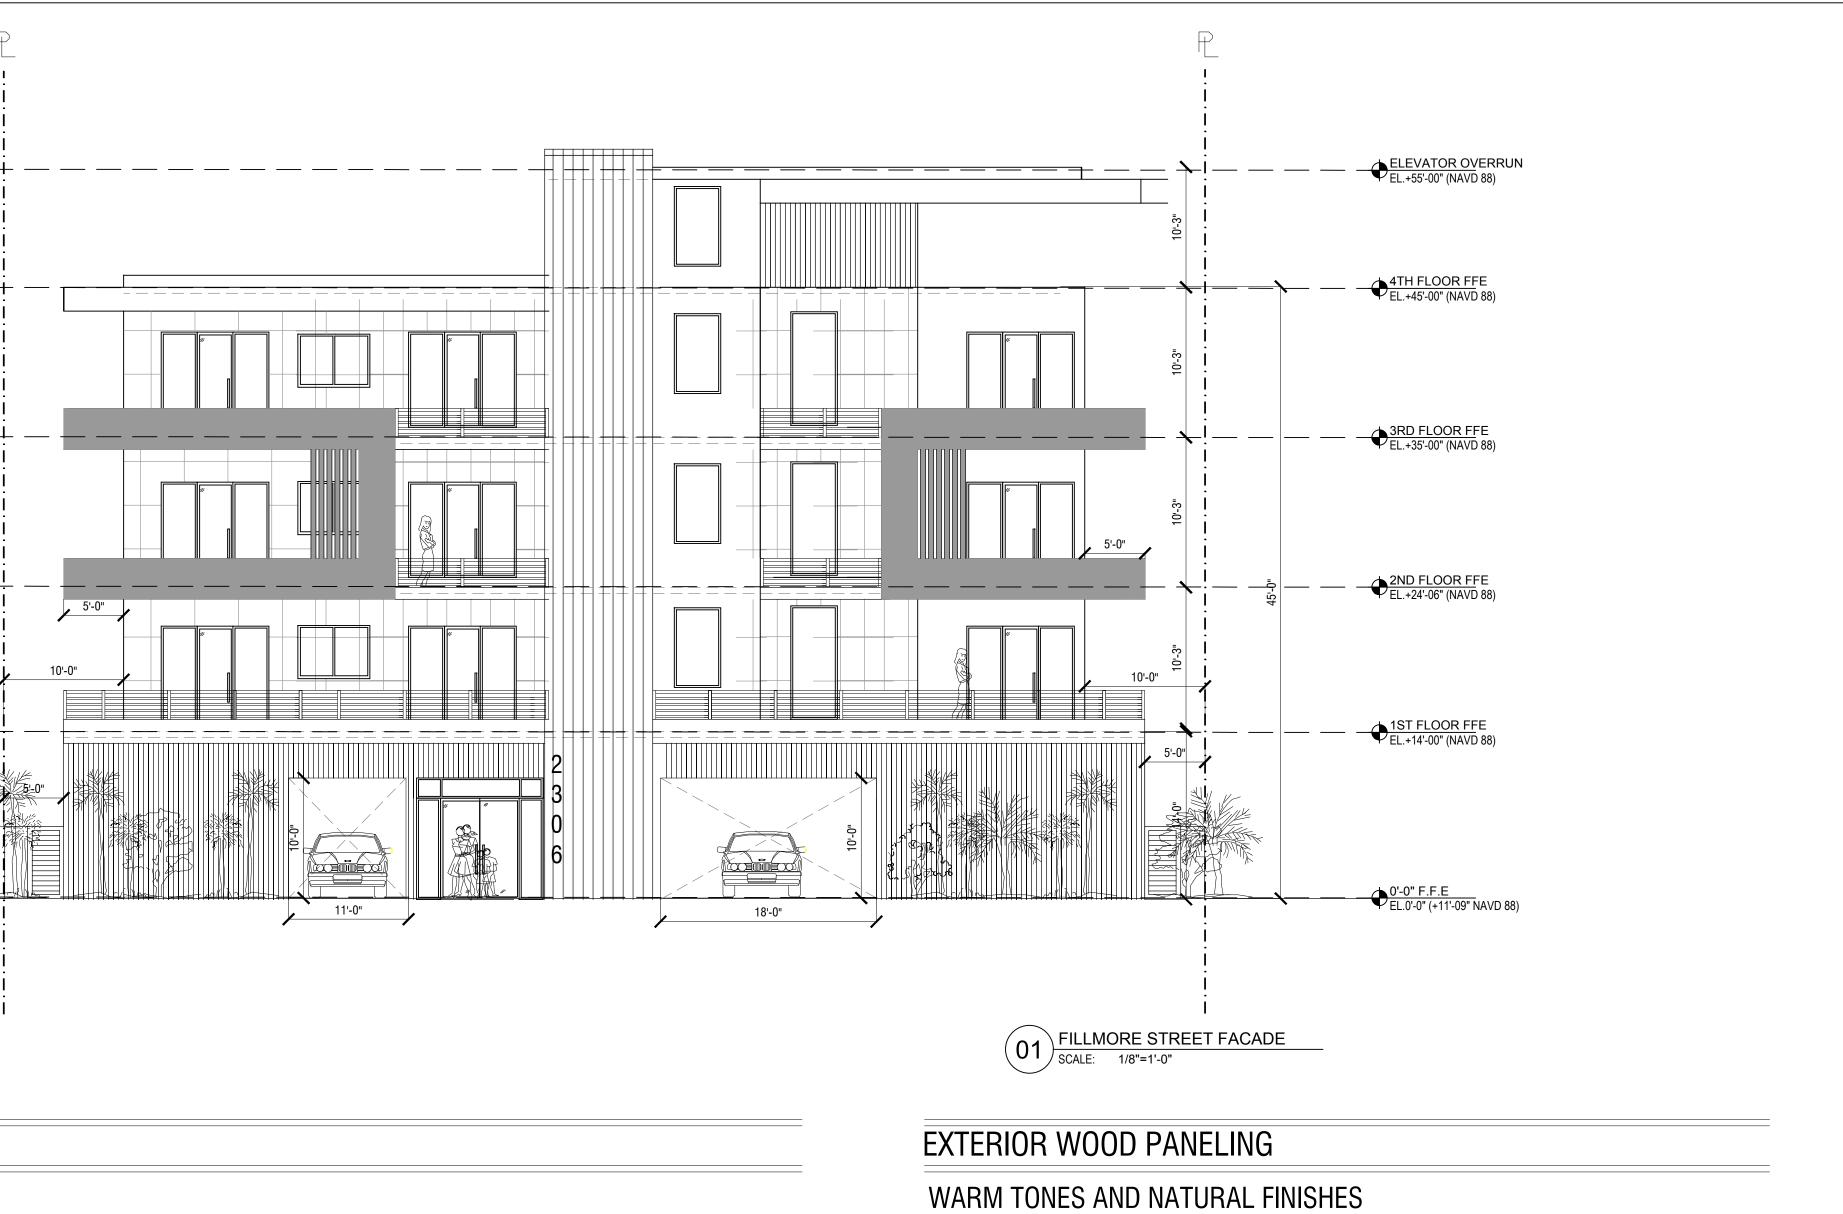

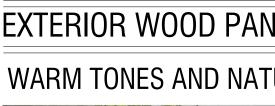



ART DECO-INSPIRED SIGNAGE





OWNER

H18 DEVELOPMENT LLC 1314 E BROWARD BLVD STE 1503 FORT LAUDERDALE FL 33301

ARCHITECT

LANDSCAPE

ARCHITECT


RAHIM VEDAEE 4132 SW 51ST STREET Dania Beach FL, 33314


M ENGINEERING DESIGN, LLC 207 SEMINOLE LAKES DRIVE Royal Palm Beach, FI 33411


AMS ARCHITECTURE AND DESIGN_CORP 1421 NE 17TH STREET . Fort Lauderdale, FL 33305


CIVIL ENGINEER




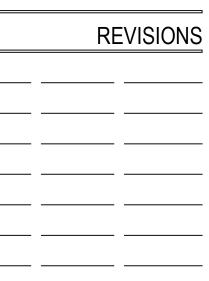

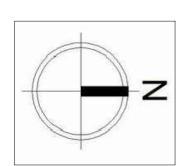

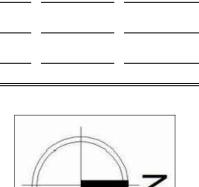

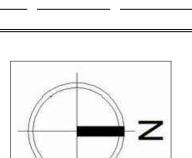

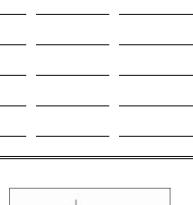



DESIGN INTENT


SHEET NO. A-001





SCALE:N.T.S DATE: 2/01/2021 DRAWING TITLE: STREET PROFILE AND CONTEXT VIEW

SHEET NO. **A-002**

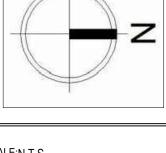



PRO DE[,] 23 REVISIONS

ဟ E \square

ARCHITECTURE AND DESIGN 1421 NE 17TH STREET FORT LAUDERDALE, FLORIDA 33305 WWW.AMSARCHITECTURE.COM AA 101065

AGUSTINA MARIA SKLAR FL. ARCHITECT REG. NO: AR101065

M ENGINEERING DESIGN, LLC 207 SEMINOLE LAKES DRIVE Royal Palm Beach, FI 33411

LANDSCAPE ARCHITECT RAHIM VEDAEE 4132 SW 51ST STREET Dania Beach FL, 33314 **CIVIL ENGINEER**

OWNER

H18 DEVELOPMENT LLC 1314 E BROWARD BLVD STE 1503 FORT LAUDERDALE FL 33301


ARCHITECT AMS ARCHITECTURE AND DESIGN CORP 1421 NE 17TH STREET . Fort Lauderdale, FL 33305

PROJECT DATA

PROJECT NAME AND ADDRESS 2306 FILLMORE STREET HOLLYWOOD FL 33020

Ζ	ONING.			
	ZONING :	DH-2	Dixie Highway Med	ium Intensity Multi-Family Dis
	LOT SIZE:	20,06	9 SF (.461 ACRES)	
	MAX FAR :	1.752	X 20,069 SF= 35,120	SF
	MAX HEIGHT:	4 STO	ORIES NOT TO EXC	EED 45'
	OPEN SPACE:	20%	OF TOTAL SITE ARE	EA
	SETBACKS	ALLO'	WABLE	PROPOSED
	FRONT	15'		15'
	REAR	20'		20'
	SIDES (INT)	10'		10'
	PARKING SETBACKS:	ALLOV	VABLE	PROPOSED
	FRONT	10'		10'
	INTERIOR	5'		5'
	ALLEY	5'		N/A'
			_	

BUILDING AMENITIES: RECREATIONAL POOL & ROOF RESERVABLE BBQ AREA,

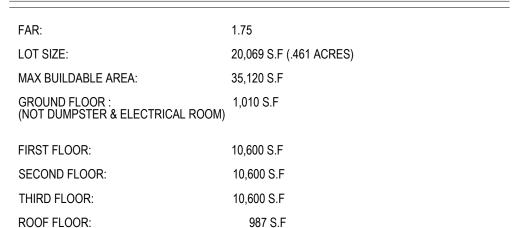





HEIGHT PROVIDED:


FLORIDA.


MAX HEIGHT ALLOWED: 4 STORIES NOT TO EXCEED 45' 45' TOP OF STRUCTURAL ROOF SLAB

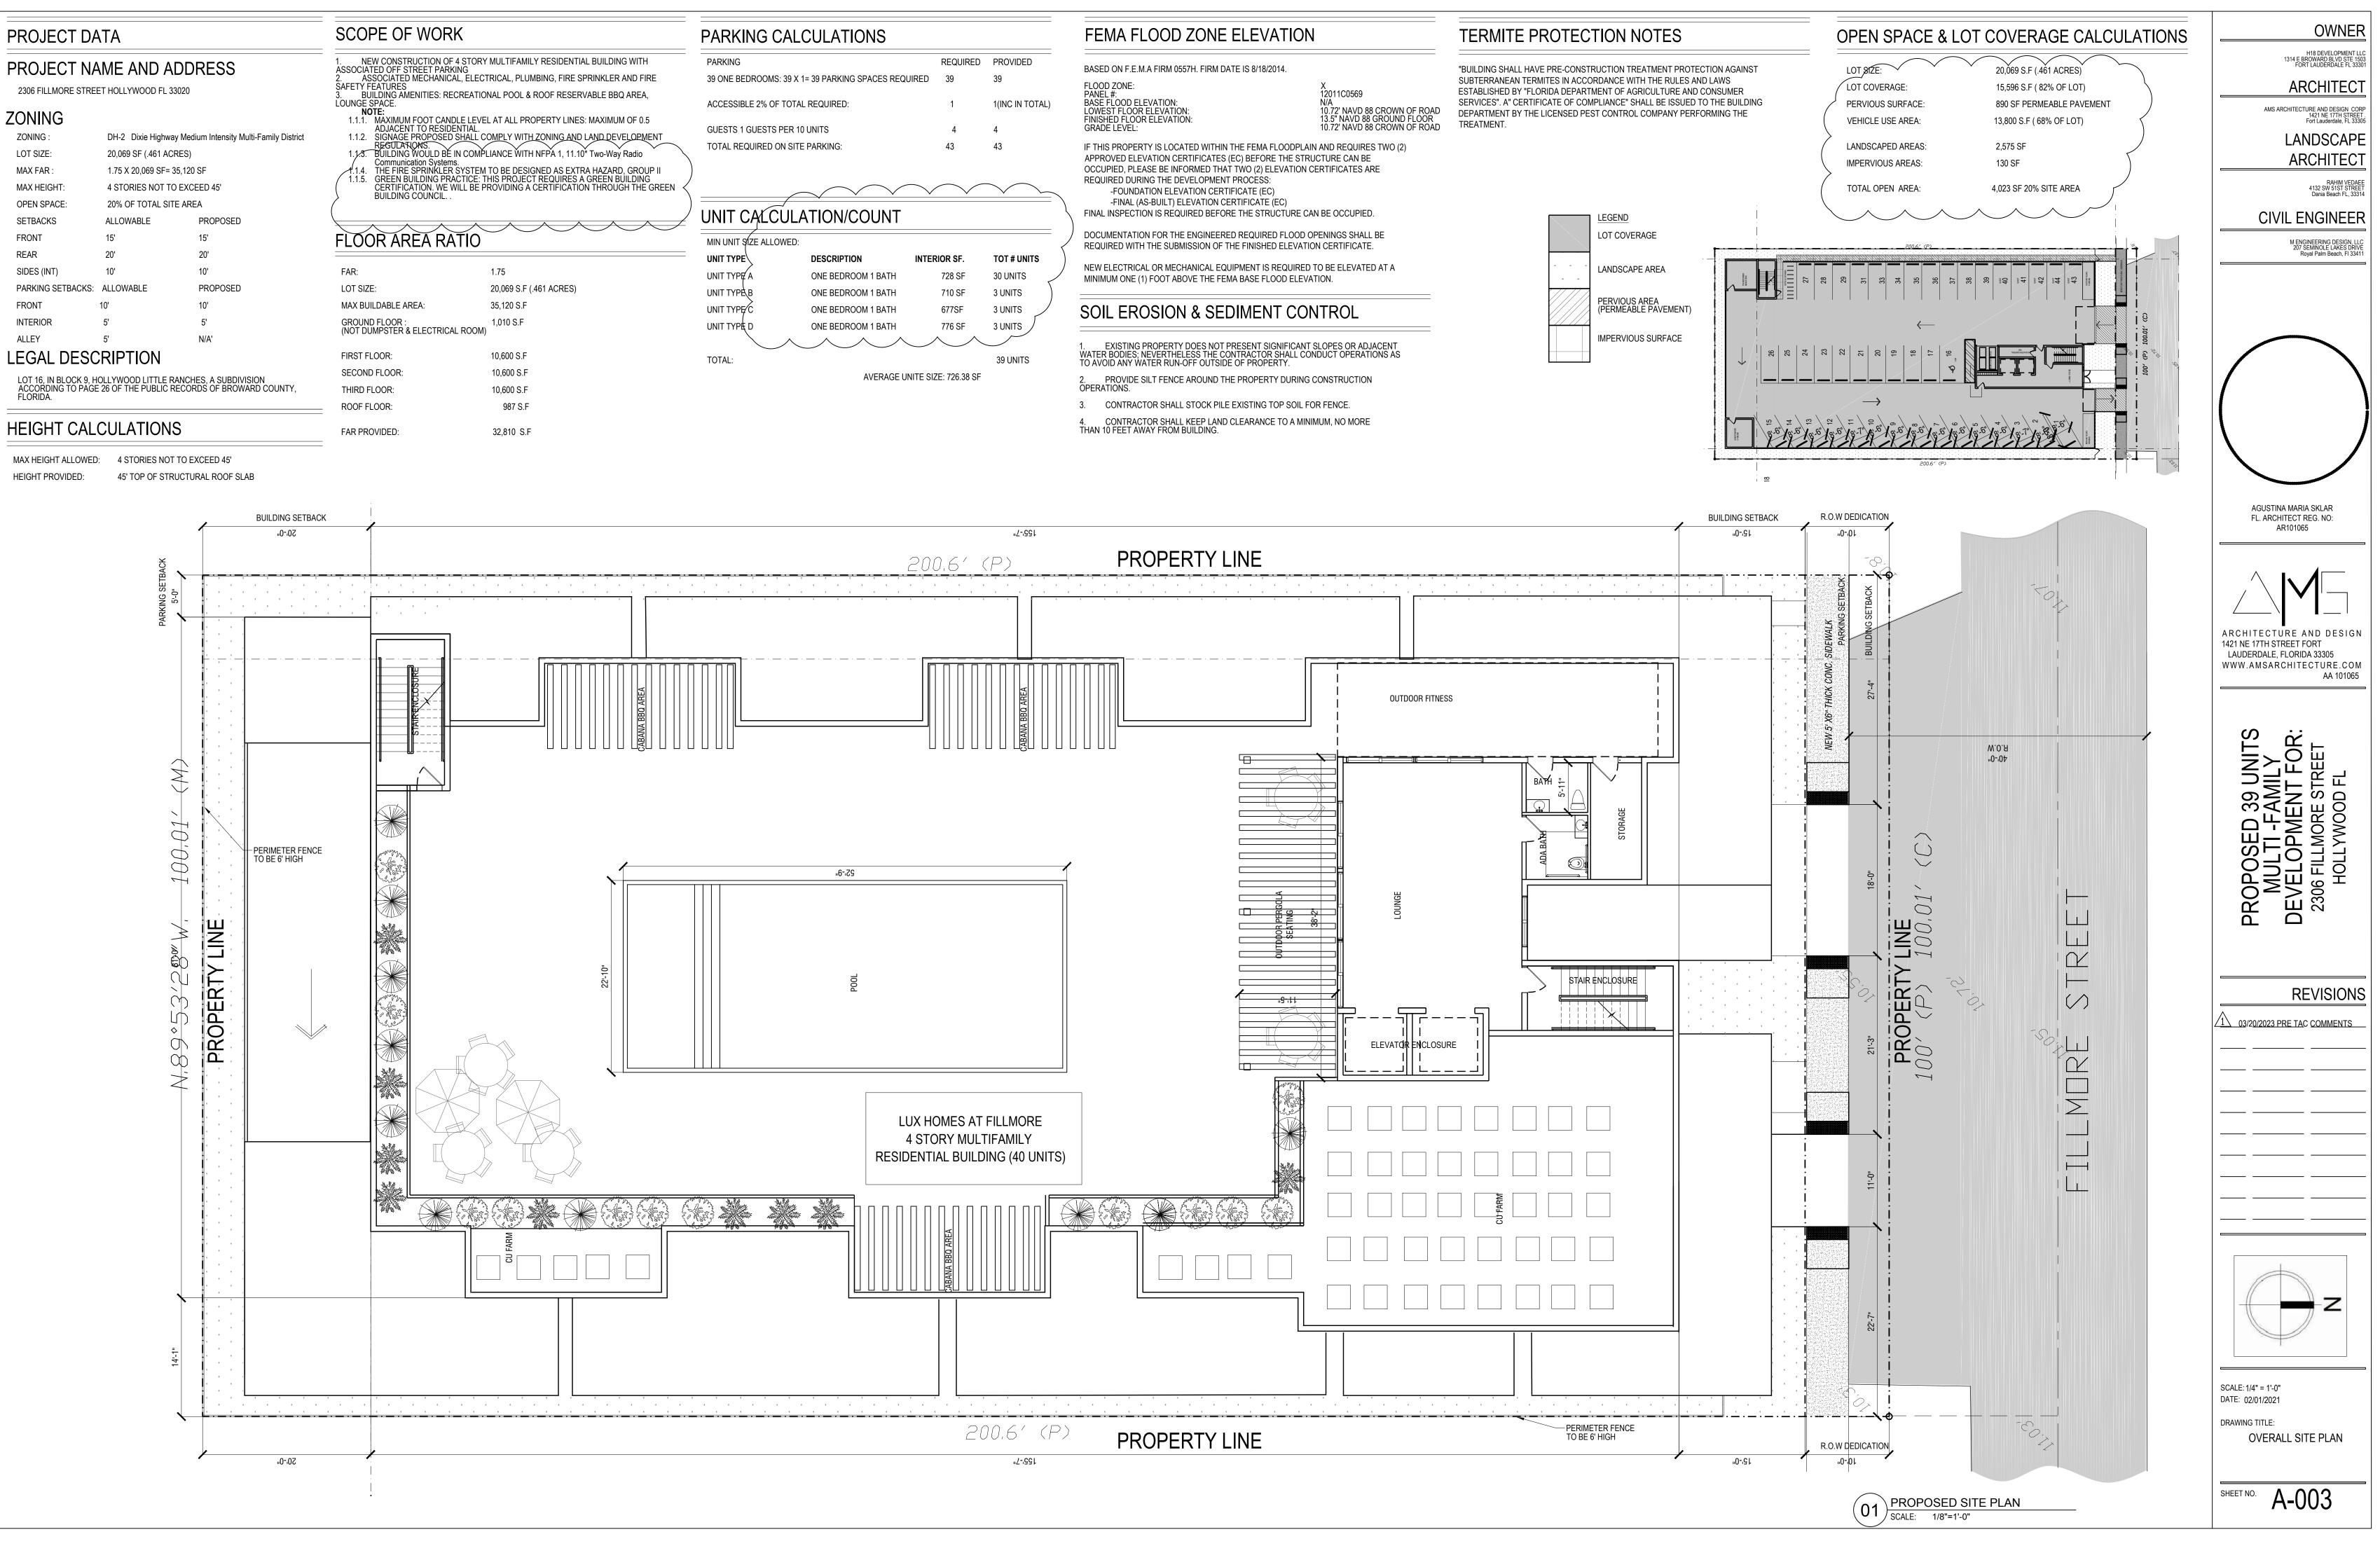


CULATIONS			FEMA FLOOD ZONE EL	EVATION	TERMITE PROTEC	CTION NO
1= 39 PARKING SPACES REQUIRED	REQUIRED 39	PROVIDED 39	BASED ON F.E.M.A FIRM 0557H. FIRM DATE IS	S 8/18/2014. X 12011C0569	"BUILDING SHALL HAVE PRE-CONS SUBTERRANEAN TERMITES IN ACC ESTABLISHED BY "FLORIDA DEPAR	ORDANCE WITH T
AL REQUIRED:	1	1(INC IN TOTAL)	PANEL #: BASE FLOOD ELEVATION: LOWEST FLOOR ELEVATION: FINISHED FLOOR ELEVATION: GRADE LEVEL:	12011C0569 N/A 10.72' NAVD 88 CROWN OF ROAD 13.5" NAVD 88 GROUND FLOOR	SERVICES". A" CERTIFICATE OF CC DEPARTMENT BY THE LICENSED P	MPLIANCE" SHALI
IO UNITS	4	4	GRADE LEVEL:	10.72' NAVD 88 CROWN OF ROAD	TREATMENT.	
'E PARKING:	43	43	IF THIS PROPERTY IS LOCATED WITHIN THE I APPROVED ELEVATION CERTIFICATES (EC) E OCCUPIED, PLEASE BE INFORMED THAT TWO REQUIRED DURING THE DEVELOPMENT PRO	BEFORE THE STRUCTURE CAN BE O (2) ELEVATION CERTIFICATES ARE DCESS:		
			-FOUNDATION ELEVATION CERTIFICA -FINAL (AS-BUILT) ELEVATION CERTIF			
ATION/COUNT			FINAL INSPECTION IS REQUIRED BEFORE TH	E STRUCTURE CAN BE OCCUPIED.		LEGEND
		<	DOCUMENTATION FOR THE ENGINEERED RE REQUIRED WITH THE SUBMISSION OF THE FI			LOT COVERAG
	RIOR SF.	TOT # UNITS	NEW ELECTRICAL OR MECHANICAL EQUIPME	ENT IS REQUIRED TO BE ELEVATED AT A		LANDSCAPE A
ONE BEDROOM 1 BATH	728 SF	30 UNITS	MINIMUM ONE (1) FOOT ABOVE THE FEMA BA	ASE FLOOD ELEVATION.		
ONE BEDROOM 1 BATH ONE BEDROOM 1 BATH	710 SF 677SF	3 UNITS 3 UNITS	SOIL EROSION & SEDIM			PERVIOUS ARE (PERMEABLE F
ONE BEDROOM 1 BATH	776 SF	3 UNITS				
	\wedge	39 UNITS	1. EXISTING PROPERTY DOES NOT PRESI WATER BODIES; NEVERTHELESS THE CONTR/ TO AVOID ANY WATER RUN-OFF OUTSIDE OF I	ENT SIGNIFICANT SLOPES OR ADJACENT ACTOR SHALL CONDUCT OPERATIONS AS PROPERTY.		IMPERVIOUS S
AVERAGE UNITE S	IZE: 726.38 SF		2. PROVIDE SILT FENCE AROUND THE PR OPERATIONS.	OPERTY DURING CONSTRUCTION		
			3. CONTRACTOR SHALL STOCK PILE EXIS	STING TOP SOIL FOR FENCE.		
			4. CONTRACTOR SHALL KEEP LAND CLEA THAN 10 FEET AWAY FROM BUILDING.	ARANCE TO A MINIMUM, NO MORE		

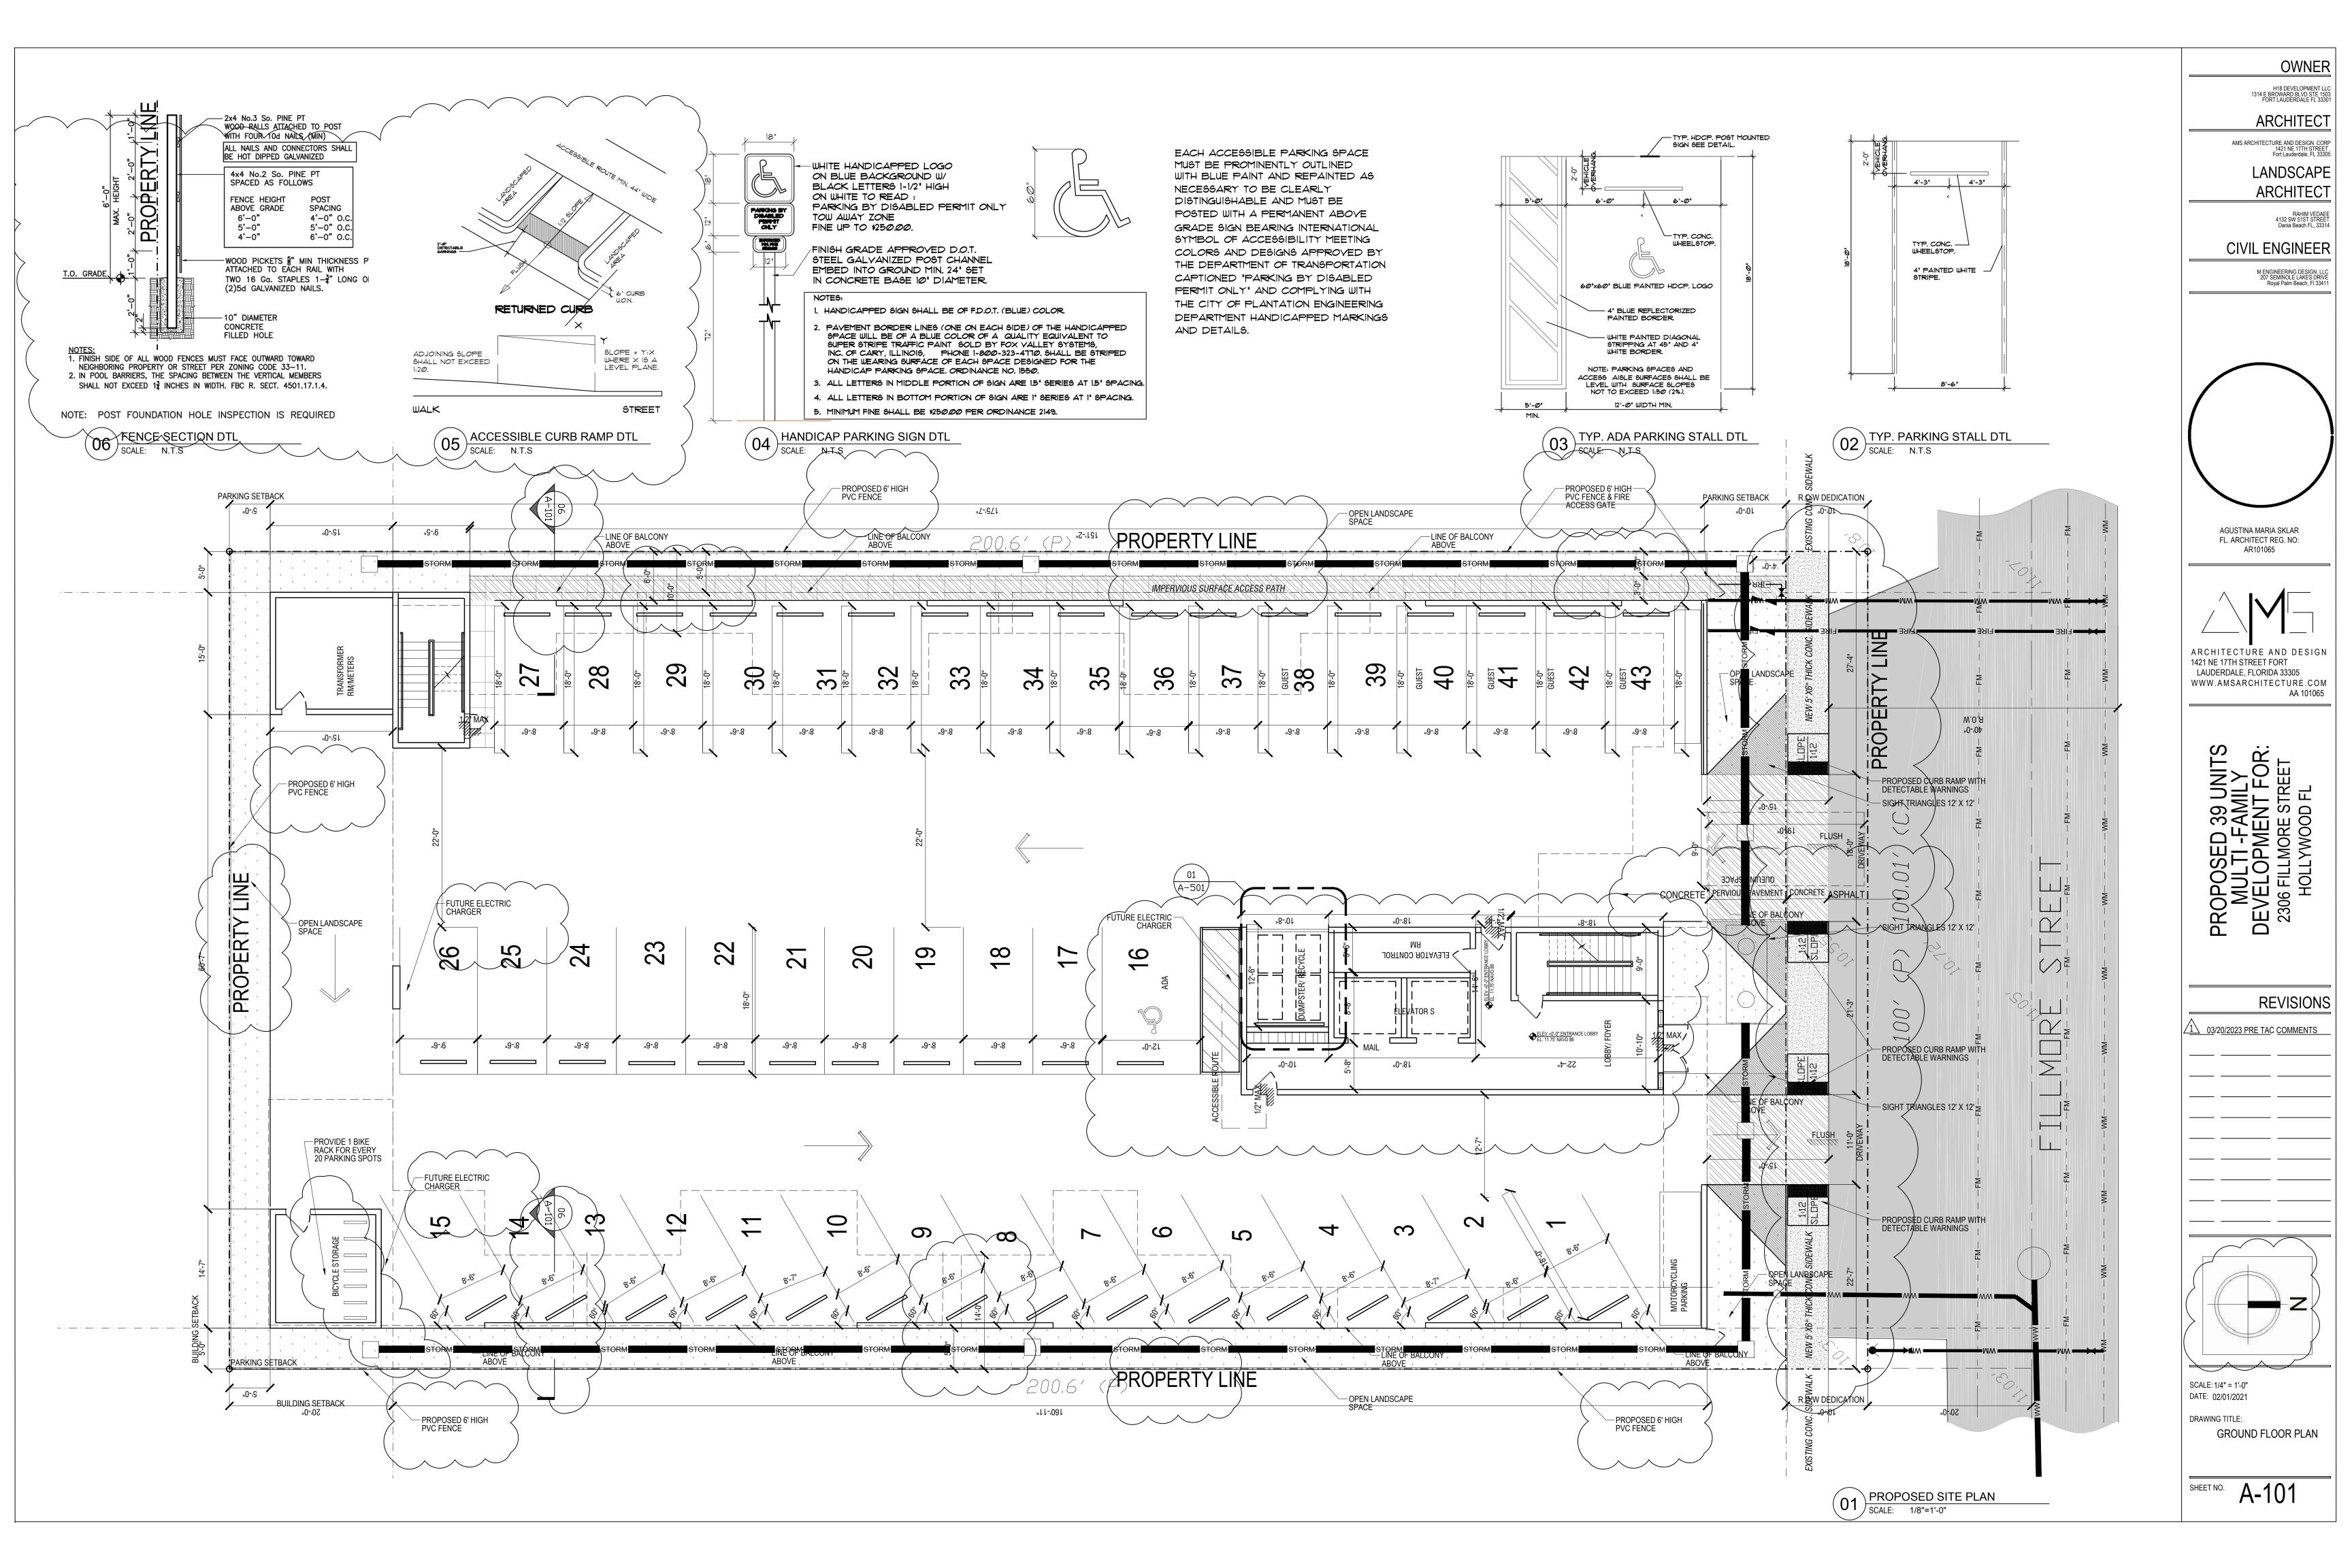


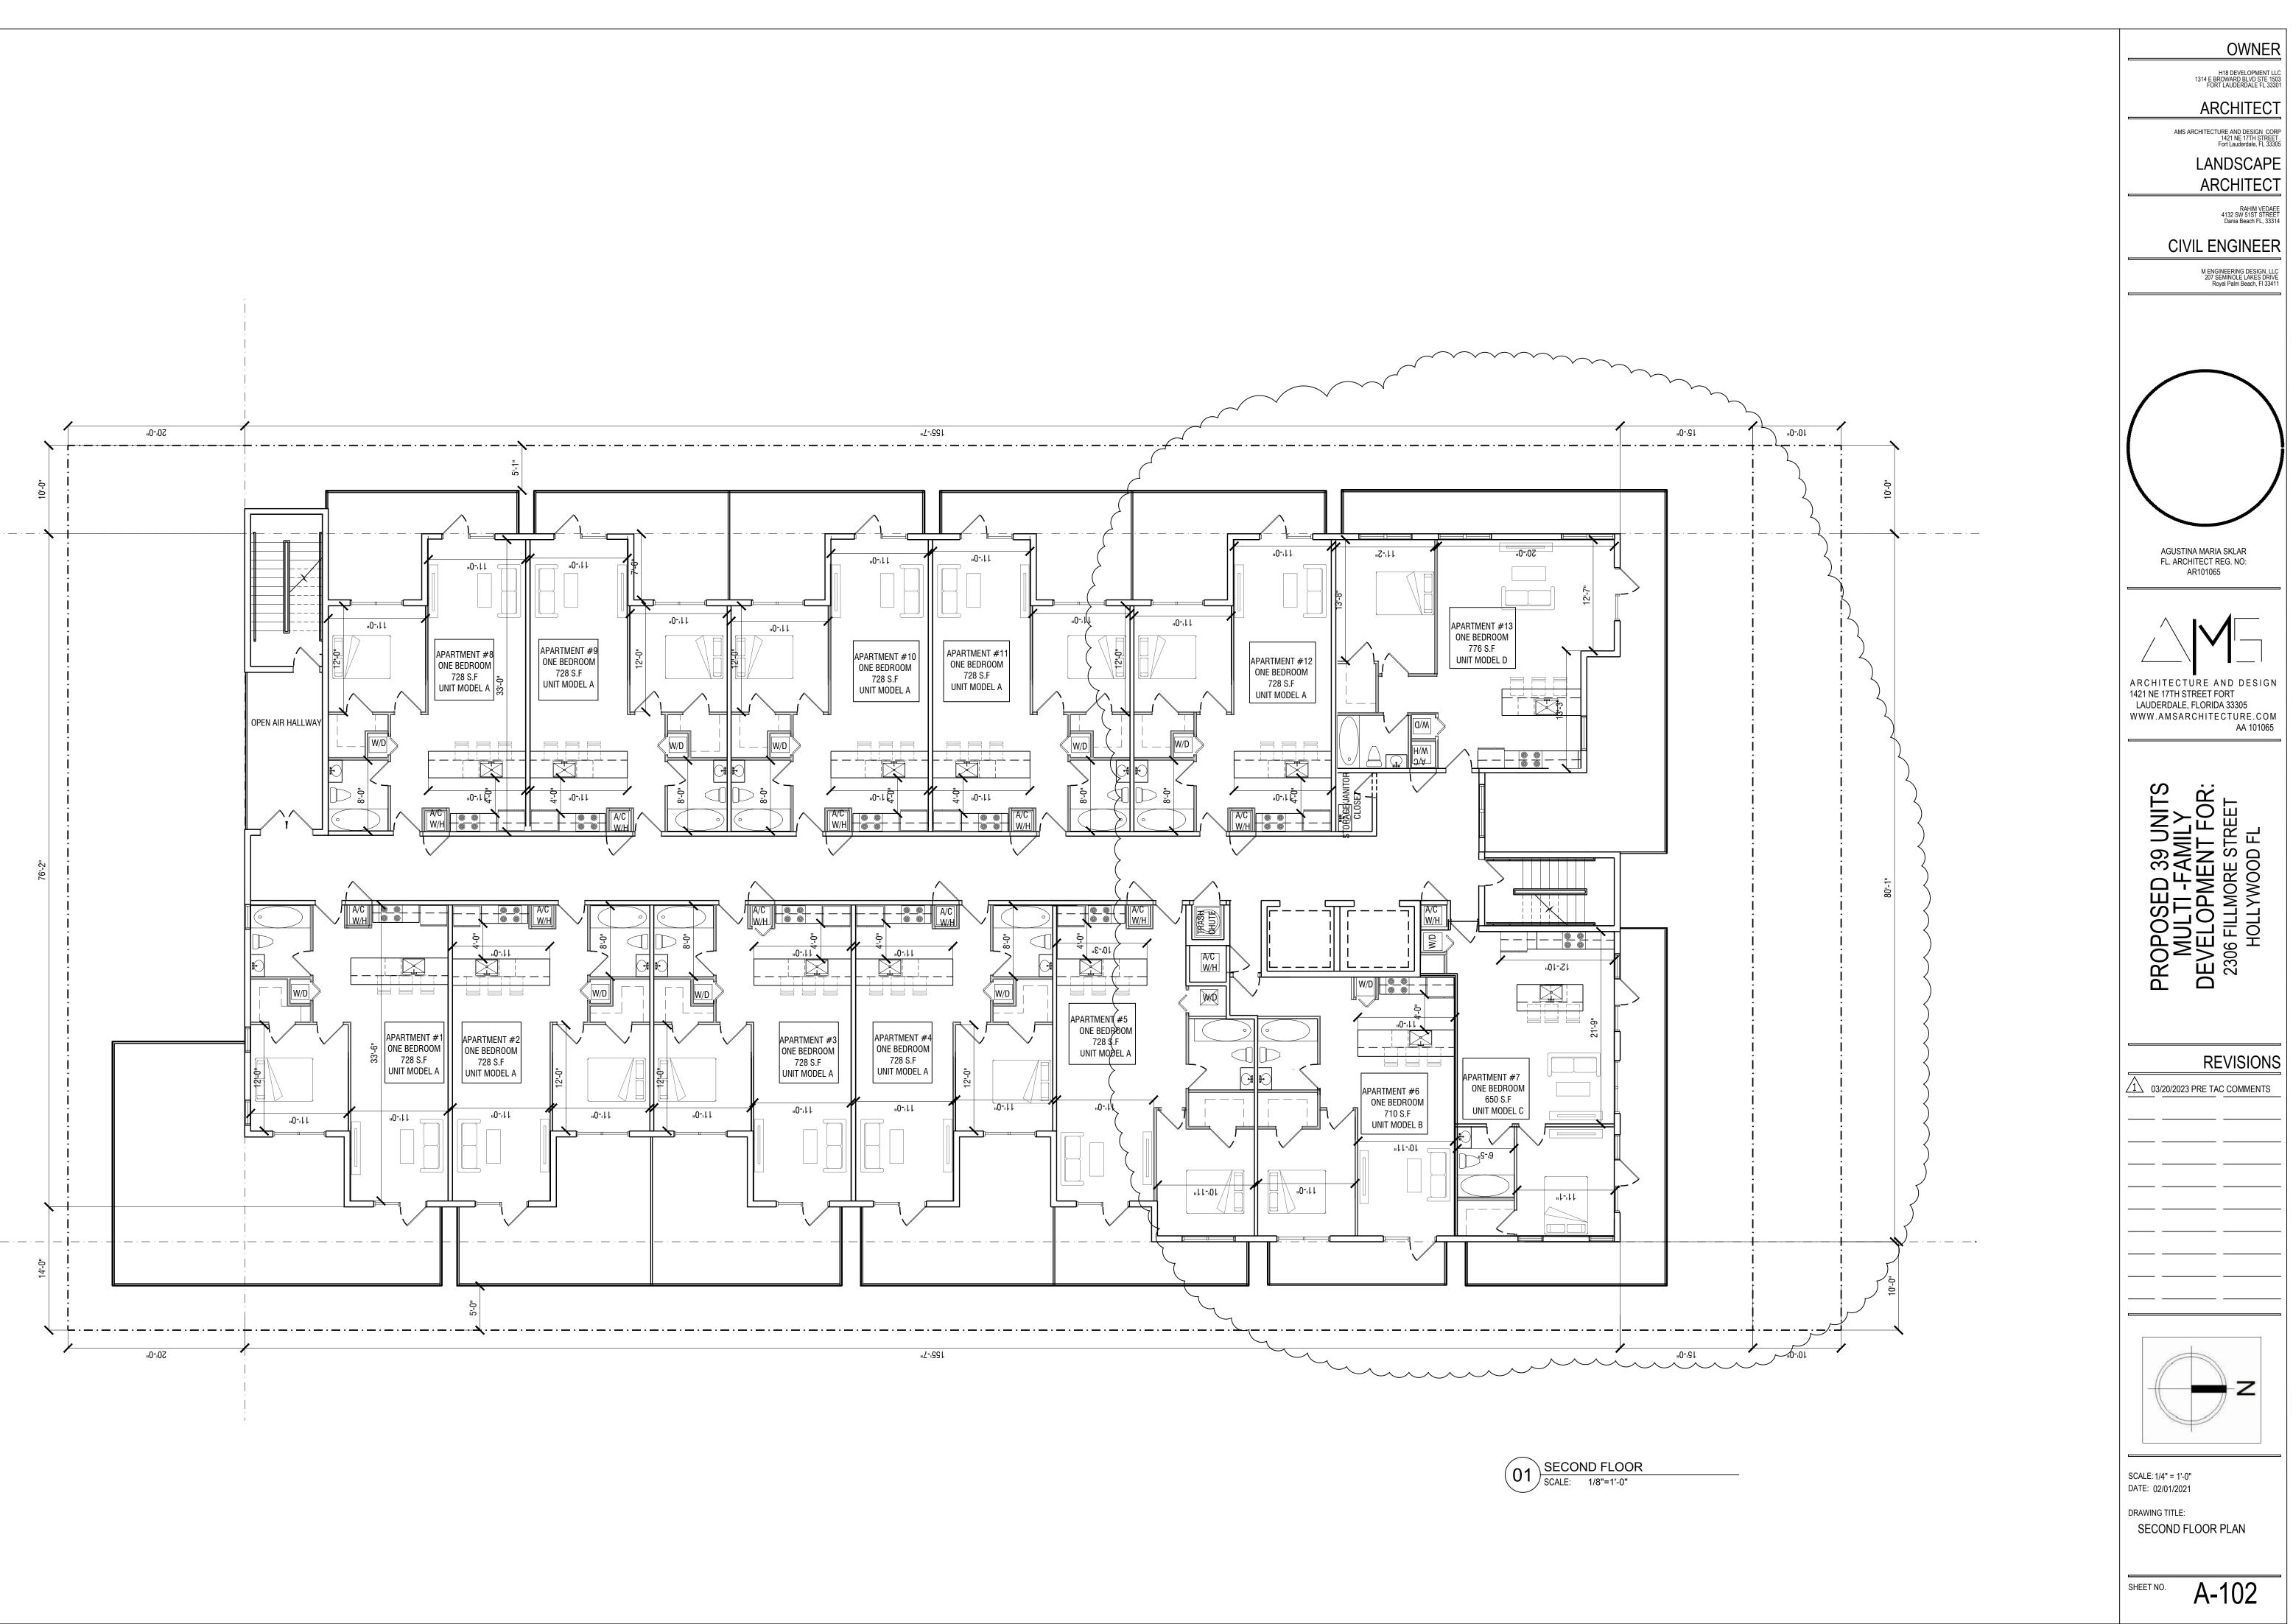


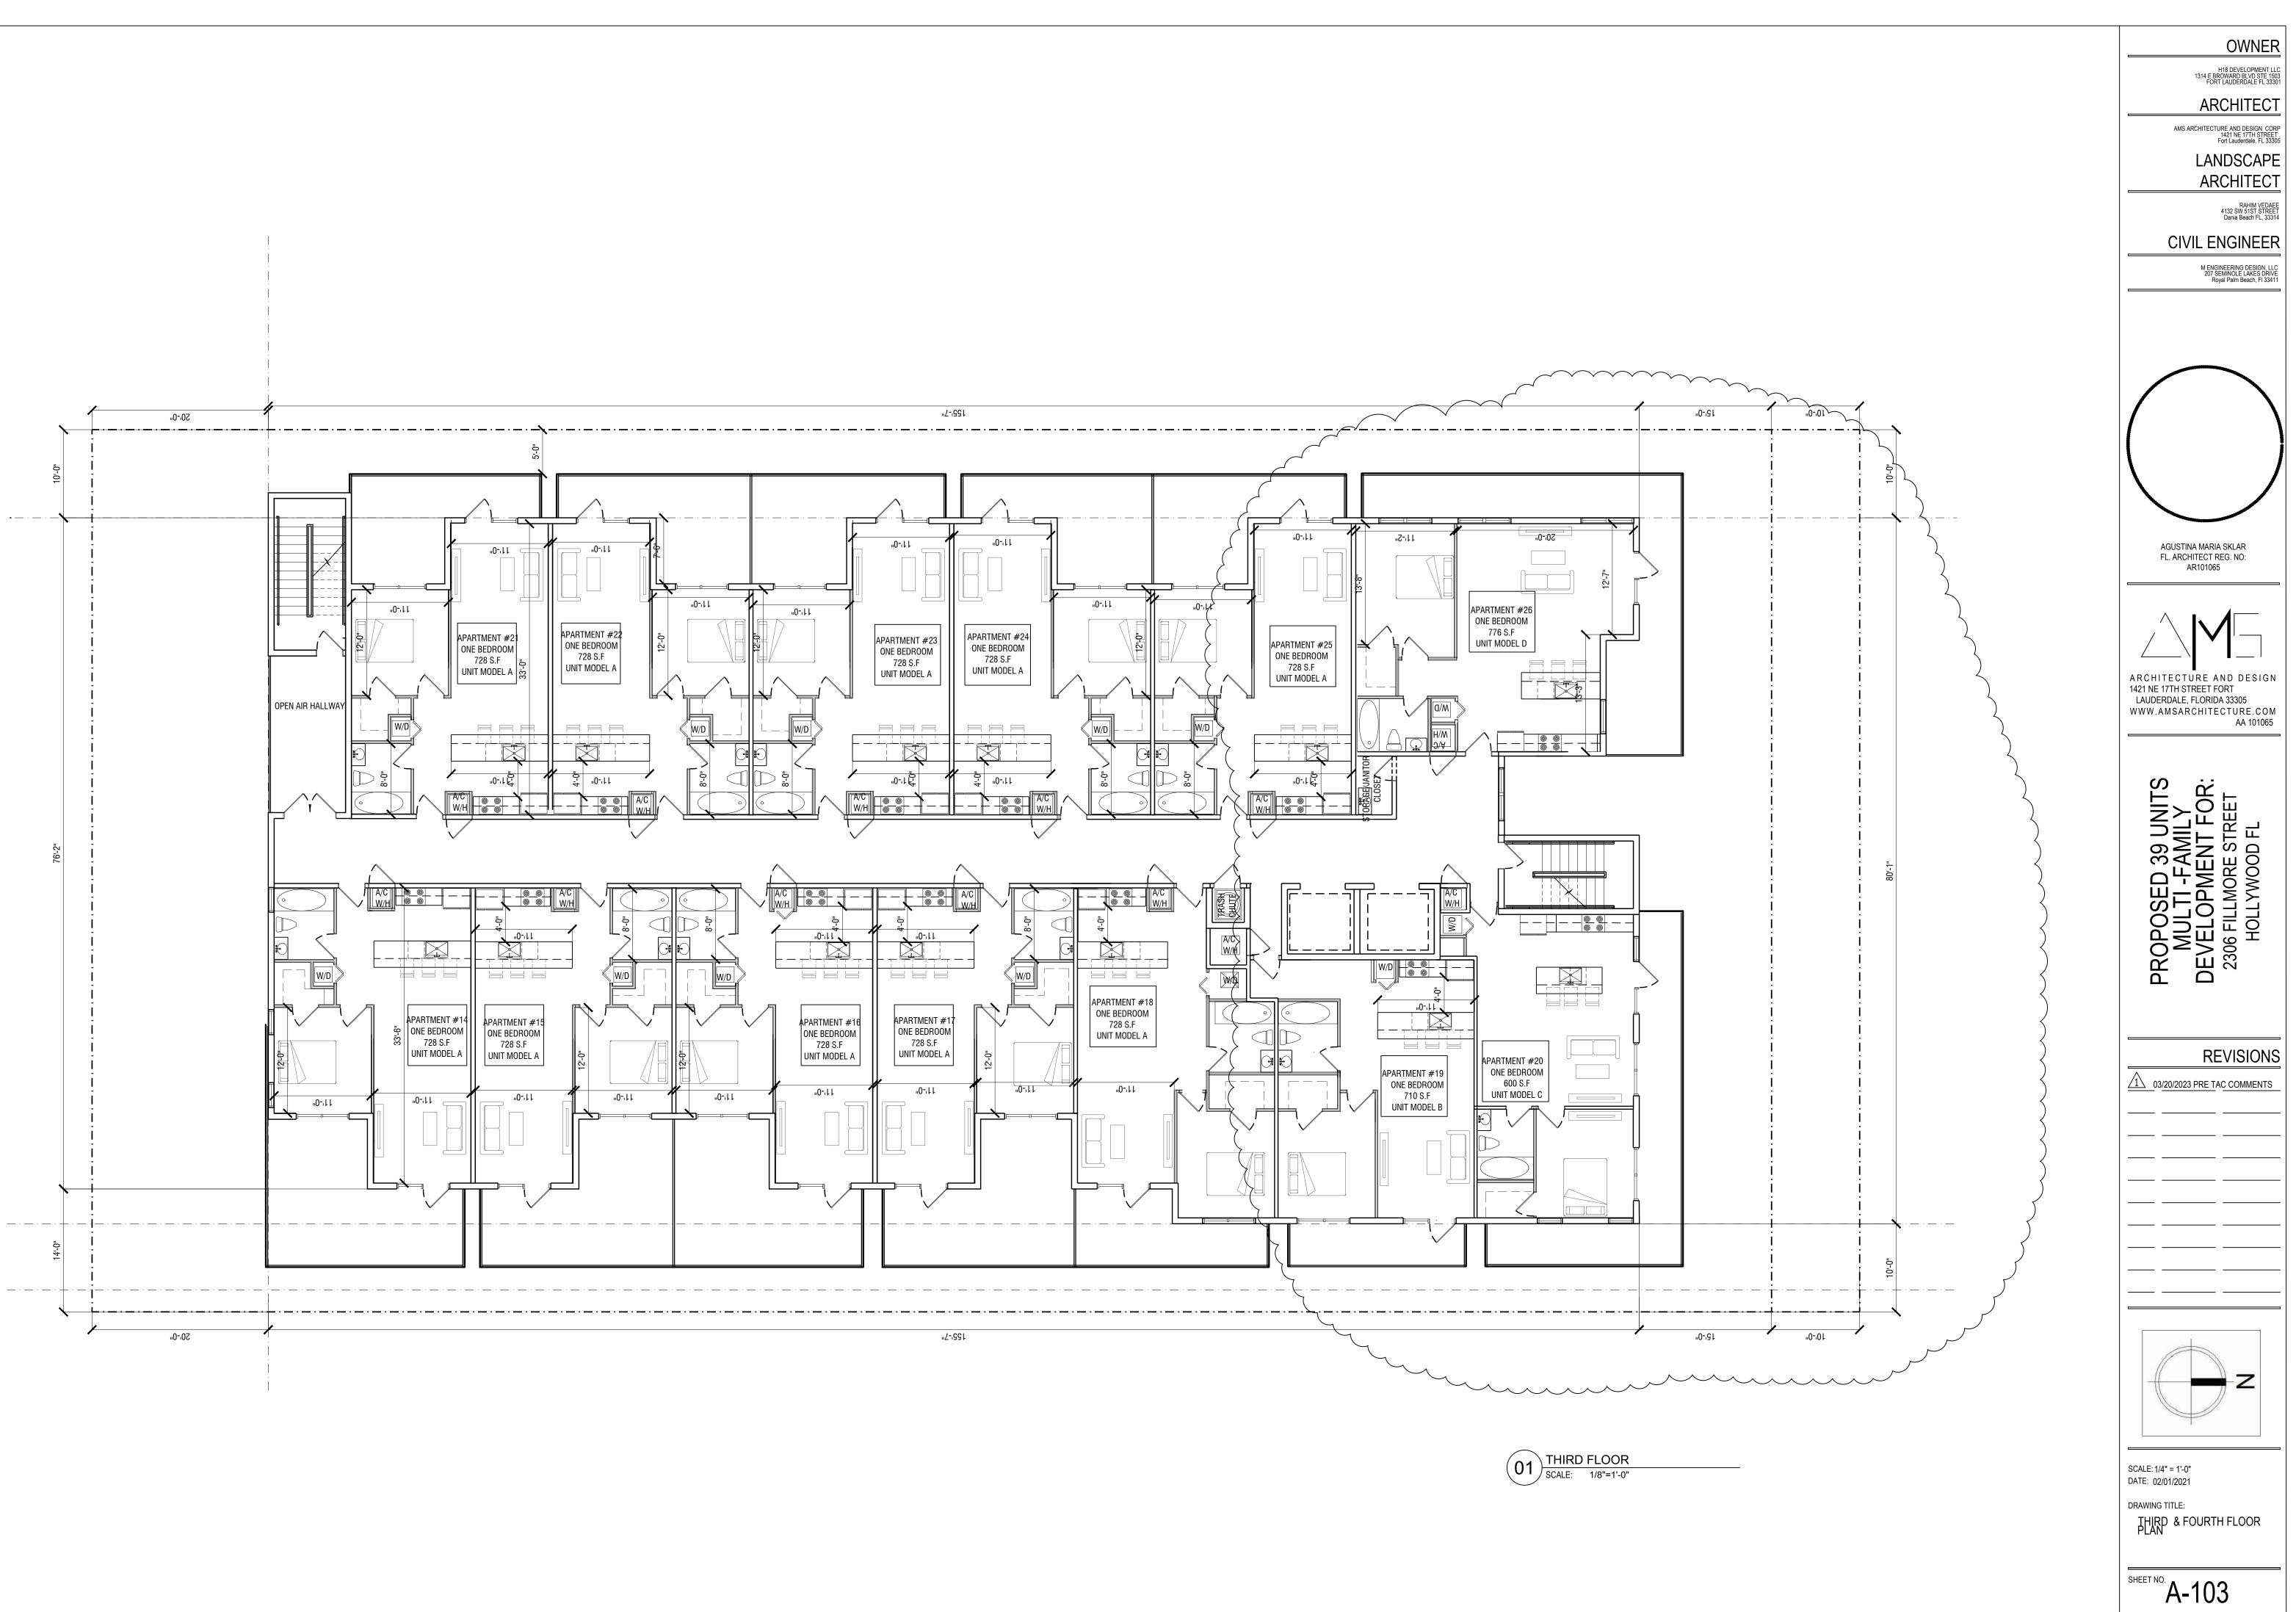

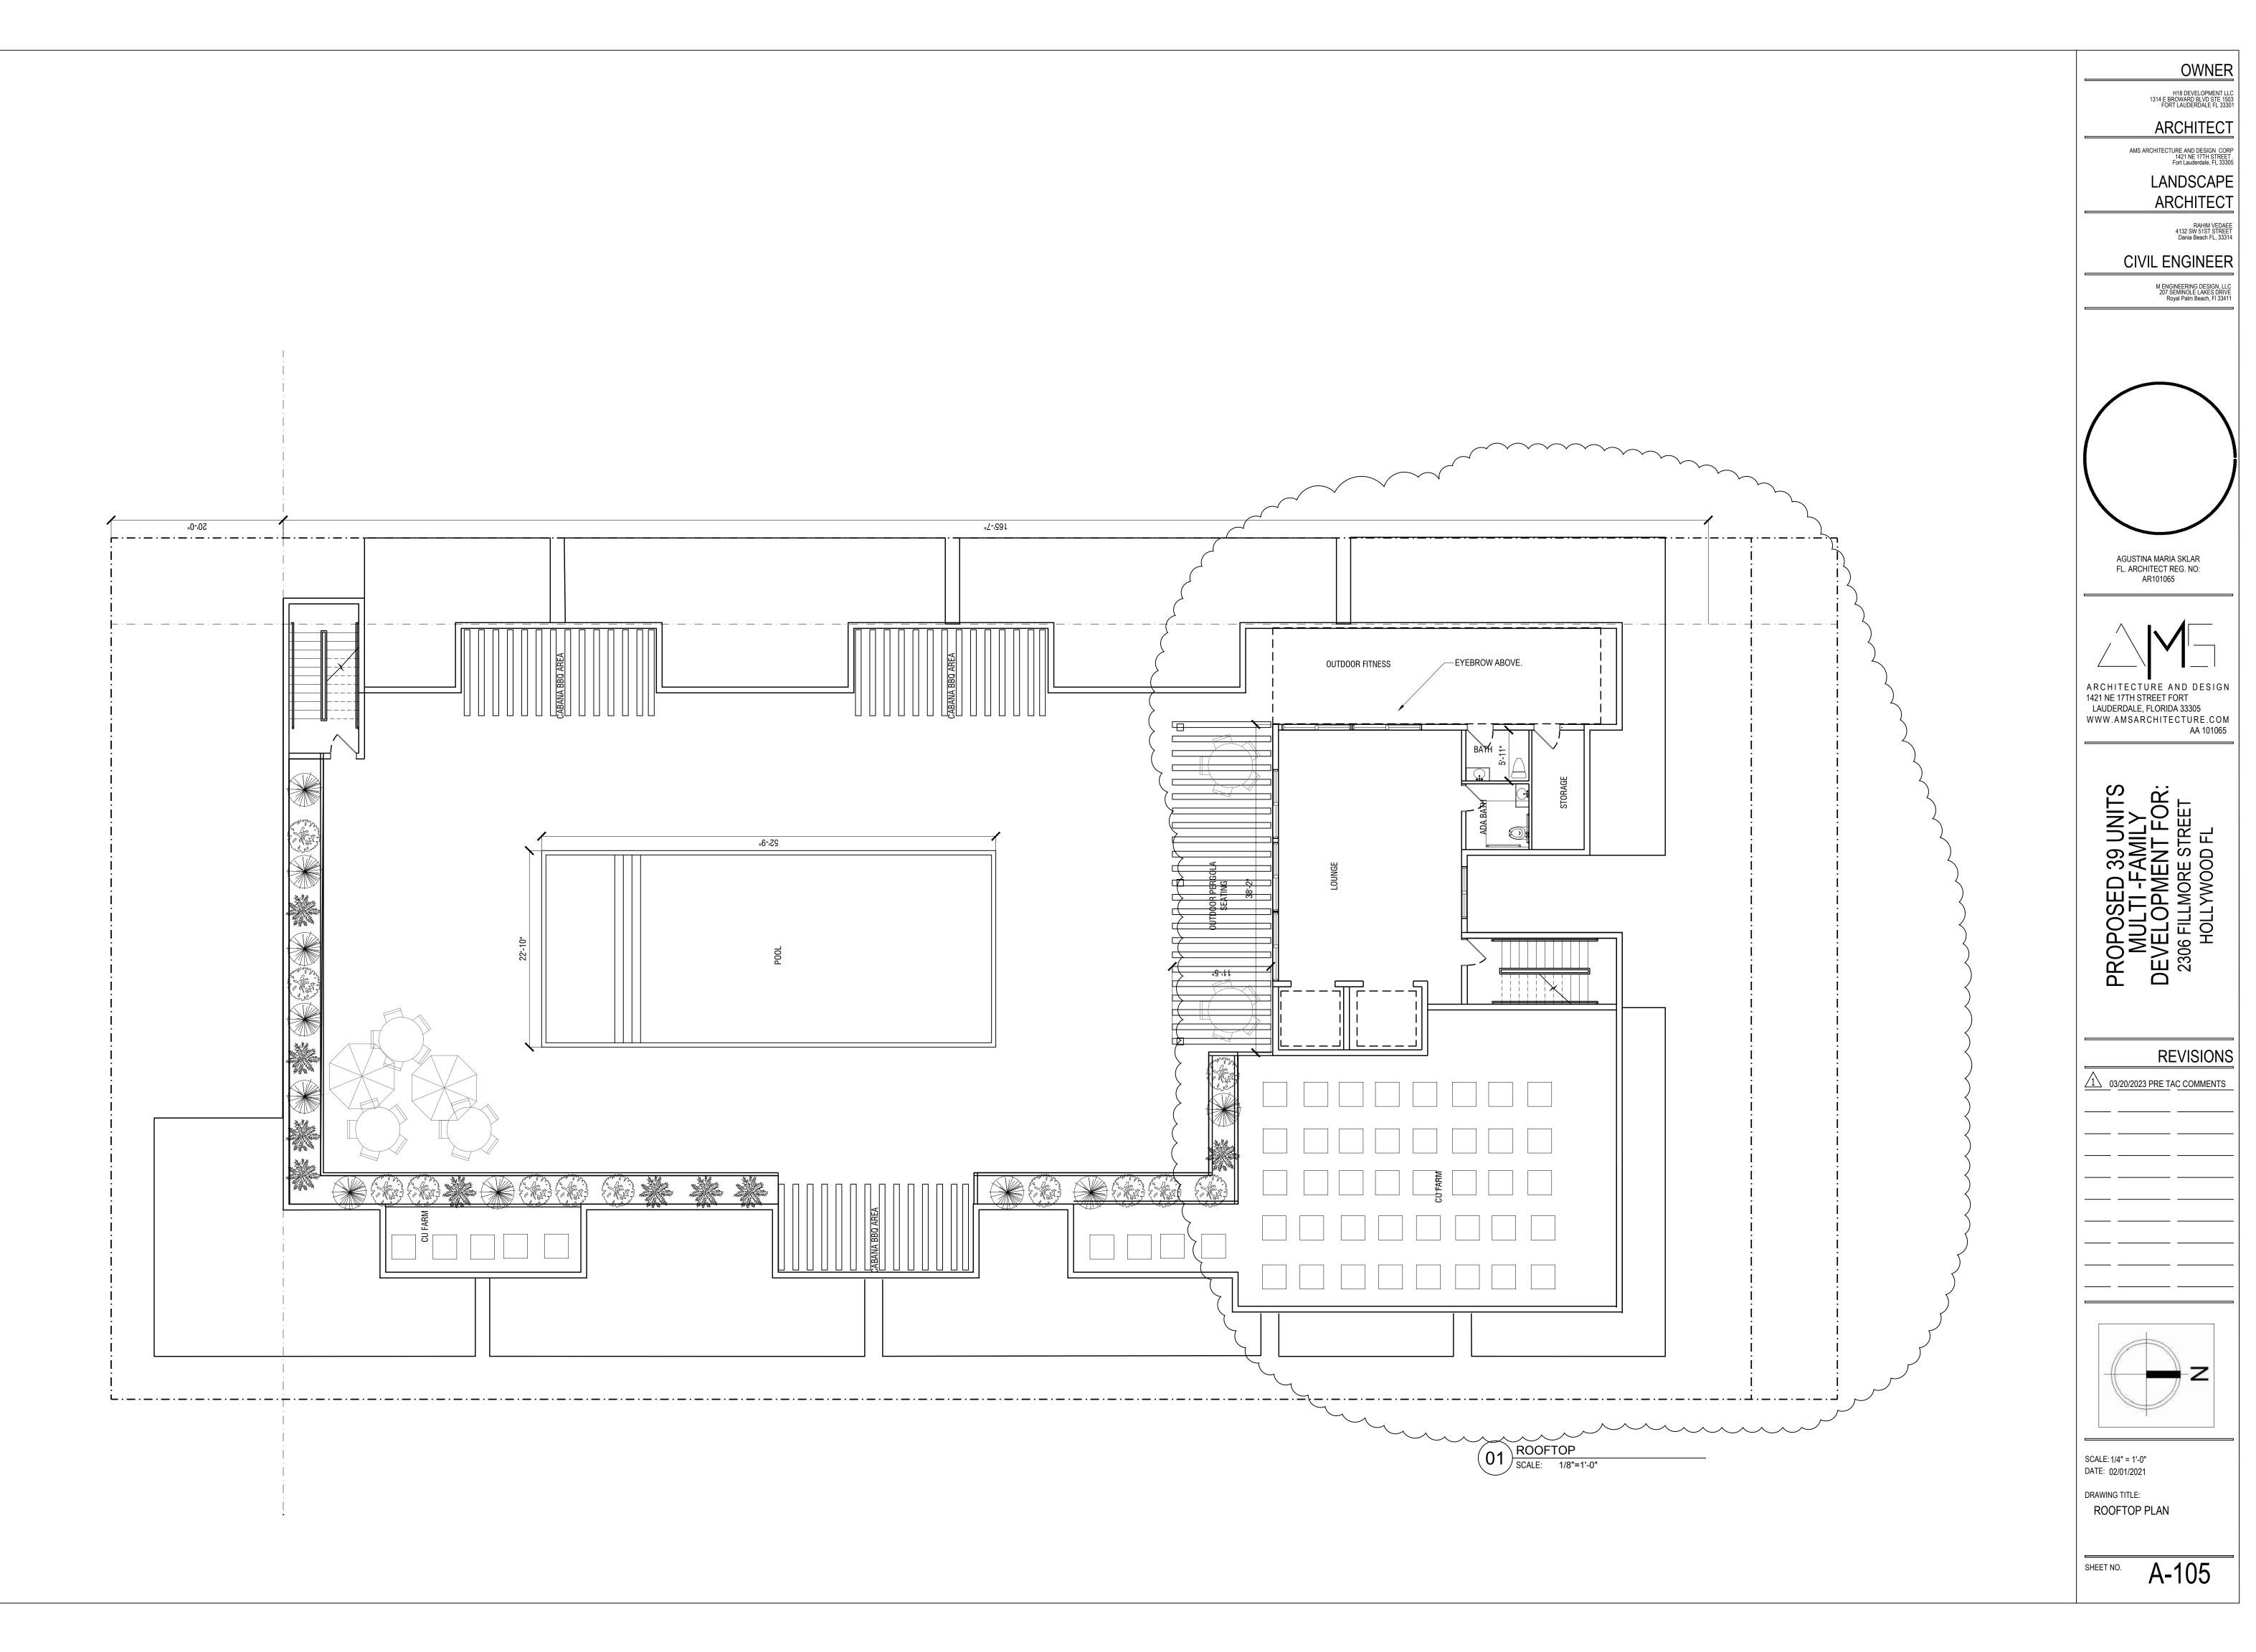





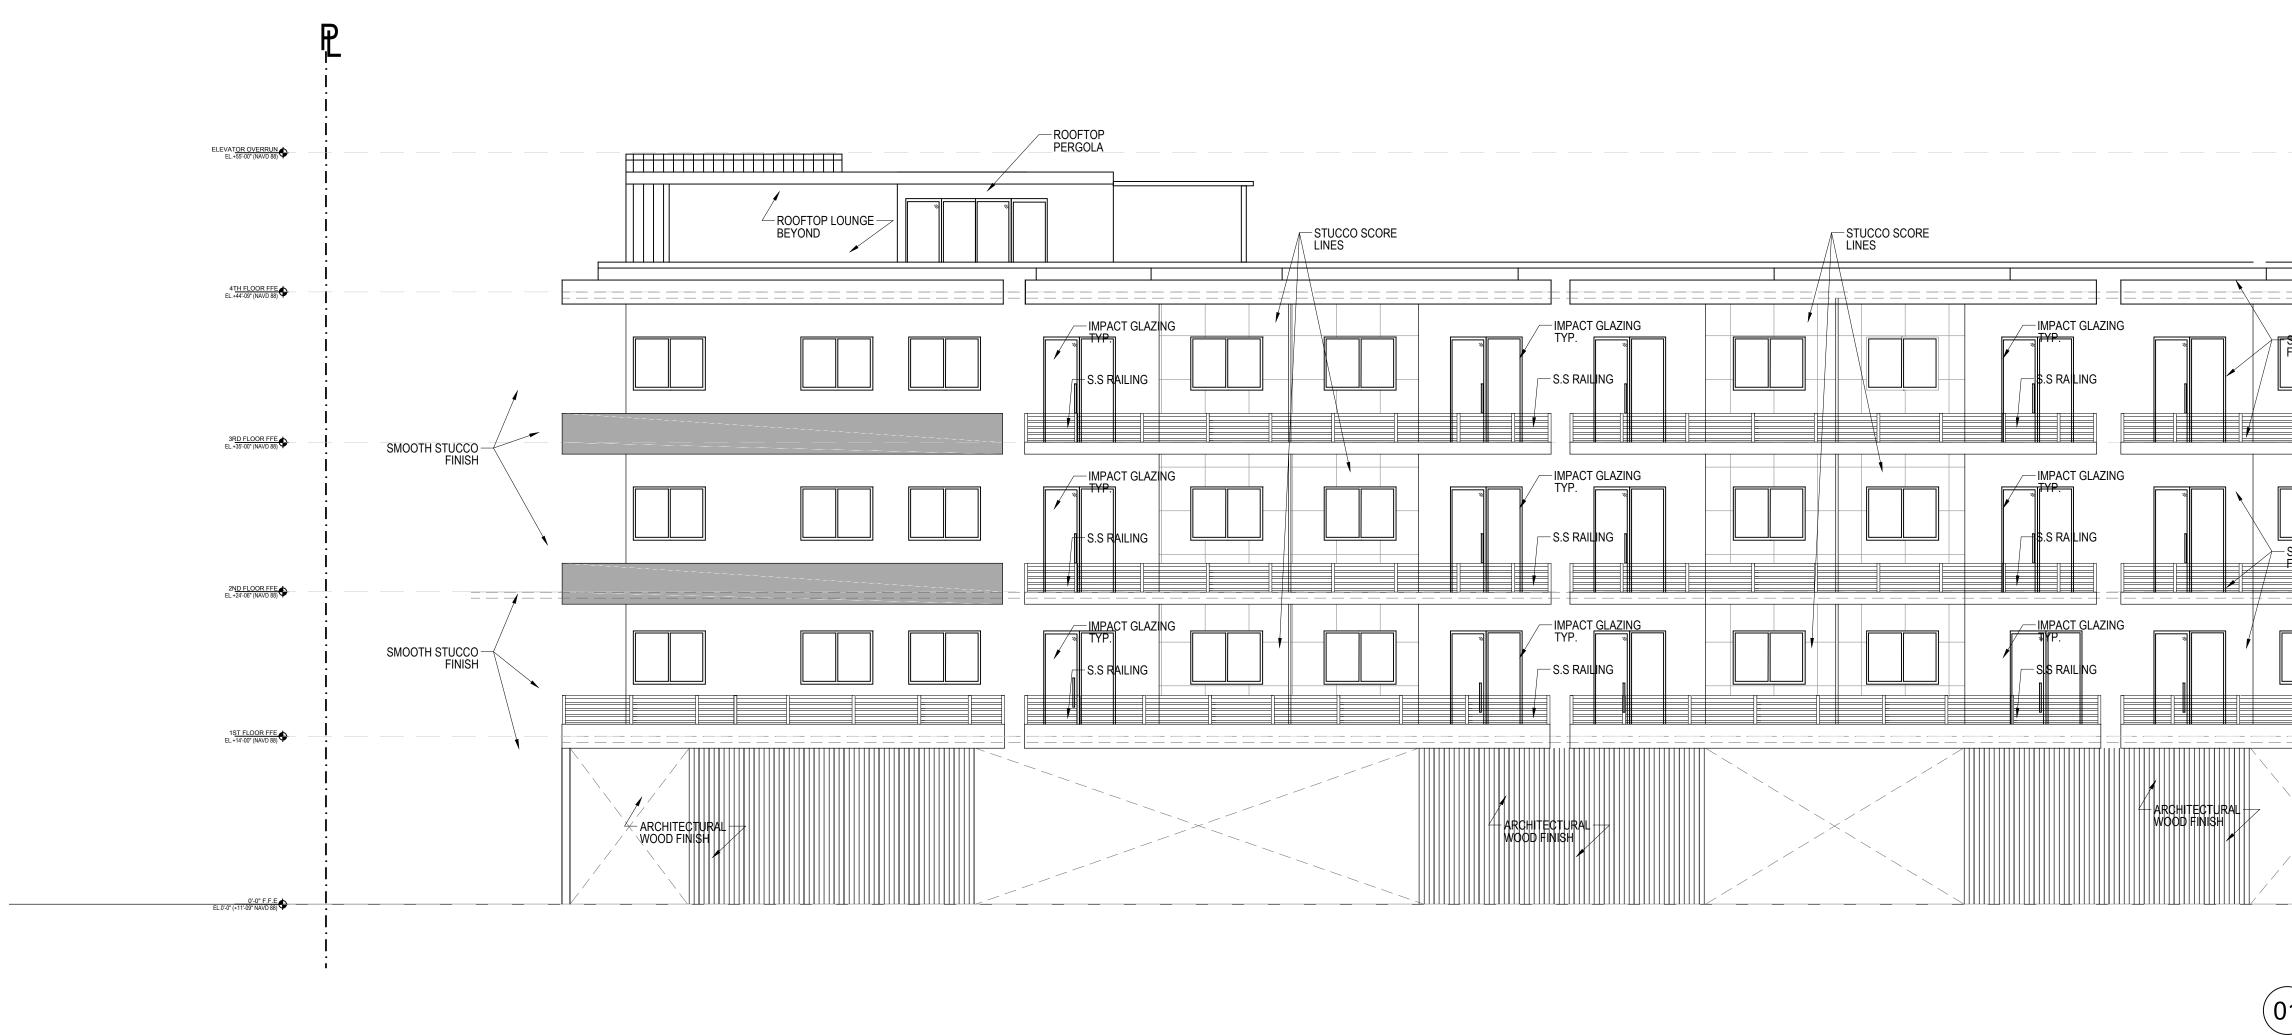


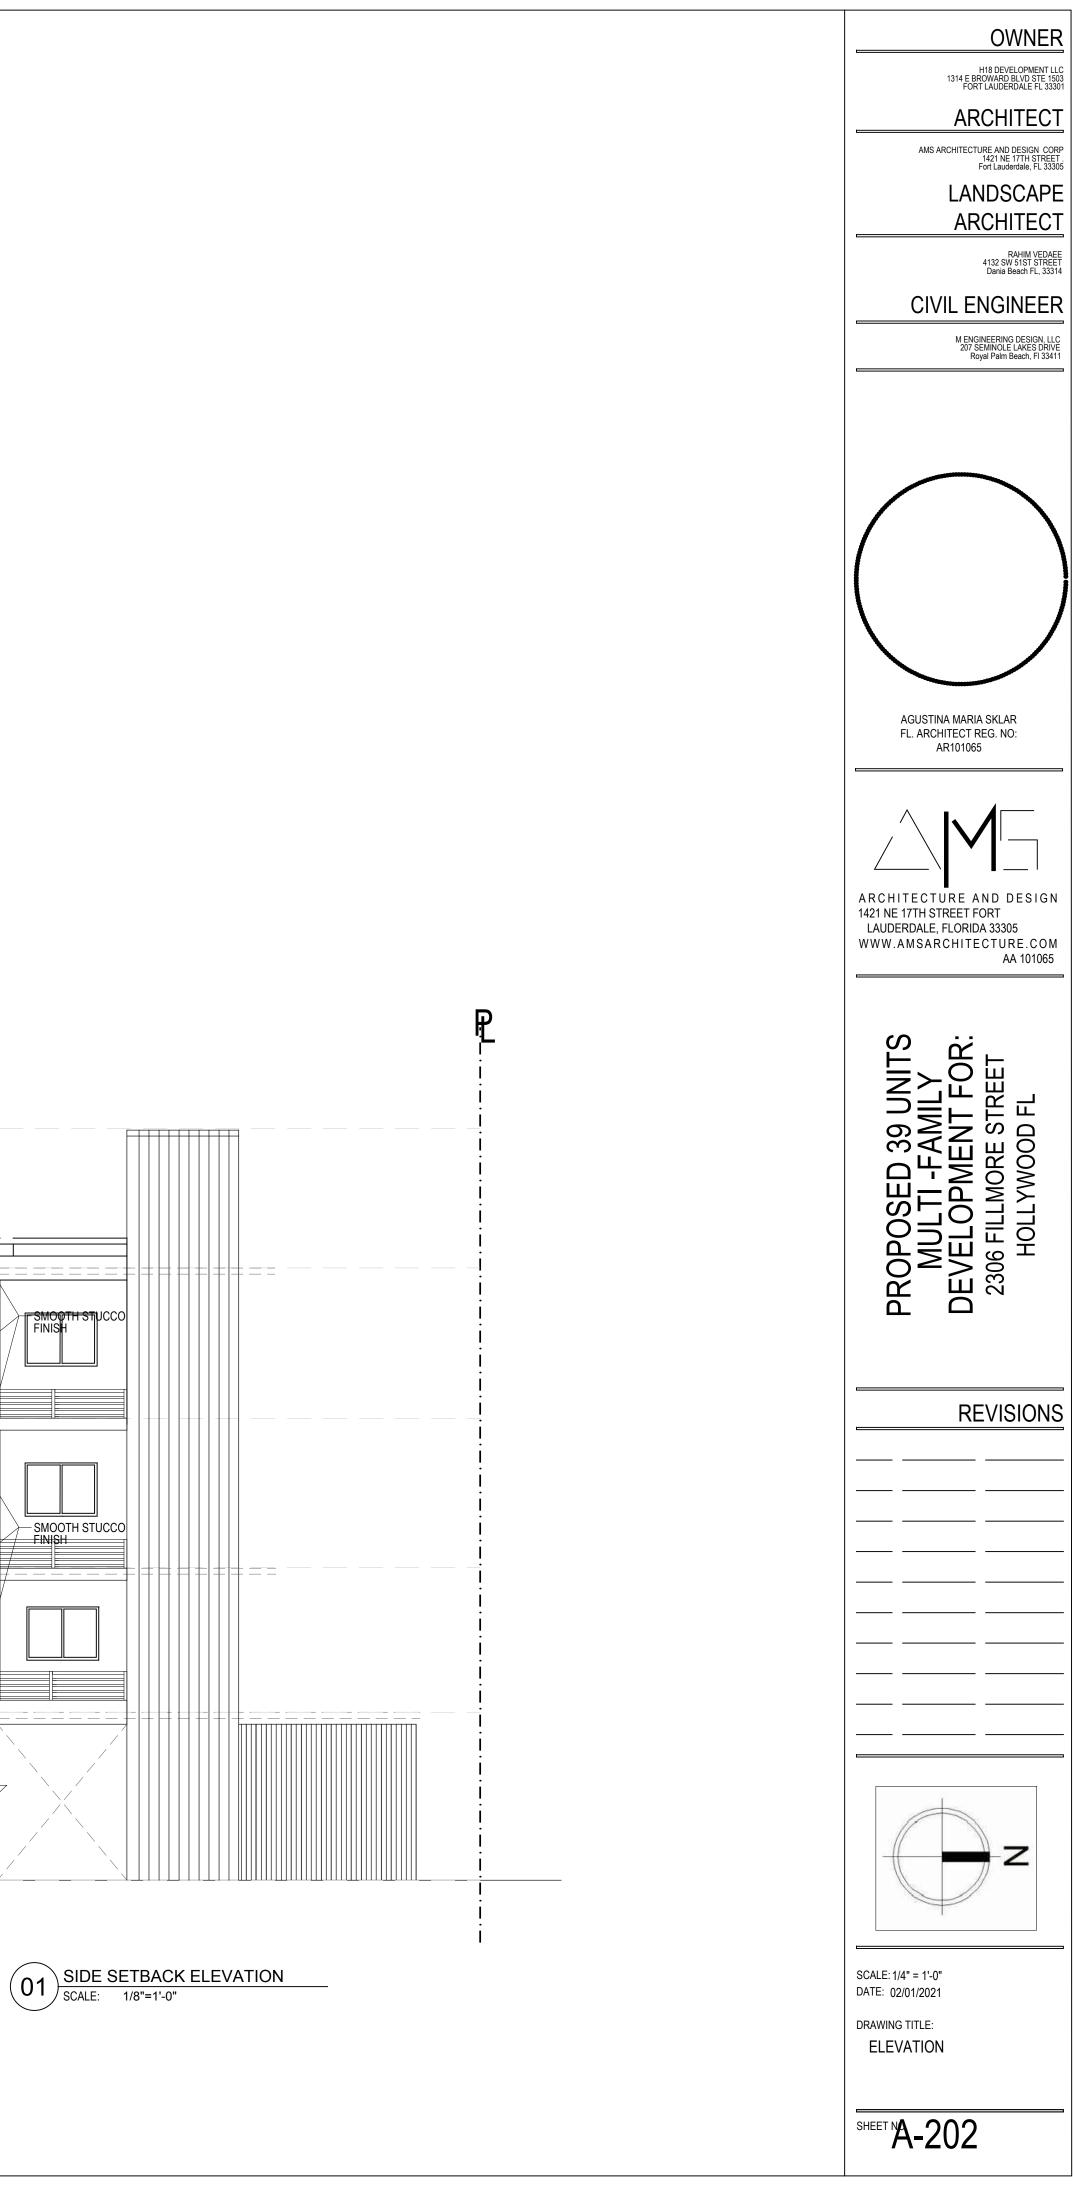




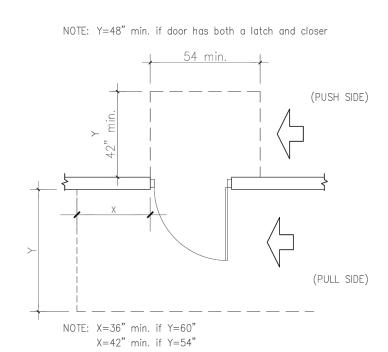


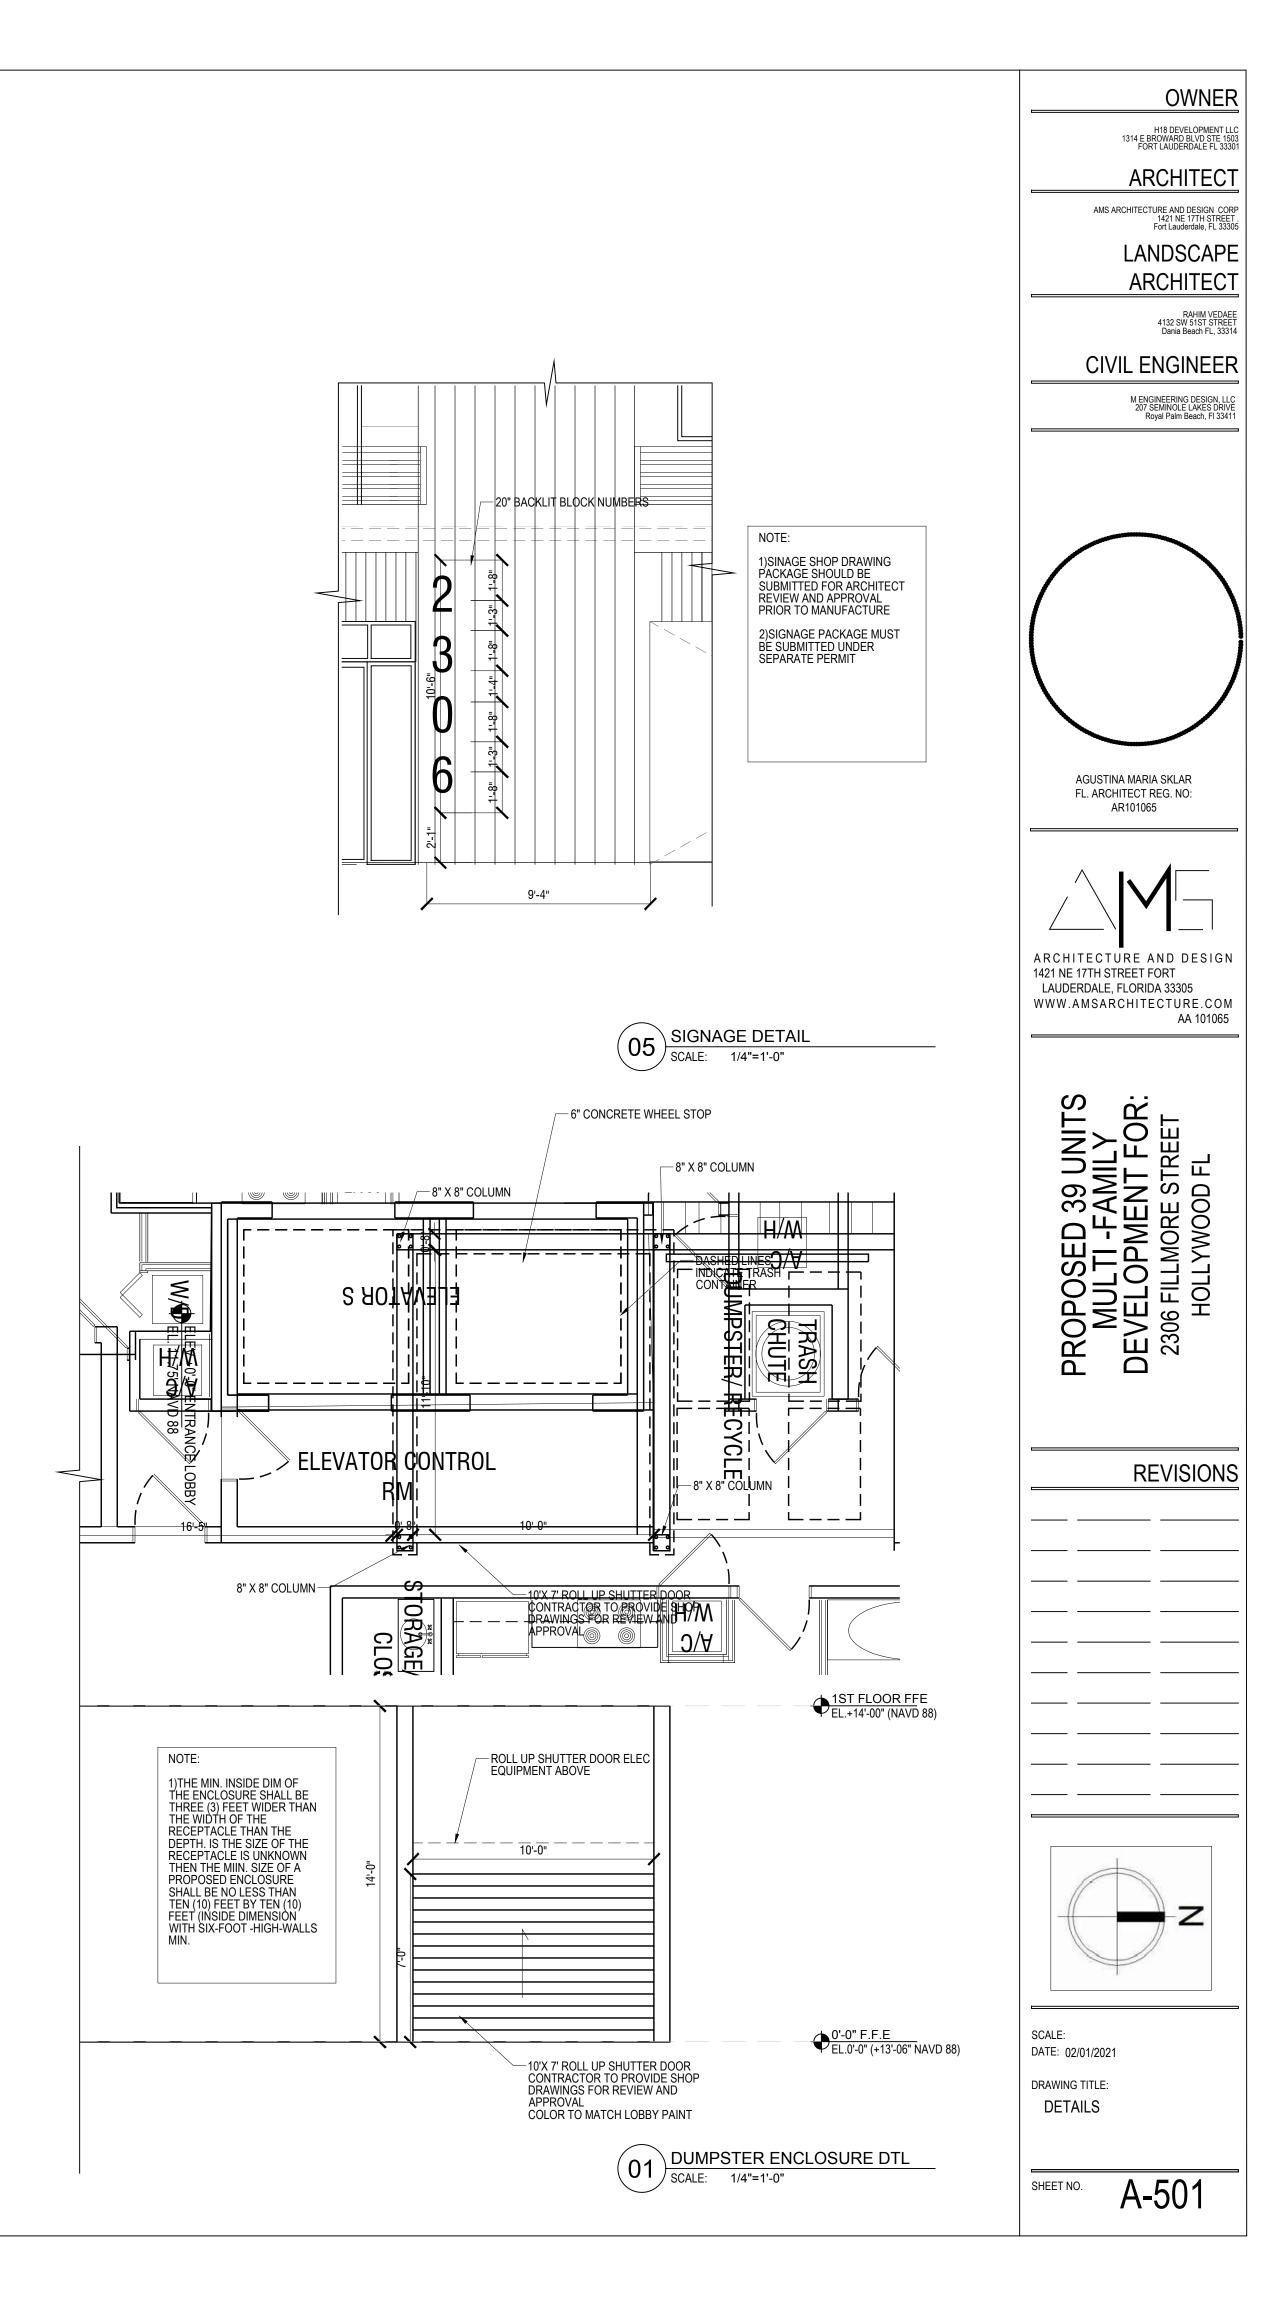

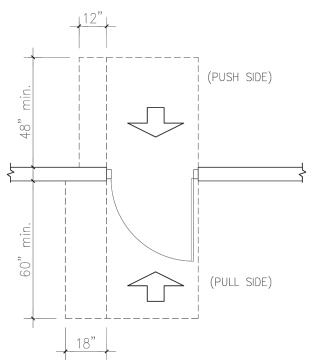


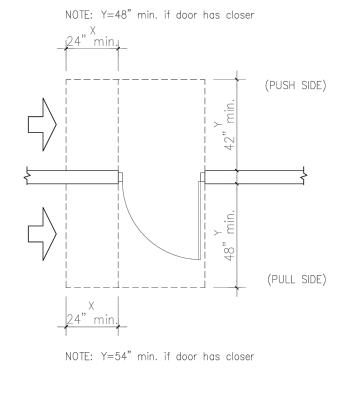




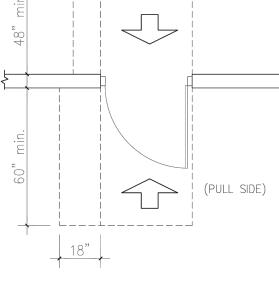

(03) FRONT APPROACH SCALE: N.T.S

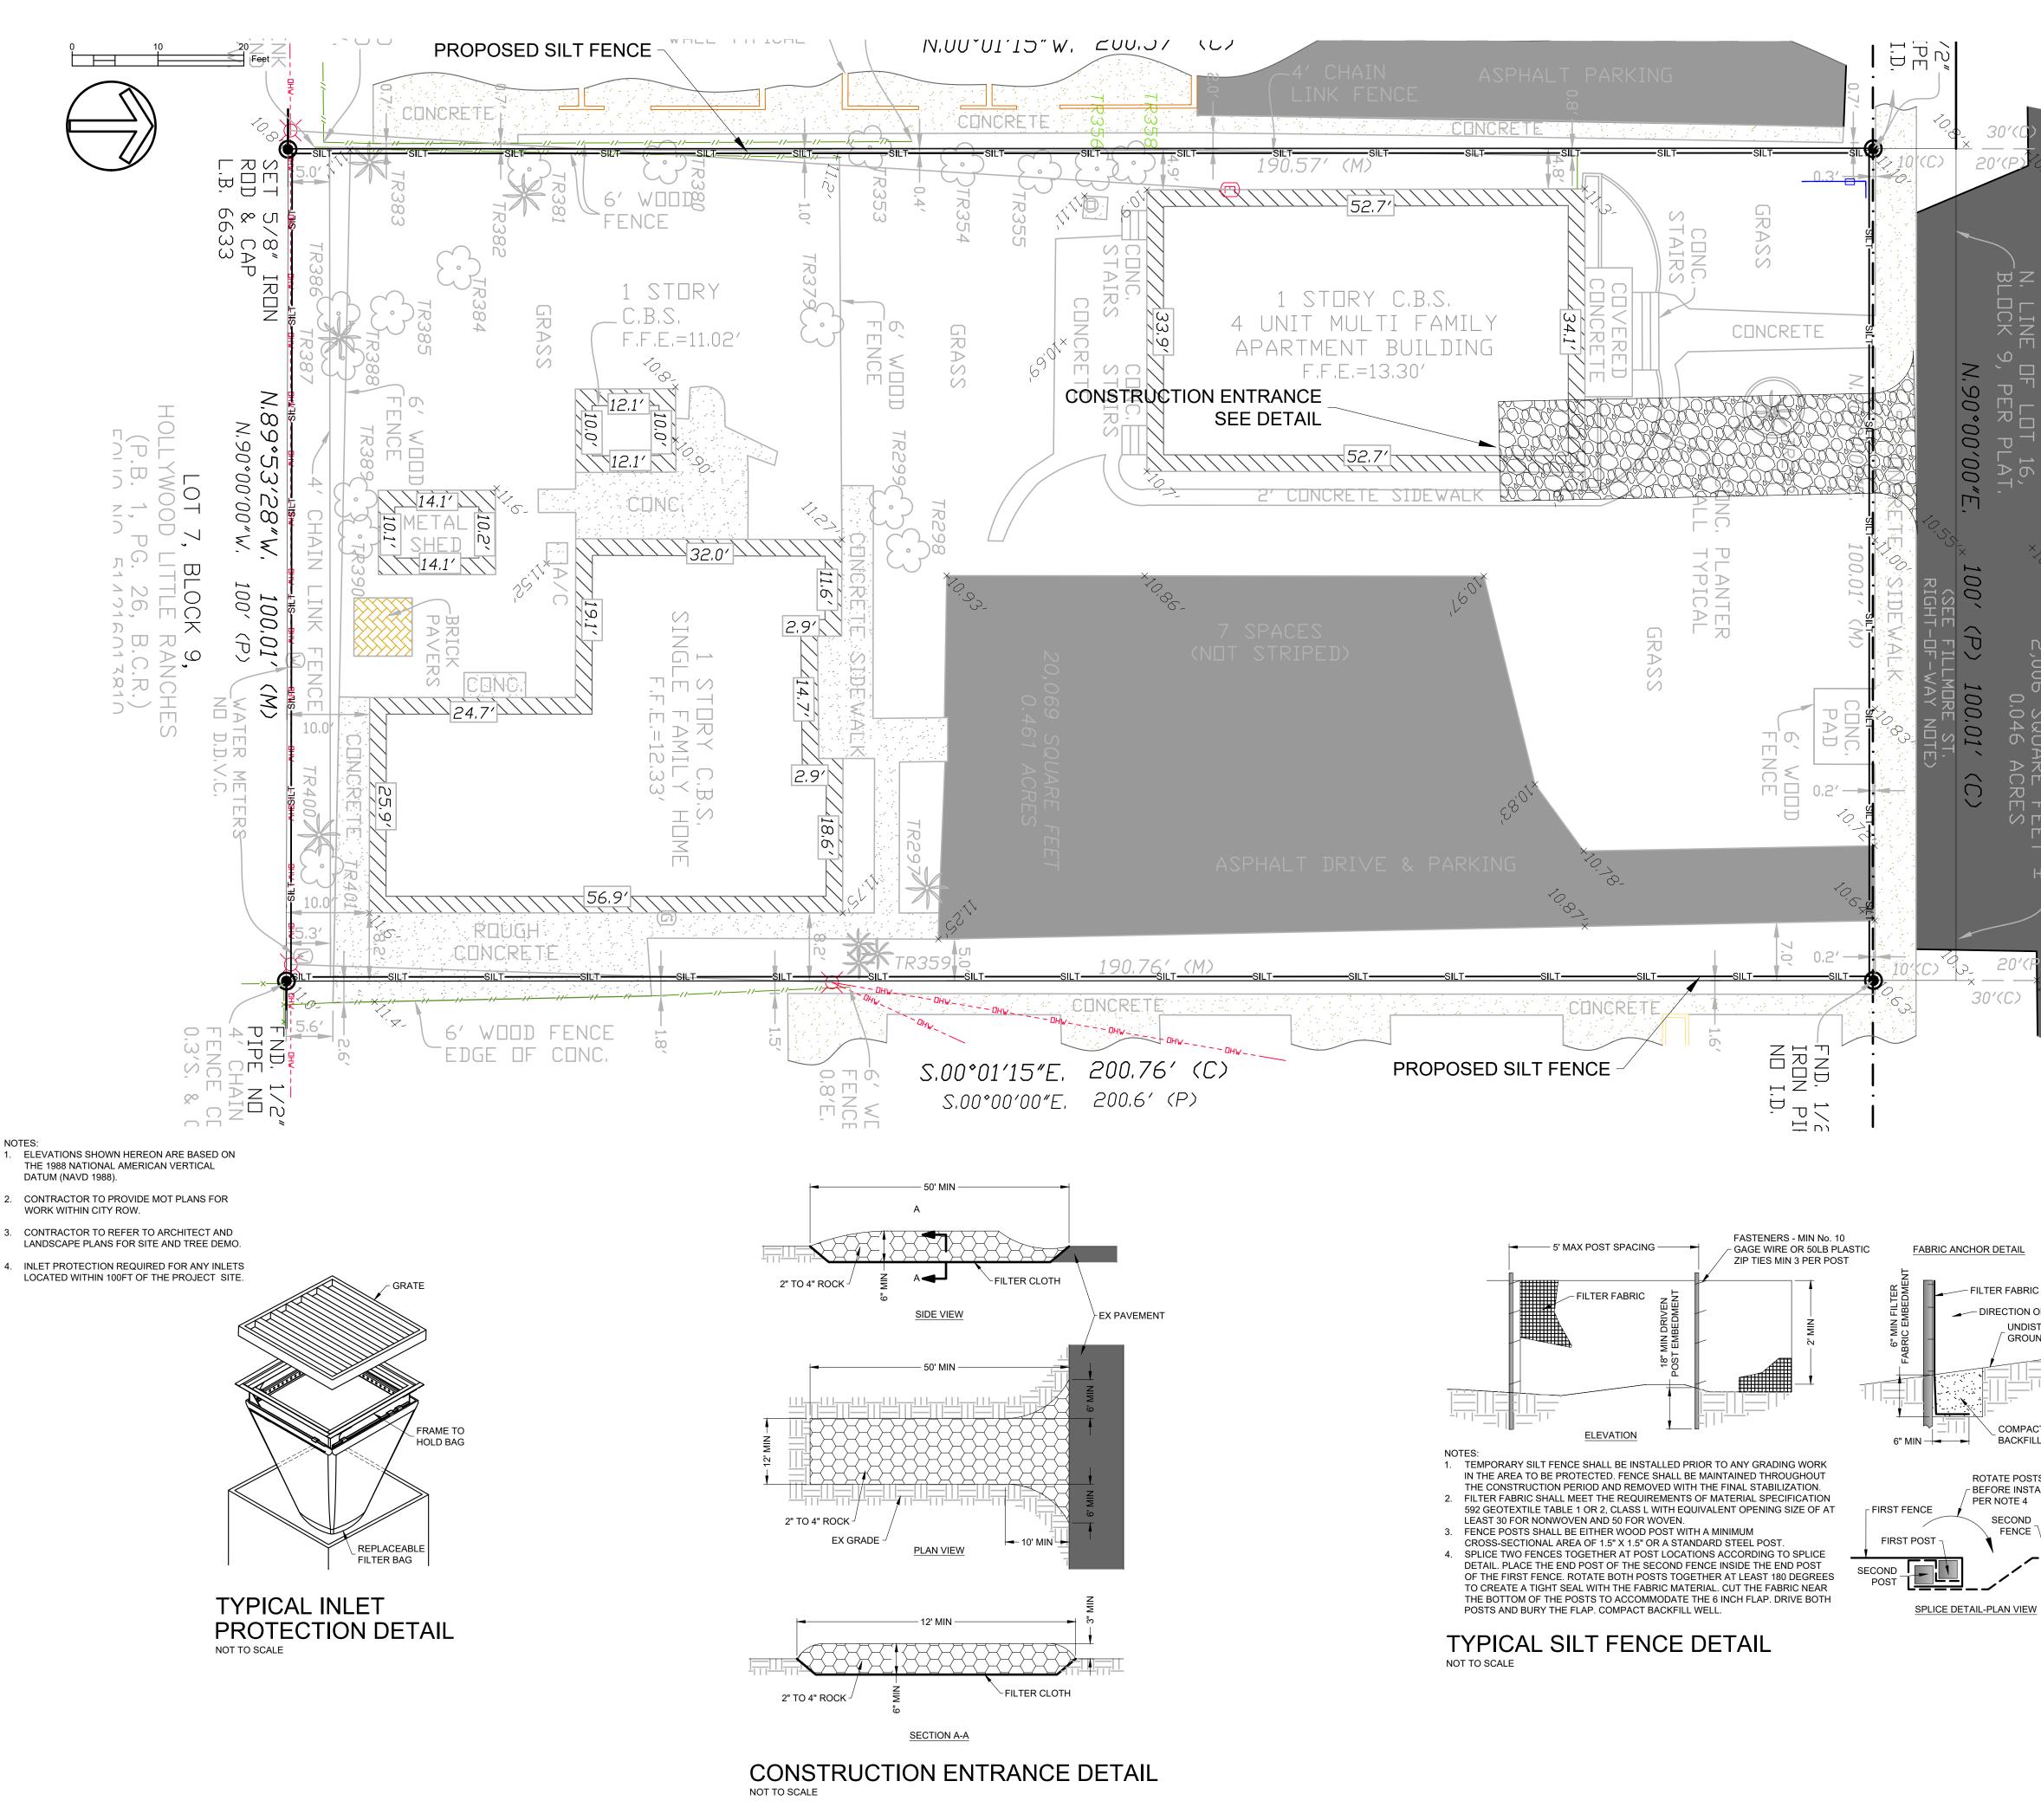

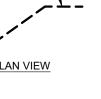

ROTATE POSTS TOGETHER FENCE

- BEFORE INSTALLATION PER NOTE 4 SECOND

BACKFILL

COMPACTED

DIRECTION OF FLOW UNDISTURBED GROUND LINE

- FILTER FABRIC

30' -0<u>5</u>-20'(F С О MORE STREE , S_ **∕___** ACRES 30′(C) 6



SIGN M ENGINEERING DE This documents has been digitally signed and sealed by Marckley Etienne, PE on 01-23-23. Printed copies of this documents are not considered signed and sealed and electronic copies should be writed 1 JCENSE" No. 83266 STATE OF ENGINEER OF RECORD : MARCKLEY E. ETIENNE FL PE # 83266 2023-04-19 ARCHITECTURE AND DESIGN 1421 NE 17TH STREET FORT LAUDERDALE, FLORIDA 33305 WWW.AMSARCHITECTURE.COM AA 101065 PROPOSED 40 UNITS MULTI -FAMILY DEVELOPMENT FOR: 2306 FILLMORE STREET HOLLYWOOD FL S REVISIONS _____ SCALE: 1" = 10'

DATE: 04/18/23

DRAWING TITLE:

DEMOLITION,

SWPPP, & EROSION

CONTROL PLAN

SHEET NO. C-050

OWNER

H18 DEVELOPMENT LLC 1314 E BROWARD BLVD STE 1503 FORT LAUDERDALE FL 3330

ARCHITECT

LANDSCAPE


ARCHITECT


M ENGINEERING DESIGN, LLC 207 SEMINOLE LAKES DRIVE Royal Palm Beach, FI 33411

RAHIM VEDAEE 4132 SW 51ST STREET Dania Beach FL, 33314


AMS ARCHITECTURE AND DESIGN_CORP 1421 NE 17TH STREET . Fort Lauderdale, FL 33305


CIVIL ENGINEER

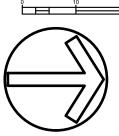


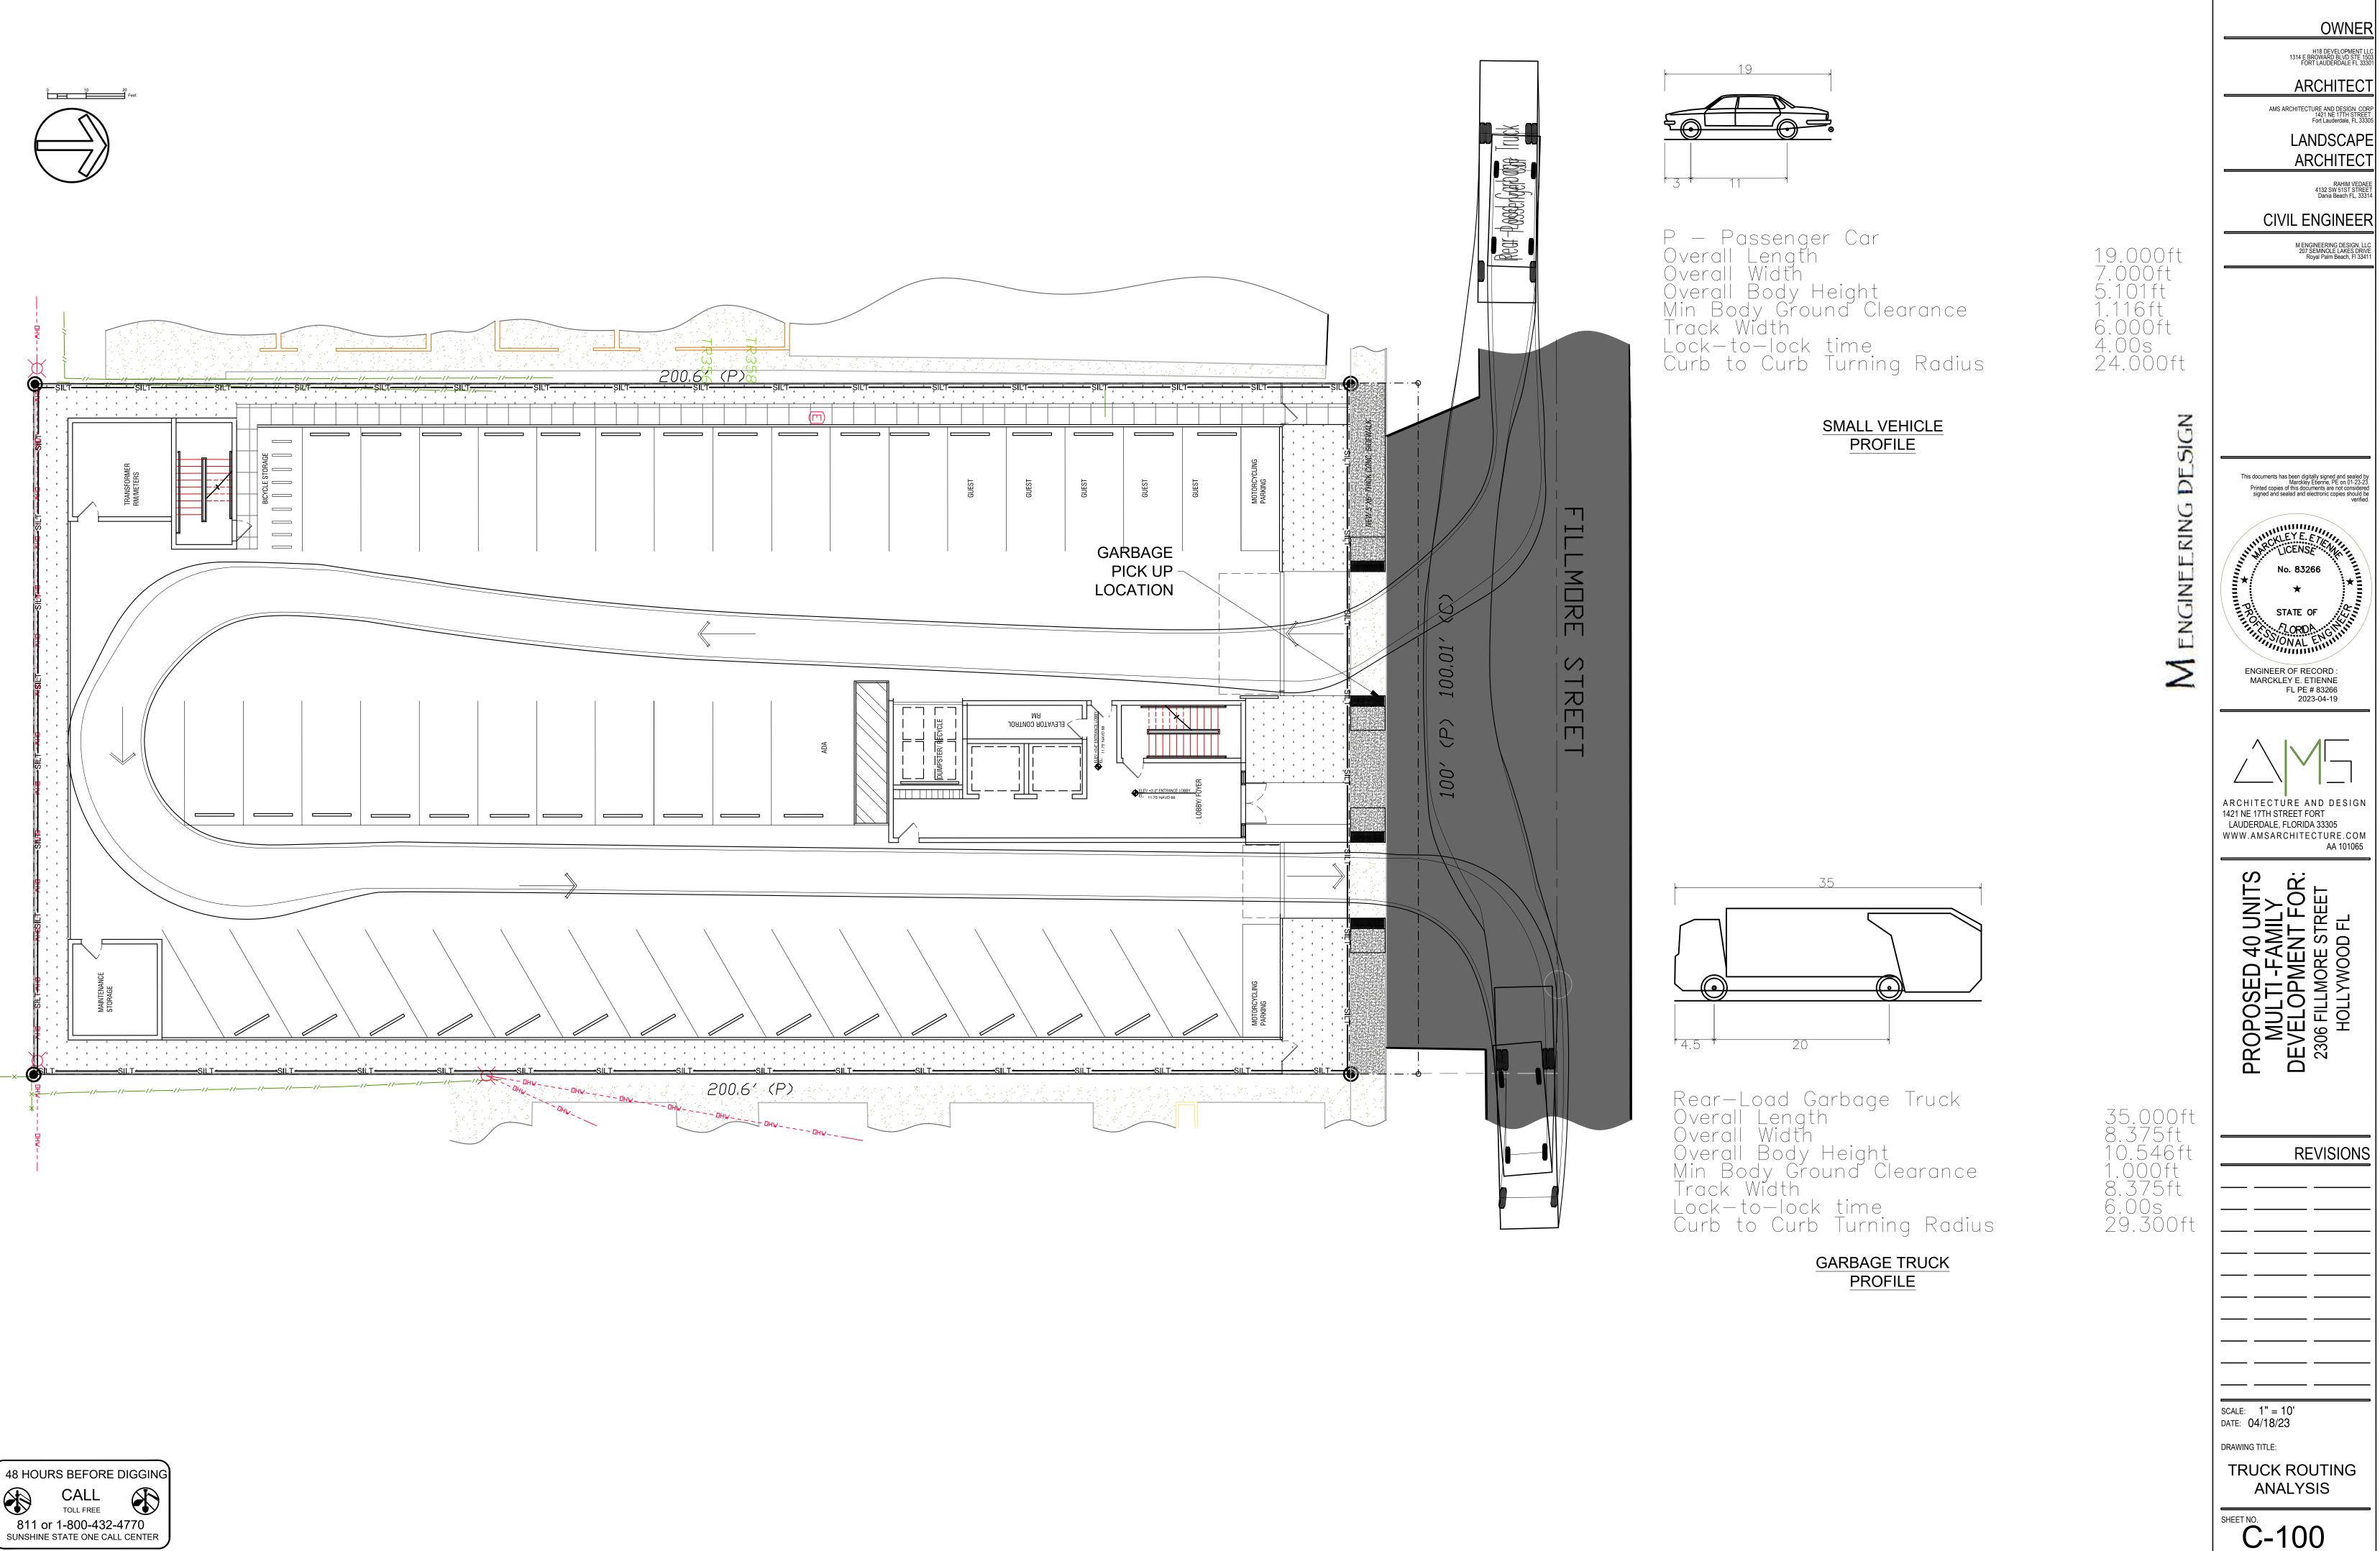


811 or 1-800-432-4770 SUNSHINE STATE ONE CALL CENTER

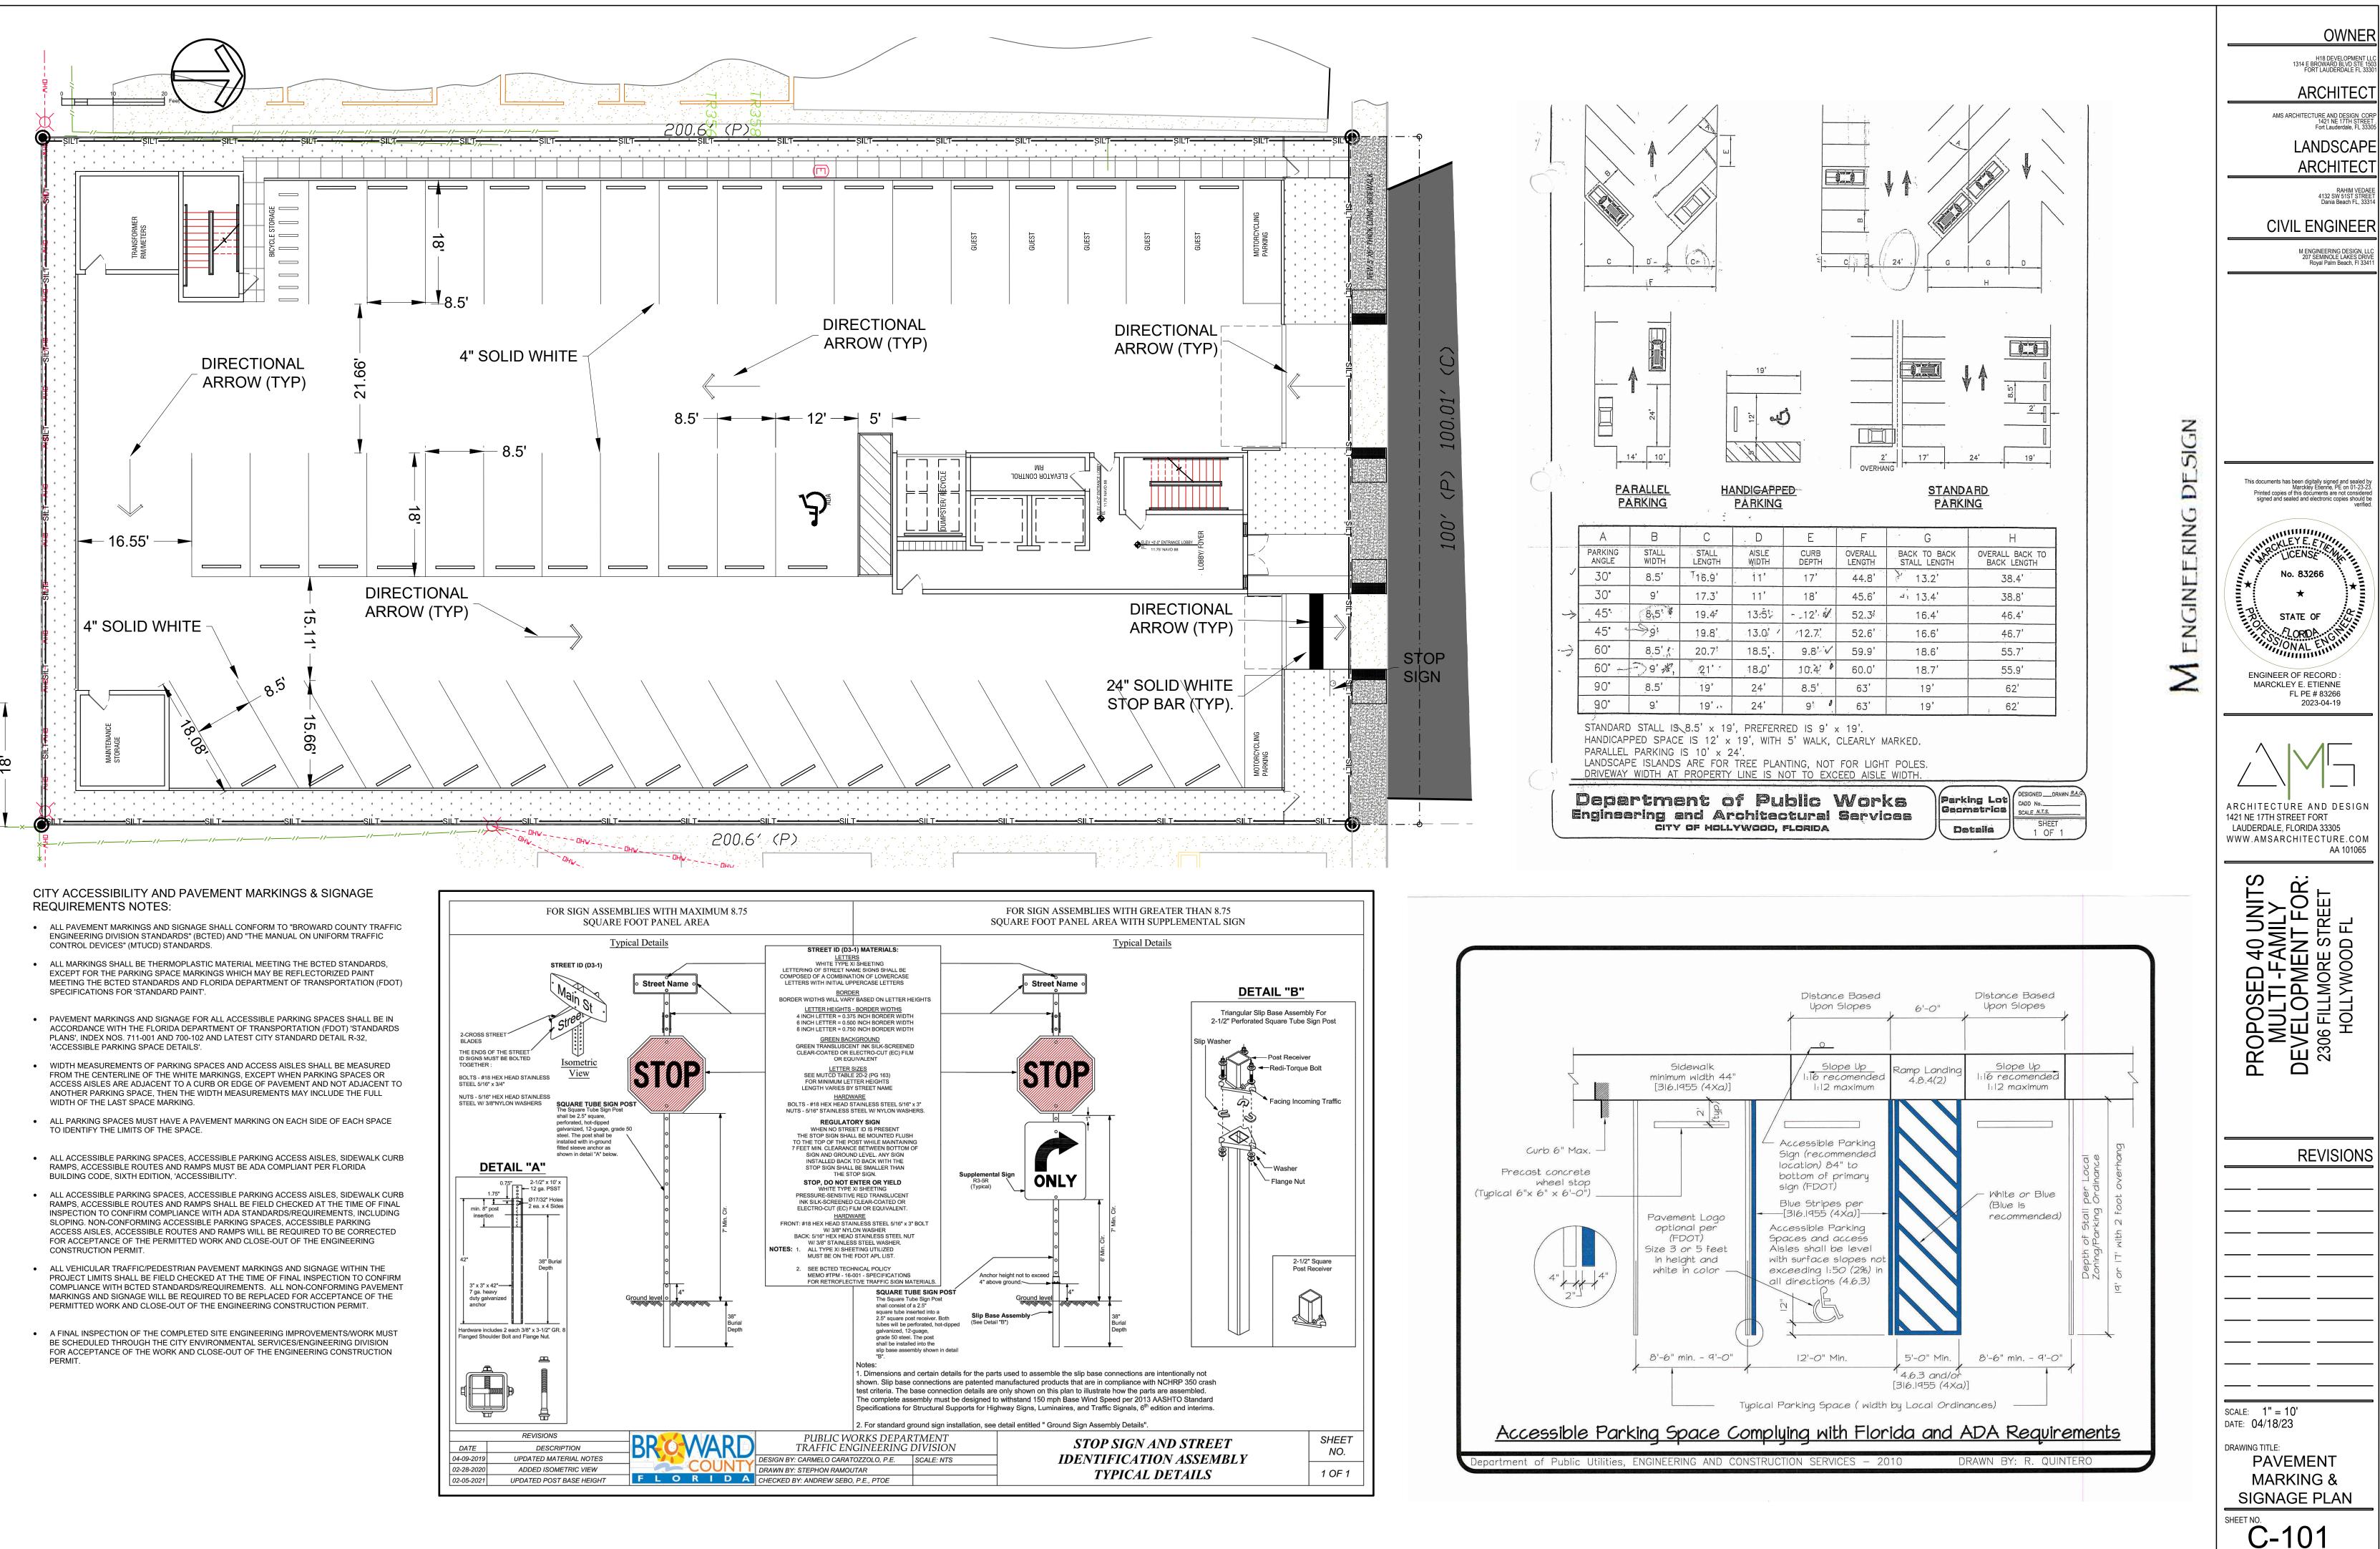

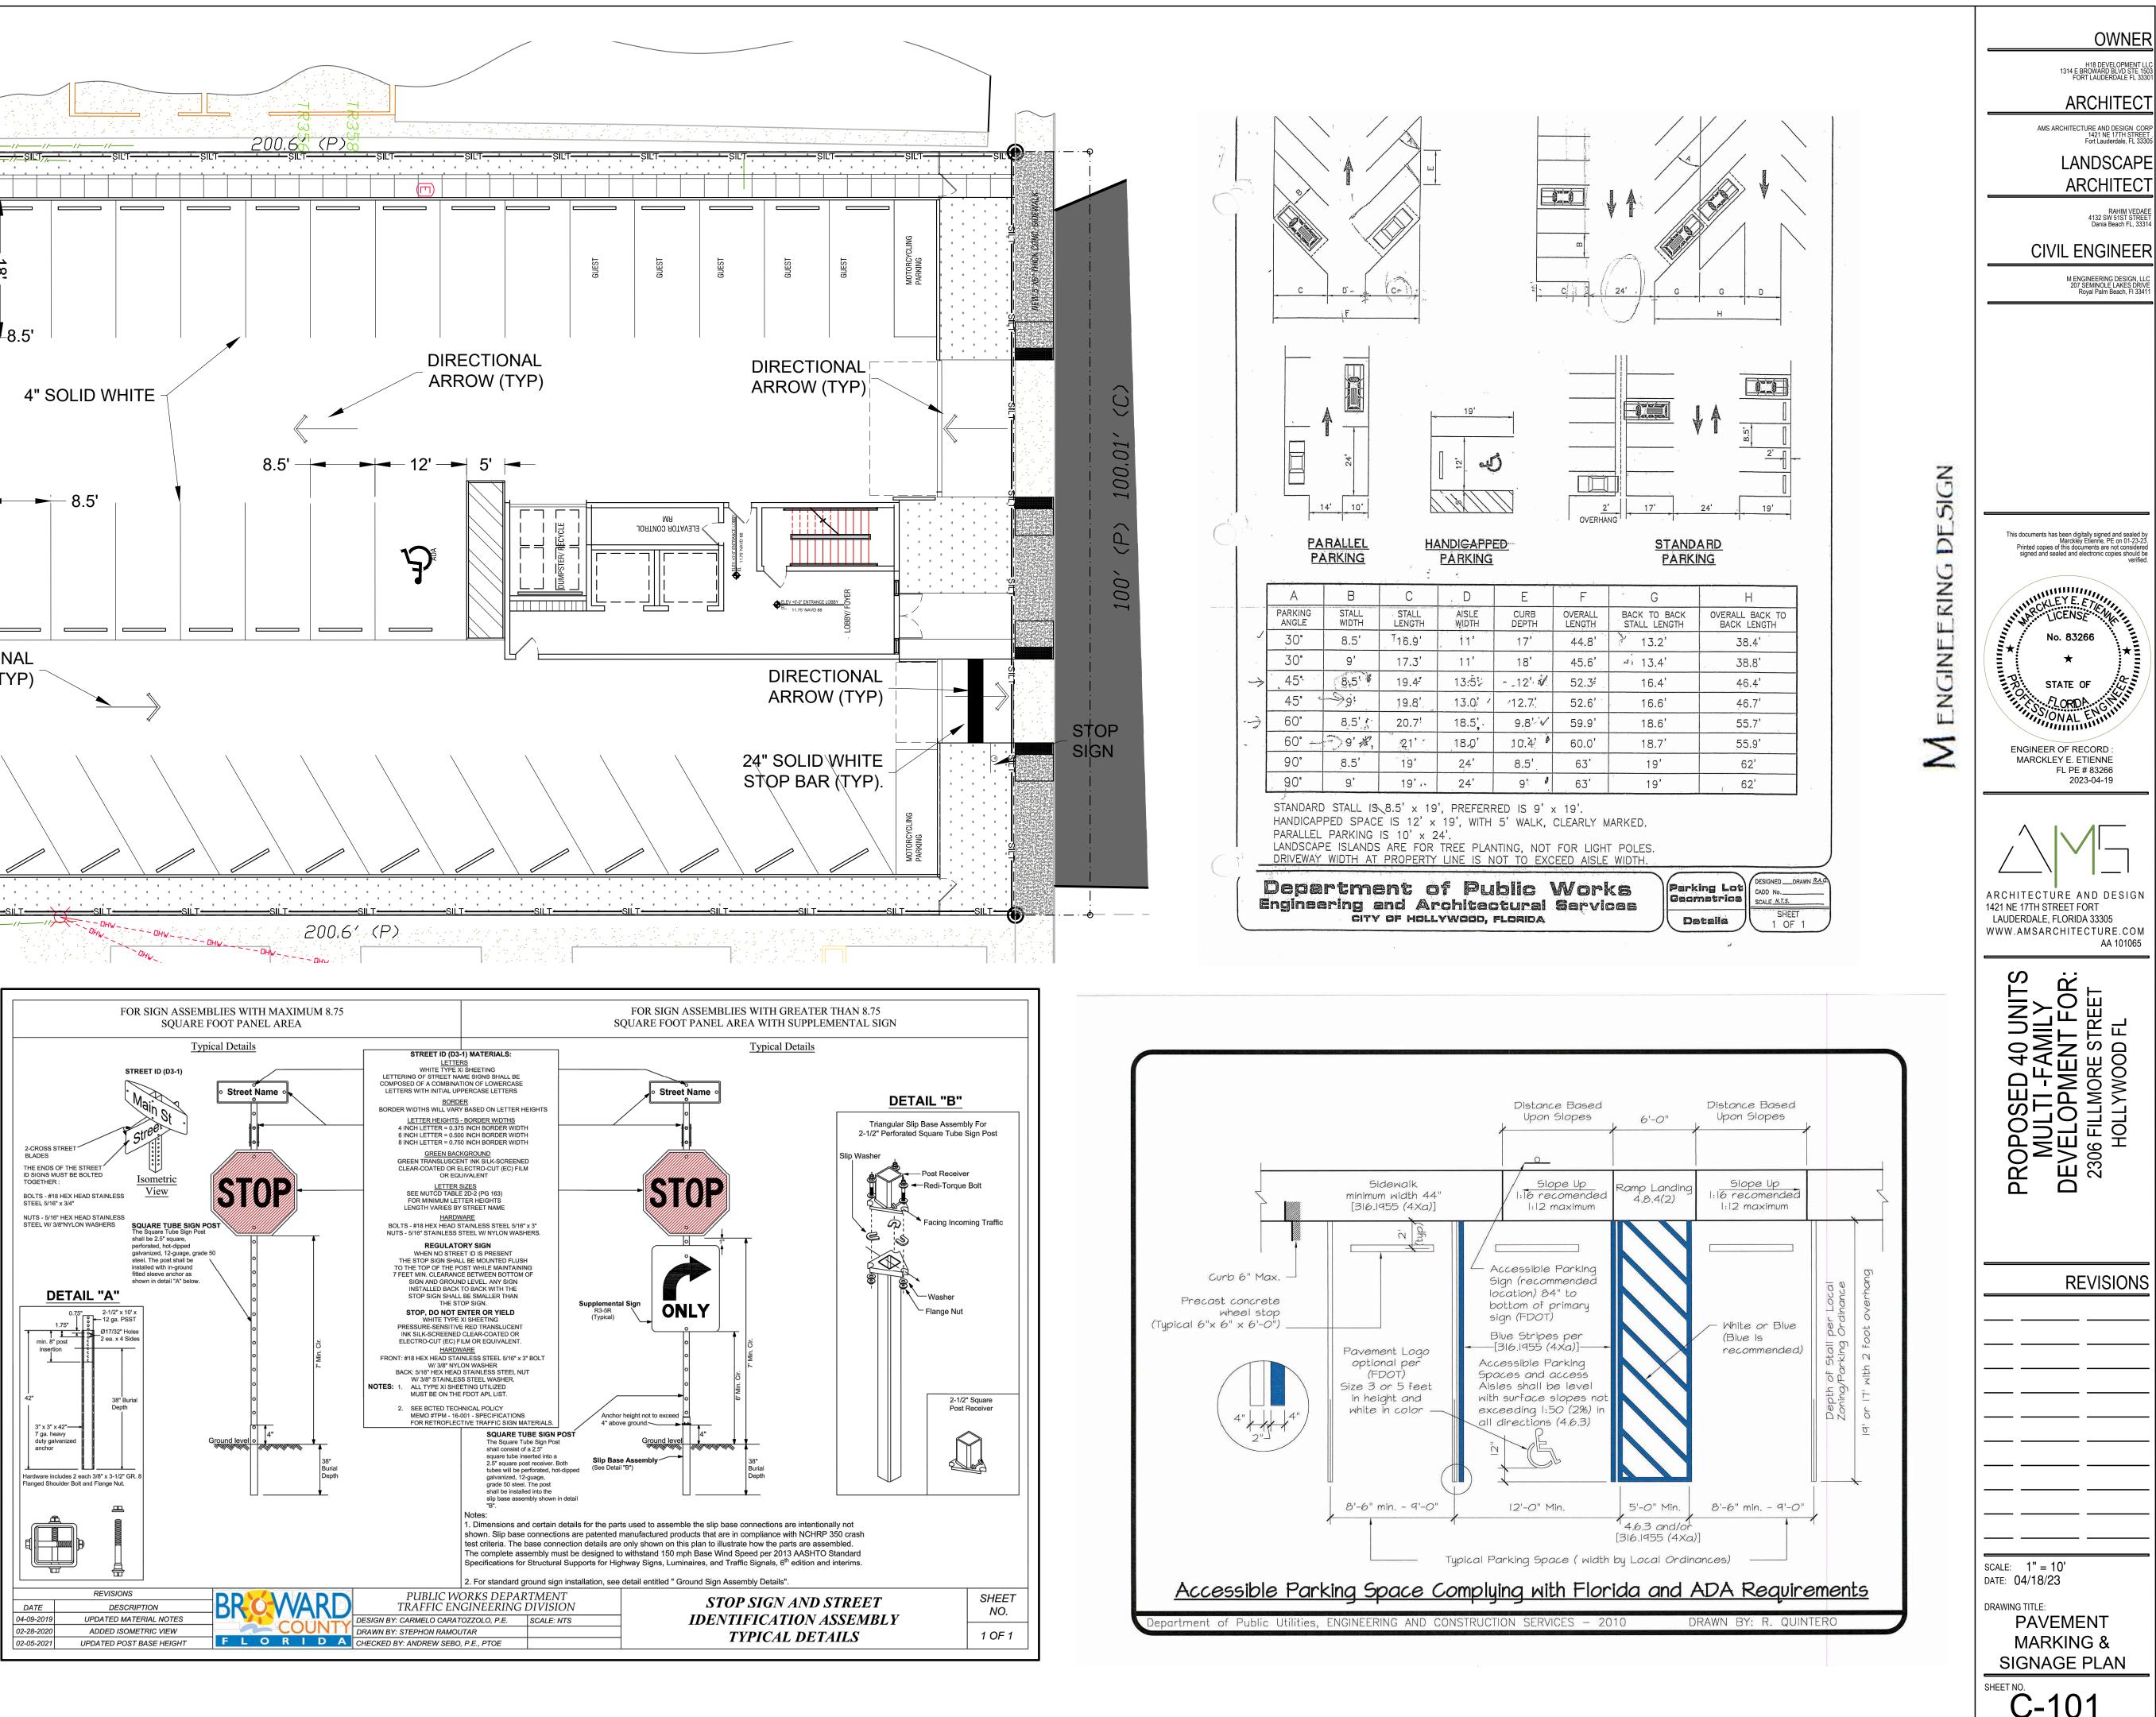


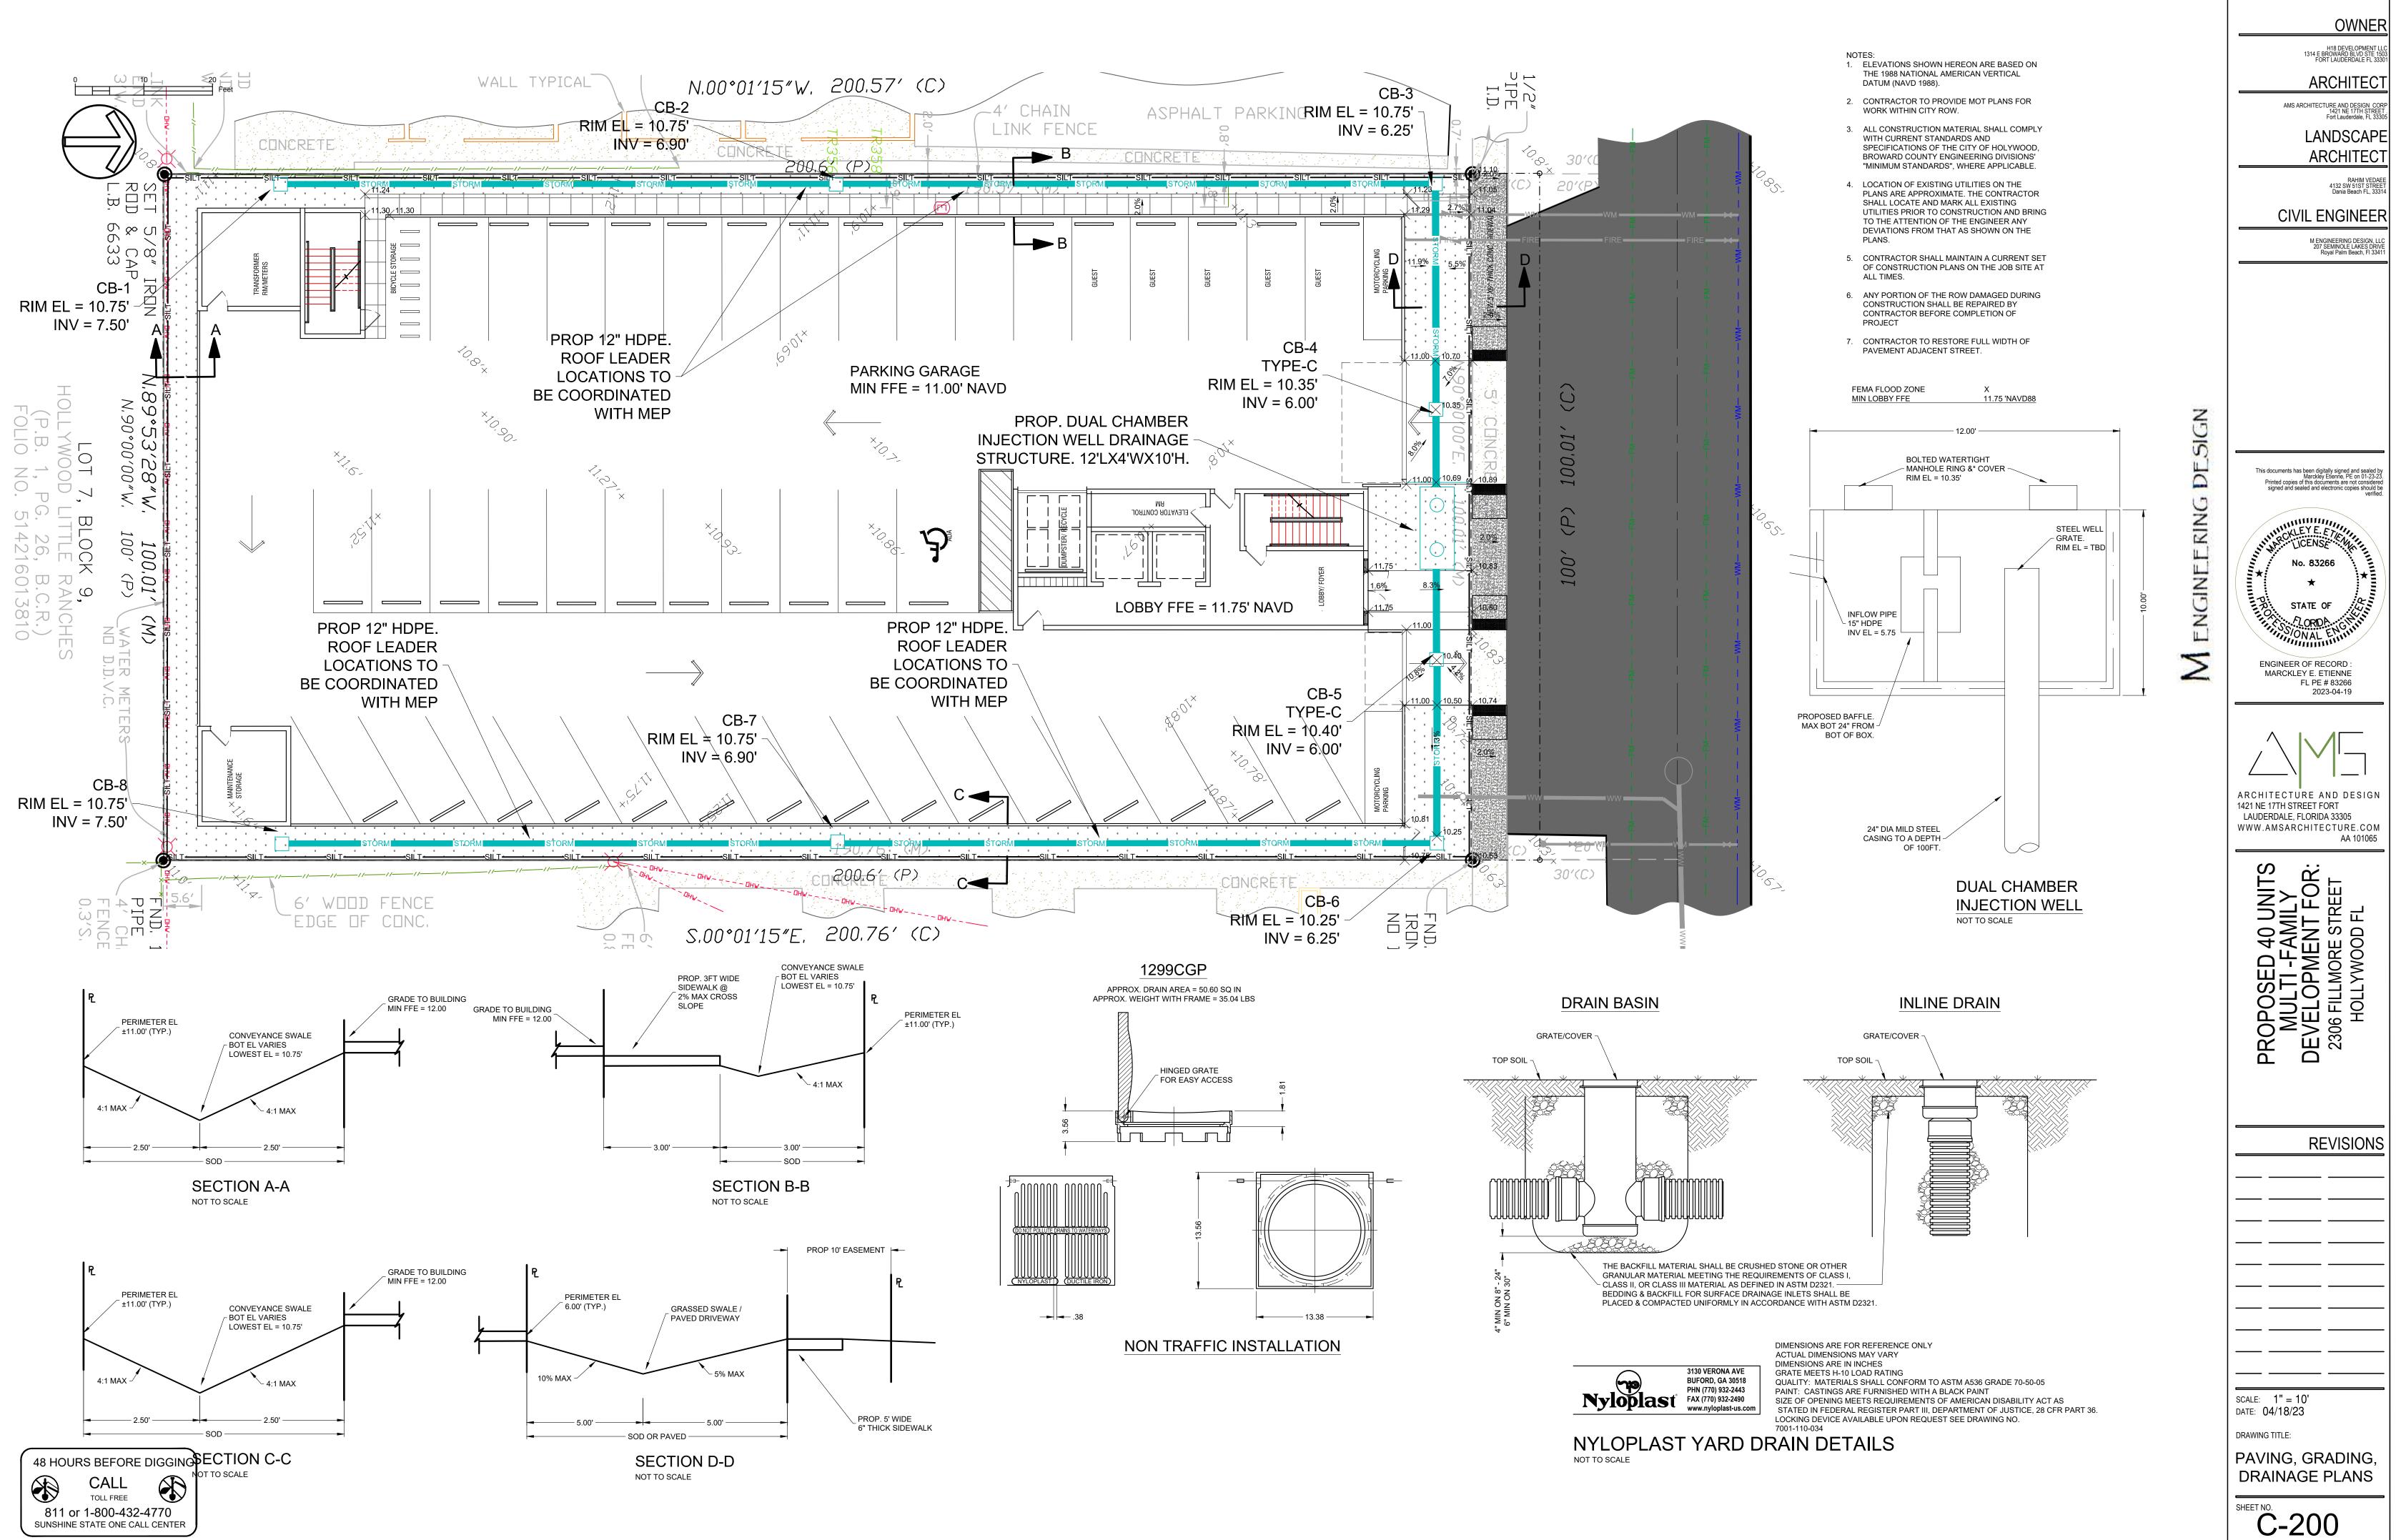


2-0033-C-BASE.DWG | LAST SAVED: 2023-04-19 12:05:18 AM | PLOT SCALE : 1:1| | PLOTTED: 2023-04-19 12:08:50 AM | USER: Marckley E

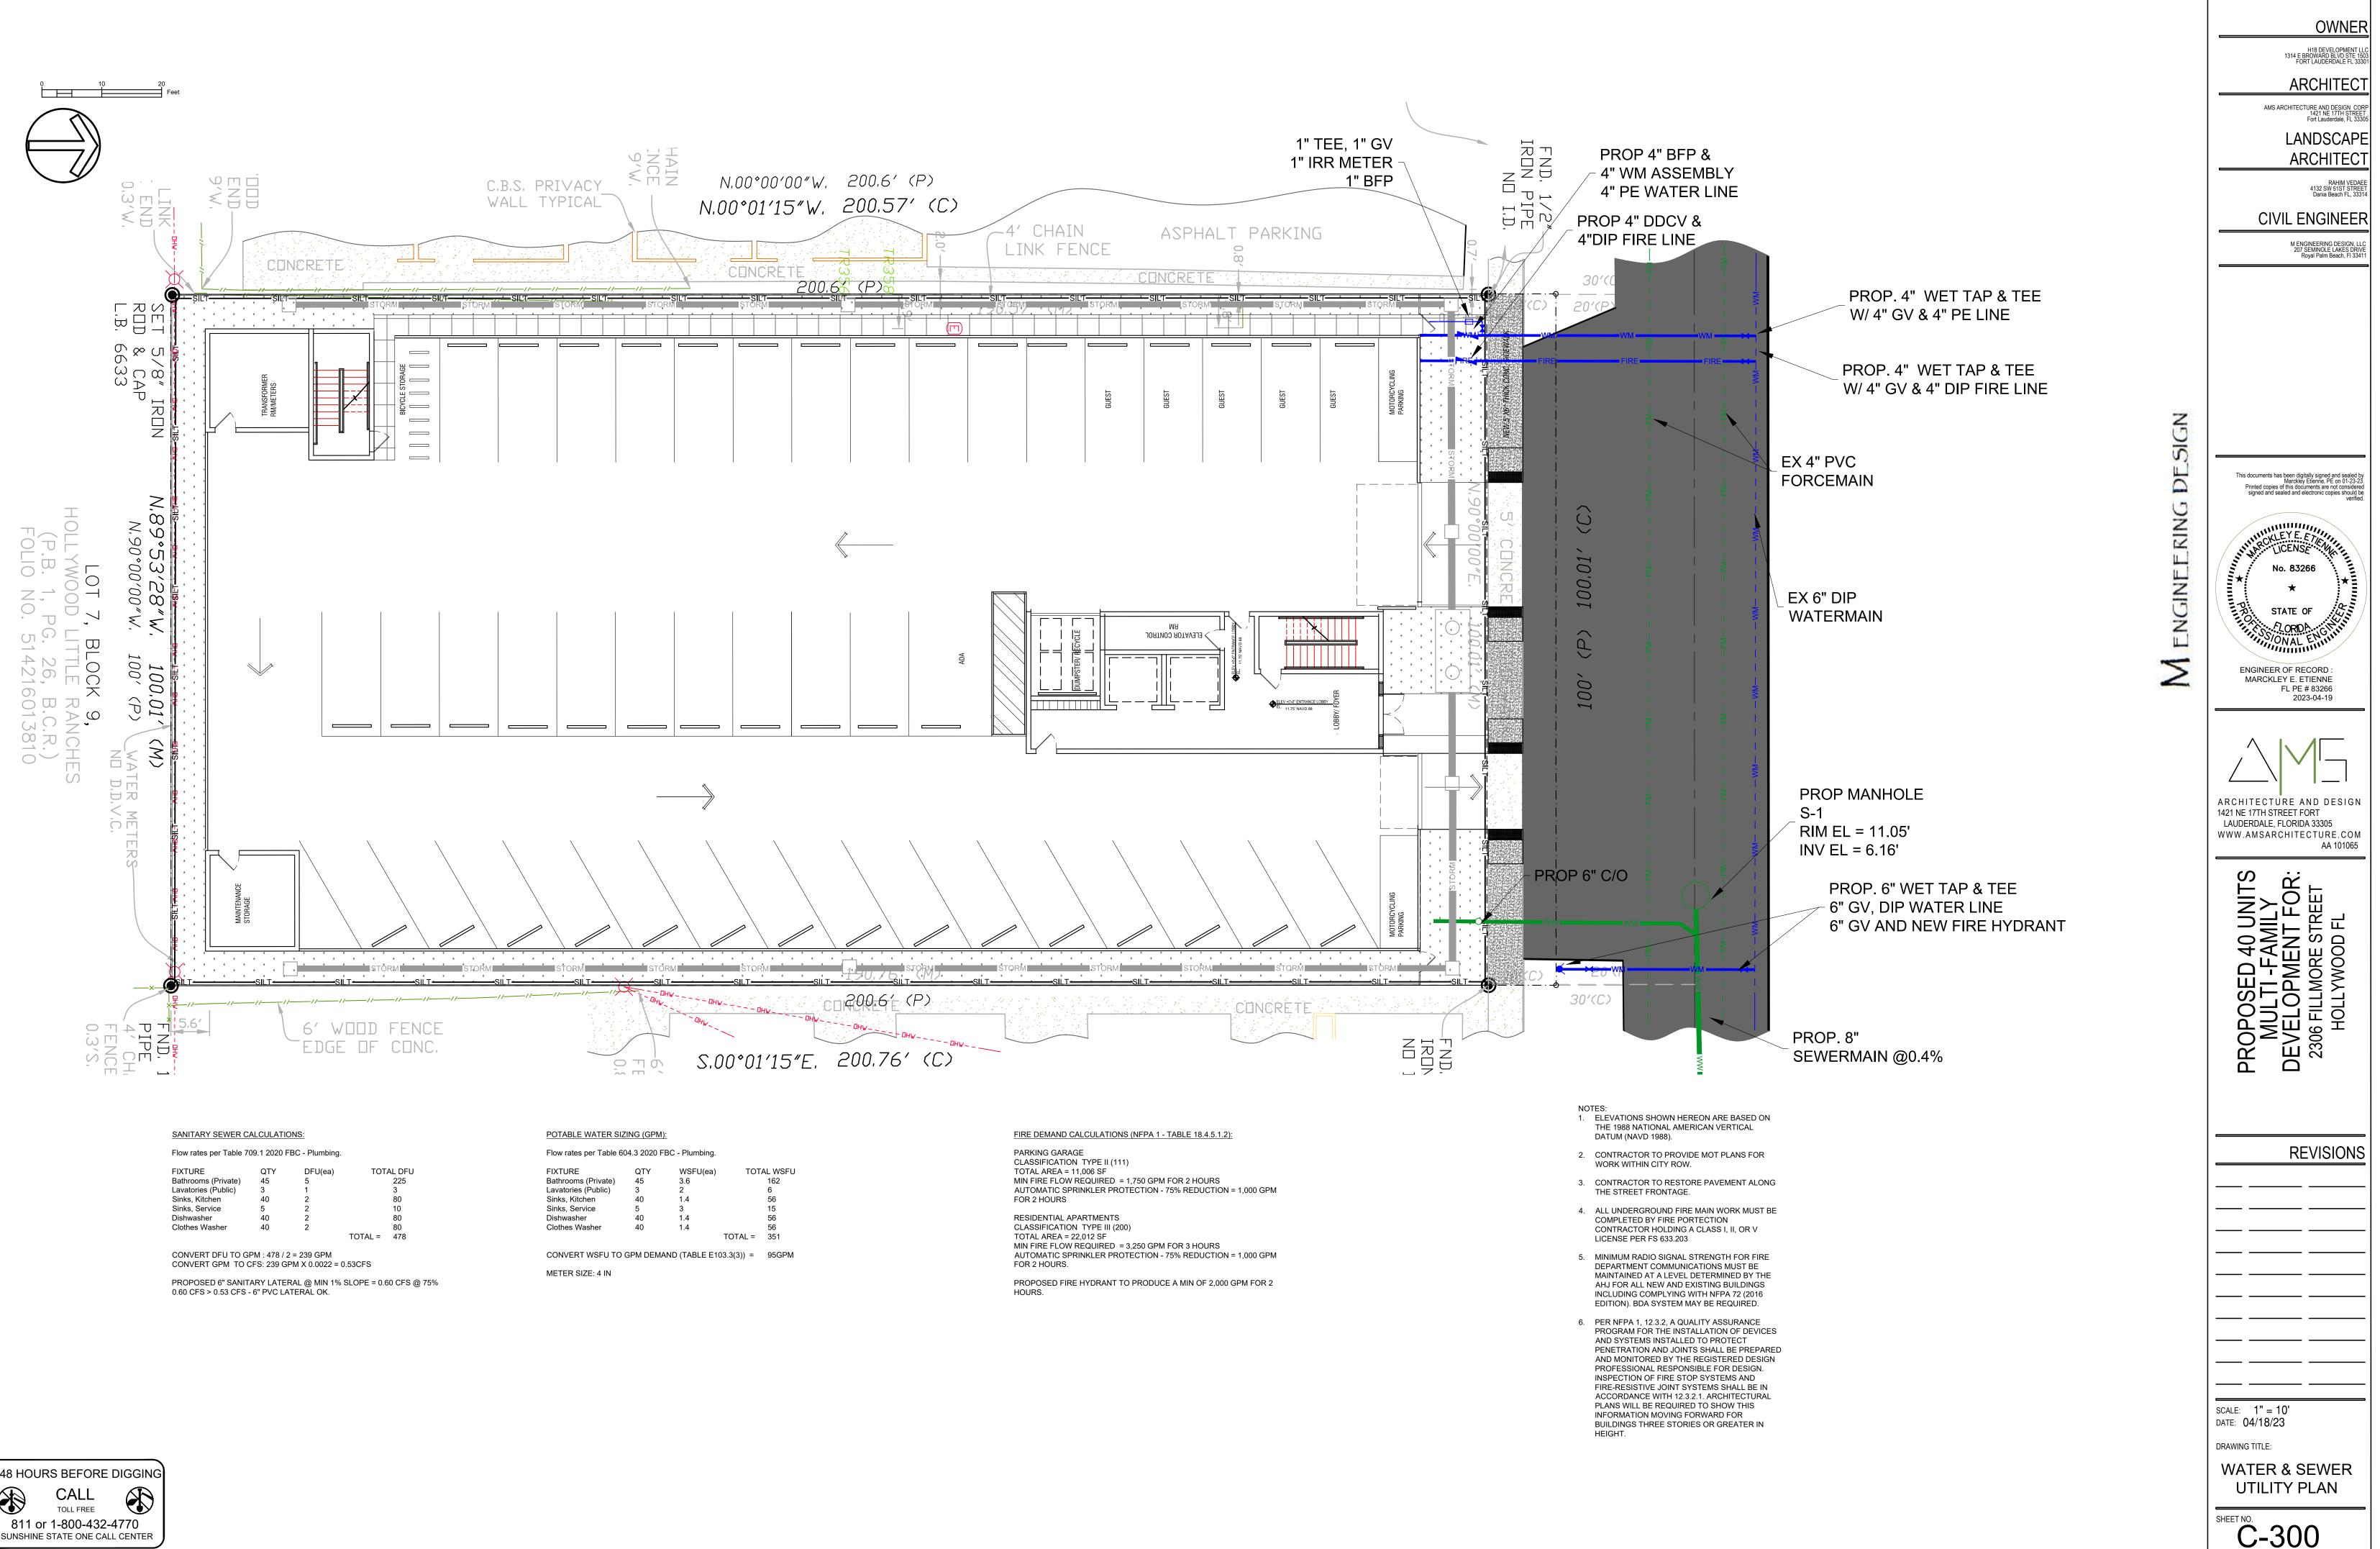





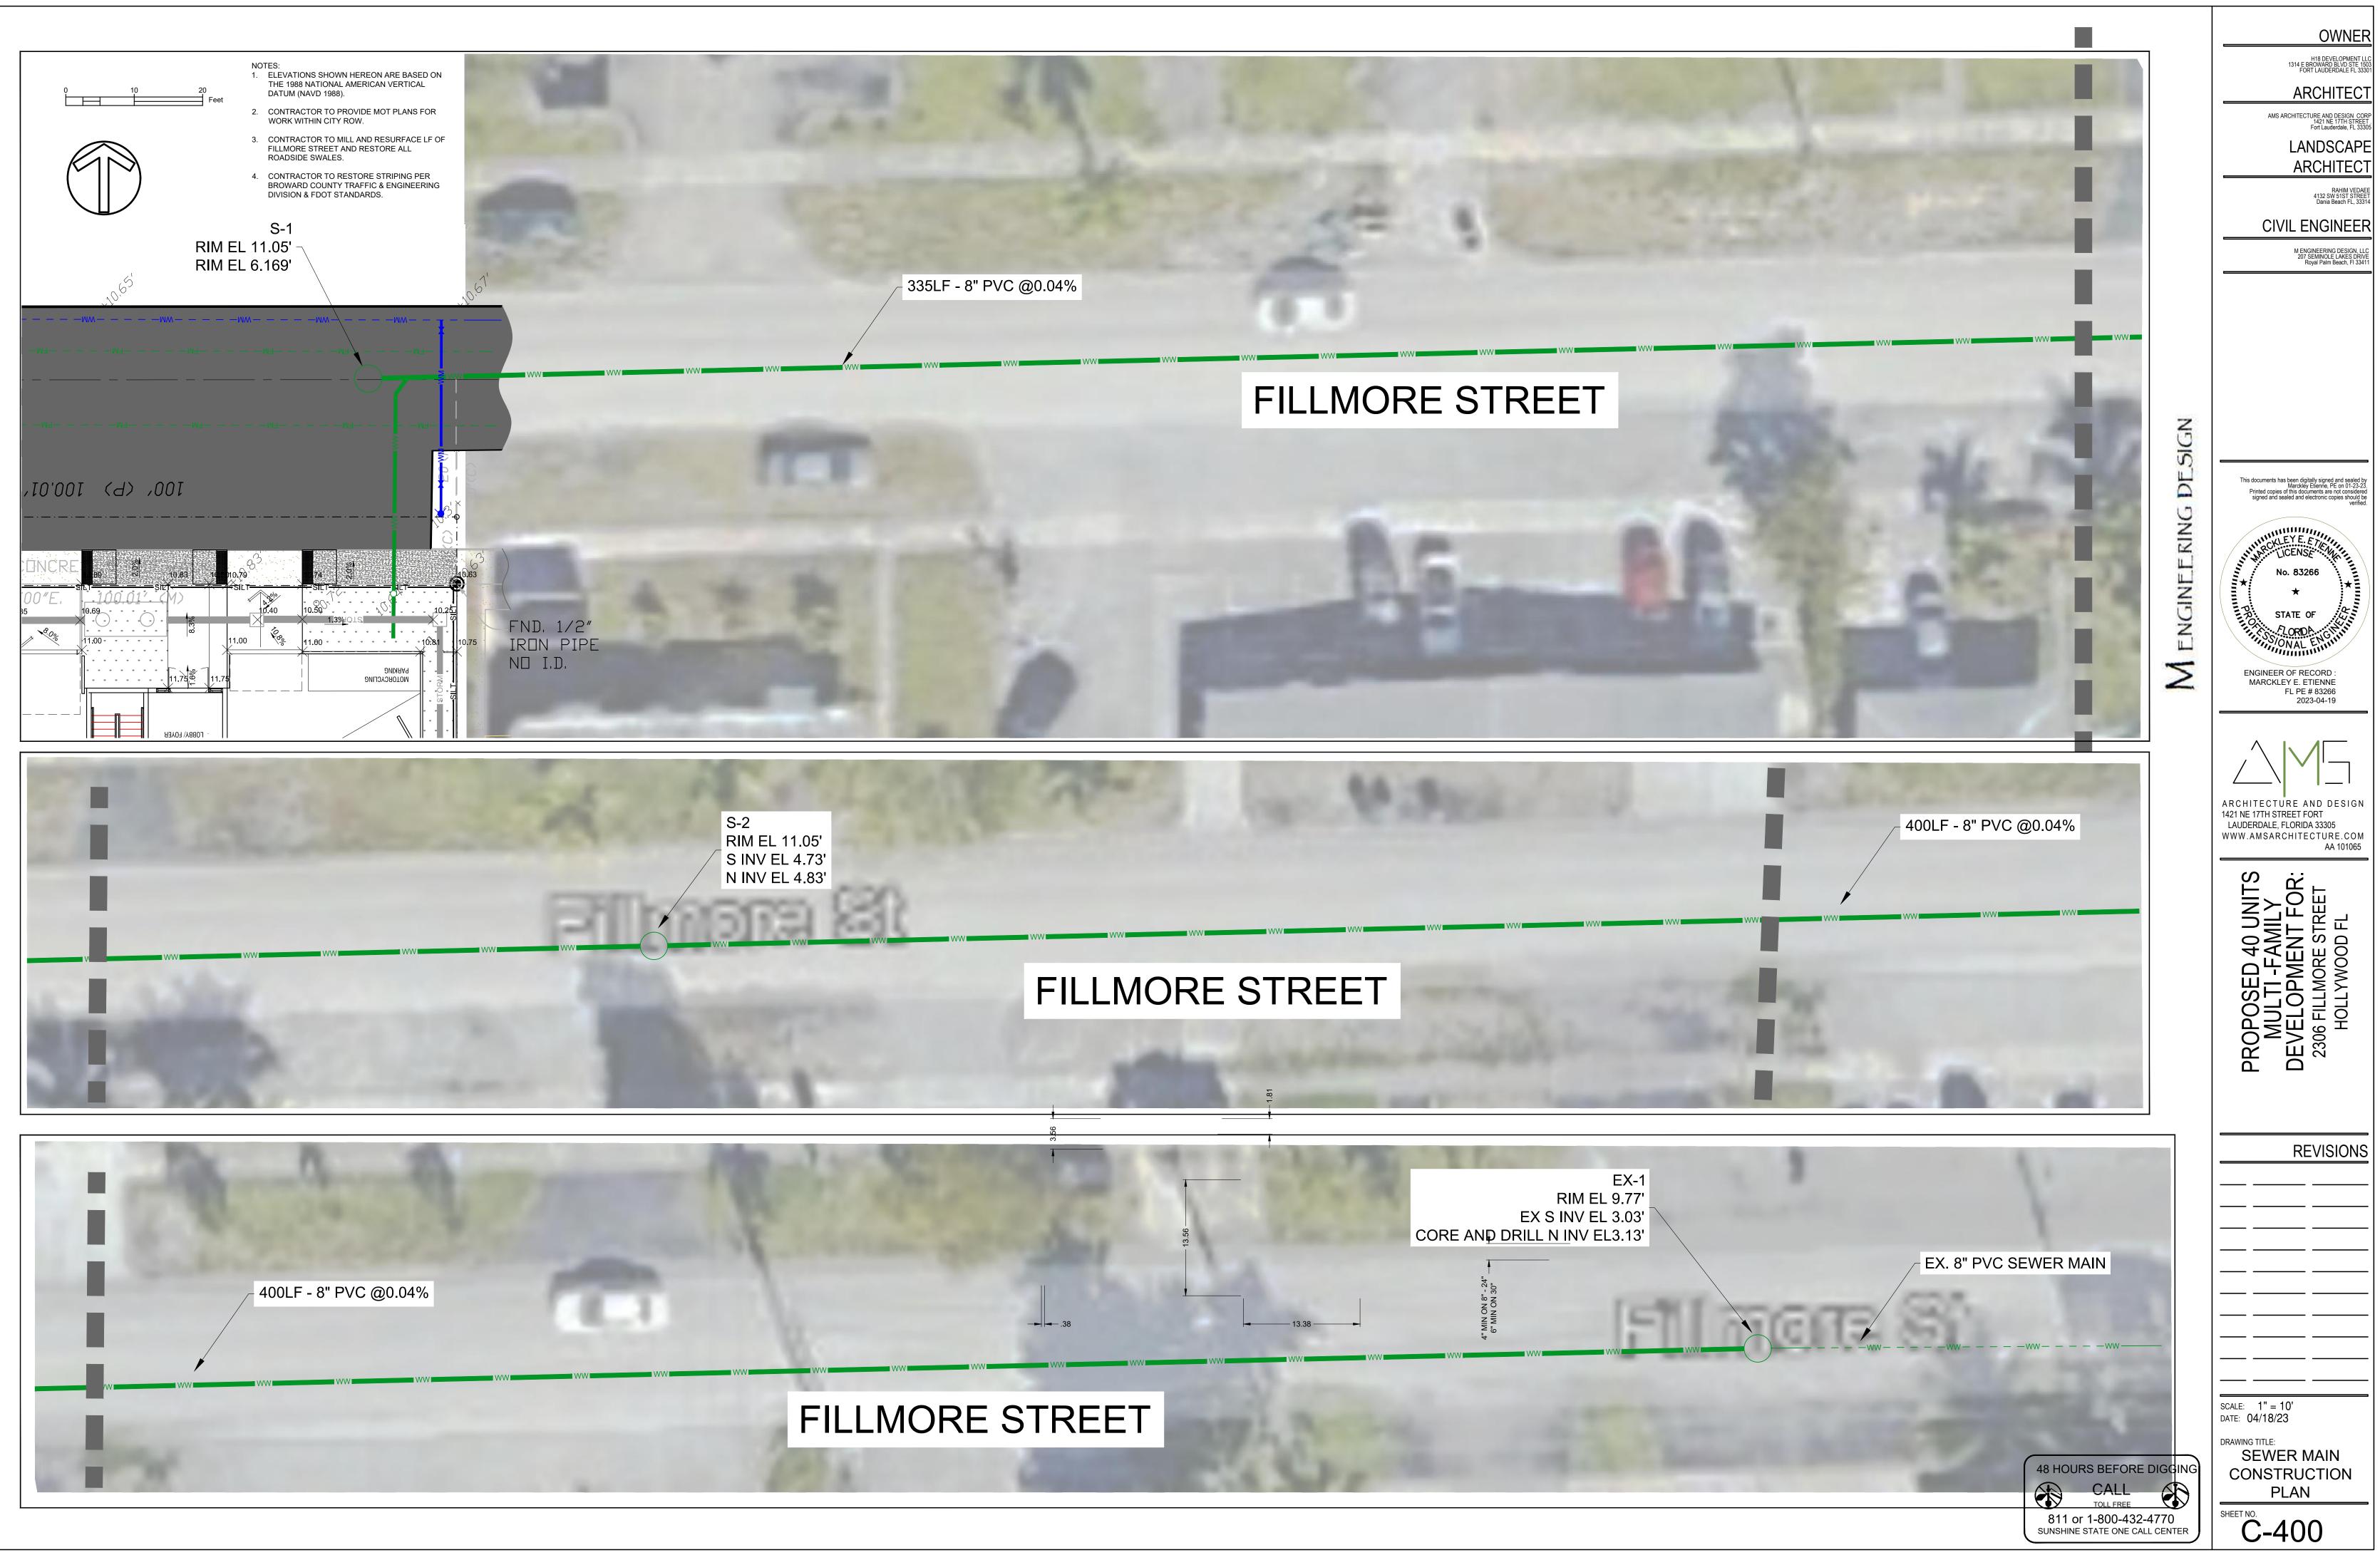




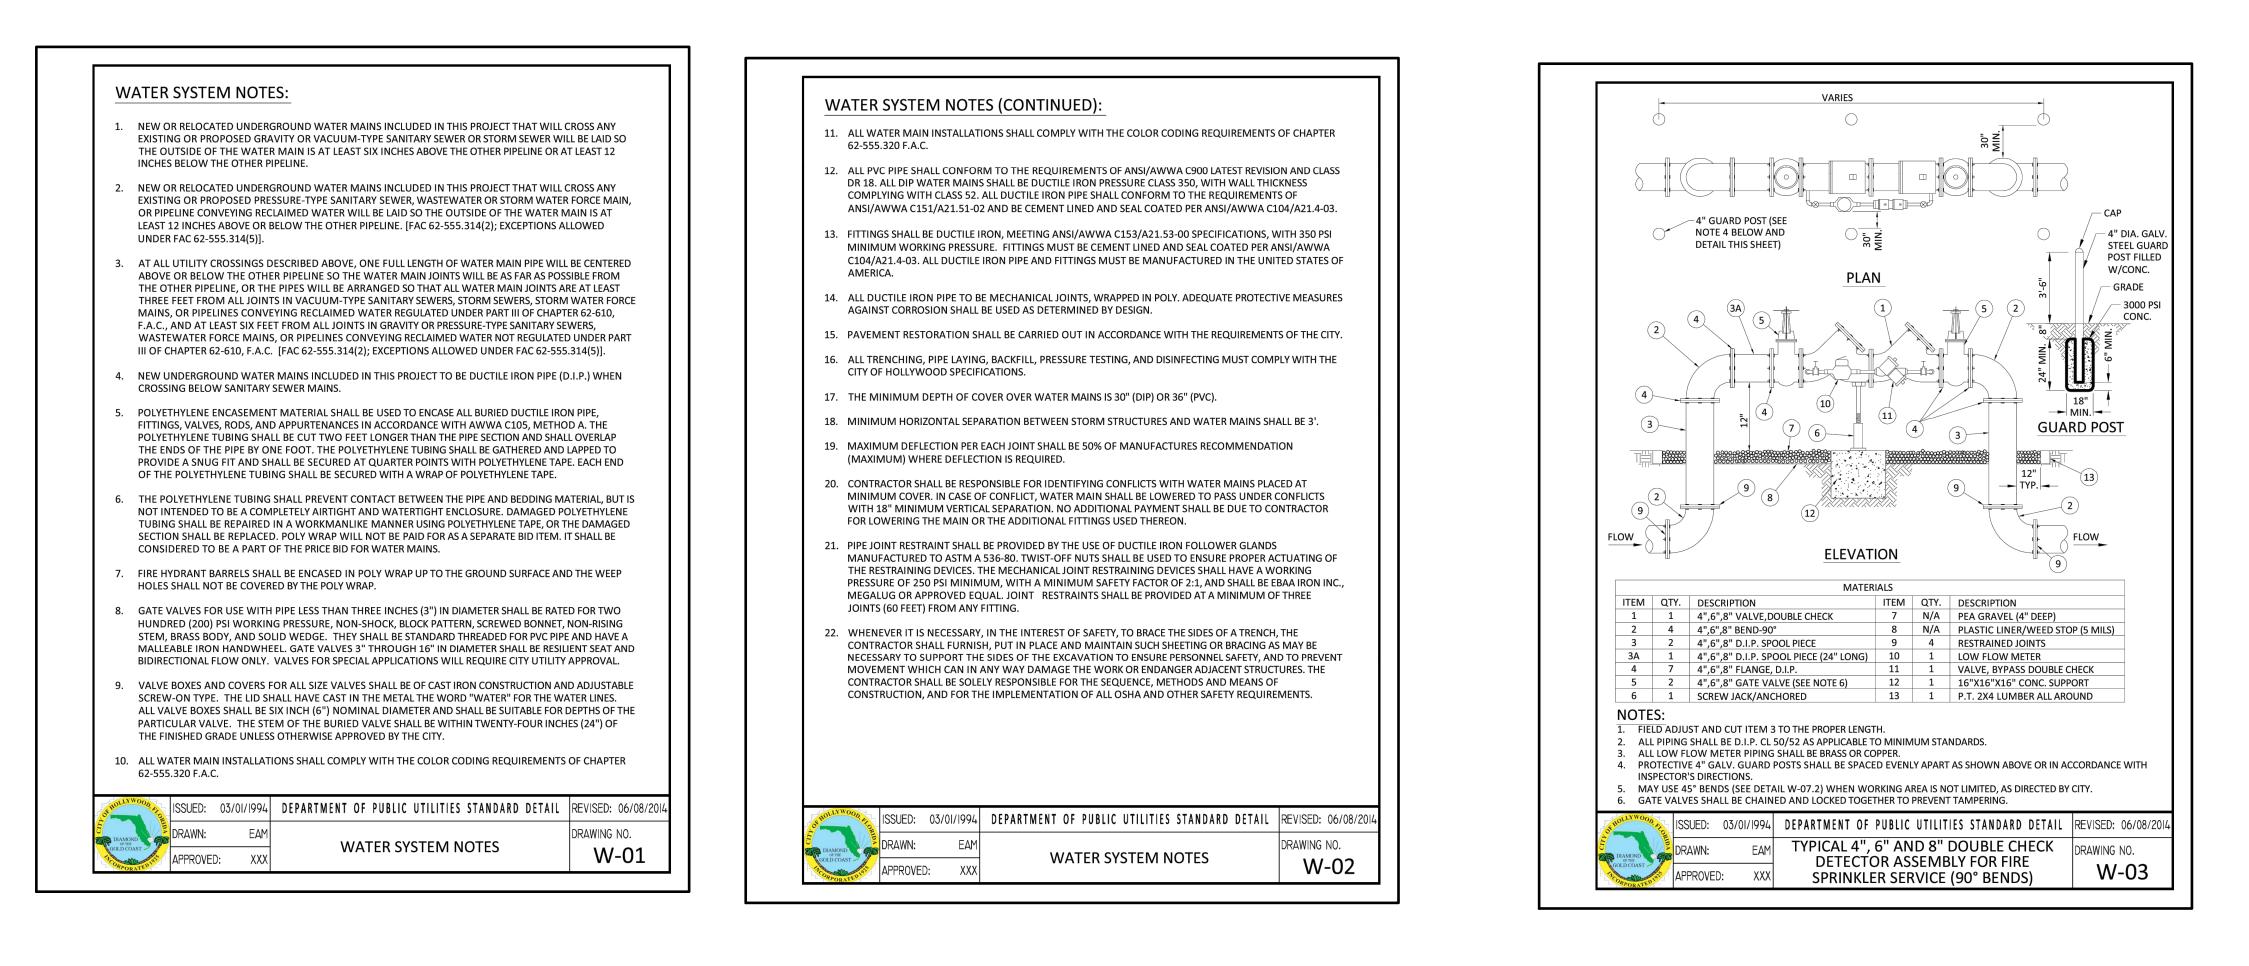


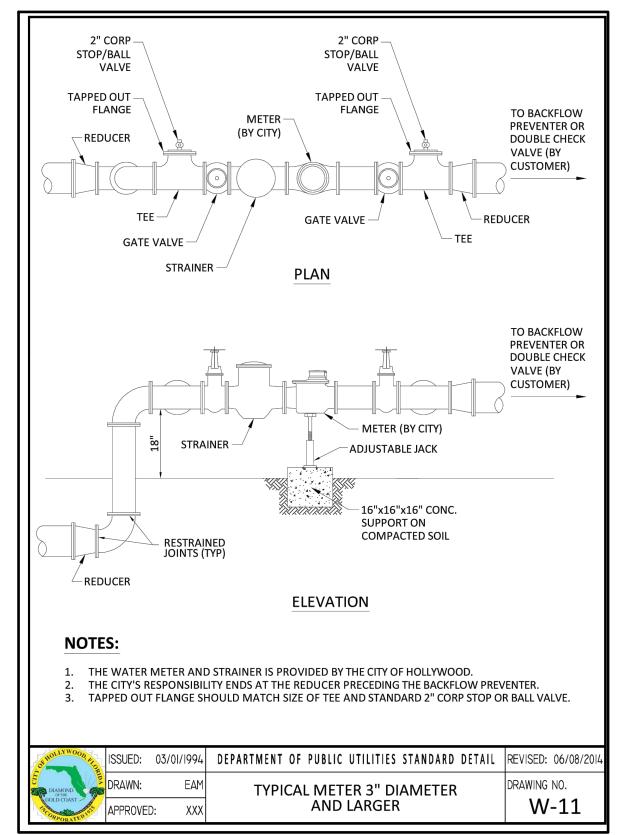

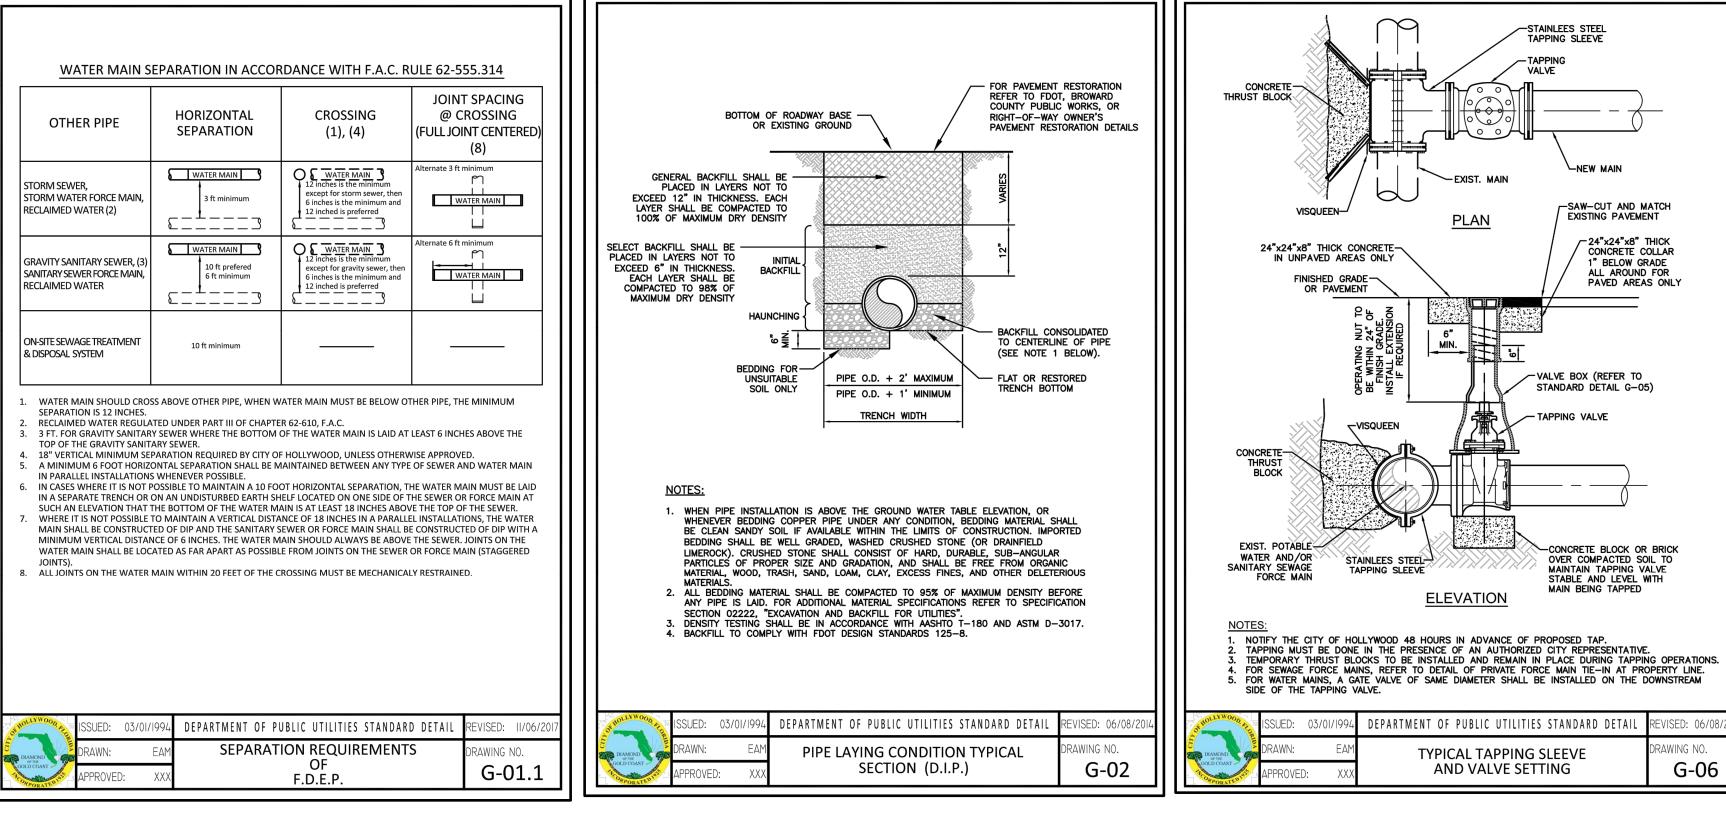

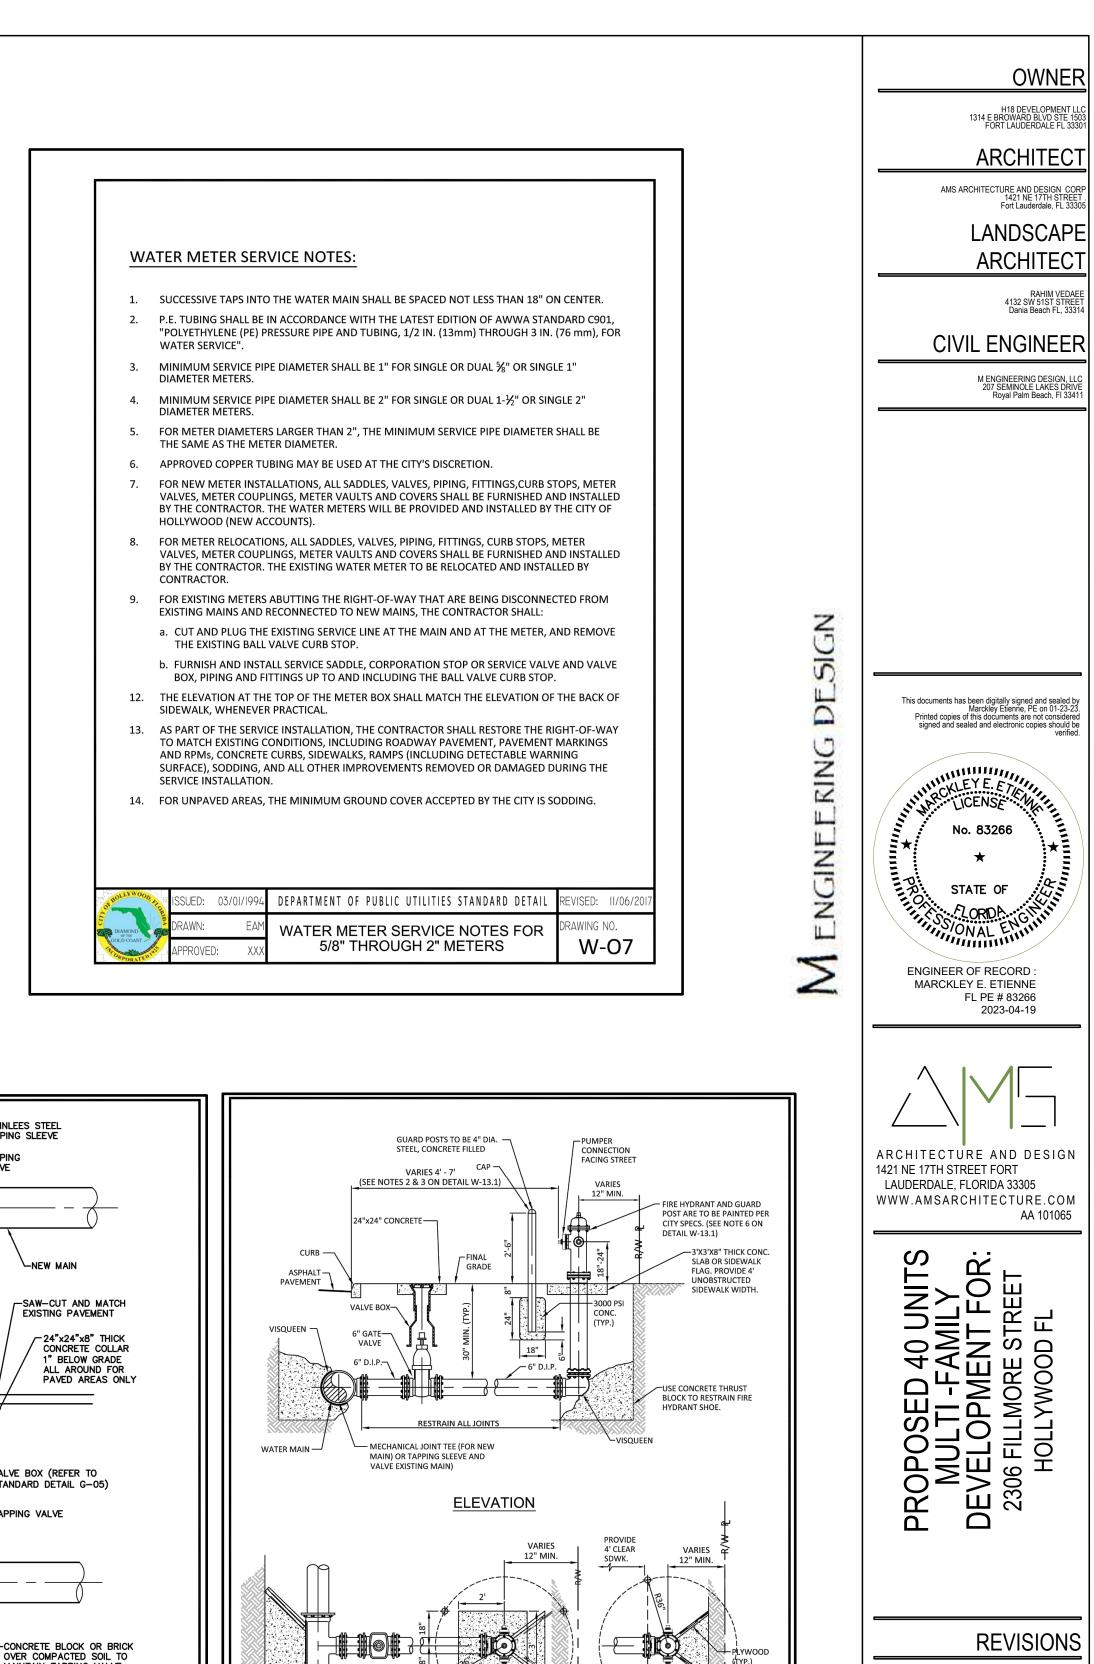

AWING NO. G-06

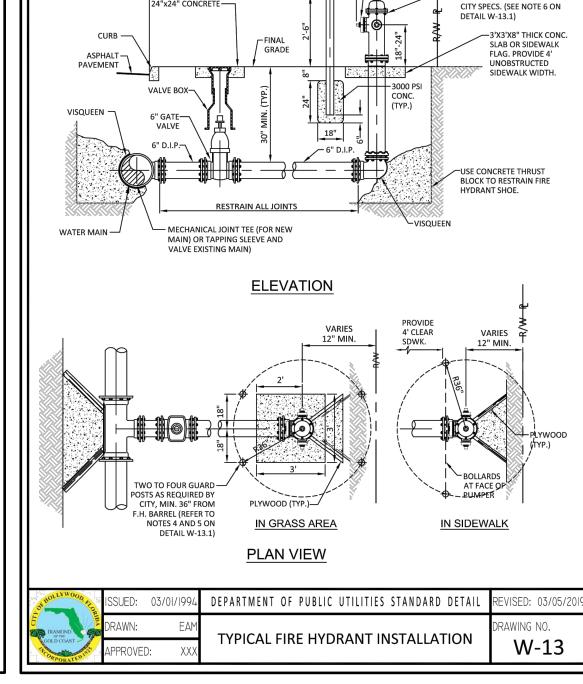



SCALE: 1" = 10' DATE: 04/18/23

DRAWING TITLE:


SHEET NO.


____ ____


WATER UTILITY


DETAILS


C-500

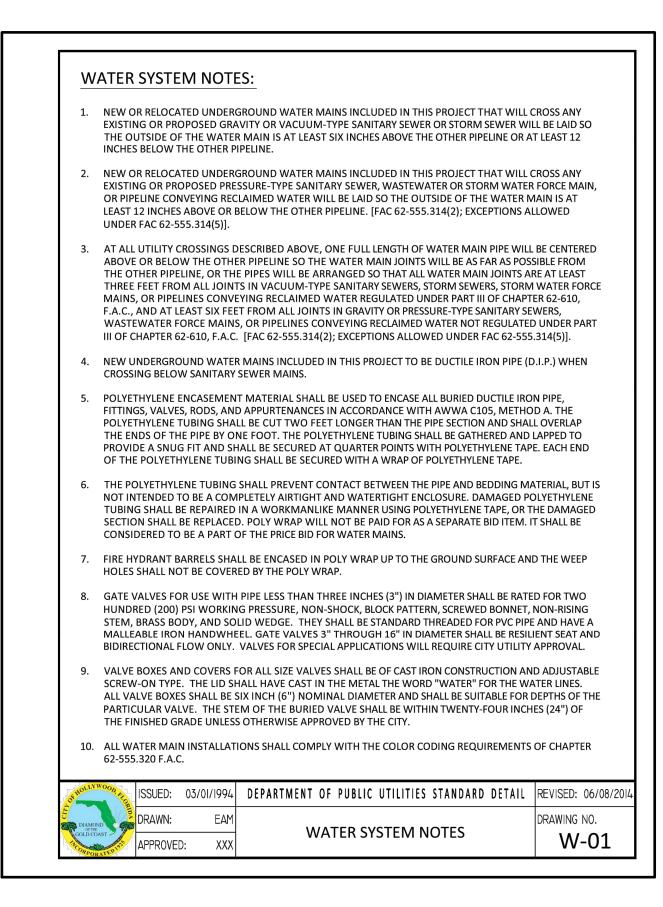


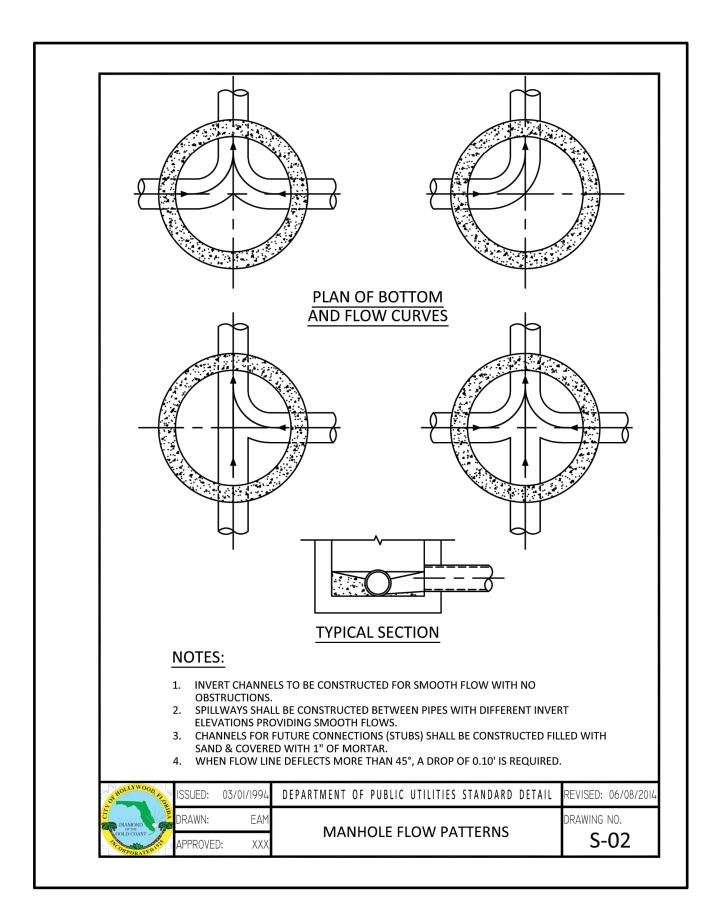


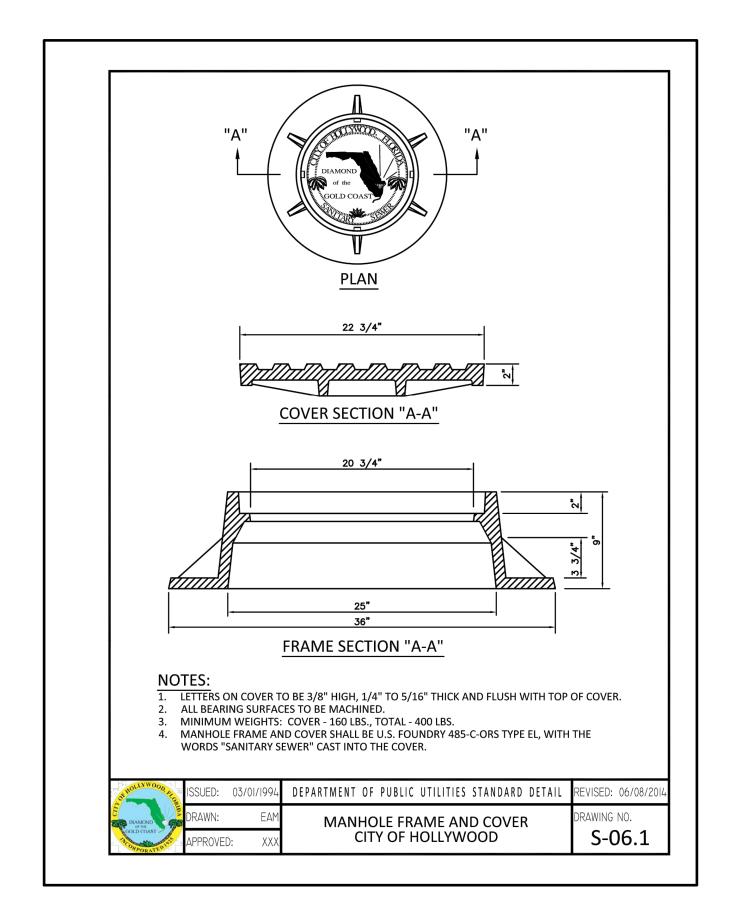


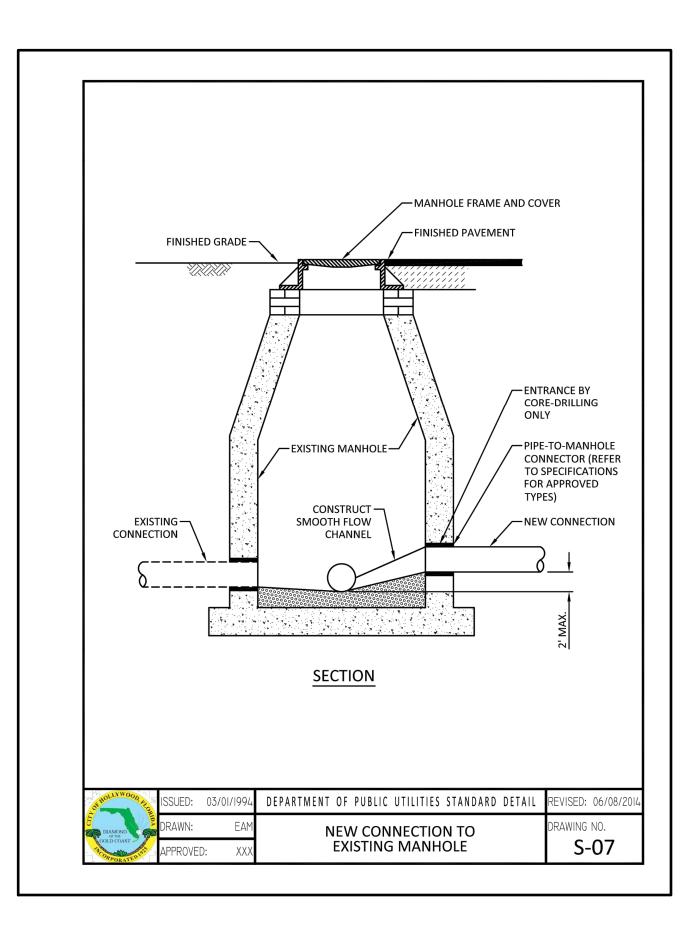

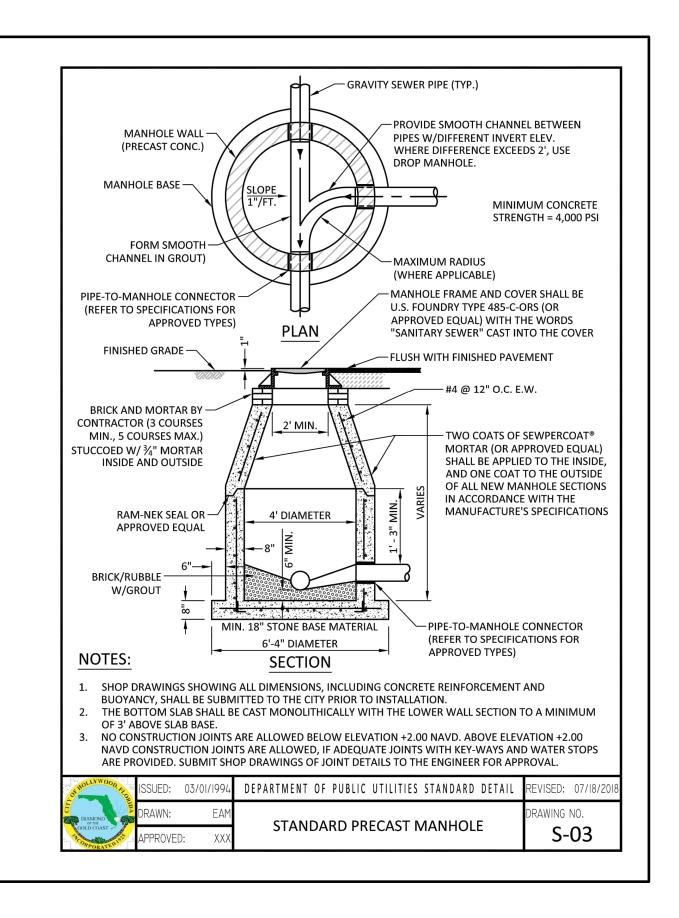


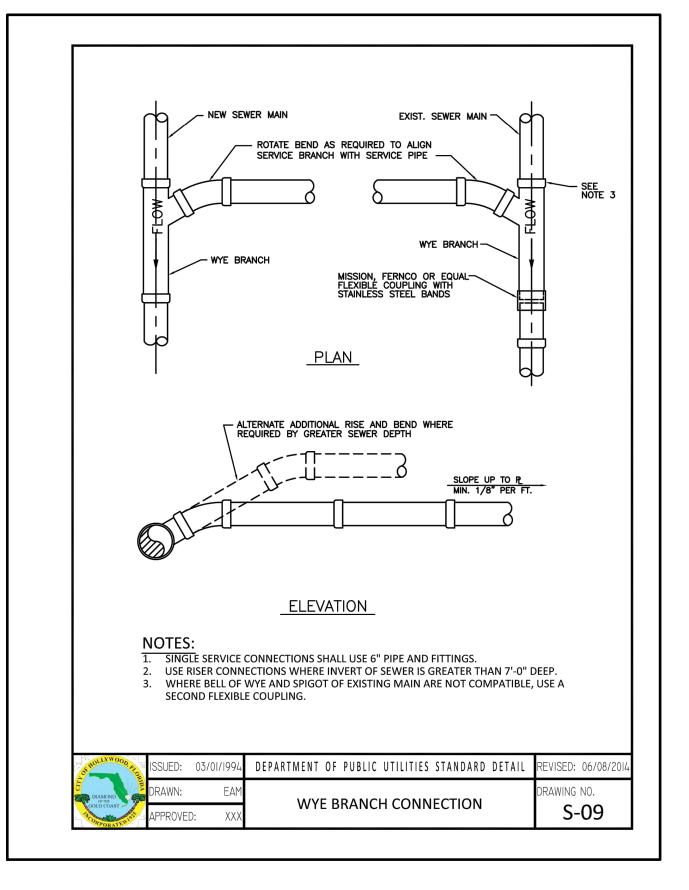

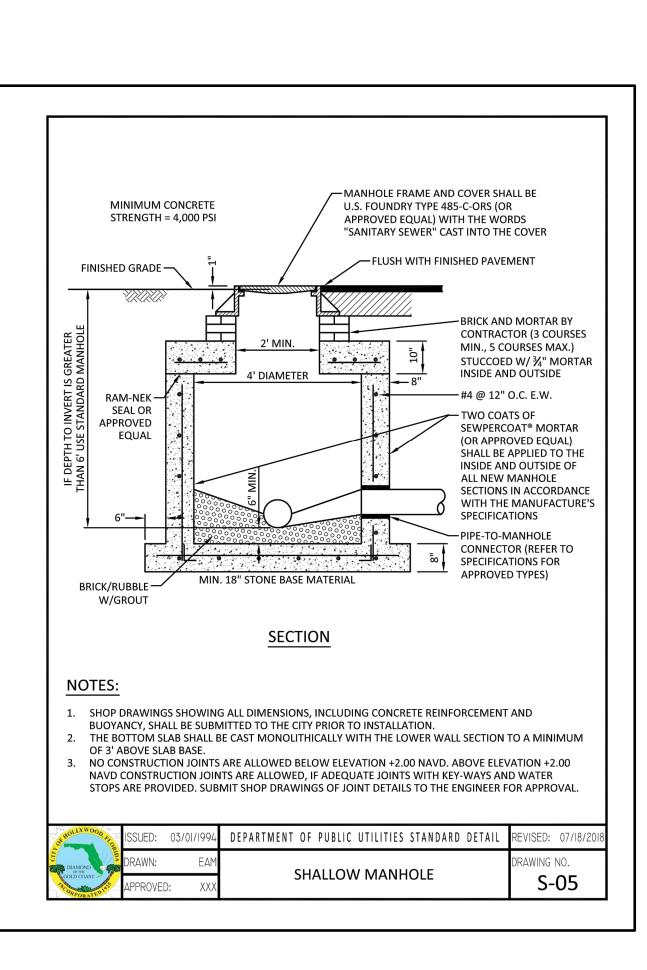

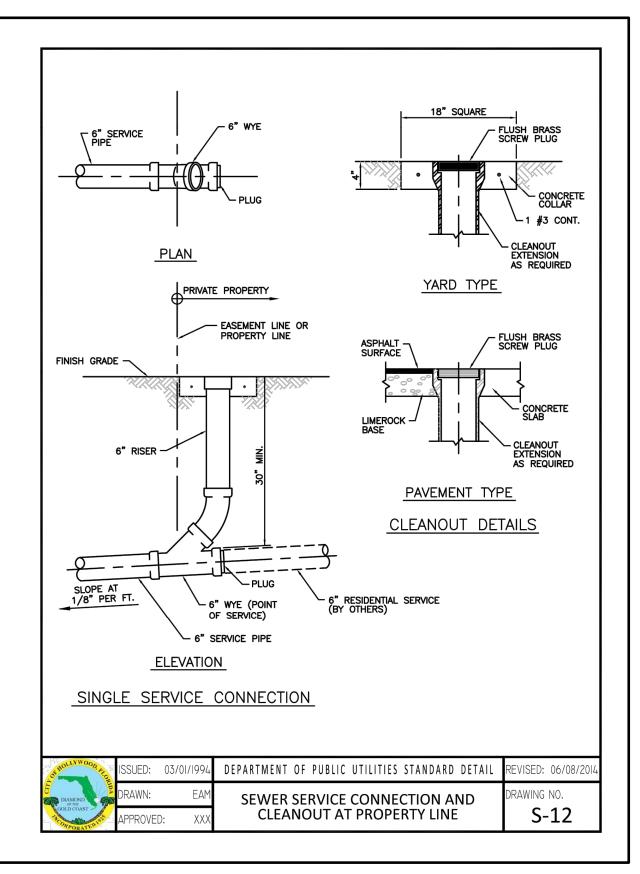




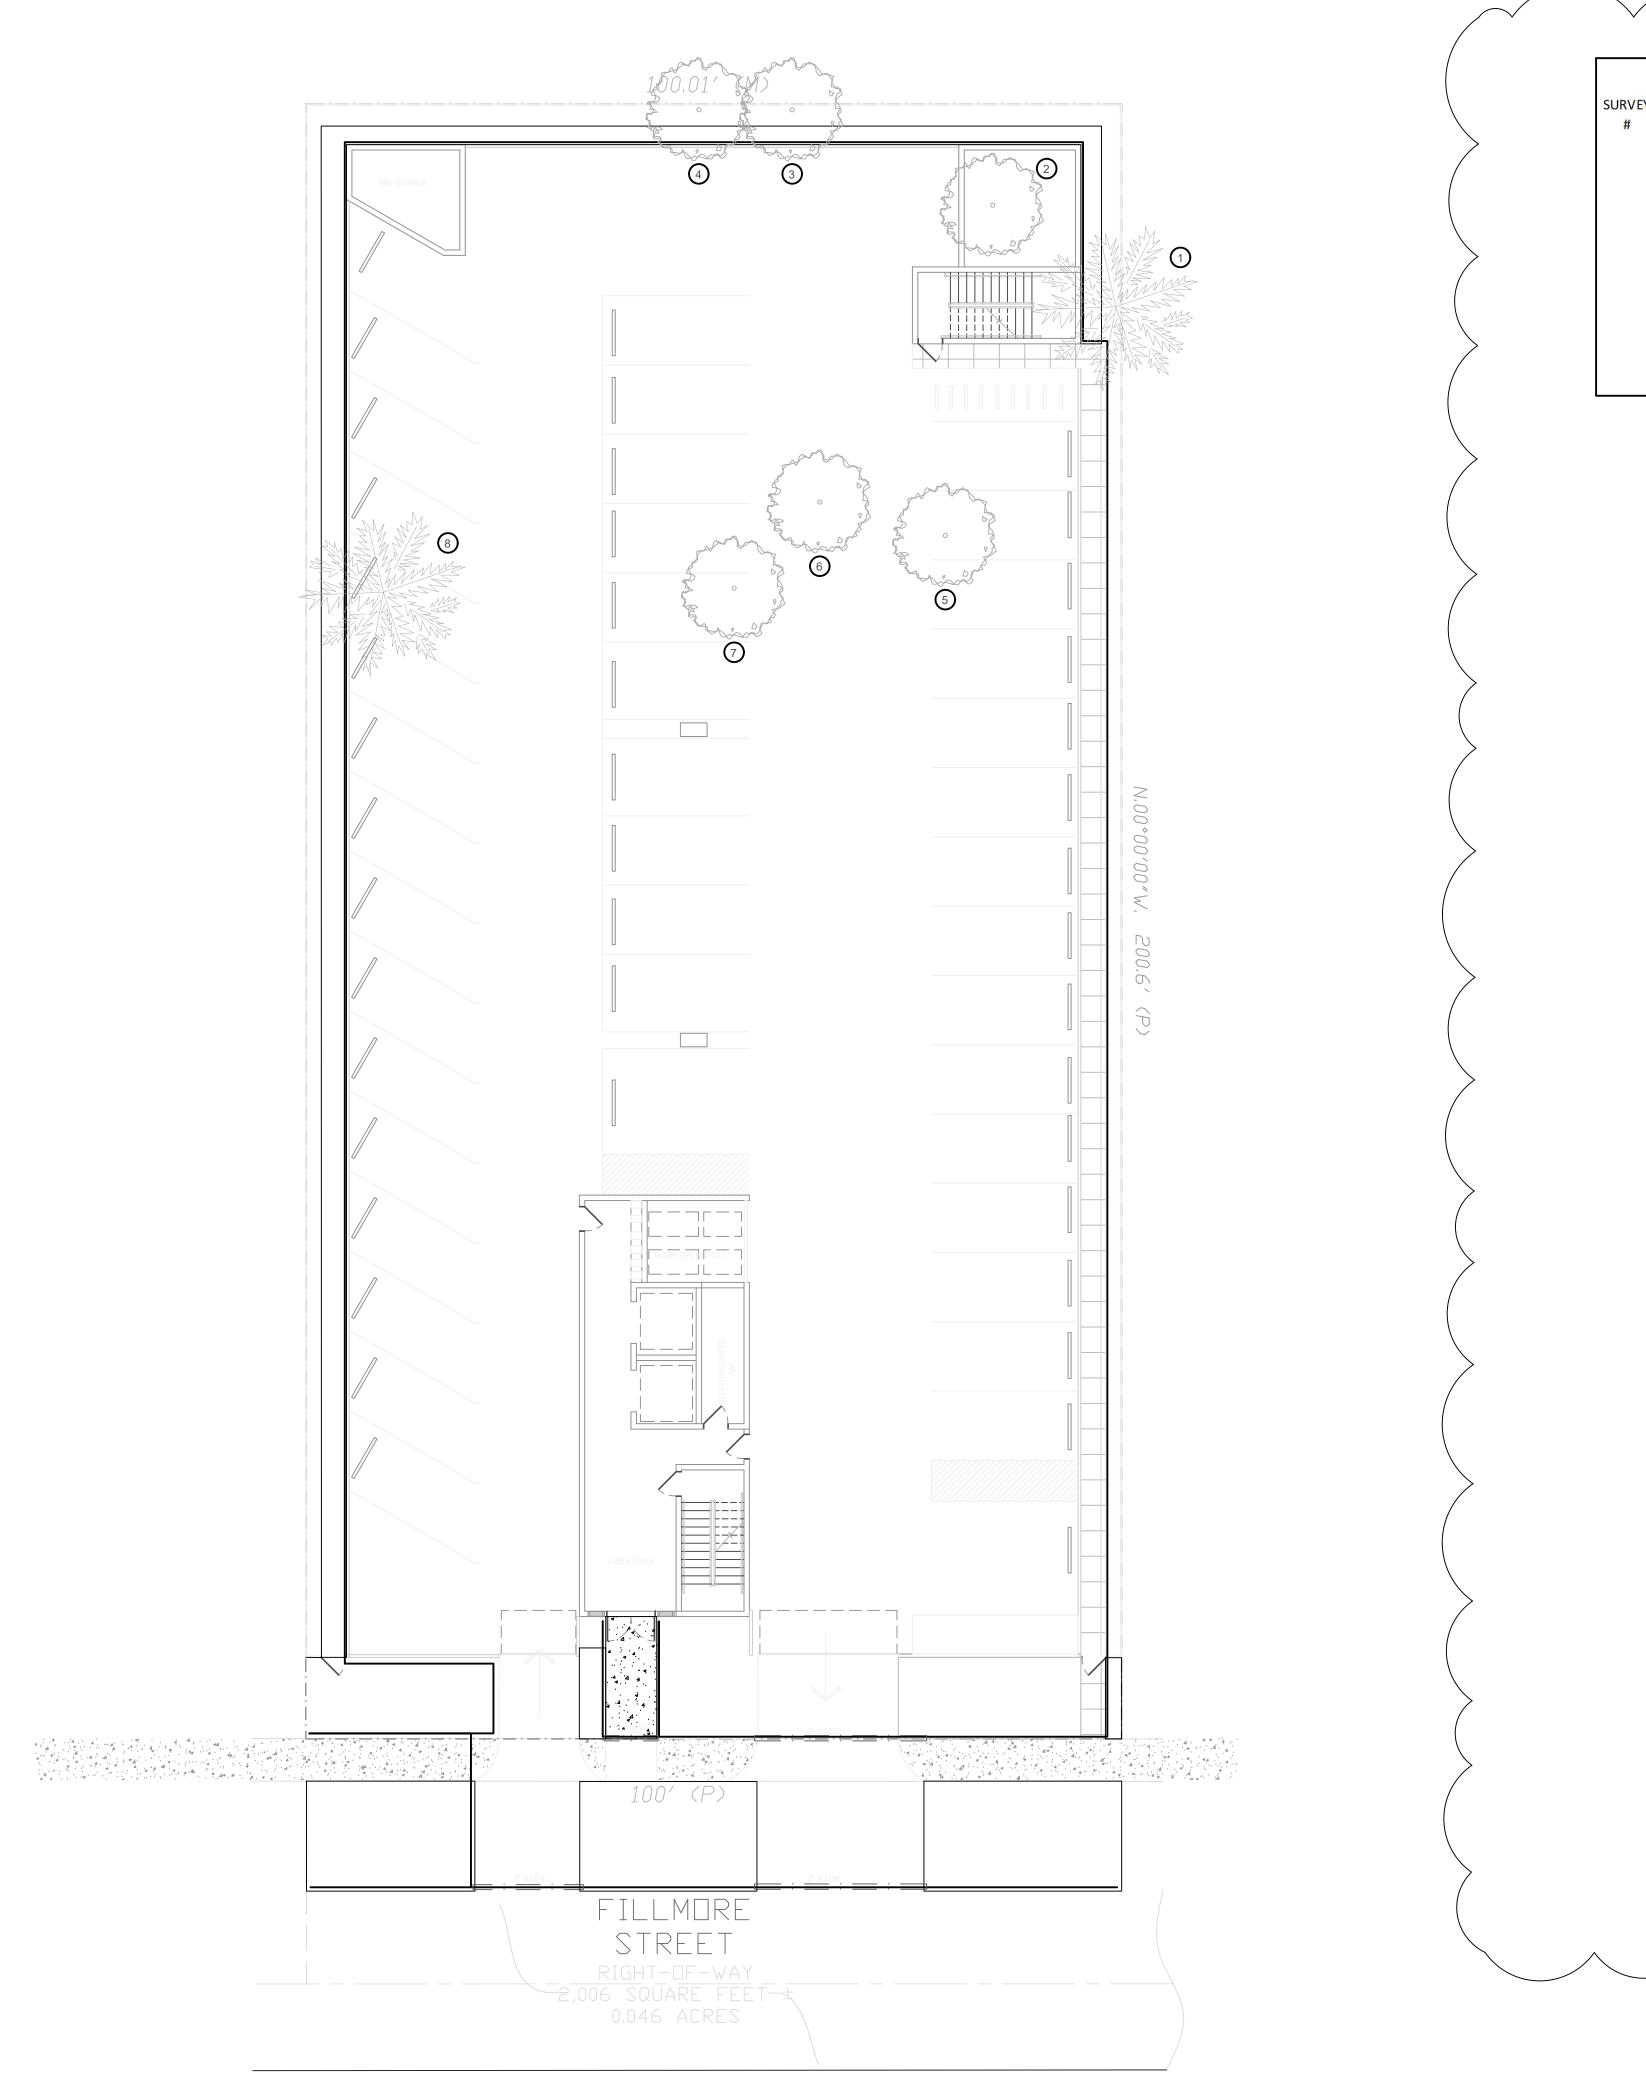

JRVEY #	KEY	COMMON NAME	BOTANTICAL NAME	DIAMETER (INCHES)	HEIGHT (FT)	SPREAD (FT)	CANOPY (S.F.)	CLEAR TRUNK (FT)	CONDITION (%)	DISPOSITION	COMMENT	MITIGATIO
	1	Sabal Palm	Sabal palmetto	10	12	10	78.5	4	Fair	Remove	Undersize	
	2	Mango	Mangifera indica	7	25	16	201.0		58%	Remove		7" Calipe
	3	Carrotwood	Cupaniopsis anacardioid	les						Remove	Invasive	
	4	Weeping Fig	Ficus benjamina	24	40	25	490.6		47%	Remove		24" Calipe
	5	Brazilian pepper	Schinus terebinthifolia				0.0			Remove	Invasive	
	6	Womens Tongue	Albizia lebbeck							Remove	Invasive	
	7	Norfolk Island Pine	Araucaria heterophylla	19	50	18	254.3		50%	Remove	Invasive	
	8	Coconut Palm	Cocos nucifera	9	30	20	314.0	18	Good	Remove		1 Palm


Total Mitigation to be 31 Caliper inches and 1 Palm

TREE PROTECTION

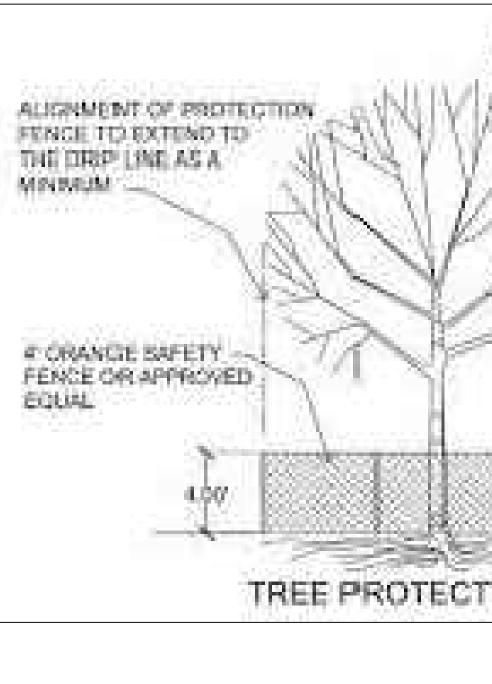


NO GRADING, STORAGE, PARKING OR ANY OTHER CONTRUCTION ACTIVITY WITHIN THE PROTECTION FENCE TO BE SAVED CRIPLINE OR APPROVED EDUAL EXISTING GRADE WITHIN FENCE TO REMAIN TREE PROTECTION DETAIL Note: All undeveloped portions of a parcel of land shall be left undisturbed or planted with ground cover or lawn as to leave no exposed soil in order to prevent dust or soil erosion.

MULTI-FAMILY DEVELOPMENT MULTI-FAMILY DEVELOPMENT MULTI-FAMILY DEVELOPMENT 2306 FILLMORE STEET A132 SW 51 ST Dania Beach FI 33314 Dania Beach FI 33314 Dania Beach FI 33314	MULTI-FAMILY DEVELOPMENT MULTI-FAMILY DEVELOPMENT 2306 FILLMORE STEET Hollywood FL Dania Beach Fl Dania F	A REVISION / DATE A 2/4/2023
DRAWN BY: CHECKED BY: JOB NUMBER: 2306_	DRAWN BY: CHECKED BY: JOB NUMBER: 2306_ DATE: 4/7/2023	SW 51 each Fl
BITTE: HITTEDED	N SCALE 3/32"=1'	DRAWN BY: CHECKED BY: JOB NUMBER: 2306_

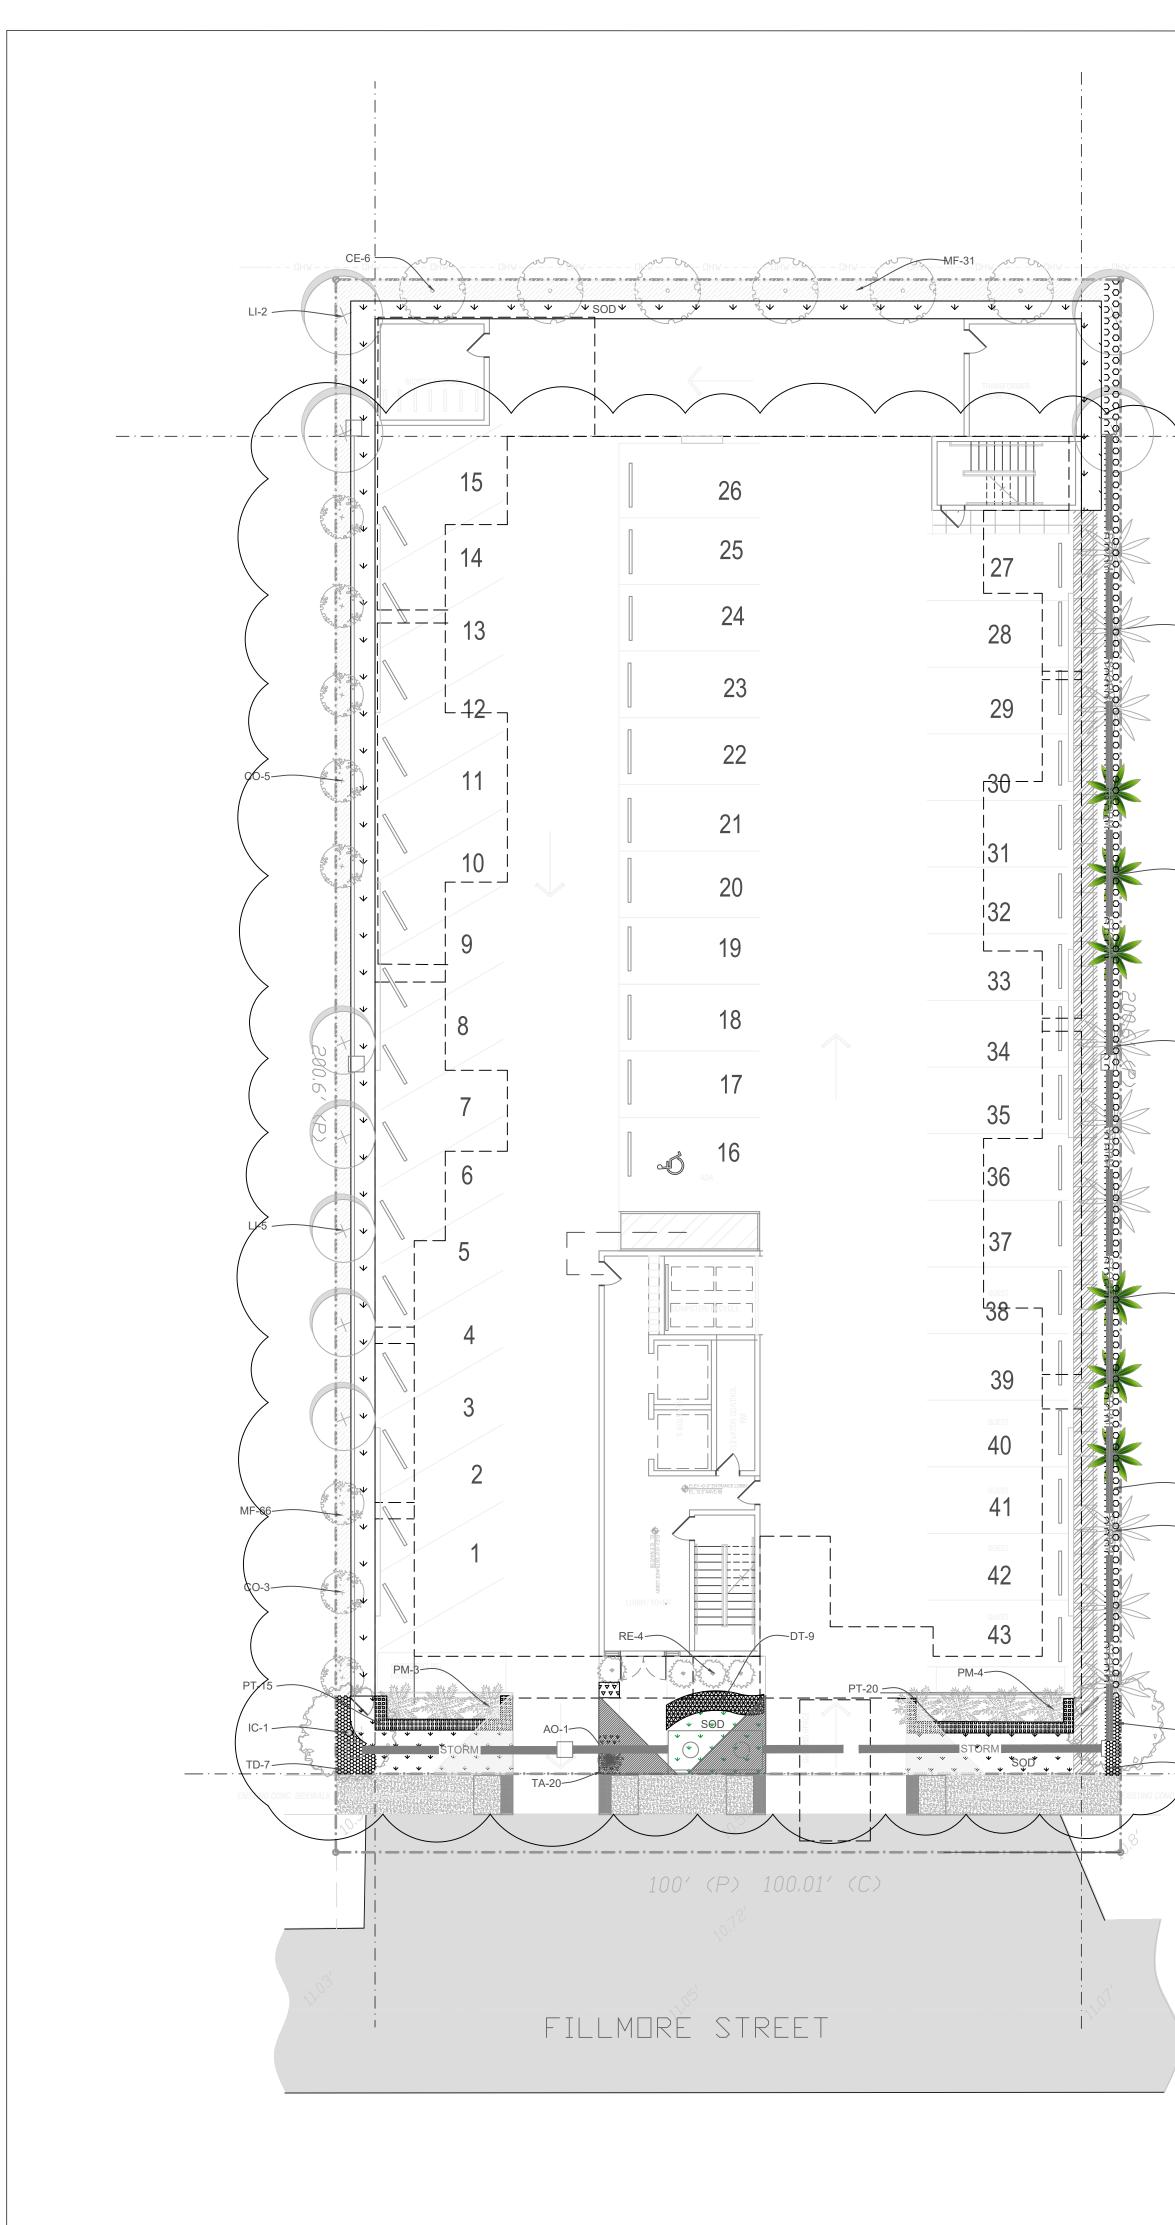

LI-2


____ · ___ · ___ · ___ · ___ · ___

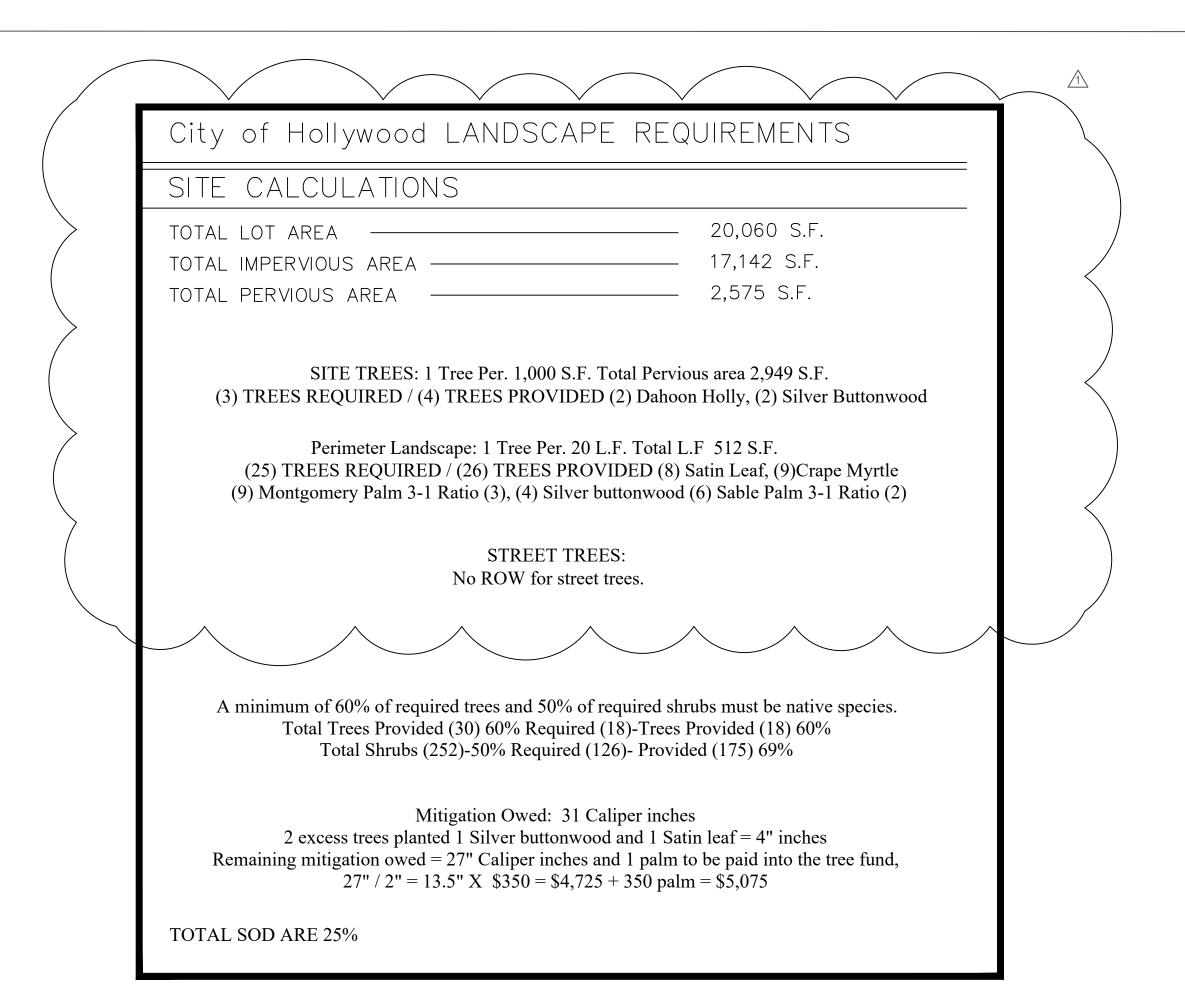

SYMBOL	NAME	COMMON NAME	SPECIFICATIONS	NATIVE	QUAN	Drought Tolerant
CE	Conocarpus erectus	Silver Buttonwood	12' HT. 6' SPR. MIN. 2" DBH FL-1	Yes	6	Low
IC	llex cassine	Dahoon holly	14' HT. 8' SPR. MIN. 2" DBH FL-1	Yes	2	Low
СО	Chrysophyllum oliuiforme	Stainleaf	14' HT. 8' SPR. MIN. 2" DBH FL-1	Yes	8	Low
LI	Lagerstroemia indica "muskogee"	Crepe myrtle	14' HT. 8' SPR. MIN. 2" DBH FL-1	Yes	9	Low
VA	Veitchia arecina	Montgomery palm	14' HT. Min. 6' CT. FL-1	No	9	Low
SB	Sabal palmetto	Sable palm	14' HT. Min. 6' CT. FL-1	Yes	6	Low
			Groundcover	-		
RE	Rhapis excelsa	Shrubs and	Groundcover	No	4	Medium
RE MF			1	No Yes	4 97	Medium Low
	Rhapis excelsa	Lady Palm	24" HT X 24" Sprd. 24" O.C.			
MF	Rhapis excelsa Myrcianthes fragrans	Lady Palm Simpson Stopper	24" HT X 24" Sprd. 24" O.C. 36" HT. X 18" SPR., 36" O.C.	Yes	97	Low
MF TD	Rhapis excelsa Myrcianthes fragrans Tripsacum dactyloides	Lady Palm Simpson Stopper Dwarf fakahatchee grass	24" HT X 24" Sprd. 24" O.C. 36" HT. X 18" SPR., 36" O.C. 18" HT X 14" Sprd. 24" O.C.	Yes	97 12	Low Low
MF TD PT	Rhapis excelsa Myrcianthes fragrans Tripsacum dactyloides Pittosporum tobira	Lady Palm Simpson Stopper Dwarf fakahatchee grass Variegated pittosporum	24" HT X 24" Sprd. 24" O.C. 36" HT. X 18" SPR., 36" O.C. 18" HT X 14" Sprd. 24" O.C. 15" HT. X 18" SPR., 24" O.C.	Yes Yes No	97 12 35	Low Low Medium
MF TD PT AO	Rhapis excelsa Myrcianthes fragrans Tripsacum dactyloides Pittosporum tobira Alcantarea odorata	Lady Palm Simpson Stopper Dwarf fakahatchee grass Variegated pittosporum Odorata	24" HT X 24" Sprd. 24" O.C. 36" HT. X 18" SPR., 36" O.C. 18" HT X 14" Sprd. 24" O.C. 15" HT. X 18" SPR., 24" O.C. 24" HT X 24" Sprd.	Yes Yes No No	97 12 35 1	Low Low Medium Medium
MF TD PT AO DT T	Rhapis excelsa Myrcianthes fragrans Tripsacum dactyloides Pittosporum tobira Alcantarea odorata Dianella tasmanica	Lady Palm Simpson Stopper Dwarf fakahatchee grass Variegated pittosporum Odorata Flax Lily	24" HT X 24" Sprd. 24" O.C. 36" HT. X 18" SPR., 36" O.C. 18" HT X 14" Sprd. 24" O.C. 15" HT. X 18" SPR., 24" O.C. 24" HT X 24" Sprd. 12" HT X 12" SPRD.	Yes Yes No No	97 12 35 1 9	Low Low Medium Medium Medium

NOTE: 2" OF SOIL SHALL BE ADDED UNDER ALL SOD



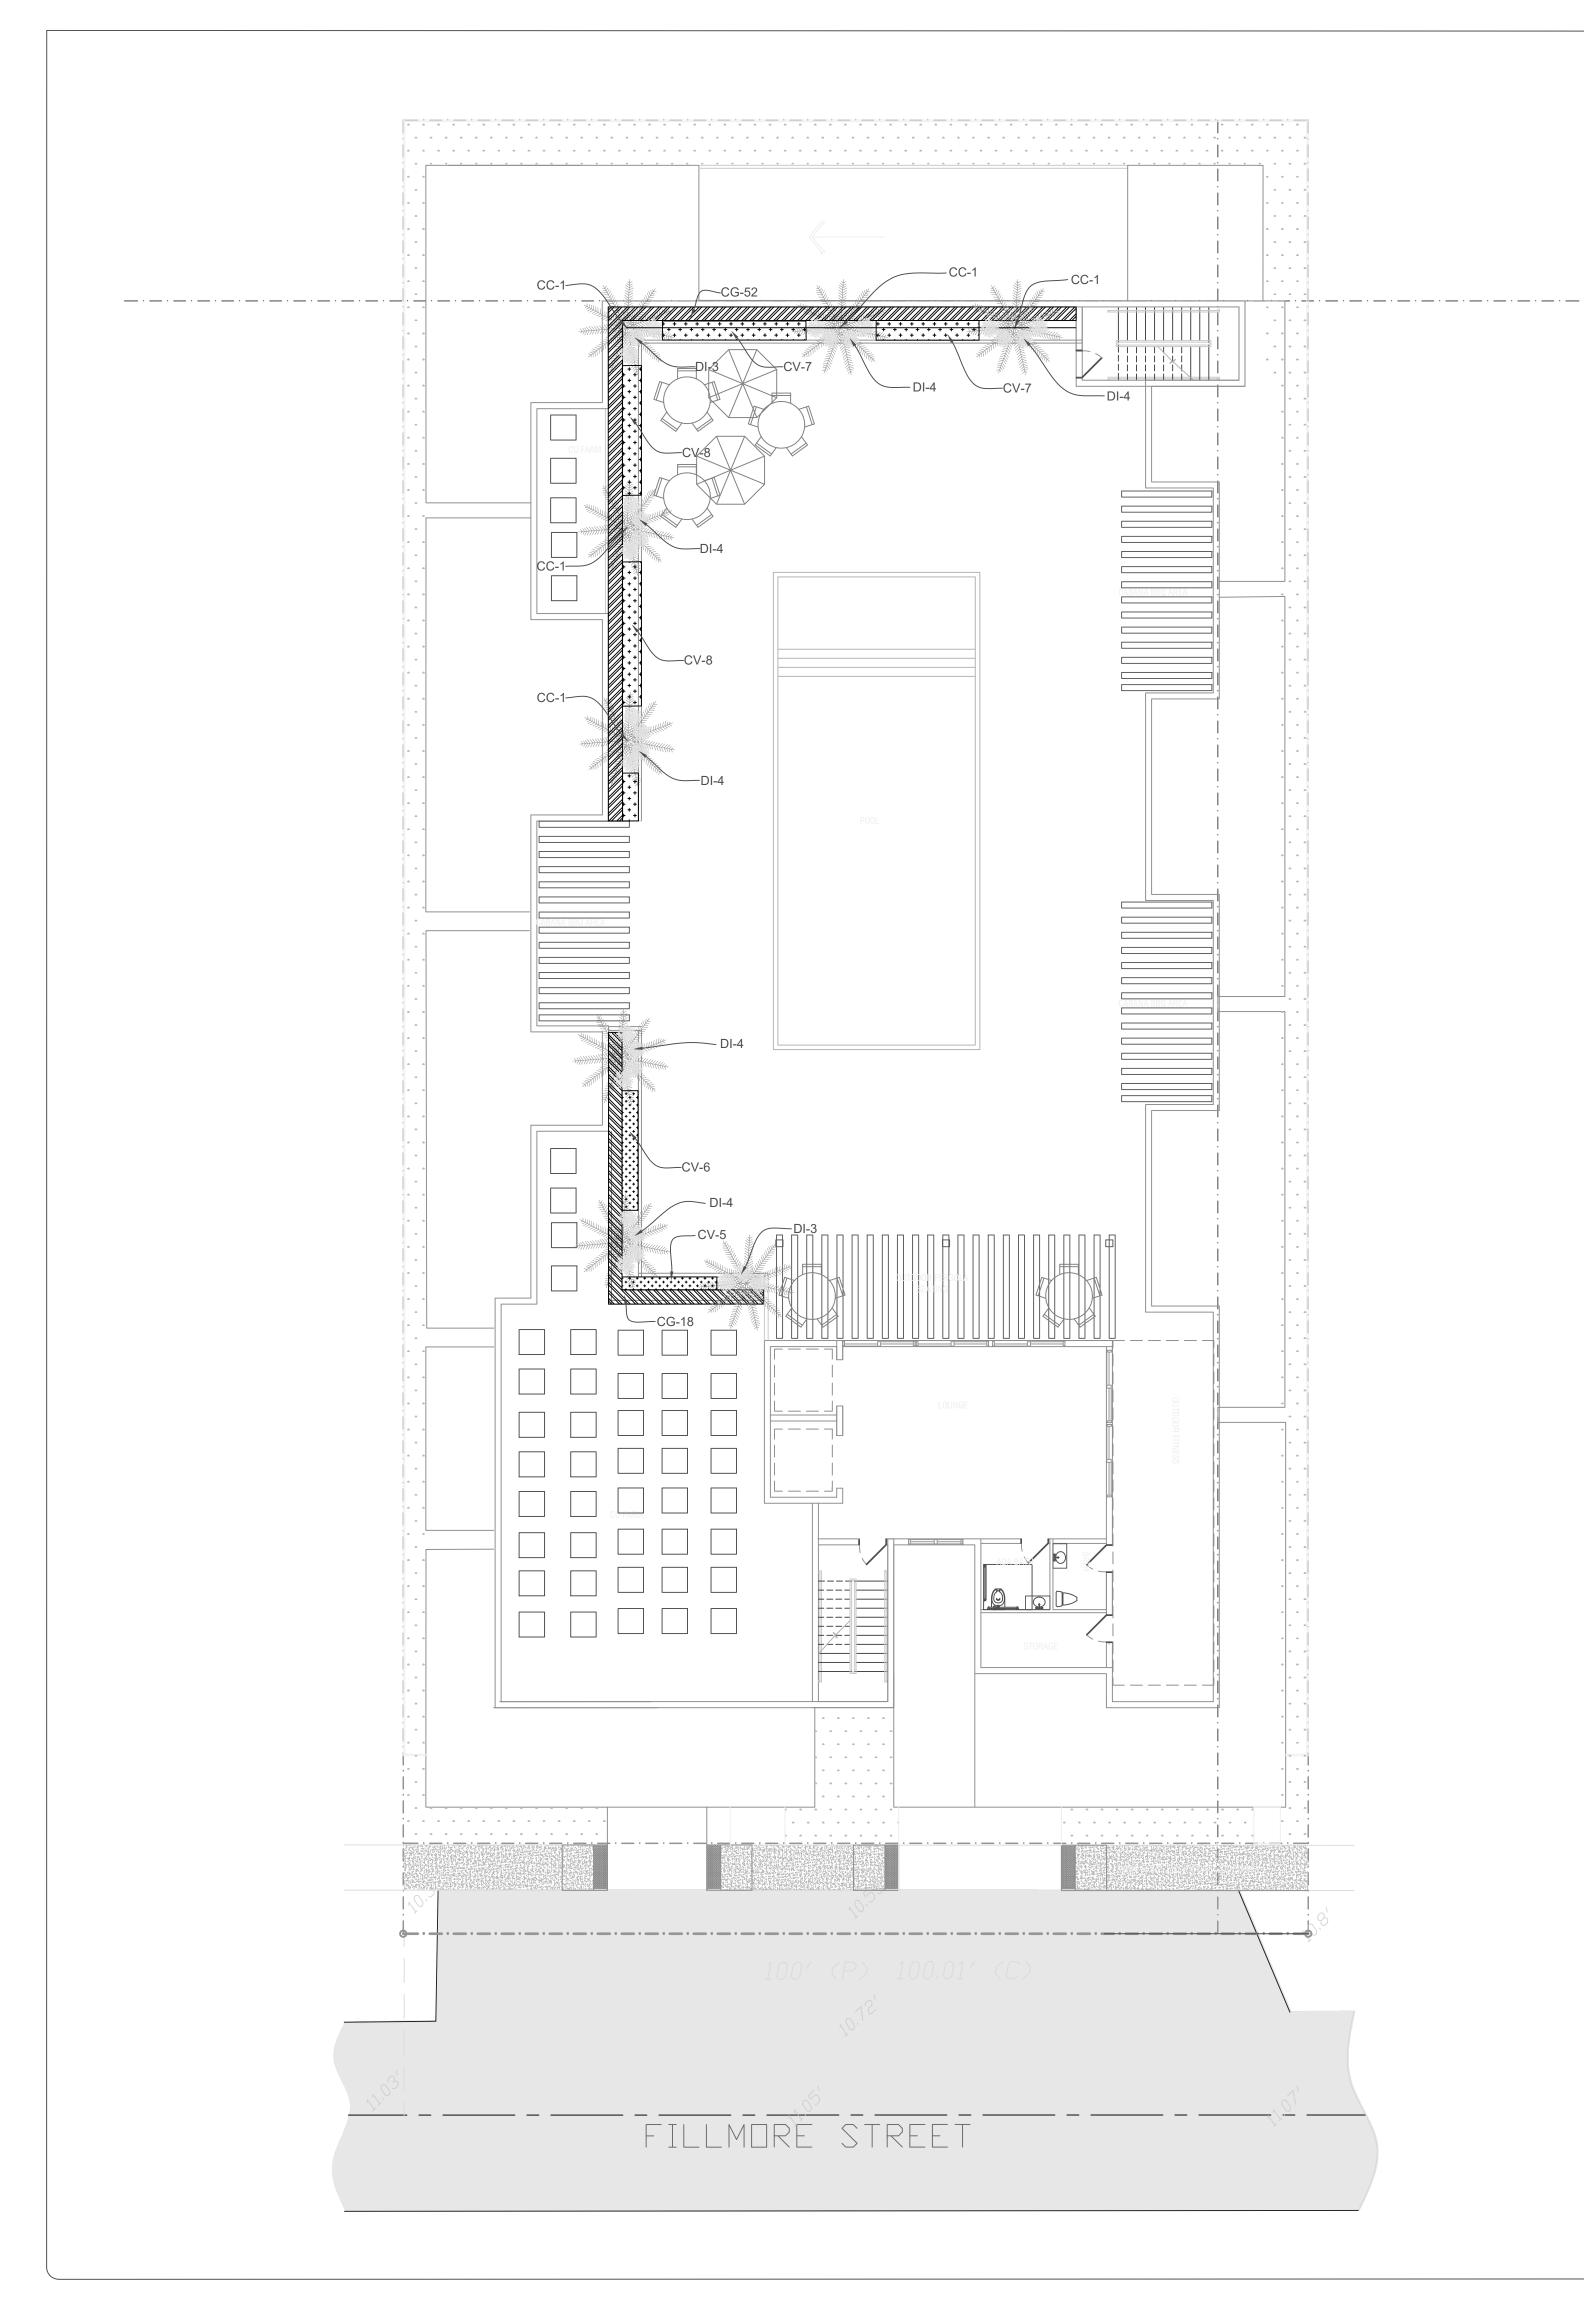

1 NUMBER XX SYMBO		ANT MATERIA	L SCHEDULE			
SYMBOL	NAME	COMMON NAME	SPECIFICATIONS	NATIVE	QUAN	Drought Toleran
CC	Coccothrinax	Florida silver palm	6' OA	Yes	8	Low
		Shrubs and	Groundcover			
			Groundcover		 	
DI	Dietes iridioides	Shrubs and African iris	Groundcover	No	30	Medium
DI			· · · · · · · · · · · · · · · · · · ·	No	30 41	Medium Medium



GENERAL PLANTING REQUIREMENTS

1-All sizes shown for plant material on the plans are to be considered Minimum.

2-All plant material must meet or exceed these minimum requirements for both height and spread. Any other requirements for specific shape or effect as noted on the plan(s) will also be required for final acceptance.

3-All plant material furnished by the landscape contractor shall be Florida #1 or better as established by "Grades and Standards for Florida Nursery Plants" and "Grades and Standards for Florida Nursery Trees".

4-All material shall be installed as per CSI specifications. All plant material as included herein shall be warranted by the landscape contractor for a minimum period as follows: All trees and palms for 12 months, all shrubs, vines, groundcovers and miscellaneous planting materials for 90 days, and all lawn areas for 60 days after final acceptance by the owner or owner's representative.

5-All plant material shall be planted in planting soil that is delivered to the site in a clean loose and friable condition. All soil shall have a well-drained characteristic. Soil must be free of all rocks, sticks, and objectionable material including weeds and weed seeds as per CSI specifications. Twelve inches (12") of planting soil 50/50 sand/topsoil mix is required around and beneath the root ball of all trees and palms, and 1 cubic yard per 50 bedding or groundcover plants.

6-All landscape areas shall be covered with Eucalyptus or sterilized seed free Melaleuca mulch to a minimum depth of three inches (3") of cover when settled. Cypress bark mulch shall not be used.

7-All plant material shall be thoroughly watered in at the time of planting; no dry planting permitted. All plant materials shall be planted such that the top of the plant ball is flush with the surrounding grade.

8-All landscape and lawn areas shall be irrigated by a fully automatic sprinkler system adjusted to provide 100% coverage of all landscape areas. All heads shall be adjusted to 100% overlap as per manufacturers specifications and performance standards utilizing a rust free water source.

9-Each system shall be installed with a rain sensor.

10-It is the sole responsibility of the landscape contractor to insure that all new plantings receive adequate water during the installation and during all plant warranty periods.

11-Deep watering of all new trees and palms and any supplemental watering that may be required to augment natural rainfall and site irrigation is mandatory to insure proper plant development and shall be provided as a part of this contract.

12-All plant material shall be installed with fertilizer, which shall be State approved as a complete fertilizer containing the required minimum of trace elements in addition to N-P-K, of which 50% of the nitrogen shall be derived from an organic source as per CSI specifications.

13-Contractors are responsible for coordinating with the owners and appropriate public agencies to assist in locating and verifying all underground utilities prior to excavation.

14-All ideas, designs and plans indicated or represented by this drawing are owned by and are the exclusive property of landscape Architect

15-The plan takes precedence over the plant list.

SPECIAL INSTRUCTIONS

General site and berm grading to +/- 1 inch (1") shall be provided by the general contractor. All finished site grading and final decorative berm shaping shall be provided by the landscape contractor.

All sod areas as indicated on the planting plan shall receive Stenotaphrum secundatum, St. Augustine 'Palmetto' solid sod. It shall be the responsibility of the landscape contractor to include in the bid, the repair of any sod which may be damaged from the landscape installation operations.

TREE RELOCATION

1) ROOT PREPARATION

- A. Trees to be root pruned with clean, sharp equipment.
- 1. Maintain root pruned materials by watering, weeding, mowing, spraying,

fertilizing, and other horticulture practices.

2. After root pruning, backfill with good rooting medium, fertilize with organic

fertilizer to promote root growth.

3. Mulch to reduce weeds, discourage foot traffic, conserve moisture, and minimize

temperature fluctuation.

B. Root Ball Size Chart: Root ball sizes shall be according to minimum standards

set forth in Grades and Standards for Nursery Plants Part II, Palms and Trees,

Florida Department of Agriculture.

DBH Minimum Ball Diameter 1. Trees-Minimum Ball Sizes:

3-1/2" to 4" 28"


4" to 4-1/2" 30"

4-1/2" to 5" 32"

5" to 5-1/2" 34"

Larger sizes increase proportionally.



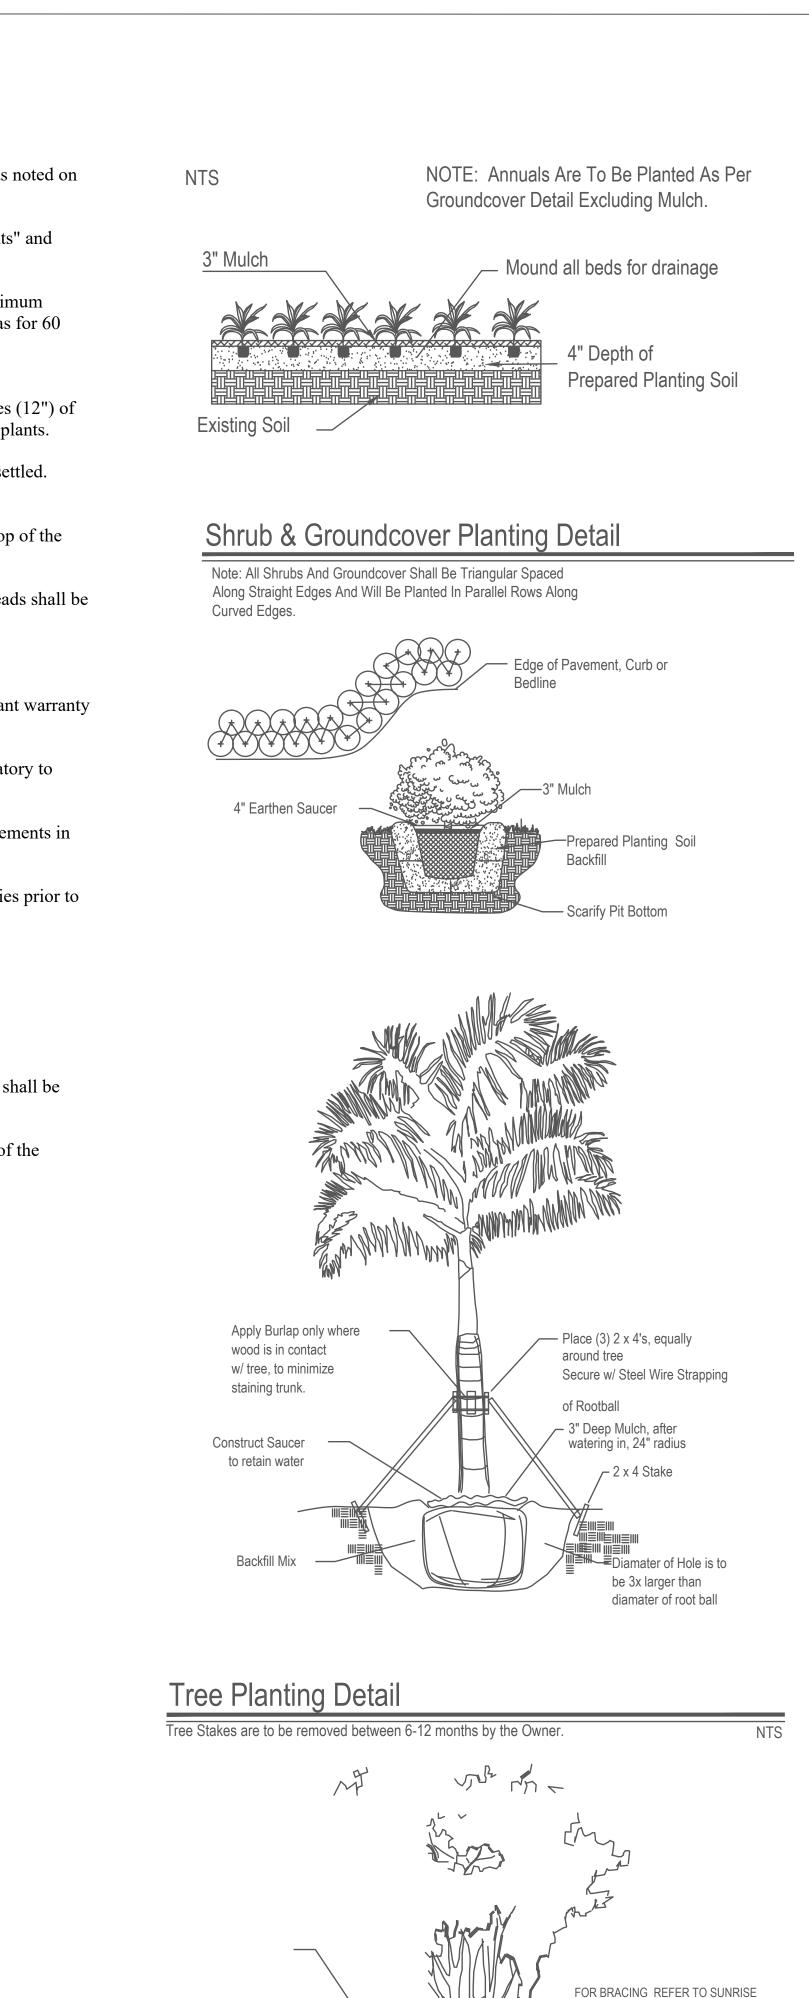

All Plants shall be Florida No.1 or better. Landscape Contractor shall review plans and indicate any availability problems at time of bid. Landscape contractor shall be responsible bidding and installing all plantings as they are drawn on the plan, and shall verify the accuracy of the plant list vs the drawn plan, at the time of bid. In the event that a certain specification is not able to be met, then contractor shall contact landscape architect to discuss alternatives. Contractor shall be familiar w/ the City of Hollywood, FLORIDA landscape code and shall comply with all of its applicable requirements. Contractor shall verify all quantities indicated at time of bid. Contractor shall provide unit prices at time of bid. 6. All contractors working on the project shall be licensed and fully insured as required. The Property Owner is responsible for replacement of all dead plant material & for maintenance of the required irrigation system. Tree and palm staking shall be removed between 6 and 12 months. All prohibited exotic vegetation shall be removed from the site and it shall be 10. maintained free of exotics in perpetuity. 11. The review and approval of improvement plans does not authorize the construction of required improvements which are inconsistent w/ existing easements of record. Contractor to verify underground utilities with "Sunshine State One Call of 12. Florida" 800-432-4770. Contractor to verify property lines and setbacks before construction. 13. Contractor must have property lines staked and located, and must verify plan dimensions and field conditions are consistent. All plant, trees, and palms shall be for guarantee 1 Year Warranty period 15. begins at the time of project acceptance by the owner. Irrigation Note: Per Article 9: 9.4(4): Irrigation. All landscaped areas shall 16. receive 100% coverage by means of an automatic sprinkler system designed and constructed in accordance with the City of Hollywood Code of Ordinances, the Florida Building Code, State Law, and the regulations of the South Florida Water Management District. Failure to maintain or disconnection of the irrigation system shall be a violation of these regulations. Contractor shall maintain all plant material and beds must be kept weed free until accepted by owner.

18. 19. Broward County. 20. 23. 24. 25 be used in a 3" consistent layer in all planting beds.

26. line visibility.

This plan has been designed to meet the tree planting requirements 27. contained within the FPL document entitled 'Plant the Right Tree in the

For existing or proposed utilities, no tree shall be planted where it could, at 28. mature height conflict with overhead power lines.

29. line visibility.

TRAPPING METHOD DETAIL

24" Radius. Mulch

than diameter of root ball

- Diameter of hole is to be 50% larger

Backfill mix

3" thick.

Contractor shall maintain site in a clean fashion and shall remove any waste created by landscape installation construction.

All plant materials to be installed and maintained as per City of Hollywood and

General/Site contractor shall make certain that all soil for planting areas shall be of suitable landscape quality fill. Soil shall be comprised of a sandy base, and have good organic and good percolation qualities.

General/Site contractor shall make certain all limerock and excessively compacted soils shall be removed from planting beds.

Landscape Contractor shall make certain that the site conditions meet to their satisfaction before installing plant material.

If Landscape Contractor has any concerns over the survivability of plant materials, he must inform the owner immediately.

All slopes steeper than 4:1 shall be planted with native vegetation No Cypress Mulch is to be used on site. Eucalyptus or Melaleuca Mulch is to

Landscape adjacent to vehicular traffic to be maintained to preserve sight

Right Place' and City of Hollywood Landscape Manual.

Landscape adjacent to vehicular traffic to be maintained to preserve sight





February 22, 2023

Agustina Maria Sklar AMS Architecture and Design Corporation 6000 North Ocean Drive, Unit 3N Hollywood, Florida 33019 Via Email Only

Dear Ms. Sklar:

Re: Platting requirements for a parcel legally described as Lot 16, Block 9, "Hollywood Little Ranches," according to the Plat thereof, as recorded in Plat Book 1, Page 26, of the Public Records of Broward County, Florida. This parcel is generally located on the south side of Fillmore Street, between North 24 Avenue and Dixie Highway, in the City of Hollywood.

This letter is in response to your correspondence regarding the Broward County Land Use Plan's platting requirements for a proposed multi-family residential development on the above referenced parcel.

Planning Council staff has determined that replatting <u>would not be required</u> by Policy 2.13.1 of the Broward County Land Use Plan (BCLUP) for the proposed development, subject to compliance with any applicable Broward County Trafficways Plan requirement.

As per the criteria of Policy 2.13.1, replatting is required for the issuance of building permits when constructing a non-residential or unified residential development, unless all of the following conditions are met:

- a. The lot or parcel is smaller than 10 acres and is unrelated to any adjacent development;
- b. The lot or parcel has been specifically delineated in a recorded plat;
- c. All land within the lot or parcel which is necessary to comply with the County Trafficways Plan has been conveyed to the public by deed or easement; and
- d. The proposed development is in compliance with the applicable land development regulations.

The subject parcel is less than 10 acres (approximately 0.46 acres) and meets the specifically delineated requirement. This platting interpretation is subject to the municipality finding that the proposed development is unrelated to any adjacent development, as noted in "a." above.

Agustina Maria Sklar February 22, 2023 Page Two

Some jurisdictions may be more restrictive and require platting in more situations than the BCLUP. The City of Hollywood's platting requirements should be investigated.

The contents of this letter are not a judgment as to whether this development proposal complies with State or local vehicular access provisions, the Broward County Trafficways Plan, permitted uses and densities, local zoning, the land development regulations of the municipality or the development review requirements of the BCLUP, including concurrency requirements.

If you have any additional questions concerning the BCLUP's platting requirements, please contact Julie M. Bernal at your convenience.

Respectfully,

Barbara Blake Boy Executive Director

BBB:JMB

cc/email: Dr. Wazir Ishmael, City Manager City of Hollywood

> Shiv Newaldass, Director, Development Services City of Hollywood

