
PLANNING DIVISION



2600 Hollywood Boulevard Room 315 Hollywood, FL 33022 File No. (internal use only):__

GENERAL APPLICATION

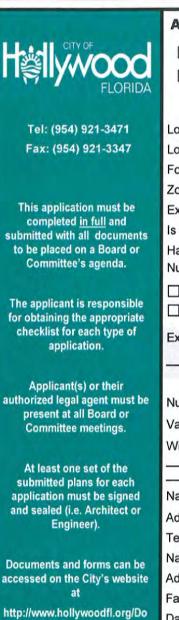

cumentCenter/Home/View/21

Tachnical Advisory Committee	V Historia Proponyation Board
☐ Technical Advisory Committee	X Historic Preservation Board Reprine and Development Board Reprine and Development Board Reprine and Development Board
City Commission	☐ Planning and Development Board
Date of Application: 03.05.18	
Location Address: 2740 N. Surf Rd., Ho	
Lot(s): 3 Block(s):	3 Subdivision: Hollywood beach 2nd a
Folio Number(s): 51-42-12-02-0473	
Zoning Classification: BWK-25-HD-R	
Existing Property Use: residential	Sq Ft/Number of Units: 3,059sf a/c - 3br.
	ce? () Yes (x) No If yes, attach a copy of violation.
Has this property been presented to the Number(s) and Resolution(s):	City before? If yes, check al that apply and provide File
☐ Economic Roundtable ☐ Technical	Advisory Committee
☐ City Commission ☐ Planning	and Development
Explanation of Request:previously sul	bmitted for permit/ never submitted to historic board.
Number of units/rooms: 2 bedrooms	Sg Ft: 3,059sf a/c
Number of units/rooms: 2 bedrooms Value of Improvement: \$722,000.00	Sq Ft: 3,059sf a/c Estimated Date of Completion: 12/01/18
Number of units/rooms: 2 bedrooms Value of Improvement: \$722,000.00 Will Project be Phased? () Yes (x)No	Sq Ft: 3,059sf a/c Estimated Date of Completion: 12/01/18 If Phased, Estimated Completion of Each Phase
Value of Improvement: \$722,000.00 Will Project be Phased? () Yes (x)No Name of Current Property Owner: Trito:	Estimated Date of Completion:12/01/18 If Phased, Estimated Completion of Each Phase In II, LLC / Kristina Lawrence
Value of Improvement: \$722,000.00 Will Project be Phased? () Yes (x)No Name of Current Property Owner: Trito:	Estimated Date of Completion:12/01/18 If Phased, Estimated Completion of Each Phase In II, LLC / Kristina Lawrence
Value of Improvement: \$722,000.00 Will Project be Phased? () Yes (x)No Name of Current Property Owner: Trito: Address of Property Owner: 3389 Sherio	Estimated Date of Completion:12/01/18 If Phased, Estimated Completion of Each Phase In II, LLC / Kristina Lawrence Idan Street #558, Hollywood, FL 33021
Value of Improvement: \$722,000.00 Will Project be Phased? () Yes (x)No Name of Current Property Owner: Trito: Address of Property Owner: 3389 Sheric Telephone: Fax:	Estimated Date of Completion:12/01/18 If Phased, Estimated Completion of Each Phase In II, LLC / Kristina Lawrence Idan Street #558, Hollywood, FL 33021 Email Address:
Value of Improvement: \$722,000.00 Will Project be Phased? () Yes (x)No Name of Current Property Owner: Trito: Address of Property Owner: 3389 Sherio Telephone: Fax: Name of Consultant/Representative/Tena	Estimated Date of Completion:12/01/18 If Phased, Estimated Completion of Each Phase In II, LLC / Kristina Lawrence Idan Street #558, Hollywood, FL 33021 Email Address: Int (circle one):Randall Stofft Architects - Carlos Linare
Value of Improvement: \$722,000.00 Will Project be Phased? () Yes (x)No Name of Current Property Owner: Trito: Address of Property Owner: 3389 Sheric Telephone: Fax: Name of Consultant/Representative/Tena Address: 42 N swinton Avenue, Delray I	Estimated Date of Completion:
Value of Improvement: \$722,000.00 Will Project be Phased? () Yes (x)No Name of Current Property Owner: Trito: Address of Property Owner: 3389 Sheric Telephone: Fax: Name of Consultant/Representative/Tena Address: 42 N swinton Avenue, Delray Fax: Email Addres	Estimated Date of Completion:
Value of Improvement: \$722,000.00 Will Project be Phased? () Yes (x)No Name of Current Property Owner: Trito: Address of Property Owner: 3389 Sheric Telephone: Fax: Name of Consultant/Representative/Tena Address: 42 N swinton Avenue, Delray Fax: Email Addres	Estimated Date of Completion:
Value of Improvement: \$722,000.00 Will Project be Phased? () Yes (x)No Name of Current Property Owner: Trito: Address of Property Owner: 3389 Sheric Telephone: Fax: Name of Consultant/Representative/Tena Address: 42 N swinton Avenue, Delray H Fax: Email Address Date of Purchase: 07.01.16 Is the If Yes, Attach Copy of the Contract.	Estimated Date of Completion:
Value of Improvement: \$722,000.00 Will Project be Phased? () Yes (x)No Name of Current Property Owner: Trito: Address of Property Owner: 3389 Sheric Telephone: Fax: Name of Consultant/Representative/Tena Address: 42 N swinton Avenue, Delray H Fax: Email Address Date of Purchase: 07.01.16 Is the If Yes, Attach Copy of the Contract.	Estimated Date of Completion:

PLANNING DIVISION File No. (interval line only): GENERAL APPLICATION Hollywood, FL 33022

CERTIFICATION OF COMPLIANCE WITH APPLICABLE REGULATIONS

The applicant/owner(a) signature certifies that he/she has been made awars of the criteria, regulations and guidelines applicable to the request. This information can be obtained in Room 315 of City Hall or on our website at www.hollywoodll.org. The owner(s) further certifies that when required by applicable law, including but not limited to the City's Zoning and Land Development Regulations, they will post the site with a sign provided by the Office of Planning and Development Services. The owner(s) will photograph the sign the day of posting and submit photographs to the Office of Planning and Development Services as required by applicable law. Failure to post the sign will result in violation of State and Municipal Notification Requirements and Laws.

(I)(We) certify that (I) (we) understand and will comply with the provisions and regulations of the City's Zoning and Land Development Regulations, Design Guidelines, Design Guidelines for Historic Properties and City's Comprehensive Plan as they apply to this project. (I)(We) further certify that the above statements and drawings made on any paper or plans submitted herewith are true to the best of (my)(our) knowledge. (I)(We) understand that the application and attachments become part of the official public records of the City and are not returnable.

Signature of Current Owner.	Date: 3/1/18
PRINT NAME FRITANI II, LIC KRISHNA LA	HUTENE Date: 3/1/18
Signature of Consultant/Representative	Date
PRINT NAME Randall Stofft Architects - Carlos Li	nares Date: 03.01.18
Signature of Tenent.	Date:
PRINT NAME	Date
Current Owner Power of Attorney	
arm the current owner of the described real property and that I am aware of the Committee of the Land of the Committee of the Land of the	of the nature and effect the request for tade by the or I am bereby authorizing
Swom to and subscribed before me this day of Marrie 2018	Bignature of Current Owner
Notary Hubito	Kelly Paker
State of Florida	Print Nama
My Commission Expires: 1/10/22 (Check One) Personally known to me: ORP	roduced Identification

March 5th, 2018

Lawrence Renovation 2740 N. Surf Road Hollywood, FL

Lot 3, Block 3, HOLLYWOOD BEACH, SECOND ADDITION, according to the plat thereof, as recorded in Plat Book 4, Page 6, of the public records of Broward County, Florida.

Said lands situate, lying and being in the City of Hollywood Beach, Broward County, Florida and containing 3,305 square feet or 0.0759 acres, more or less.

LAWRENCE RENOVATION

2740 N. Surf road, Hollywood, FL

COLOR BOARD

Randall Stofft Architects



WINDOW FRAME COLOR (SILVERSTORM – PPG UC106685F)



STUCCO PAINT COLOR (BIG CHILL - SW7648)

Date:	03.05.18

LOT COVERAGE INFORMATION

If you are the applicant for a building permit for a SINGLE FAMILY RESIDENCE, please be aware that the following information is needed in order to process your request for any additions or accessory structures, including pools, decks, and the like:

1,_	3,305sf	SQUARE FEET OF YOUR LOT (length x width)
2	1,240sf ground level	_ SQUARE FEET OF YOUR HOUSE
3	697sf	SQUARE FEET OF ALL EXISTING IMPERVIOUS SURFACES (e.g. Driveways, walkways, decks, pools, storage sheds, etc.)
4	n/a	_ SQUARE FEET OF THE ADDITION, AND OR
5	102sf terrace	SQUARE FEET OF THE PROPOSED ACCESSORY STRUCTURES, DRIVEWAYS, PAVEMENT, DECKS, ETC.
6	2,039sf	TOTAL SQUARE FEET OF THE IMPERVIOUS AREA ON YOUR LOT (Add Nos. 2 + 3+ 4+ 5)
7	61.6%	PERCENTAGE OF IMPERVIOUS LOT COVERAGE (Divide No.6 by No. 1)

March 5th, 2018



City of Hollywood 2600 Hollywood Boulevard Hollywood, Florida 33020

Re:

2740 N. Surf Road Hollywood Hollywood, Florida Architect's Project #1701020

CRITERIA OF APPROPRIATENESS FOR DESIGN 2740 N. Surf Road

CRITERION: INTEGRITY OF LOCATION

ANALYSIS: The property is located in the Historic District of Hollywood at 2470 N. Surf Road, originally built in the mid-1980's it sits along mainly new single-family homes along Surf Road.

CRITERION: SETTING

ANALYSIS: The setting of the proposed Residence is typical to most of the homes in the Community. It is located on the East site of Surf Road in basically the center of the Block. The street is in line with sidewalks for pedestrian access to the homes, located between the street and boardwalks fronting the ocean.

CRITERION: MATERIALS

ANALYSIS: All materials used on the proposed New Single-Family Home will be authentic to the type of Contemporary Architecture with a modern twist, as well as durable to meet or exceed the requirements of the Florida Building code 2014.

CRITERION: WORKMANSHIP

ANALYSIS: Workmanship on the new proposed single-family home will be such that all State and Local laws are upheld. Proper Barricading will be done so that san is preserved on Site, Practices will meet or exceed requirements of Florida Building Code 2014 and the State of Florida Department of Environmental Protection.

Should you have any questions, please fell free to contact this office.

Sincerely

Randall E. Stofft Architects, PA

Carlos Linares
Project Manager

42 N. SWINTON AVENUE DELRAY BEACH, FLORIDA 33444 561-243-0799 - PHONE 561-243-0299 - FAX















PREPARED BY: Land Surveyors, Inc.


> www.exactaland.com Toll Free 866-735-1916 • F 866-744-2882





PROPERTY ADDRESS: 2740 N SURF ROAD HOLLYWOOD, FLORIDA 33019

SURVEY NUMBER: FL1606.1337

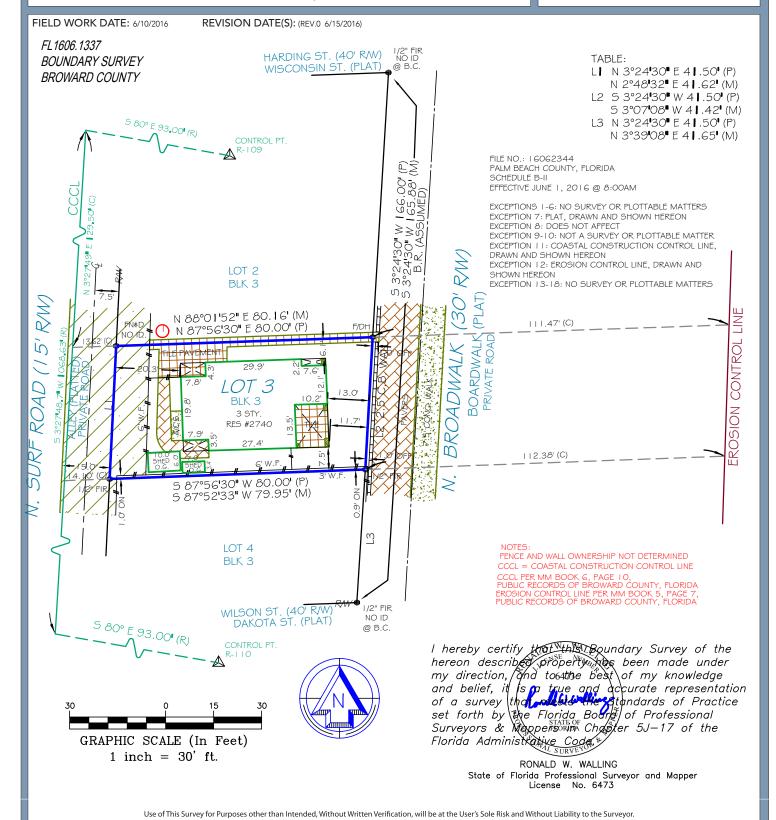

FLOOD INFORMATION:

BY PERFORMING A SEARCH WITH THE LOCAL GOVERNING MUNICIPALITY OR WWW.FEMA.GOV, THE PROPERTY APPEARS TO BE LOCATED IN ZONE VE (WITH A BASE FLOOD ELEVATION OF 11). THIS PROPERTY WAS FOUND IN THE CITY OF HOLLYWOOD, COMMUNITY NUMBER 125113, DATED 08/18/14.

CLIENT NUMBER: 1614.14

DATE: 6/15/2016

BUYER: TRITON II, LLC

SELLER: JEFFREY B. STRUTZ AND LINDA C. STRUTZ

CERTIFIED TO: TRITON II, LLC; ALEIDA ORS WALDMAN, P.A.; OLD REPUBLIC NATIONAL TITLE INSURANCE COMPANY

This is page 1 of 2 and is not valid without all pages.

POINTS OF INTEREST

Nothing hereon shall be Construed to Give ANY Rights or Benefits to Anyone Other than those Certified.

1 TILE PAVEMENT OVER PROPERTY LINE



AFFILIATE **MEMBERS**



www.exactaland.com

LB# 7337

P.866-735-1916 • F.866-744-2882 11940 Fairway Lakes Drive, Suite 1 • Ft. Myers, FL 33913

LEGAL DESCRIPTION:

LOT 3 OF BLOCK 3, OF HOLLYWOOD BEACH SECOND ADDITION, ACCORDING TO THE PLAT THEREOF, AS RECORDED IN PLAT BOOK 4, AT PAGE 6, OF THE PUBLIC RECORDS OF BROWARD COUNTY, FLORIDA, TOGETHER WITH ALL RIPARIAN RIGHTS, IF ANY.

JOB SPECIFIC SURVEYOR NOTES:

THE ASSUMED BEARING REFERENCE OF SOUTH 3 DEGREES 24 MINUTES 30 SECONDS WEST IS BASED ON THE WESTERLY RIGHT-OF-WAY LINE OF NORTH BROADWALK, LOCATED WITHIN HOLLYWOOD BEACH SECOND ADDITION, ACCORDING TO THE PLAT THEREOF, AS RECORDED IN PLAT BOOK 4, PAGE 6, OF THE PUBLIC RECORDS OF BROWARD COUNTY, FLORIDA.

GENERAL SURVEYOR NOTES:

- The Legal Description used to perform this survey was supplied by others. This survey does not determine or imply ownership.

 This survey only shows improvements found above ground. Underground footings, utilities and encroachments are not located on this survey map.

 If there is a septic tank, or drain field shown on this survey, the location is approximate as the location was either shown to Exacta by a third party or it was estimated by metal detection, probing rods, and visual above ground inspection only. No excavation was performed in order to determine the exact and accurate location.

 This survey is exclusively for the use of the parties to whom it is certified.
- Additions or deletions to this survey map and report by other than the signing party or parties is prohibited without written consent of the signing party or parties. Dimensions are in feet and decimals thereof.

 Due to varying construction standards, house dimensions are approximate.

 Any FEMA flood zone data contained on this survey is for informational purposes only. Research to obtain such data was performed at www.fema.gov.

 All corners marked as set are at a minimum a ½"diameter, 18" iron rebar with a cap stamped LB#7337.

- 9. All corners marked as set are at a minimum a ½ claimeter, 18 iron rebar with a cap stamped LBP/337.

 10. If you are reading this survey in an electronic format, the information contained on this document is only valid if this document is electronically signed as specified in Chapter 5J-17.062 (3) of the Florida Administrative Code and Florida Statute 472.025. The Electronic Signature File related to this document is prominently displayed on the invoice for this survey which is sent under separate cover. Manually signed and sealed logs of all survey signature files are kept in the office of the performing surveyor. If this document is in paper format, it is not valid without the signature and original raised seal of a Florida Licensed Surveyor.

 11. Unless otherwise noted, an examination of the abstract of title was NOT performed by the signing surveyor to determine which instruments, if any, are affecting this property.


- The symbols reflected in the legend and on this survey may have been enlarged or reduced for clarity. The symbols have been plotted at the center of the field location, and may not represent the actual shape or size of the feature.
 Points of Interest (POI's) are selected above-ground improvements which may be in conflict with boundary, building setback or easement lines, as defined by the parameters of this survey. There may be additional POI's which are not shown, not called-out as POI's, or which are otherwise unknown to the surveyor. These POI's may not represent all items of interest to the viewer.
- 14. Utilities shown on the subject property may or may not indicate the existence of recorded or unrecorded utility easements
- 15. The information contained on this survey has been performed exclusively, and is the sole responsibility, of Exacta Surveyors. Additional logo or references to third party firms are for informational purposes only.

 16. Pursuant to F.S. 558.0035, an individual employee or agent may not be held individually liable for negligence.

 17. House measurements should not be used for new construction or planning. Measurements should be verified prior to such activity.

LEGEND:

SURVEYOR'S LEGEND

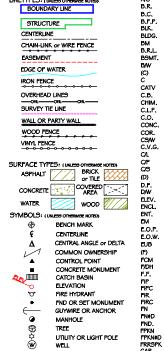

AIR CONDITIONING
BLASING REFERENCE
BLOCK CORNER
BACKFLOW PREVENTOR
BLOCK
BUILDING
BENCHMARK
BUILDING RESTRICTION LINE
BASEMENT
BAYBOX WINDOW
CALCULATED
CURVE
CALCULATED
CURVE
CABLE TV. RISER
CONCRETE BLOCK
CHIMINEY
CHAIN LINK FENCE
CLEAN OUT
CONCRETE
CONCRETE
CONCRETE
CONCRETE
SIDEWALK
CONCRETE SIDEWALK
CONCRETE SUDEWALK
CONCRETE SUDE FINISHED FLOOR
FOUND IRON PIPE
FOUND IRON PIPE \$ CAP
FOUND IRON ROD
FOUND IRON ROD \$ CAP
FOUND IRON ROD \$ CAP
FOUND ANIL \$ DISC
FOUND
FOUND FK NAIL \$ DISK
GARAGE
GAS METER

IDENTIFICATION
ILLEGIBLE
INSTRUMENT
INTERSECTION
LENGTH
LICENSE # - BUSINESS
LICENSE # - SURVEYOR
MEASURED
MAP BOOK LD# (M) M.E.S. M.F. N.T.S. O.C.S. OFF O.G. OFF P.E. C.C. P.F.C. P.F.F.C. P.F.C. P.F.F.C. P.F.F.F. P.F.F.F. P.F.F. P.F.F.F. P.F.F. MEASURED
MAP BOOK
MITERED END SECTION
METAL FENCE
NON RADIAL
NOT TO SCALE
ON CONCRETE SLAB
ON GROUND
OUTSIDE OF SUBJECT PARCEL
OVERHANG
OVERPHANG OUTSIDE OF SUBJECT PARCEL
OVERHAND
OVERHAND
OFFICIAL RECORD BOOK
OFFICIAL RECORD BOOK
OFFICIAL RECORD VOLUME
OVERALL
OFFISET
PLAT
PLAT BOOK
POINT OF CURVATURE
POINT OF CURVATURE
PERMANENT TO ONTROL POINT
FOOL EQUIPMENT
FACE
POINT OF MITTERSECTION
PROFESSIONAL LAND SURVEYOR
PLANTER
POINT OF REVERSE CURVATURE
PICHT OF COMMENCEMENT
PIONT OF REVERSE CURVATURE
PERMANENT REFERENCE MONUMENT
PROFESSIONAL SURVEYOR
AND MAPPER
POINT OF REVERSE CURVATURE
PERMANENT REFERENCE MONUMENT
PROFESSIONAL SURVEYOR
AND MAPPER
POINT OF TANGENCY
RADIUS OF RADIAL
RECORD P.T. R (R) RGE. RES. RAW (9) S.B.L. S.C.L. SCR, RECORD
RANGE
RESIDENCE
RIGHT OF WAY
SURVEY
SETBACK LINE
SURVEY CLOSURE LINE
SCREEN

SECTION
SETTIC TANK
SETWER
SET GULE DISC
SET IRON ROD & CAP
SET HANL & DISC
SQUARE FEET
STORY
SURVEY TIE LINE
SEWER VALVE
SIDEWALK
SEAWALL
TEMPORARY BENCHMARK
TELEPHONE FACILITIES
TOP OF BANK
TOWNSHIP
TRANSPORMER
TYPICAL
UTILITY RISER
WITNESS CORNER
WATER RILITER
WOODEN FENCE
WATER METERVALVE BOX
WATER VALVE
VINNI, FENCE SEP. SEW. S/GD SIRC SN4D SQ.FT.

ELECTRONIC SIGNATURE:

In complete accordance with Florida Statute 472.025 and Pursuant to the Electronic Signature Act of 1996 or Florida Statute TITLE XXXIX, Chapter 668, if this document was received electronically via PDF, then it has been lawfully Electronically Signed. Therefore, this survey PDF, if authentic, is completely official and insurable. In order to validate the "Electronic Signature" of PDF surveys sent via www.surveystars.com, you must use a hash calculator. A free hash calculator is available for download at:

In order to validate the Electronic Signature of any survey PDF sent via

Download the Hash Calculator available at: www.softpedia.com/get/System/File-Managen

www.softpedia.com/get/System/File-Management/Hash-Calculator-Kirill.shtml
2. Save the Survey PDF onto your computer from www.surveystars.com
or from the email sent from www.surveystars.com.
3. Click the square Browse button in the upper right hand corner of the
Hash Calculator to find and select the saved Survey PDF document, and click
the COMPUTE button in the lower right hand corner of the Hash Calculator.
4. Compare the 40 digit string of Gharacters in the SHA-1 line to the 40 digit
SHA-1 characters for the survey in the job file in www.surveystars.com which
is also printed on the invoice for that survey.

5. If the 40 digit string of SHA-1 characters are exactly the same on the invoice (or in the survey file at www.surveystars.com) as they are in the Hash Calculator, then this PDF is authentic. If the 40 digit string of characters does not match exactly, then this PDF has been tampered with and it is not authentic.

PRINTING INSTRUCTIONS:

- 1. While viewing the survey in Adobe Reader, select the "Print" button under the "File" tab.
- 2. Select a printer with legal sized paper
- 3. Under "Print Range", click select the "All" toggle.
- 4. Under the "Page Handling" section, select the number of copies that you would like to print.
- 5. Under the "Page Scaling" selection drop down menu, select "None."
- 6. Uncheck the "Auto Rotate and Center" checkbox.
- 7. Check the "Choose Paper size by PDF" checkbox.
- 8. Click OK to print

TO PRINT IN BLACK + WHITE:

- 1. In the main print screen, choose "Properties".
- 2. Choose "Quality" from the options.
- 3. Change from "Auto Color" or "Full Color" to "Grav Scale"

OFFER VALID ONLY FOR: TRITON II. LLC



Т



Exacta Land Surveyors, Inc.

PROJECT TEAM

42 NORTH SWINTON AVE., SUITE DELRAY BEACH, FLORIDA 33444 TEL: 561.243.0799 CONTACT: CARLOS LINARES EMAIL: CARLOS@STOFFT.COM

HOSE BIBB

UNISON STRUCTURAL DESIGN 2000 N. STATE ROAD 7, SUITE 200 MARGATE, FLORIDA 33063 TEL: 305.298.0467 CONTACT: KERVIN VENTURA EMAIL: KERVINVENTURA@HOTMAIL.COM

LAWRENCE RENOVATION



TWO STORY SINGLE FAMILY RESIDENCE FBC 2014 CHAPTER 3, GROUP R-3 OCCUPANCY TABLE 503 CONSTRUCTION TYPE V-B

WIND LOADS AS PER FBC 2014 EDITION

MAXIMUM ROOF HEIGHT

IMPACT RESISTANT ASSEMBLY

COMPONENT & CLADDING

IS A CONT. LOAD PATH PROVIDED

MEAN ROOF HEIGH

AND ANSI/ASCE 7-10 THE FOLLOWING DESIGN PARAMETERS ARE REPEATED FROM THE STRUCTURAL DRAWINGS (SEE STRUCTURAL PLANS FOR ADDITIONAL STRUCTURAL NOTES/DESIGN PARAMETERS)

CODE EDITION: FLORIDA BUILDING CODE 2014 **BUILDING DESIGNED AS:** ENCLOSED, RIGID WIND EXPOSURE CLASSIFICATION: WIND SPEED DESIGN: 170 mph INTERNAL PRESSURE COEFFICIENT +-0.18

BUILDING CATAGORY ROOF LIVE LOAD: TOP CHORD DEAD LOAD BOT CHORD DEAD LOAD 10 PSF FLOOR LIVE LOAD: 40 PSF FLOOR DEAD LOAD: SUPERIMPOSED MIN. SOIL BEARING PRESSURE

THE PROJECT WAS DESIGNED IN ACCORDANCE WITH THE BUILDING CODE REQUIREMENTS FOR INFORCED CONCRETE (ACI 318-11, 315-11, LRFD). AMERICAN INSTITUTE OF STEEL CONSTRUCTION) AISC LRFD 13th EDITION. BUILDING CODE REQUIREMENTS AND SPEC'S FOR MASONRY STRUCTURES (ACI 530-11/ASCE 5-05/TMS 402-11). BUILDING CODE REQUIREMENTS AND NATIONAL DESIGN SPECIFICATIONS FOR WOOD CONSTRUCTION

(ANSI/NFOPA NDS-2005, ASD, AF&PA).

Florida Building Code (FBC) 2014

National Electrical Code (NEC) 2011

44'-11"

THE SCOPE OF WORK FOR THIS PROJECT UNDER THE 2014 FLORIDA BUILDING CODE-EXISTING BUILDING, IS AN 'ALTERATION LEVEL 2' AS DEFINED IN CHAPTER 4, SECTION 404.1 & 402.2 AND MUST BE IN TOTAL COMPLIANCE AS OUTLINED BELOW

-ALL WORK SHALL CONFORM TO THE 2010 EDITION OF THE FLORIDA BUILDING CODE AND CONFORM TO 'EXISTING BUILDINGS' CHAPTER 4, SECTION 402: REPAIRS, SECTION 403: ALTERATIONS, SECTION 407:

-ADDITIONALLY, ALL WORK SHALL CONFORM TO THE PROVISIONS IN CHAPTER 4, SECTION 404: ALTERATION LEVEL 1, CHAPTERS 6 & 7 FOR LEVEL 1 & 2 ALTERATIONS AS WELL AS ANY AND ALL APPLICABLE FEDERAL AND LOCAL BUILDING CODES

ILL RESIDENTIAL CONSTRUCTION SHALL COMPLY WITH SEVEN VOLUMES OF THE FLORIDA BUILDING CODE 2014 EDITION. THE CODE IS COMPILED WITH THE LATEST EDITION OF THE NATIONAL ELECTRICAL CODE ADOPTED BY EFERENCE. THE NATIONAL ELECTRICAL CODE IS REFERENCED STANDARD NFPA-70. RESIDENTIAL POOL SAFETY ACT - CHAPTER 45 OF THE 2014 FBC RESIDENTIAL

. ALL DOORS AND WINDOWS PROVIDING DIRECT ACCESS FROM THE HOME TO THE POOL SHALL MEET THE REQUIREMENTS OF RESIDENTIAL POOL SAFETY ACT SECTION R4501.17.1.9.

. ALL DOORS PROVIDING DIRECT ACCESS FROM THE HOME TO THE POOL ARE TO BE SELF CLOSING AND SELF LATCHING. LATCH MECHANISM SHALL BE MOUNTED AT 54" A.F.F. (MIN).

. THE G.C. IS TO VERIFY THAT ALL ACCESS TO THE POOL AREA MEET THE SWIMMING POOL SAFETY ACT.

SCOPE OF WORK

CONSTRUCTION NOTES, SPECIFICATIONS AND GENERAL REQUIREMENTS

ARCHITECT'S STATUS:

A. THE ARCHITECT SHALL NOT BE RESPONSIBLE FOR AND WILL NOT HAVE CONTROL OR CHARGE OF CONSTRUCTION MEANS, METHODS, TECHNIQUES, SEQUENCES OR THE WORK, AND HE OR SHE WILL NOT BE RESPONSIBLE FOR THE CONTRACTOR'S FAILURE O CARRY OUT THE WORK IN ACCORDANCE WITH THE CONTRACT DOCUMENTS. THE ARCHITECT SHALL NOT BE RESPONSIBLE OR HAVE CONTROL OR CHARGE OVER THE ACTS OR OMISSIONS OF THE CONTRACTOR, SUBCONTRACTORS OR ANY OF THEIR AGENTS OR EMPLOYEES, OR ANY OTHER PERSONS PERFORMING ANY OF THE WORK.

H.B.

L ALL CODES HAVING JURISDICTION SHALL BE OBSERVED STRICTLY IN THE CONSTRUCTION OF THE PROJECT, INCLUDING ALL APPLICABLE STATE, CITY AND, COUNTY BUILDING ZONING ELECTRICAL PLUMBING LIFE SAFETY AND FIRE CODES. CONTRACTOR SHALL VERIFY ALL CODE REQUIREMENTS AND BRING ANY DISCREPANCY BETWEEN THE CODES AND THE CONSTRUCTION DOCUMENTS TO THE ATTENTION OF THE ARCHITECT.

THE PROJECT WAS DESIGNED IN ACCORDANCE WITH THE BUILDING CODE REQUIREMENTS FOR REINFORCED CONCRETE (ACI 318-11 EDITION). (AMERICAN INSTITUTE OF STEEL CONSTRUCTION) AISC ASD/13th EDITION. BUILDING CODE REQUIREMENTS AND SPECIFICATIONS FOR MASONRY STRUCTURES (ACI 530-11/ASCE 5-11/TMS 402-11). BUILDING CODE REQUIREMENTS AND NATIONAL DESIGN SPECIFICATIONS FOR WOOD CONSTRUCTION (ANSI/NFOPA NDS-2001).

THESE PLANS AS DRAWN AND NOTED, COMPLY WITH THE BUILDING ENVELOPE ENERGY REQUIREMENTS OF THE FLORIDA MODEL ENERGY CODE. CONTRACTOR SHALL FAMILIARIZE HIMSELF WITH THE GOVERNING CODE IN IT'S ENTIRETY AND BUILD IN ACCORDANCE WITH ALL PROVISIONS OF THIS CODE.

. THE CONTRACTOR SHALL BE RESPONSIBLE FOR OBTAINING ALL REQUIRED BUILDING AND TRADE PERMITS AND FOR THEIR RESPECTIVE COSTS

JOB CONDITIONS:

. THE CONTRACTOR SHALL VISIT THE PROJECT SITE PRIOR TO SUBMITTAL OF BID AND OR CONTRACT NEGOTIATIONS. AND HE SHALL VERIFY EXISTING CONDITIONS WITH THE CONSTRUCTION DOCUMENTS. DISCREPANCIES BETWEEN CONSTRUCTION DOCUMENTS SHALL BE BROUGHT TO THE ARCHITECT'S ATTENTION IN WRITING FOR CLARIFICATION. BIDS SHALL NOT BE SUBMITTED OR CONSTRUCTION CONTRACTS NEGOTIATED BY THE CONTRACTOR PRIOR TO CLARIFICATION OF THE INTENT OF THE CONSTRUCTION DOCUMENTS WHERE SUCH INTENT IS IN DOUBT. BACK CHARGES WILL NOT BE ACCEPTED

DIMENSIONS AND NOTES SHALL TAKE PRECEDENCE OVER SCALE AND GRAPHICS. DO NOT SCALE DRAWINGS.

C. IF WORK IS BEING PREFORMED IN AN EXISTING BUILDING AND / OR AS AN ADDITION OR ALTERATION(S) TO AN EXISTING BUILDING. THE CONTRACTOR SHALL VERIFY ALL EXISTING CONDITIONS WITH REFERENCE TO ARCHITECTURAL. STRUCTURAL. MECHANICAL. AND ELECTRICAL SYSTEMS, ANY DISCREPANCIES BETWEEN THE EXISTING CONDITIONS AND CONSTRUCTION DOCUMENTS SHALL BE BROUGHT TO THE ARCHITECT'S ATTENTION IN WRITING PRIOR TO THE SUBMISSION OF BIDS OR CONTRACT NEGOTIATIONS. THE CONTRACTOR SHALL COORDINATE AND SCHEDULE WORK BY TRADES SUPPLIERS. SUBCONTRACTORS AND OTHER PROVIDERS TO INSURE THAT THE WORK. WHEN COMPLETED WILL BE IN ACCORDANCE WITH THE INTENT OF THE CONSTRUCTION DOCUMENTS.

D. CONTRACTOR SHALL BE RESPONSIBLE FOR ADEQUATE BRACING OF STRUCTURAL AND NON-STRUCTURAL MEMBERS DURING CONSTRUCTION.

WORK NECESSARY TO COMPLETE CONSTRUCTION:

A. IT IS THE PURPOSE OF THESE PLANS AND SPECIFICATIONS TO DESCRIBE A COMPLETE AND FINISHED PROJECT OTHER THAN ITEMS MARKED "N.I.C" (NOT IN CONTRACT)

CLEAN UP / REPAIR:

. THE CONTRACTOR SHALL MAINTAIN THE PREMISE CLEAN AND FREE OF ALL. TRASH DEBRIS AND SHALL PROTECT ALL AD IACENT WORK FROM DAMAGE. SOILING PAINT OVER-SPRAY FTC ALL FIXTURES, EQUIPMENT, GLAZING FLOORS, ETC. SHALL BE LEFT CLEAN AND READY FOR OCCUPANCY UPON COMPLETION OF THE PROJECT.

B. THE CONTRACTOR SHALL REPAIR AND / OR REPLACE ALL ITEMS DAMAGED BY THE PROCESS OF CONSTRUCTION AND SHALL FINISH ALL PATCHWORKS AND REPAIRS TO MATCH ADJACENT AREAS AND SURFACES.

A. PERFORM ALL WORK IN CONFORMANCE WITH THE FINAL SOILS, COMPACTION AND

B. FOUNDATIONS SHALL BE MONOLITHIC OR SPREAD FOOTINGS BASED ON A SOIL BEARING CAPACITY OF 2500 PSF. FINAL WRITTEN VERIFICATION SHALL BE SENT TO THE OWNER AND ARCHITECT PRIOR TO THE START OF CONSTRUCTION.

C. AFTER STANDARD CLEANING AND GRUBBING HAS BEEN COMPLETED AND APPROVED, APPLY VIBRATORY COMPACTOR WITH A MINIMUM OF FOUR PASSES.). SOIL SHALL BE COMPACTED TO 95% MODIFIED PROCTOR (ASTM D1557) TO A DISTANCE

OF 5 FEET BEYOND ALL BUILDING EDGES. AT LEAST ONE FIELD DENSITY TEST SHALL BE

ERFORMED FOR EACH 2500 SQUARE FEET OF AREA. DENSITY TESTS ARE TO BE MADE 1 NCHES BELOW THE COMPACTED SURFACES. RESULTS OF PROCTOR TEST(S) AND FIELD DENSITY TEST(S) SHALL BE FURNISHED TO THE ARCHITECT/ENGINEER. E. FILL SHALL BE CLEAN, WELL GRADED SAND, CLASSIFICATION SW PER. ASTM D2487-69

75) WITH LESS THAN 12% PASSING 200 SIEVE. FILL MATERIAL SHALL BE PLACED IN LIFTS OF NOT MORE THAN 12" AND COMPACTED AS ABOVE. T. TERMITE PROTECTION SHALL BE IN ACCORDANCE WITH SECTION 1816 OF THE FL

BUILDING CODE 2014.

A. GENERAL: ALL CONCRETE WORK SHALL CONFORM TO ALL RECOMMENDATIONS AND

REQUIREMENTS OF ACI. 318-11. B. PORTLAND CEMENT: ASTM C-150 TYPES I OR II. LOW ALKALI, SILL TESTED AND CERTIFIED. USE TYPE V CEMENT FOR SOIL CONTAINING SULFATE CONCENTRATIONS OF

WATER: FROM DOMESTIC SOURCES, CLEAN, POTABLE, AND FREE FROM ALL ORGANIC OR OTHER DELETERIOUS MATERIALS.

D. AGGREGATES: ASTM C-33 FOR SLABS ON GRADE. E. SAND: ASTM C-33 FOR SLABS ON GRADE.

FOUNDATIONS: INSTALL AS INCLUDED IN THESE DWG'S. OR AS AMENDED BY THE FINAL

G. VAPOR BARRIER: BENEATH SLABS TO BE 6 MIL. POLYETHYLENE.

I. CONCRETE SHALL BE READY MIX & HAVE A MINIMUM COMPRESSIVE STRENGTH OF 2.500 PSI FOR FOOTINGS & SLABS ON GRADE & 3.000 PSI FOR BEAMS, COLUMNS AT 28 DAYS. ALL CONCRETE WORK SHALL COMPLY W/ THE REQUIREMENTS OF THE ACI BUILDIN CODE (ACI 318-11) THE ACI DETAILING MANUAL (ACI 315/LATEST EDITION), AND THE SPECS OR STRUCTURAL CONCRETE FOR BUILDINGS (ACI 301/LATEST EDITION). CONCRETE COVER FOR REINFORCING STEEL SHALL BE AS REQUIRED BY THE LATEST ACI PECIFICATIONS. WELDED WIRE FABRIC SHALL COMPLY WITH ASTM A-185, UNLESS FHERWISE SPECIFIED. PLACE FABRIC 2" CLEAR FROM TOP OF THE SLAB IN SLAB ON GRADE LAP ALL WWE A MINIMUM OF 6 INCHES U.N.O. ALL REINFORCING STEEL SHALL BE

MANUF. FROM HIGH STRENGTH_BILLET STEEL CONFORMING TO ASTM DESIGNATION A-61! GRADE 60 LAP ALL BARS MINIMUM 48 DIA. U.N.O. ON DRAWINGS, ALL HOOKS SHOWN IN REINFORCEMENT SHALL BE ACI RECOMMENDED HOOKS U.N.O.

REINFORCING STEEL

SUPPORT U N O

A. ALL WORK SHALL COMPLY WITH THE REQUIREMENTS SET FORTH IN THE "MANUAL OF STANDARD PRACTICE FOR DETAILING REINFORCED CONCRETE STRUCTURES" PUBLISHE BY THE AMERICAN CONCRETE INSTITUTE, EXCEPT WHERE MORE EXACTING REQUIREMENTS ARE SPECIFIED IN THE CONTRACT DOCUMENTS.

. MINIMUM CONCRETE COVERAGE OF REINFORCING STEEL. * SLAB ON VAPOR BARRIER 2" (ELEVATED 1 ½") BEAMS AND COLUMNS 1 1/2 FORMED CONCRETE BELOW GRADE 2" **UNFORMED BELOW GRADE 3"** FOOTING 3"CLEAR AT BOTTOM & SIDES 2"CLEAR OF TOP

WALLS 2" CLEAR OUTSIDE FACE, 1 1/2" CLEAR INSIDE

* SLABS 3/4" CLEAR AT TOP (INTERIOR), 1 ½" CLEAR AT TOP (EXTERIOR) BEAMS 1 1/2" CLEAR TO STIRRUPS COLUMNS 1 1/2" CLEAR TO TIES . REINFORCING MESH: ON-GRADE BUILDING SLABS SHALL BE ACI-318 ELECTRICALLY

) ALL ADDED LONGITUDINAL BEAM REINFORCING SHALL EXTEND 6" MIN. INTO

VELDED WIRE FABRIC. SIZES AND GAUGES AS SHOWN ON THE DRAWINGS.

) SCHEDULE HOOPS OR STIRRUPS SHALL BE PLACED AT EACH END OF BEAM U.N.O. BUNDLE ALL STR. BEAM TOP BARS IN PAIRS OVER SUPPORT W/ TOP BARS FROM ADJ.) ALL TIE BEAM REINFORCING SHALL EXTEND INTO SPAN OF ANY ADJ. STR. BEAM PER TANDARD ASTM BENDING DIAGRAM) TIE BEAM DEPTHS ARE MIN. AND MAY BE INCREASED (8" MAX.) TO FIT BLOCK WORK AND INDOW AND DOOR HEADS DROP BOTTOM OF TIE BEAMS, AS REQUIRED, AT WINDOW & DOOR HEADS (28" MAX. BEAM PEPTH) & ADD 2 #5 BOTTOM, IF DROP EXCEEDS 8" U.N.O. ON PLANS.

A. THE TRUSS LAYOUT SHOWN ON CONSTRUCTION DOCUMENTS IS SCHEMATIC IN NATURE. HOWEVER, THE SUPPORTING SUPERSTRUCTURE HAS BEEN DESIGNED UNDER FINAL TRUSS MFG. LAYOUT. THIS FRAMING SCHEME (DIRECTION OF TRUSSES, MAJOR G.T. BEARING POINTS, ETC.) CAN BE MODIFIED ONLY AFTER OBTAINING PERMISSION FROM THE PRIME PROFESSIONAL OF RECORD WHO MUST REVIEW PROPOSED CHANGES AND MAKE STRUCTURAL REVISIONS ACCORDINGLY. FINAL SIGNED AND SEALED ENGINEERING

B. WOOD ROOF TRUSSES ARE TO BE DESIGNED FOR THE WOOD FABRICATOR BY A FABRICATOR TO PROVIDE PRE-FABRICATED HANGERS AS REQUIRED.

CONNECTORS SHALL BE IN ACCORDANCE WITH THE FOLLOWING STANDARDS.

CONCRETE UNIT MASONRY:

PLATE CONNECTED WOOD TRUSSES PER BCSI 2013 EDITION

A. THIS PROJECT IS DESIGNED AS ENGINEERED UNIT MASONRY. STRUCTURAL DESIGN SHALL BE IN ACCORDANCE WITH ACI 530-11/ASCE 5-11/TMS 402-11, BUILDING CODE REQUIREMENTS FOR MASONRY STRUCTURES AND THE COMMENTARY ON BUILDING CODE REQUIREMENTS FOR MASONRY STRUCTURES.

B. REINFORCING STEEL: LAP REINFORCING NOT LESS THAN 48 BAR DIAMETERS AT SPLIC IN WALL REINFORCING. LAP HORIZONTAL REINFORCING A MINIMUM OF 18" AROUND CORNERS. HORIZONTAL BARS SHALL BE TIED TO VERTICAL BARS AS THE WORK PROGRESSES AND SHALL BE EMBEDDED IN GROUT. PLACING OF HORIZONTAL

C. FOUNDATION DOWELS: SHALL NOT BE SLOPED MORE THAN ONE HORIZONTAL TO 6 VERTICAL TO ALIGN WITH BLOCK CORE

AFTER CLEANING AND INSPECTION. OF 1900 PSI ON NET AREA OF INDIVIDUAL UNITS. ALL CMU SHALL BE LAID IN A FULL BED OI

ALL MORTAR SHALL BE TYPE S IN ACCORDANCE WITH ASTM SPECIFICATION C-270 WITH FABRICATED ITEMS AND EQUIPMENT FOR ARCHITECT'S REVIEW PRIOR TO FABRICATION A MINIMUM COMPRESSIVE STRENGTH OF 1800 PSI AT 28 DAYS. NO TESTING FOR MORTAR

FROM HIGH STRENGTH BILLET STEEL CONFORMING TO ASTM DESIGNATION A-615 GRADE

G. GROUT SHALL BE A HIGH SLUMP MIX (8"-11") IN ACCORDANCE WITH ASTM TESTING FOR GROUT STRENGTH IS REQUIRED FOR THIS PROJECT.

H. PROVIDE 9 GAUGE HORIZONTAL JOINT REINFORCEMENT (LADDER TYPE ONLY) AT EVERY SECOND COURSE FOR ALL EXTERIOR WALLS. . ALL CONCRETE MASONRY BEARING AND SHEAR WALLS MUST BE INSPECTED BY A

B. ALL STRUCTURAL STEEL SHALL BE FABRICATED AND ERECTED IN ACCORDANCE WITH THE LATEST AISC CODE. STRUCTURAL STEEL SHALL CONFORM TO ASTM SPECIFICATION FIELD WELDING SHALL BE PERFORMED BY WELDERS QUALIFIED. AS DESCRIBED IN "AMERICAN WELDING SOCIETY'S STANDARD QUALIFICATION PROCEDURE" (ASW D1.1), TO PERFORM THE TYPE OF WORK REQUIRED. ALL STEEL WELDING RODS SHALL BE E70XX **FLECTRODES**

ROUGH CARPENTRY:

OORS AND WINDOW FRAMES

INDOW AND DOOR OPENINGS

TTICS FOR AREAS OVER 3.000 S/F

CHIMNEYS. FLOOR JOISTS OR TRUSSES.

AND COMMENCEMENT OF THE WORK.

SECTION AND DETAILS

PLUMBING FIXTURES:

B. CABINET SUPPLIER SHALL PROVIDE SHOP DRAWINGS.

: WINDOW AND DOOR SUPPLIER SHALL PROVIDE SHOP DRAWINGS.

TYPICAL AND SHALL APPLY TO SIMILAR SITUATIONS ELSEWHERE U.N.O.

A. ALL SHOWER HEADS SHALL HAVE ANTI-SCALDING PROTECTION

SHOP DRAWINGS:

PERPENDICULAR TO SUPPORTS AND STAGGER JOINTS

ALL SUB-SILLS, OVER 8'-0" IN LENGTH SHALL BE DOUBLE 2"X4"s.

OF 4"X4" POSTS WHERE CONTAINED WITHIN WALLS UNLESS SPECIFICALLY NOTED

ALL LUMBER IN DIRECT CONTACT WITH STEEL OR CONCRETE SHALL BE PRESSURE

FREATED. HAVE AN APPROVED SEPARATING MATERIAL OR HAVE A GALVANIZED ANCHOR

BUILDING PAPER: FEDERAL SPECIFICATIONS UU-B-790. INSTALL UNDER ROOFING AND

FRIM AND CAREFULLY APPLY SO AS TO FORM A WATERTIGHT MEMBRANE. EACH COURSE

OF PAPER SHALL OVERLAP THE COURSE BENEATH IT 6" MINIMUM. WHERE PAPER MEETS

ANY OPENING. THE PAPER SHALL BE CAREFULLY LAPPED OVER THE FRAME TO PREVENT

THE PASSAGE OF WATER BEHIND THE FRAME. INSTALL SILKA KRAFT PAPER AT EXTERIOR

ALL BEARING PARTITIONS SHALL BE SECURED TO ADJACENT PARTITIONS, AND SHALL

ROOF SHEATHING: 19/32" THICK STANDARD PLYWOOD SHEATHING, EXTERIOR GLUE, C-D

. DRAFT-STOPPING: IN FLOOR AND CEILING ASSEMBLIES NOT TO EXCEED 1,000 S/F. IN

FIRE-BLOCKING: INSTALL IN CONCEALED SPACES BOTH VERTICAL AND HORIZONTAL.

SUCH AS BUT NOT LIMITED TO, STUD WALLS, FURRED SPACES, SOFFITS, DROP CEILINGS,

OVES, STAIR STRINGERS (TOP AND BOTTOM) OPENINGS FOR VENTS, PIPES, DUCTS,

. THE CONTRACTOR SHALL SUBMIT THREE COPIES OF ALL SHOP DRAWINGS, ALL

ALL DETAILS, SECTIONS AND NOTES SHOWN ON THE DRAWINGS ARE INTENDED TO BE

HAVE AT LEAST A DOUBLE STUD POST AT ALL ENDS, CORNERS AND EACH SIDE OF ALL

GRADE, 4 PLY, INDES 24/0, APA GRADE TRADEMARKED, APPLY WITH FACE GRAIN

HE TYPE INDICATED, NAILS TO BE THOSE FURNISHED OR RECOMMENDED BY

HE ANCHOR, ALL HANGERS AND ANCHORS SHALL BE GALVANIZED.

A. ALL BEAMS INSTALLED WITH CROWN UP UNLESS OTHERWISE NOTED. CANTILEVERED BEAMS SHALL BE INSTALLED WITH CROWN DOWN. 3. 3" MINIMUM BEARING BY BEAMS AND GIRDERS ON MASONRY OR CONCRETE TRUSS DRAWINGS MUST BE SUBMITTED TO THE ARCHITECT FOR REVIEW PRIOR TO

POURING OF FOUNDATION. PROFESSIONAL SPECIALTY ENGINEER REGISTERED IN THE STATE OF FLORIDA. TRUSS

C. DESIGN, FABRICATION, AND INSTALLATION OF WOOD TRUSSES AND SHEET METAL

D. DESIGN SPECIFICATIONS FOR METAL PLATE CONNECTED WOOD ROOF TRUSSES PER TPI 1-2007; DESIGN SPECIFICATIONS FOR METAL PLATE CONNECTED PARALLEL CHORD TRUSSES PER PCT 80: HANDLING, INSTALLATING, RESTRAINING AND BRACING OF META

REINFORCING IN JOINTS OR MORTAR WILL NOT BE PERMITTED EXCEPT FOR WIRE JOINT

D. CLEAN OUT OPENINGS SHALL BE PROVIDED AT BOTTOM OF GROUTED CELLS. SEAL . MASONRY UNITS SHALL BE ASTM C-90 TYPE II WITH MINIMUM COMPRESSIVE STRENGTI MORTAR IN RUNNING BOND U.N.O. ALL REINFORCING STEEL SHALL BE MANUFACTURED

STRENGTH IS REQUIRED FOR THIS PROJECT.

SPECIFICATION C-476 HAVING A MINIMUM COMPRESSIVE STRENGTH OF 3,000 PSI. NO

QUALIFIED ENGINEER JUST PRIOR TO POURING OF THE FOUNDATION, 1ST AND 2ND CONSTRUCTION SHALL BE IN ACCORDANCE WITH THE FLOOR TIE-BEAM. "SPECIFICATION FOR THE DESIGN AND CONSTRUCTION OF LOAD BEARING CONCRETE MASONRY" PUBLISHED BY NATIONAL CONCRETE MASONRY ASSOCIATION.

STRUCTURAL STEEL:

A. WORKMANSHIP: WORK SHALL COMPLY WITH A.I.S.C. LRFD 13TH EDITION, UNLESS MORE EXACTING REQUIREMENTS ARE SPECIFIED IN THE CONTRACT DOCUMENTS.

A36. ALL STEEL TUBING & PIPE SHALL CONFORM TO ASTM SPECIFICATION A-500 GRADE B (FY=46KSI). ALL STEEL TO HAVE A SHOP COAT OF RUST INHIBITIVE PAINT. ALL SHOP AND

A. STRUCTURAL TIMBER TO BE SOUTHERN PINE #2 (MIN.) STRESS GRADE LUMBER OR APPROVED EQUAL. THE MIN. ALLOWANCE PROPERTIES ARE AS FOLLOWS: 5. ADDITION OF SUMMER KITCHEN. 3 = 1,150 PSLFV = 90 PSLE = 1,600,000 PSLAND PRESSURE TREATED FOR USE AGA CONCRETE AND MASONRY.

. PROVIDE 4"X4" POSTS OR (2) 2"X4" STUDS MINIMUM UNDER ALL BEAMS AND HEADERS B. ALL TIMBER AND TIMBER CONSTRUCTION SHALL COMPLY WITH SPECIFICATIONS AND CODES AS SPECIFIED BELOW: AMERICAN INSTITUTE OF TIMBER CONSTRUCTION, TIMBER CONSTRUCTION MANUAL NATIONAL FOREST PRODUCTS ASSOCIATION, NATIONAL DESIGN SPECIFICATION FOR WOOD CONSTRUCTION; AMERICAN PLYWOOD ASSOCIATION, PLYWOOD DESIGN DOUBLE 2"X4"s, SPIKED TOGETHER w/ 16d'S @ 5" O/C STAGGERED MAY BE USED IN LIEU SPECIFICATION: AMERICAN WOOD PRESERVERS ASSOCIATION STANDARDS: NATIONAL UMBER MANUFACTURERS ASSOCIATION, NATIONAL DESIGN SPECIFICATION FOR STRESS GRADE LUMBER AND ITS FASTENINGS.

> ALL TIMBER CONNECTIONS ARE TO BE MADE LISING PREFABRICATED. CONNECTORS TOE NAILING WILL NOT BE PERMITTED. SUBMIT MANUFACTURER'S DATE FOR APPROVAL. FASTENERS TO BE AS MANUFACTURED BY USP OR SIMPSON.

D. LUMBER USED FOR LOAD SUPPORTING SHALL HAVE GRADE MARKS COMPLYING WITH AND PROCEDURES AND AGENCIES APPROVED BY US PROCEDURE PS 20-94.

.. PLYWOOD: PRODUCT STANDARD PS-1-73 AND RULES FOR DFPA GRADE TRADEMARKS OF AMERICAN PLYWOOD ASSOCIATION. MARKING: WOOD AND LUMBER SHALL BE MARKED WITH IT'S GRADE AND PLYWOOD WITH IT'S GRADE TRADEMARK IN ACCORDANCE WITH THE REFERENCED STANDARDS. A

5. EXTERIOR PLYWOOD SHEATHING SHALL BE GROUP I STANDARD (C-D) EXT-DFPA. (C-C) EXT-DFPA, STRUCTURAL I (C-D) EXT-DFPA OR STRUCTURAL I (C-C) EXT-DFPA. DOORS AND WINDOWS:

PIECE WITH DEFECTS SHALL NOT BE USED REGARDLESS OF GRADING.

HANGERS, FRAMING ANCHORS AND FASTENERS: STAMPED AMD FABRICATED STEEL OF A. DOOR OPENINGS BETWEEN THE GARAGE AND DWELLING TO BE SOLID CORE NOT LESS THAN 1%" THICK OR BE IN COMPLIANCE WITH FBC 716.5.3 WITH A FIRE PROTECTION RATING ANUFACTURER FOR THIS SPECIFIC USE. NAILS SHALL BE FULLY DRIVEN IN ALL HOLES IN NOT LESS THAN 20 MINUTES. DOORS SHALL BE SELF CLOSING AND SELF LATCHING.

. DOORS CONTAINING GLAZING MATERIAL NOT GREATER THAN 9 SQUARE FEET IN

OF WITHSTANDING A 150 FOOT-POUND IMPACT TEST DOORS, BATH & SHOWER ENCLOSURES, AND SLIDING GLASS DOORS CONTAINING SLAZING MATERIAL GREATER THAN 9 SQUARE FEET IN SURFACE AREA SHALL BE CLASSIFIED AS CATEGORY II AND SHALL BE CAPABLE OF WITHSTANDING A 400

SURFACE AREA SHALL BE CLASSIFIED AS CATEGORY I AND SHALL BE CAPABLE

D. THE GLAZING IN SLIDING AND SWINGING DOORS AND IN SHOWER OR TUB ENCLOSURES INCLUDING ANY GLAZING WITHIN 60 INCHES OF THE FINISHED FLOOR IN WALLS SURROUNDING TUB & SHOWER ENCLOSURES SHALL BE SAFETY GLAZED FOR CATEGORY SLAZING PRODUCTS.

E. GLASS OR MIRRORS IMMEDIATELY SURROUNDING A BATHTUB OR SHOWER ENCLOSURE SHALL BE SAFETY GLAZING WHERE THE GLASS OR MIRRORS ARE LESS THAN 60" ABOVE HE FLOOR OF THE TUB OR SHOWER.

EGRESS WINDOWS SHALL BE OPERABLE FROM THE INSIDE WITHOUT THE USE OF TOOLS. THEY SHALL PROVIDE A CLEAR OPENING OF NOT LESS 20" WIDE, 24" HIGH AND 5.7 SQUARE FEET MINIMUM AREA. THE BOTTOM OF OPENING SHALL NOT BE MORE THAN 44" BOVE FLOOR AND LATCH AT 54" ABOVE FLOOR (MAX).

G. WINDOW UNITS SHALL DISP. LABELS SHOWING COMPLIANCE WITH THE FL ENERGY

H. ALL NEW SINGLE-FAMILY HOUSES, DUPLEXES, TRI-PLEXES, CONDOMINIUMS AND

TOWNHOUSES SHALL PROVIDE AT LEAST ONE BATHROOM, LOCATED WITH MAX. POSSIBLE PRIVACY, WHERE BATHROOMS ARE PROVIDED ON HABITABLE GRADE LEVELS, WITH A DOOR THAT HAS A MIN. 29" CLEAR OPENING.

THERMAL MOISTURE PROTECTION:

FOOT-POUND IMPACT TEST

INSULATION: INSULATION SHALL BE PROVIDED AND INSTALLED PER FBC 2014 ENERGY CONSERVATION CODE. PRESCRIPTIVE REQUIREMENTS INCLUDE: MINIMUM OF R-30 CLG INSUL IN CLIMATE ZONE 1, R-38 CLG INSUL IN CLIMATE ZONE 2. MASONRY WALLS A MINIMUM OF R-4 IN CLIMATE ZONE 1, R-6 IN CLIMATE ZONE 2. RAME WALLS A MINIMUM OF R-13 IN BOTH CLIMATE ZONE 1 & 2. VERIFY REQUIRED INSULATION VALUES TO BE INSTALLED AGAINST FBC ENERGY CONSERVATION ENERGY CALCULATIONS AS SUBMITTED.

B. ROOF / TILE: TILE SHALL BE AS SHOWN ON DRAWINGS AND AS SELECTED BY ARCHITECT/DESIGNER. INSTALLATION SHALL BE PER MANUFACTURER'S RECOMMENDATIONS AND FLORIDA BUILDING CODE 2014. AT THE COMPLETION OF THE WORK. THE CONTRACTOR SHALL FURNISH A ROOFERS WRITTEN GUARANTEE COVERING WORKMANSHIP, MATERIAL MANUFACTURERS, GUARANTEE FOR REPLACEMENT OF THE SAME AT NO COST TO THE OWNER WITHIN WARRANTEE PERIOD.


EXTERIOR SCOPE OF WORK INCLUDES:

FLIMINATING/CREATING EXTERIOR WINDOWS AND DOORS. AND REPLACING. WINDOW . REPAIRING, PATCHING, AND PAINTING EXTERIOR STUCCO DUE TO REMOVAL OF EXISTING WINDOWS AND DOORS . EXTENSION OF OUTDOOR PATIO SPACE. ADDITION OF MASTER WING

INTERIOR SCOPE OF WORK INCLUDES:

. RECONFIGURING EXISTING WALLS. Σ . REMOVING BATHTUB, TOILETS AND SINKS AND REPLACING WITH NEW CONFIGURATION..

. RECONFIGURING ALL BEDROOMS, INCLUDING CLOSETS AND DOORS..

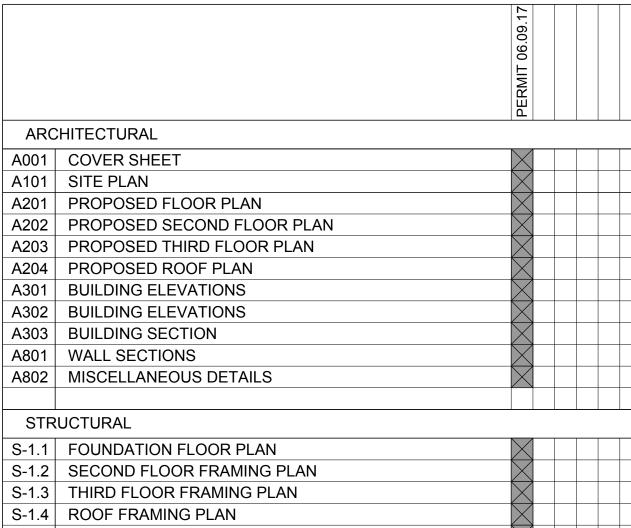

S-2.0 | DETAILS S-3.0 DETAILS S-4.0 GENERAL NOTES AND DIAGRAMS S-5.0 GENERAL NOTES AND DIAGRAMS S-6.0 GENERAL NOTES AND DIAGRAMS S-7.0 | WINDOWS AND DOORS WIND PRESSURES


MASONRY WALL	WALL ABV OR BELOW
GROUT FILLED CELL IN MASONRY WALL	POTSHELF HEIGHT AS NOTED
POURED CONCRETE COL. IN MASONRY WALL	 POURED CONCRETE COL. IN MASONRY WALL
NON-BEARING FRAME WALL	NON-BEARING FRAME WALL
FRAME BEARING WALL	NON-BEARING INSULATED WALL

9 90 S


REVISIONS

FL-0011105 FIRM-AA003379 PROPERTY OF THIS OFFICE, 4 WERE CREATED, EVOLVED, 4
DEVELOPED FOR USE ON, 4 IN CONNECTION WITH THE SPECIFIE
PROJECT, NONE OF SUCH IDEAS, DESIGNS, ARRANGEMENTS, OR LANS SHALL BE USED BY, OR DISCLOSED TO ANY PERSON, I DR CORPORATION FOR ANY PURPOSE UHATISCEVER WITHOUT TH WRITTEN PERMISSION OF RANDALLE, STORTT, ARCHITECTS, P.A. WRITTEN DIMENSIONS ON THESE DRAUMINGS SHALL HAVE PRECEDENCE OVER SCALE DIMENSIONS, CONTRACTORS SHALL ON THE JOB. 4 THIS OFFICE MUST BE NOTIFIED OF ANY VARIATI PROMITIE DIMENSIONS AND CONDITIONS SHOWN BY THESE PRAWINGS, SHOP DETAILS OF ADEQUATE SCALE MUST BE SUBMITTED TO THIS OFFICE FOR APPROVAL BEFORE PROCEED

ITH FABRICATION ON ITEMS SO NOTED. © 2017. ALL RIGHTS ESERVED RANDALL STOFFT ARCHITECTS P.A.

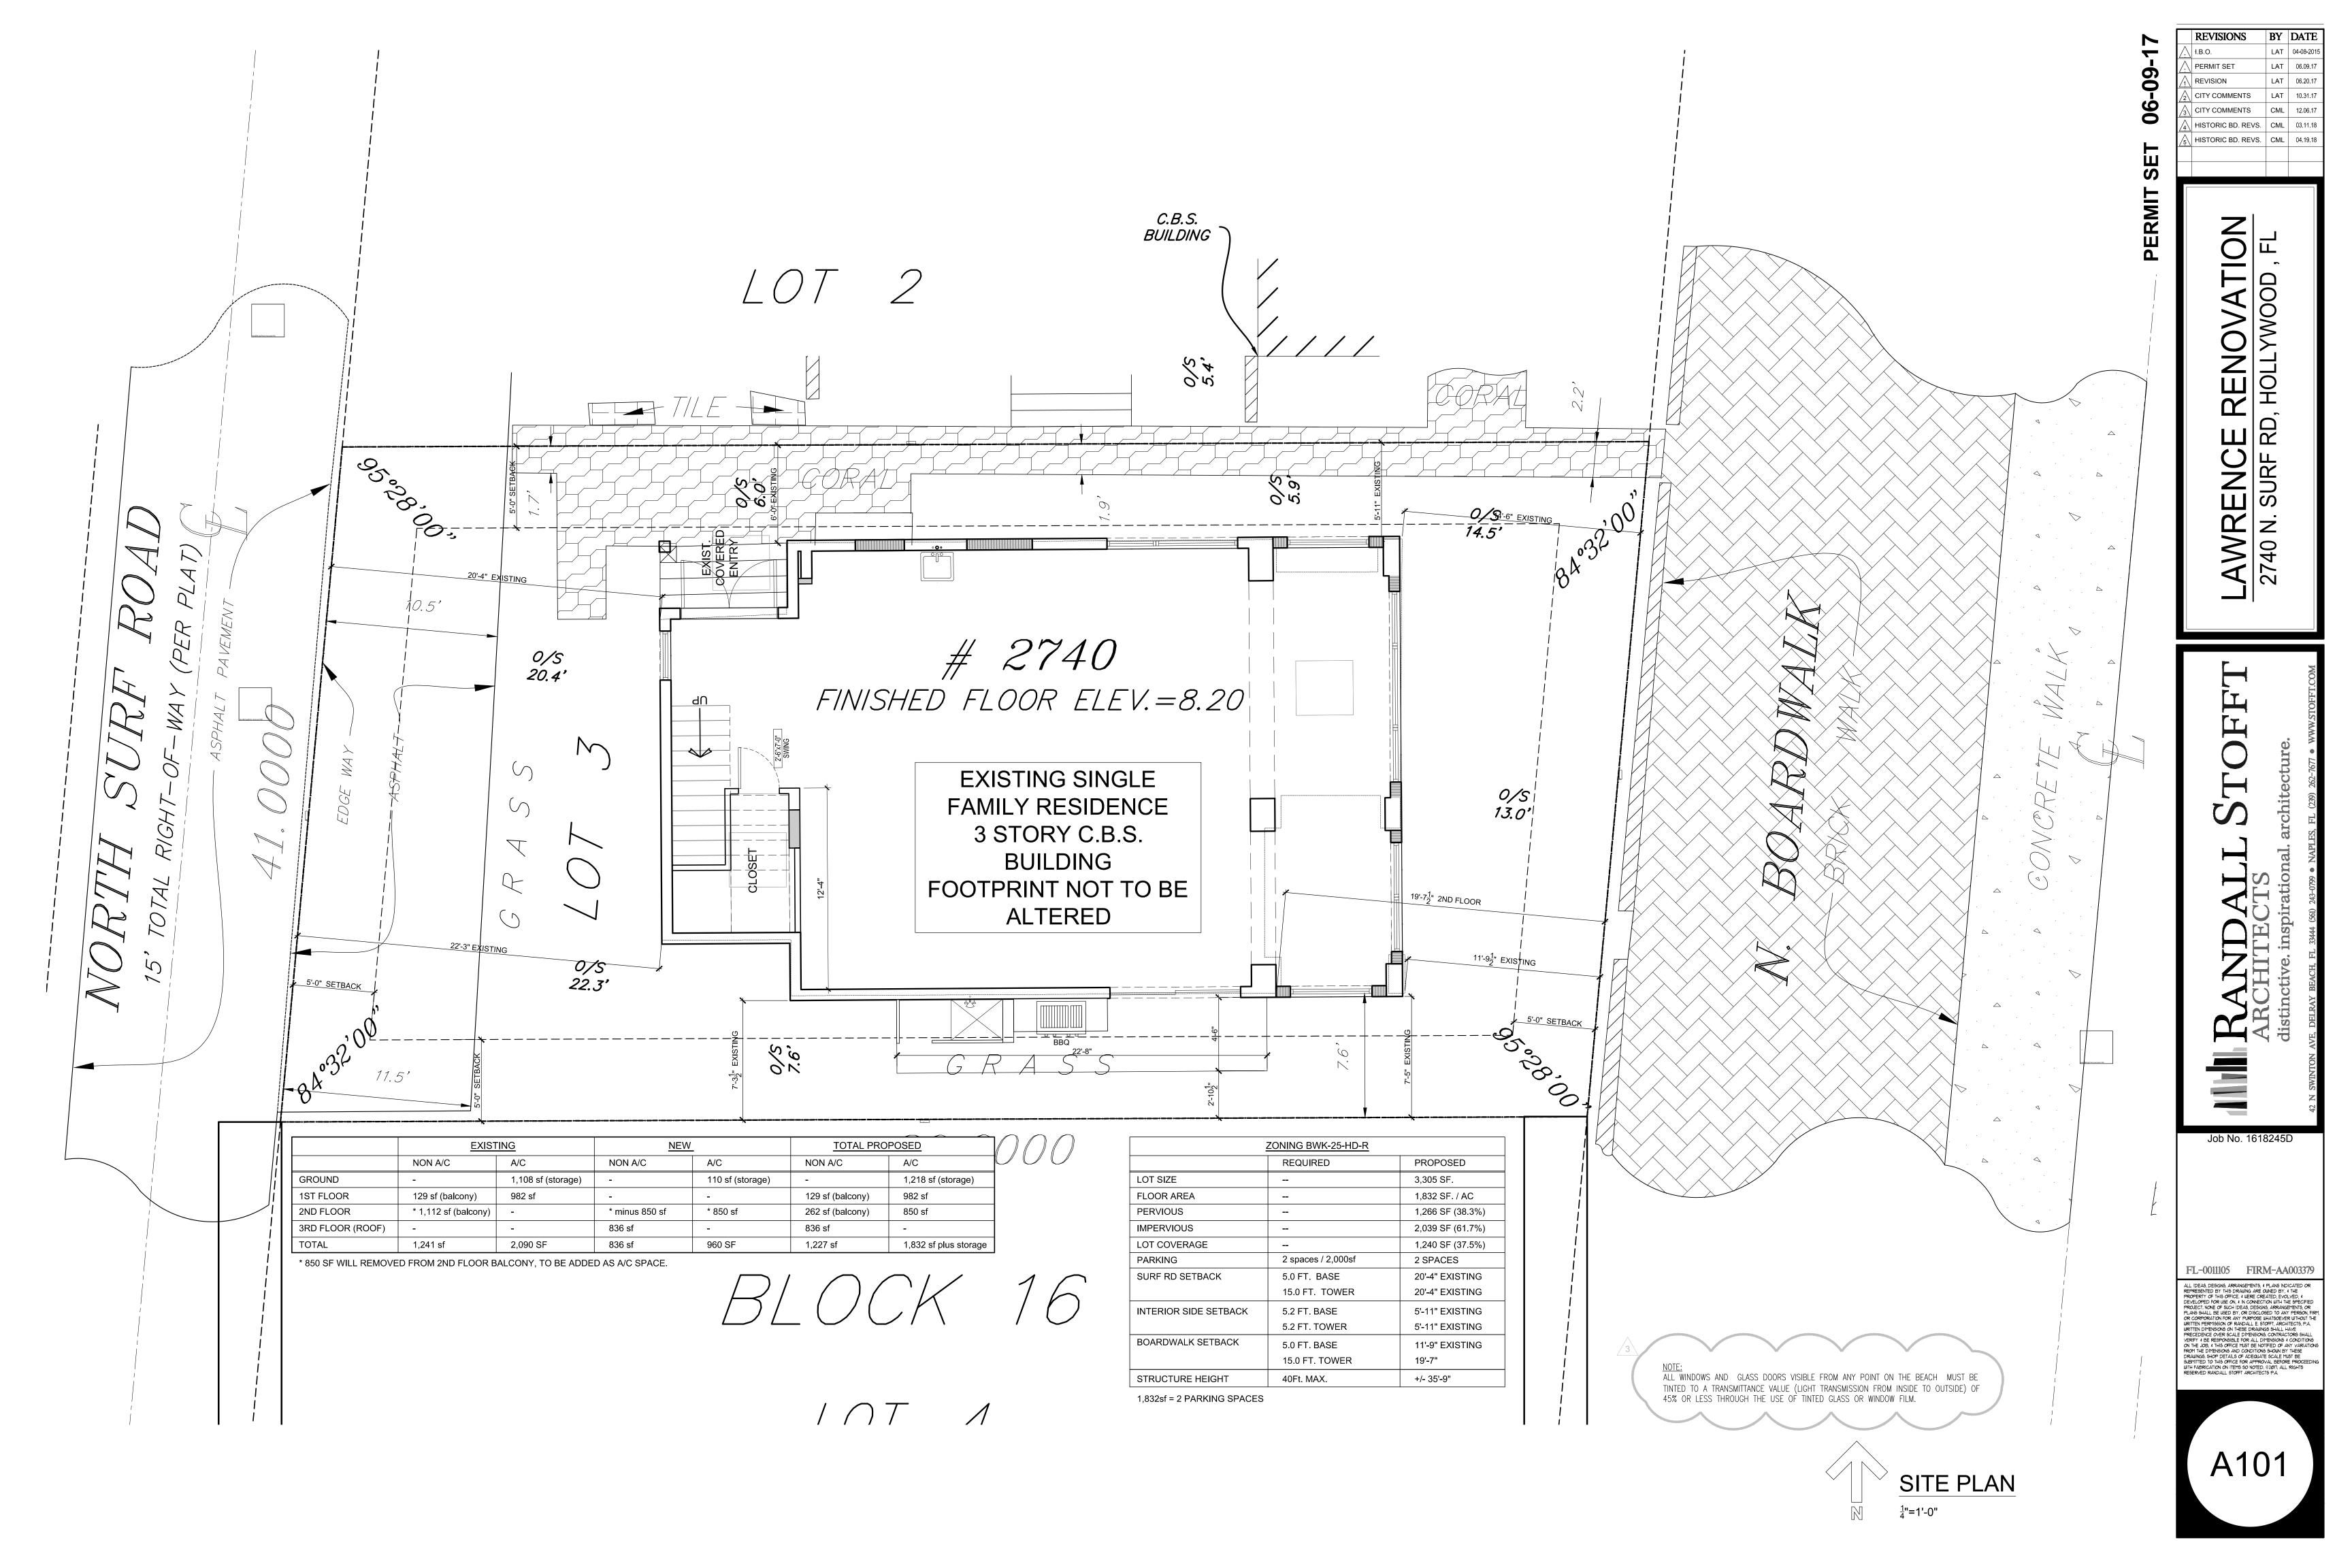

REVISIONS BY DATE

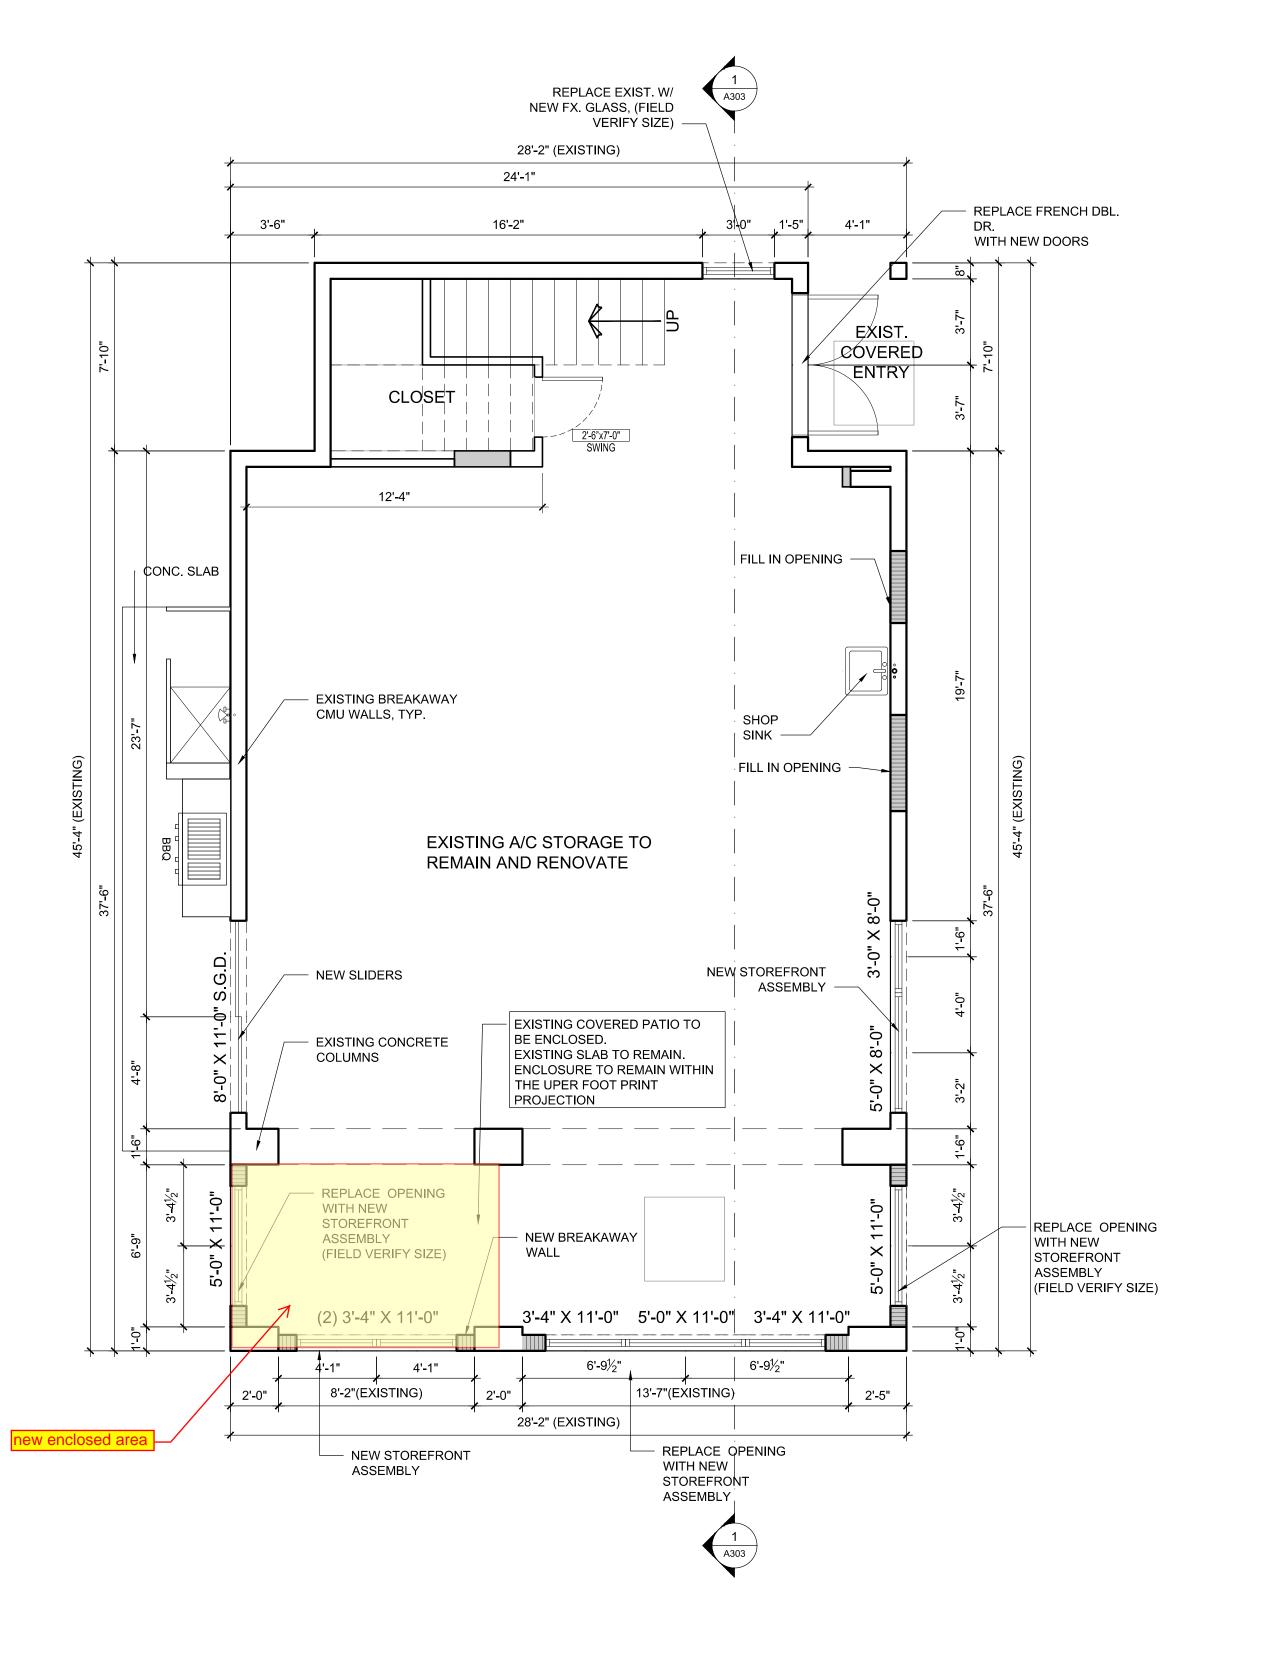

AWRENCE RENOVATION 2740 N. SURF RD, HOLLYWOOD, FL MM RAARC ARC distinct Job No. 1618245D

FL-0011105 FIRM-AA003379

ALL IDEAS, DESIGNS, ARRANGEMENTS, 4 PLANS INDICATED OR REPRESENTED BY THIS DRAWING ARE CUNED BY, 4 THE PROPERTY OF THIS OFFICE. 4 WERE CREATED, EVOLVED, 4 DEVELOPED POR USE ON, 4 IN CONNECTION WITH THE SPECIFIED PROJECT, NONE OF SUCH IDEAS, DESIGNS, ARRANGEMENTS, OR PLANS SHALL BE USED BY, OR DISCLOSED TO ANY PERSON, IRIN, OR CORPORATION FOR ANY PURPOSE WHATSOCKER WITHOUT THE WRITTEN PERMISSIONS ON THESE DRAWINGS SHALL HAVE PRECEDENCE OVER SCALE DIMENSIONS, SCATTRACTORS SHALL VERIFY 4 BE RESPONSIBLE FOR ALL DIMENSIONS 4 CONDITIONS ON THE JOB, 4 THIS OFFICE MUST BE NOTIFIED OF ANY VARIATIONS FROM THE DIMENSIONS AND CONDITIONS SHOWN BY THESE DRAWINGS, SHOP DETAILS OF ADEQUATE SCALE MUST BE SUBMITTED TO THIS OFFICE MUST BE SCALE MUST BE SUBMITTED TO THIS OFFICE FOR APPROVAL BEFORE PROCEDEDING WITH FABRICATION ON TIEMS SO NOTED, 6/2011, ALL RIGHTS RESERVED RANDALL STOFFT ARCHITECTS P.A.

A201

BY DATE


ARC distin

Job No. 1618245D


1ST LIVING FLOOR PLAN
4"=1'-0"

FL-0011105 FIRM-AA003379 ALL IDEAS, DESIGNS, ARRANGEMENTS, & PLANS INDICATED OR REPRESENTED BY THIS DRAWING ARE OUNED BY, 4 THE PROPERTY OF THIS OFFICE. & WERE CREATED, EVOLVED, & DEVELOPED FOR USE ON, & IN CONNECTION WITH THE SPECIFIED PROJECT. NOTE OF SUCH IDEAS, DESIGNS, ARRANGEMENTS, OR PLANS SHALL BE USED BY, OR DISCLOSED TO ANY PERSON, FIRM, OR CORPORDATION FOR ANY PURPOSE WHATSO-VER WITHOUT THE WRITTEN PERMISSION OF RANDALL E. STOFFT, ARCHITECTS, P.A. WRITTEN DIMENSIONS ON THESE DRAWINGS SHALL HAVE PRECEDENCE OVER SCALE DIMENSIONS. CONTRACTORS SHALL VERIFY & BE RESPONSIBLE FOR ALL DIMENSIONS & CONDITIONS ON THE DIMENSIONS AND CONDITIONS SHOWN BY THESE DRAWINGS. SHOP DETAILS OF A POPOVAL BEFORE PROCEDEDING WITH FABRICATION ON ITEMS SO NOTED. 67.20TH. MIST BE SUMMITTED TO THIS OFFICE FOR A POPOVAL BEFORE PROCEDEDING WITH FABRICATION ON ITEMS SO NOTED. 67.20TH. ALL RIGHTS RESERVED RANDALL STOFFT ARCHITECTS P.A.



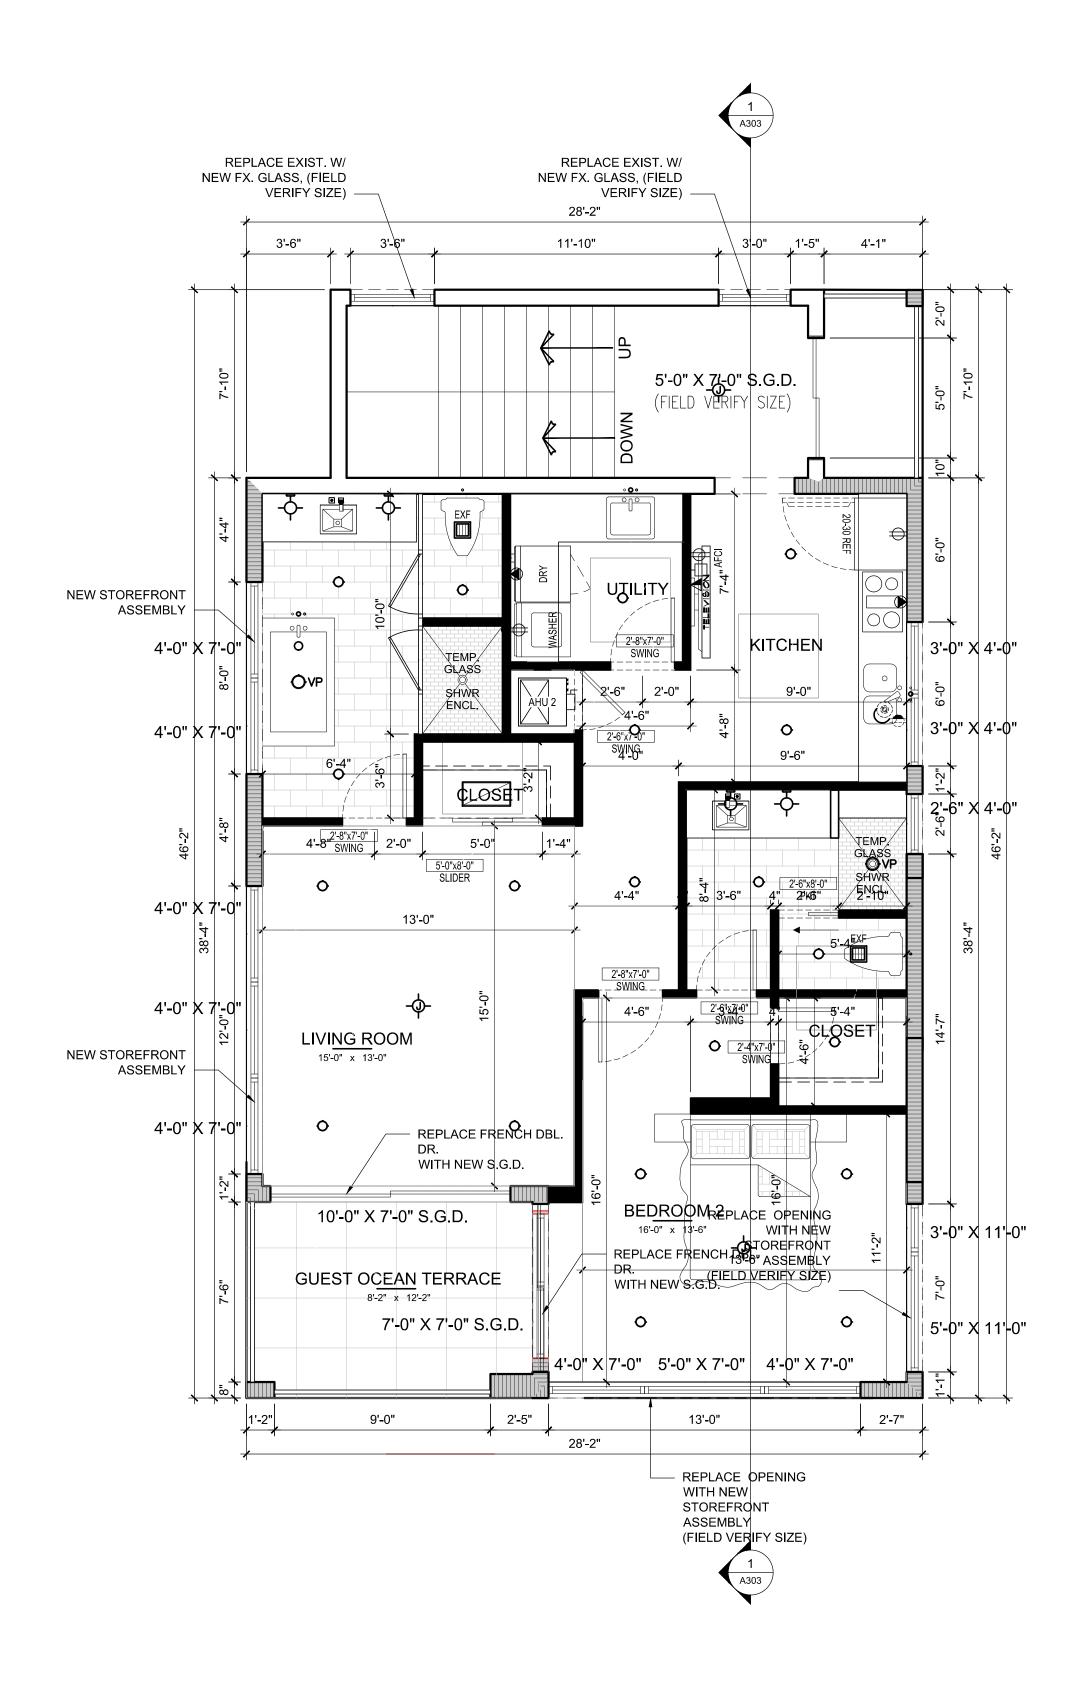


REVISIONS BY DATE

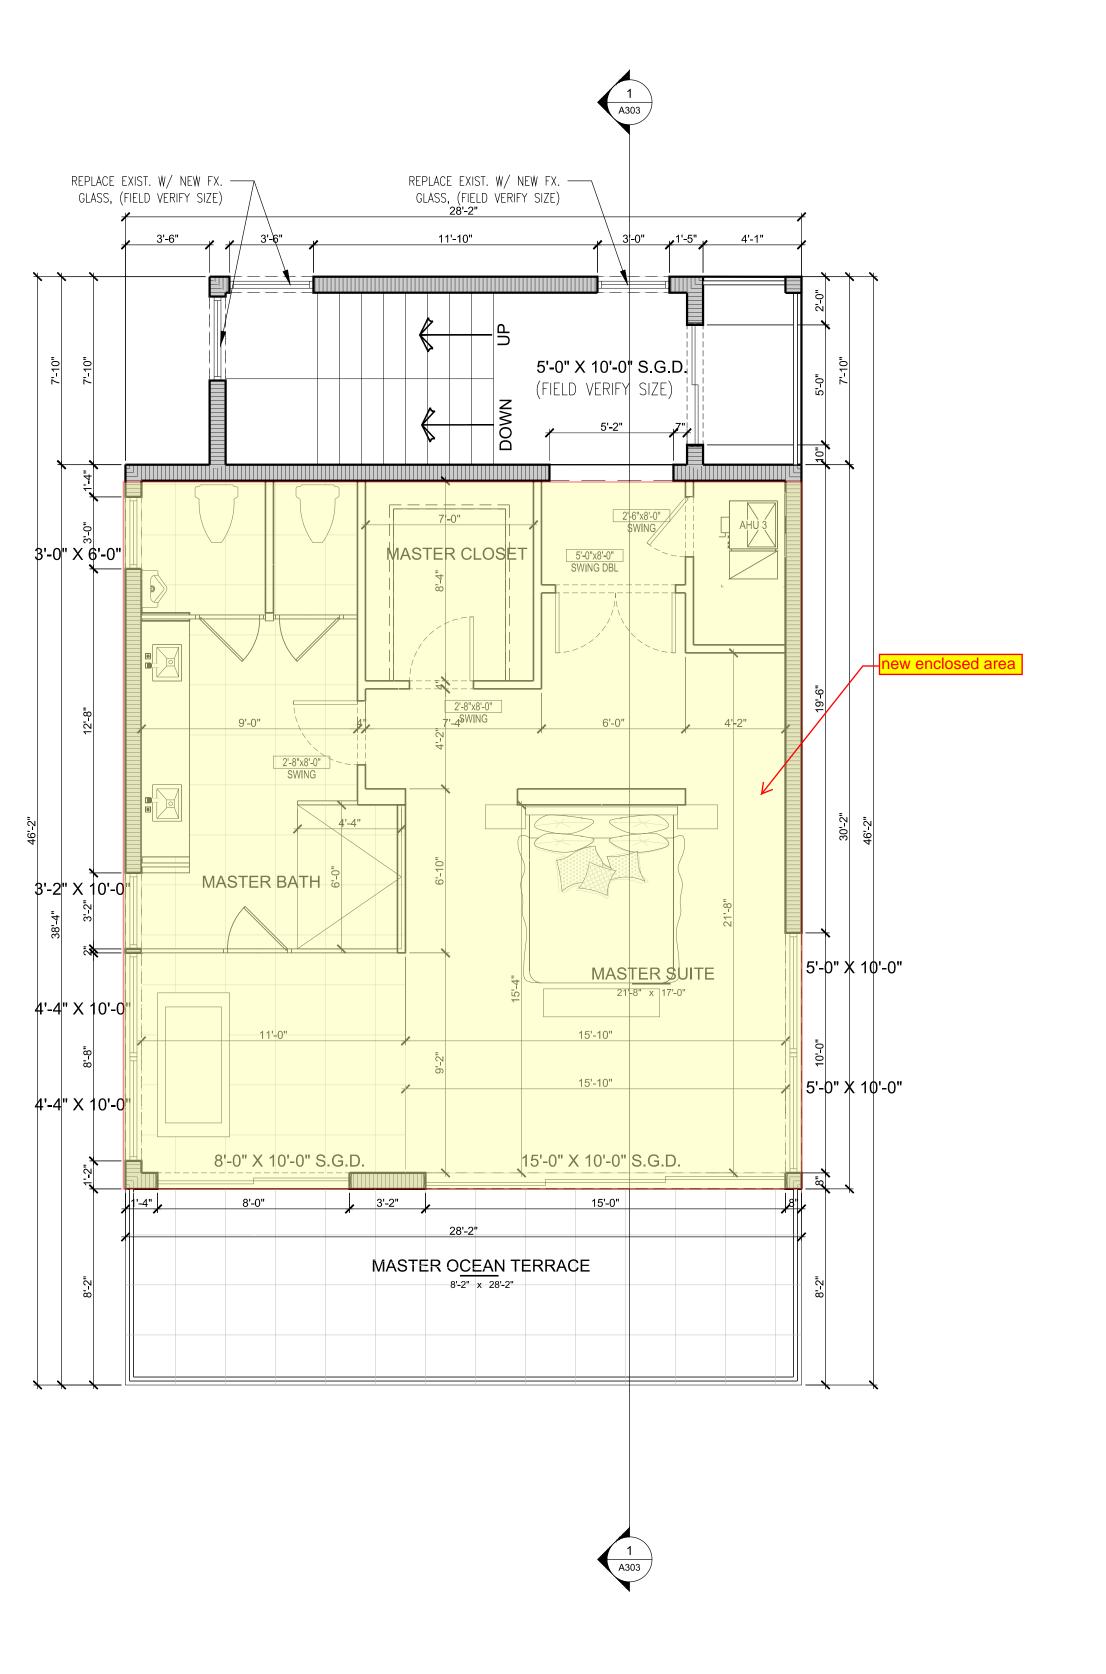



2ND FLOOR PLAN

REVISIONS BY DATE

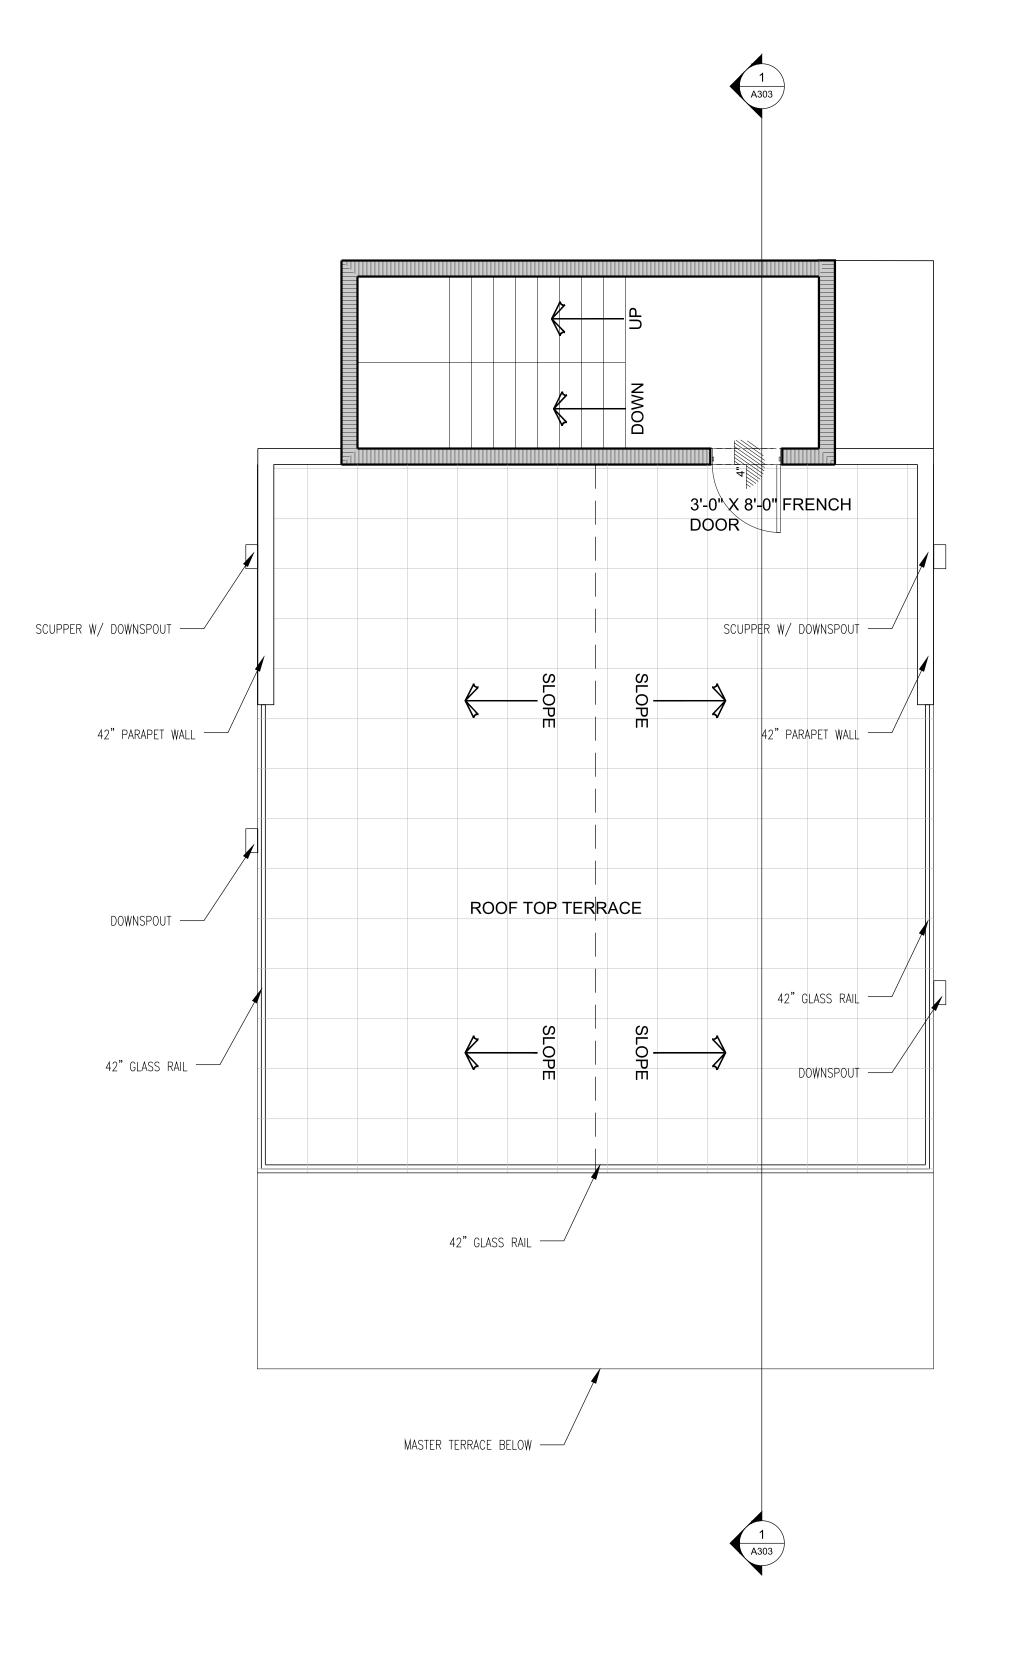




FL-0011105 FIRM-AA003379

ALL IDEAS, DESIGNS, ARRANGEMENTS, 4 PLANS INDICATED OR REPRESENTED BY THIS DRAWING ARE OWNED BY, 4 THE PROPERTY OF THIS OFFICE, 4 WERE CREATED, EVOLVED, 4 DEVELOPED POR USE ON, 4 IN CONNECTION WITH THE SPECIFIED PROJECT, NONE OF SUCH IDEAS, DESIGNS, ARRANGEMENTS, OR PLANS SHALL BE USED BY, OR DISCLOSED TO ANY PERSON, FIRM, OR CORPORATION FOR ANY FURPOSE WHATSOCKER WITHOUT THE WRITTEN PERSISSION OF RANDALL E. STOFFT, ARCHITECTS, P.A. WRITTEN DIMENSIONS ON THESE DRAWINGS SHALL HAVE PRECEDENCE OVER SCALE DIMENSIONS, CONTRACTORS SHALL VERIFY 4 BE RESPONSIBLE FOR ALL DIMENSIONS 6 CONDITIONS ON THE JOB, 4 THIS OFFICE MUST BE NOTIFIED OF ANY VARIATIONS FROM THE DIMENSIONS AND CONDITIONS SHOWN BY THESE DRAWINGS, SHOP DETAILS OF ADEQUATE SCALE MUST BE SUBMITTED TO THIS OFFICE PROSPONSIBLE TO ALL DIMENSIONS BY THESE DRAWINGS, SHOP DETAILS OF ADEQUATE SCALE MUST BE SUBMITTED TO THIS OFFICE FOR APPROVAL BEFORE PROCEEDING WITH FABRICATION ON ITEMS SO NOTED, 6/2011, ALL RIGHTS RESERVED RANDALL STOFFT ARCHITECTS P.A.

A204

ROOF TERRACE PLAN

1/4"=1'-0"

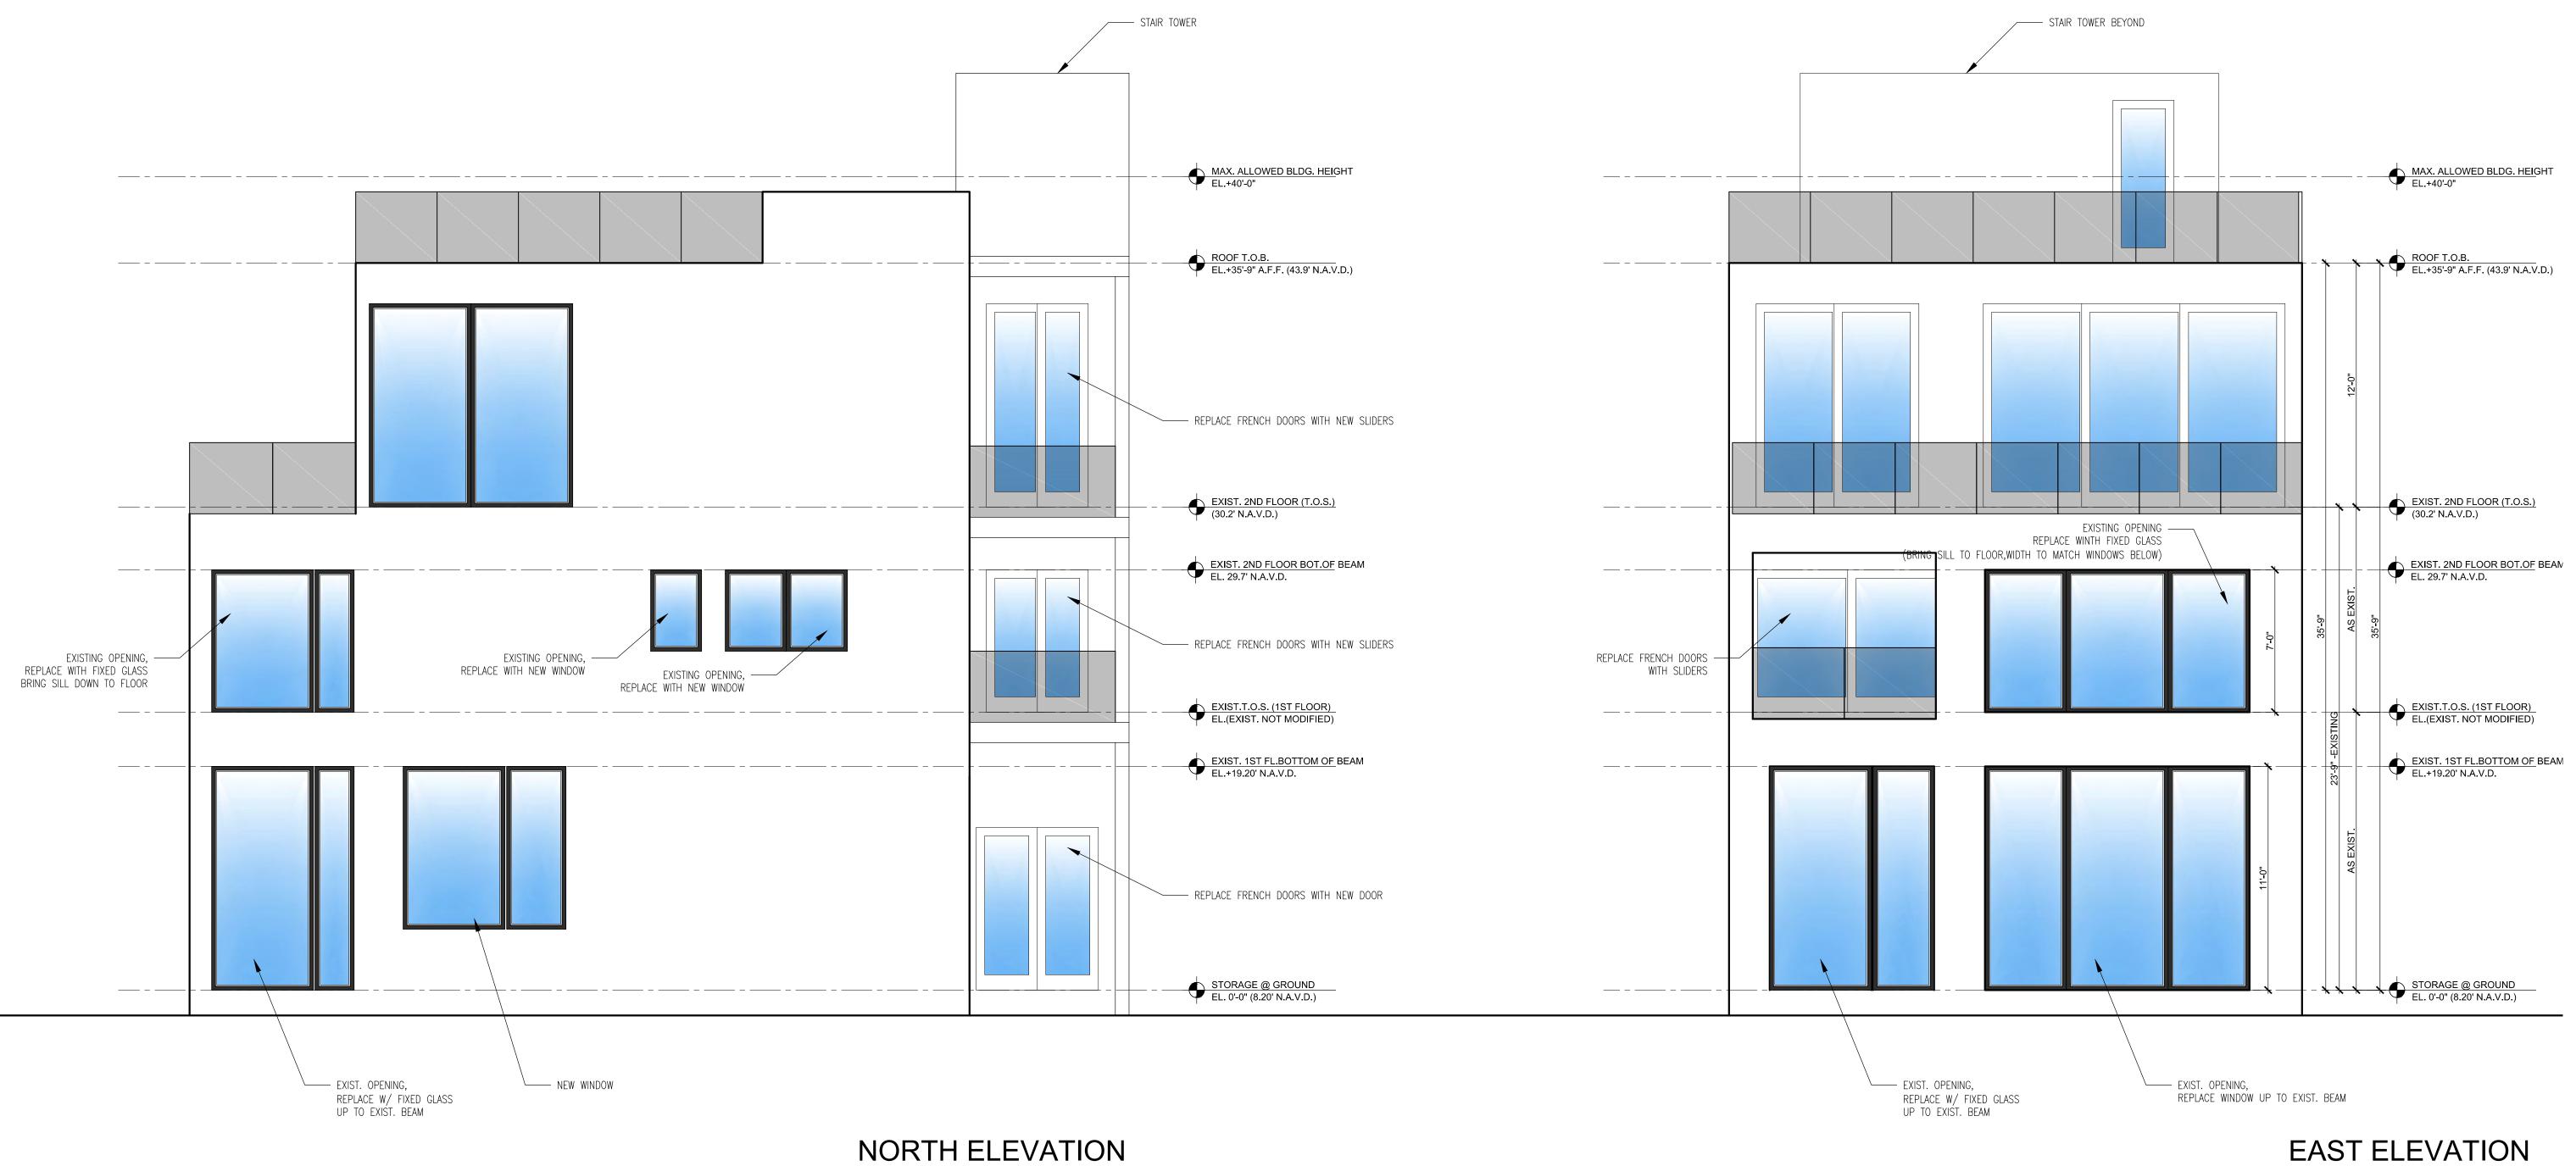

 $\frac{1}{4}$ "=1'-0"

EAST ELEVATION

ALL WINDOWS AND GLASS DOORS VISIBLE FROM ANY POINT ON THE BEACH MUST BE TINTED TO A TRANSMITTANCE VALUE (LIGHT TRANSMISSION FROM INSIDE TO OUTSIDE) OF 45% OR LESS THROUGH THE USE OF TINTED GLASS OR WINDOW FILM.

 $\frac{1}{4}$ "=1'-0"

Job No. 1618245D
FL-0011105 FIRM-AA003379
ALL IDEAS, DESIGNS, ARRANGEMENTS, & PLANS INDICATED OR REPRESENTED BY THIS DRAWNS ARE OWNED BY, & THE PROPERTY OF THIS OFFICE. & WERE CREATED, EVOLVED, & DEVELOPED FOR USE, ON, & IN CONNECTION WITH THE SPECIFIED PROJECT, NOTE OF SUCH IDEAS, DESIGNS, ARRANASEMENTS, OR PLANS SHALL BE USED BY, OR DISCLOSED TO ANY PERSON, FIRM, OR CORPORATION FOR ANY PURPOSE WHATSOEVER WITHOUT THE WRITTEN PERSISON OF RANDALL E. STOPT, ARCHITECTS, PA. WRITTEN DIPURSIONS OF THESE DRAWNINGS SHALL HAVE PRECEDENCE OVER SCALE DIPURSIONS, CONTRACTORS SHALL VERRY! & DE RESPONSIBLE FOR ALL DIPURSIONS & CONDITIONS ON THE JOB, & THIS OFFICE MUST BE NOTIFIED OF ANY VARIATIONS FROM THE DIPURSIONS AND CONDITIONS SHOUN BY THESE DRAWNINGS, SHOP DETAILS OF ADEQUATE SCALE PINST BE SUBMITTED TO THIS OFFICE FOR APPROVAL BEFORE PROCEEDING WITH FABRICATION ON THEMS SON OFFICE POR APPROVAL BEFORE PROCEEDING WITH FABRICATION ON THEMS SON OFFICE POR APPROVAL BEFORE PROCEEDING WITH FABRICATION ON THEMS SON OTHERS.



AWRENCE F 2740 N. SURF RD,



WEST ELEVATION

 $\frac{1}{4}$ "=1'-0"

SOUTH ELEVATION

 $\frac{1}{4}$ "=1'-0"

NOTE:
ALL WINDOWS AND GLASS DOORS VISIBLE FROM ANY POINT ON THE BEACH MUST BE TINTED TO A TRANSMITTANCE VALUE (LIGHT TRANSMISSION FROM INSIDE TO OUTSIDE) OF 45% OR LESS THROUGH THE USE OF TINTED GLASS OR WINDOW FILM.

FL-0011105

FIRM—AA003379

ALL IDEAS, DESIGNS, ARRANGEMENTS, & PLANS INDICATED OR REPRESENTED BY THIS DRAWING ARE QUINED BY, & THE PROPERTY OF THIS OFFICE, & LERE CREATED, EVOLVED, & DEVELOPED FOR USE ON, & IN CONNECTION WITH THE SPECIFIED PROJECT, NONE OF SUCH IDEAS, DESIGNS, ARRANGEMENTS, OR PLANS SHALL BE USED BY, OR DISCLOSED TO ANY PERSON, FIRM, OR CORPORATION FOR ANY PURPOSE WHATSOCKER WITHOUT THE WRITTEN PERMISSION OF RANDALL E. STOPT, ARCHITECTS, P.A. WRITTEN DIMENSIONS ON THESE DRAWINGS SHALL HAVE PRECEDENCE OVER SCALE DIMENSIONS, CONTRACTORS SHALL VERIFY & BE RESPONSIBLE FOR ALL DIMENSIONS ON CONTRACTORS SHALL VERIFY & BE RESPONSIBLE FOR ALL DIMENSIONS ON CONTRACTORS SHALL FINE JOB, & THIS OFFICE MUST BE NOTIFIED OF ANY VARIATIONS FROM THE DIMENSIONS AND CONDITIONS SHOUND BY THESE DRAWINGS, SHOP DETAILS OF ADEQUATE SCALE MUST BE SUBMITTED TO THIS OFFICE MUST BE SUBMITTED TO THIS OFFICE MET BY SHOW BEFORE PROCEEDING WITH FABRICATION ON ITEMS SO NOTED, © 2011. ALL RIGHTS RESERVED RANDALL STORT ARCHITECTS P.A.

A302



STRUTZ RESIDENCE
SECOND FLOOR ADDITION
2740 NORTH SURF ROAD
Hollywood, Florida

ARCHITECTS/PLANNERS/DESIGNERS/PA 333 NW 18T AVE FT. LAUDERDALE, RL 33301

92032 E.O./L.R.

SHEET NUMBER

A-3


ELEVATIONS

12/29/97 A.F.


2 = 0 0 0 0 0 0 0 0


2 WRITTEN I 3 CONTRACT THE JOB A CONDITION 4 ATTENTION ARTICLE A DRAWNING 5 IN THE EV GIVEN IN TO GIVEN IN TO




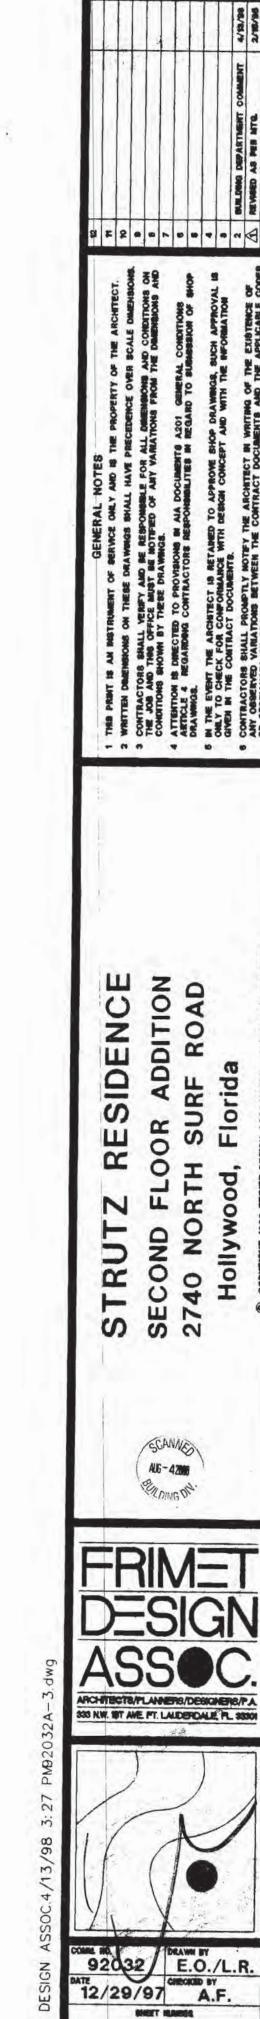

ELEVATIONS

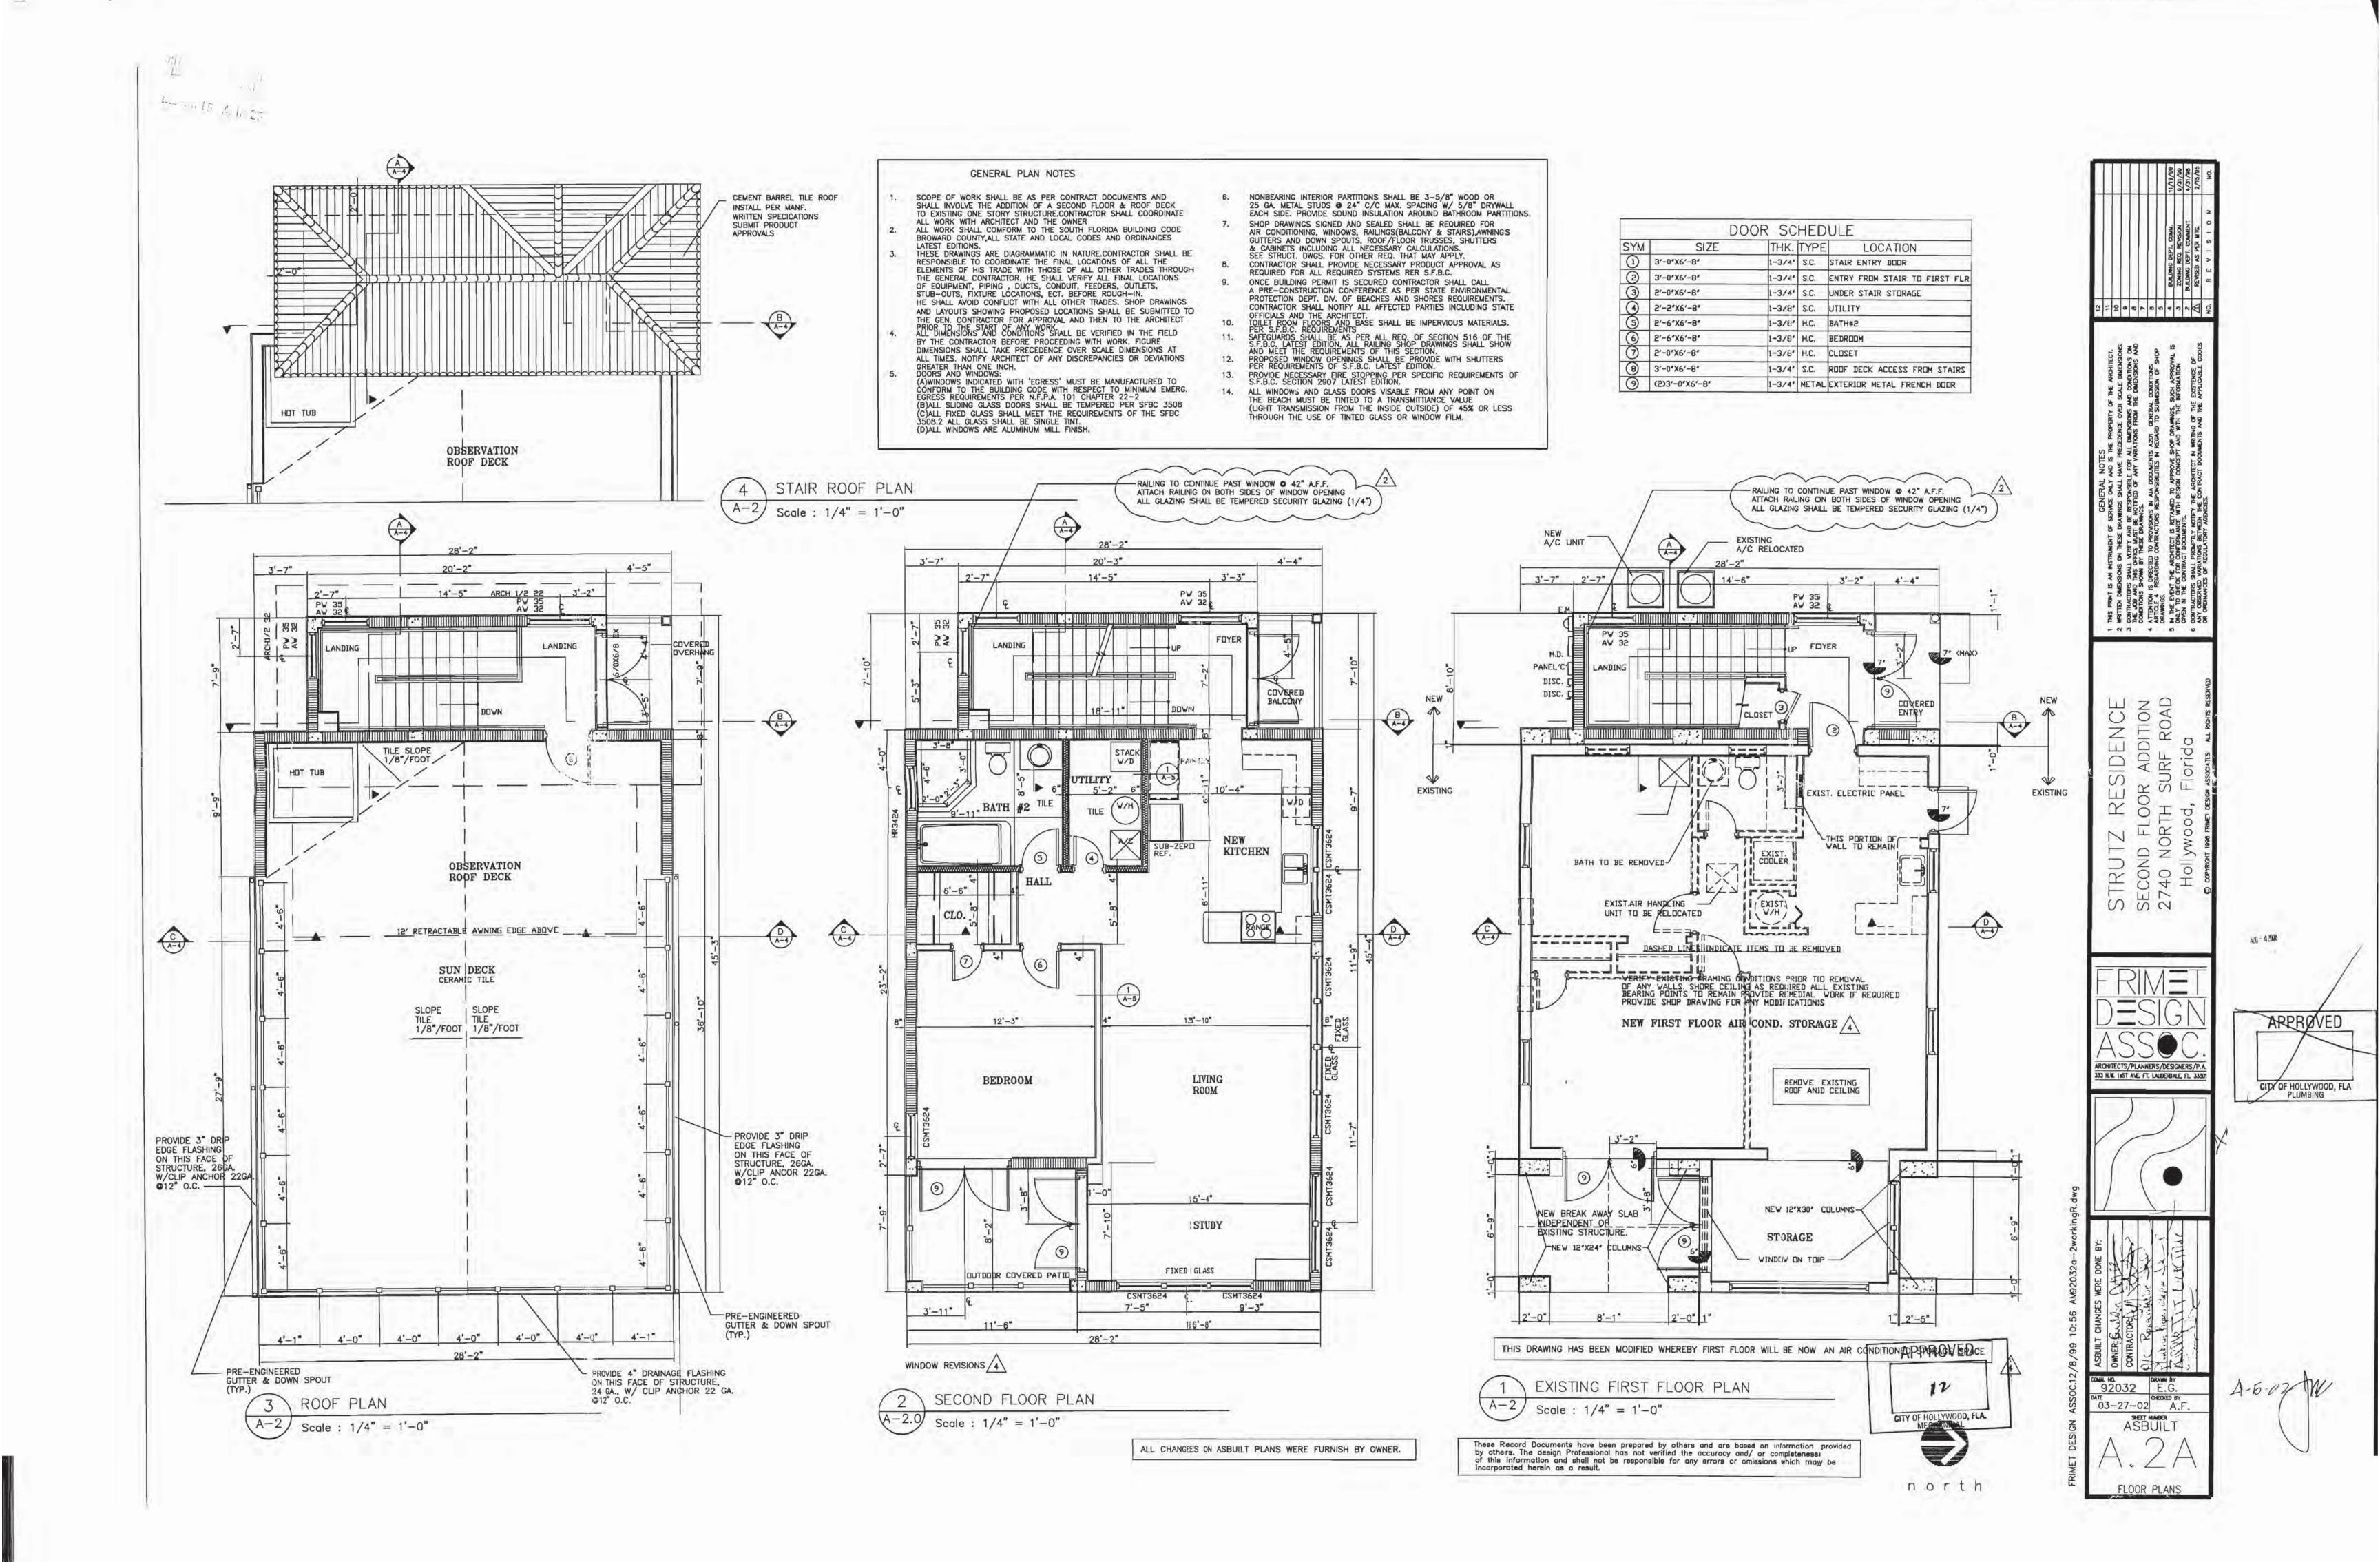

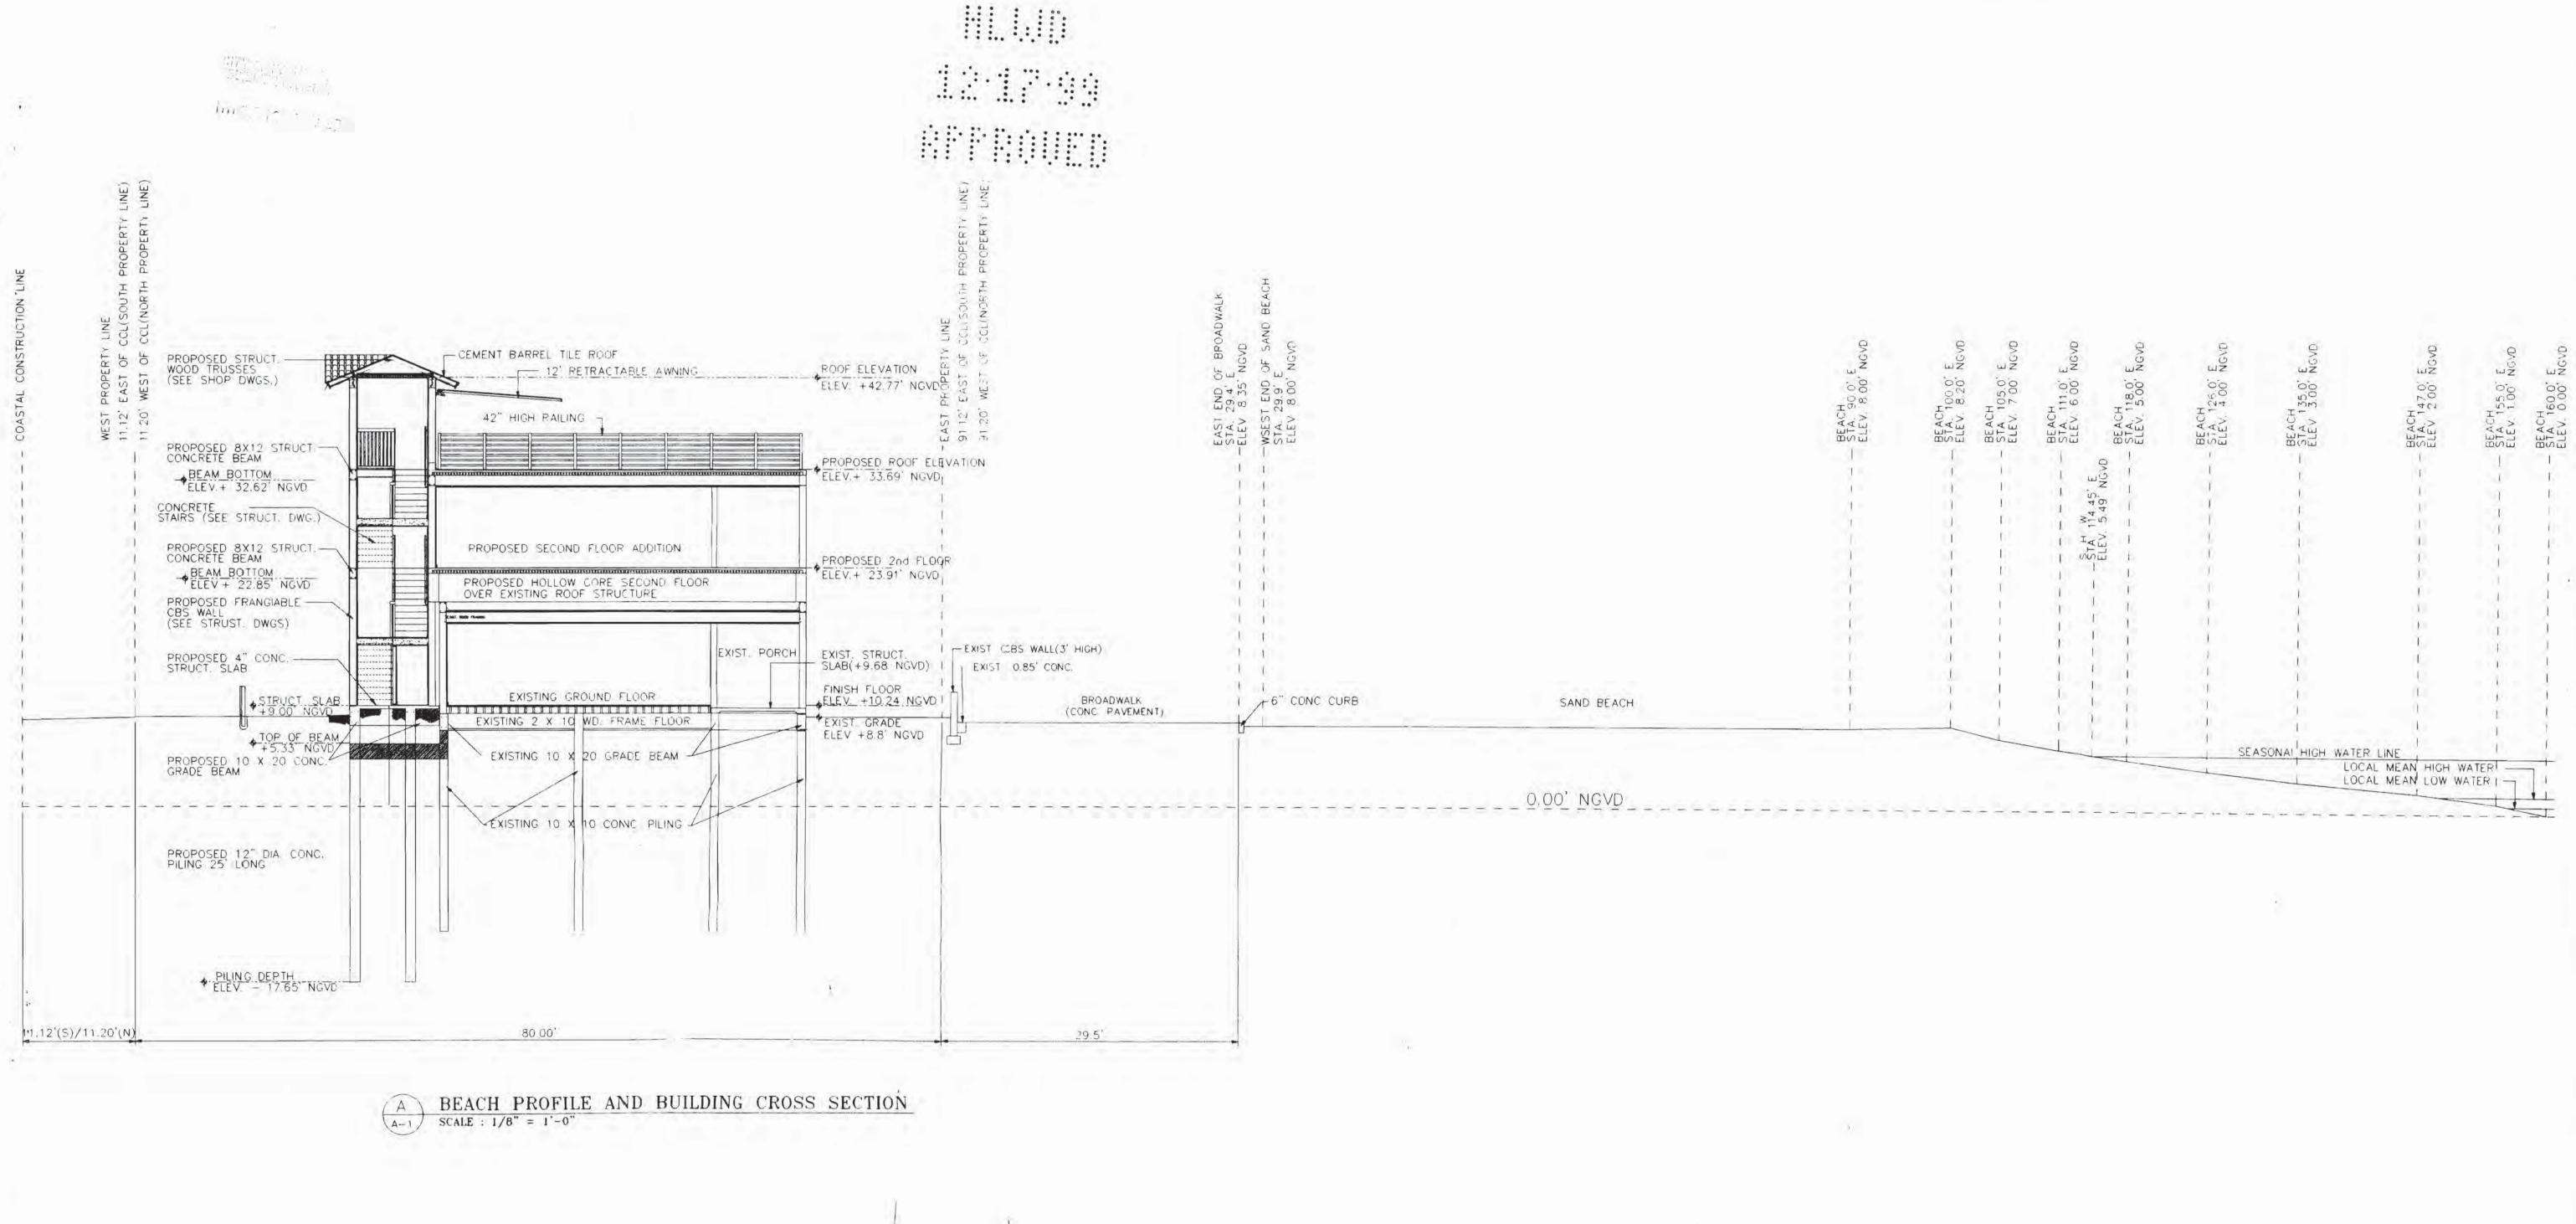

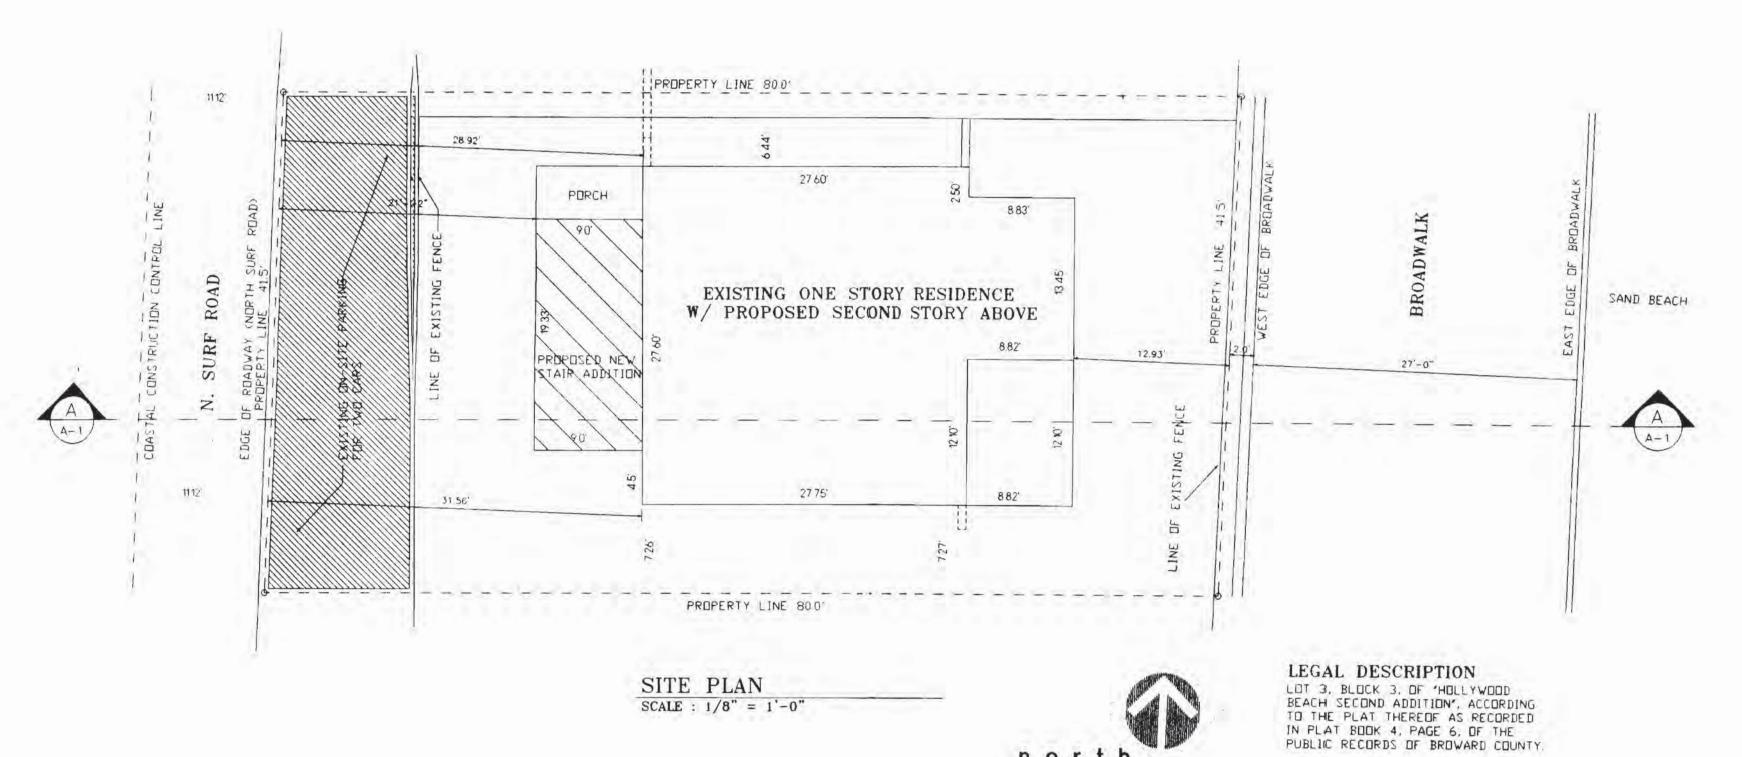

north



92032 E.O./L.R.

12/23/97 CHECKED BY A.F.

A-

BUILDING DATA


BUILDING DATA

OCCUPANCY TYPE - I (RESIDENCIAL SINGLE FAMILY)
CONSTRUCTION TYPE - TYPE III , PROTECTED
FIRE RATING REQUIREMENTS:
LOAD BEARING WALLS - ONE HOUR
LOAD BEARING COLUMNS - ONE HOUR
ROOF ASSEMBLY - ONE HOUR
CEILINGS ASSEMBLY - ONE HOUR
TOTAL SITE SO. FT. - 3,314.8 S.F.
TOTAL BUILDING COVERAGE -1,216.65 S.F.
EXISTING PAVED AREA - 449.42 S.F.
TOTAL IMPERVIOUS AREA - 1648.88 S.F.
TOTAL PERVIOUS AREA - 1666.07 S.F.
TOTAL WATER RETENTION REQUIRED - 164.8 S.F.

TOTAL WATER RETENTION REQUIRED - 164.8 S.F. TOTAL WATER RETENTION PROVIDED - 1577.07 S.F.

A ALL INTERIOR LOAD BEARING PARTITIONS
SHALL BE MIN 1-HOUR FIRE RATED CONSTRUCTION.
PER S.F.B.C. TABLE 37-B ITEM, 72(METAL) & 79(WOOD).
B. FLOOR & CEILING ASSEMBLY SHALL BE AS PER
S.F.B.C. TABLE 37-C, ITEM 42
C. ALL LOAD BEARING COLUMNS WHERE APPLICABLE
SHALL BE PER S.F.B.C. TABLE 37-E 2-LAYERS OF
5/8° TYPE'X' GYPSUM WALLBOARD.


3 = 2 0 = 1 0 0 4 8 8

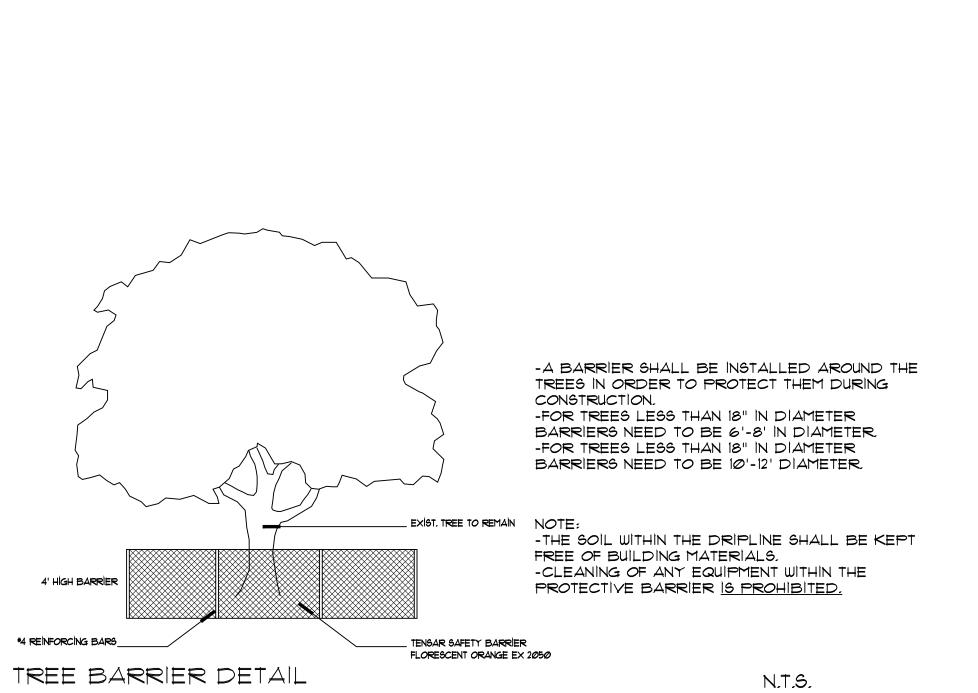

Tree Disposition No Botanical Name DBH (in.) HT (ft.) SPR (ft.) Disposition Condition Remarks Common Name 12 36 18 Remain 10 28 18 Remain 1 Cocos nucifera Coconut
 10
 28
 18
 Remain
 Good

 10
 30
 18
 Remain
 Good

 3
 14
 12
 Remain
 Good
 2 Cocos nucifera Coconut Adjacent property 3 Cocos nucifera Coconut 4 Conocarpus erectus 'sericeus' Silver Buttonwood Adjacent property, adjacent to power lines

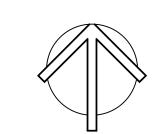

RESIDENC
SURF ROAD
DD, FLORIDA WRENCE 3740 NORTH SHOLLYWOOD

REVISIONS

DISPOSITION

TREE


LANDSCAPE

Date 3/5/18 Scale 1"=10'-0"

Drawn DV Check DV

Sheet


Of Sheets

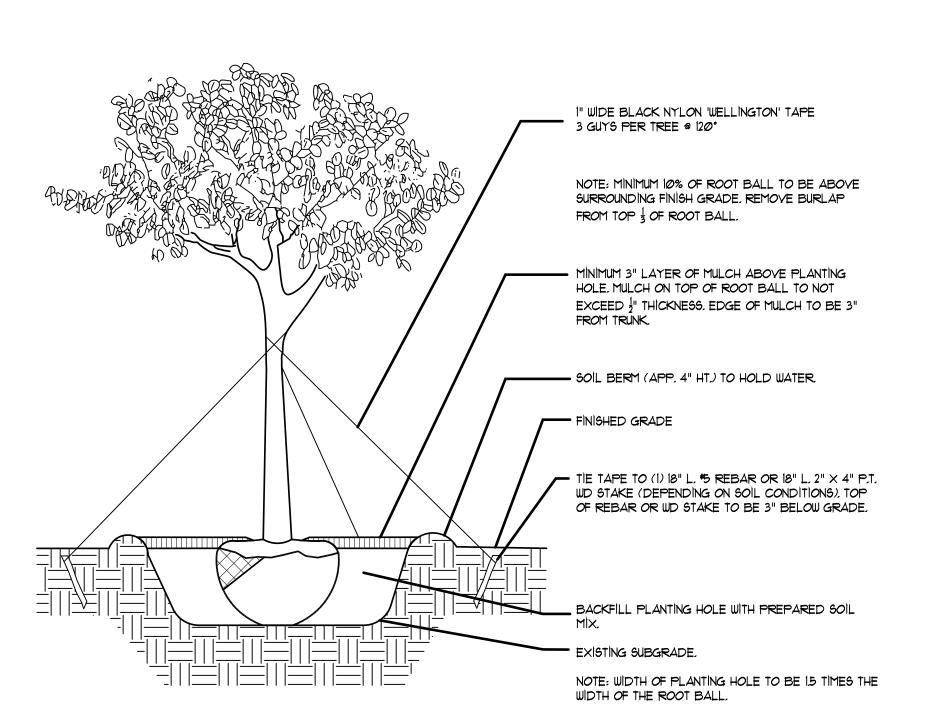

TREES WITH 3" CALIPER OR LESS

TREE PLANTING DETAIL

LARGE TREE PLANTING DETAIL SIMILAR

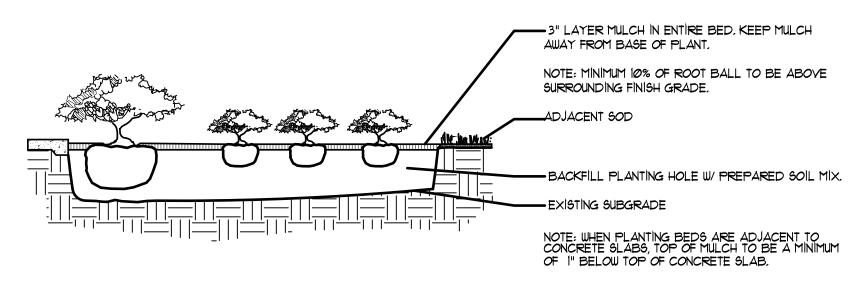

N.T.S.

N.T.S.

SHRUB/GROUND COVER DETAIL

PLANT NOTES

1. ALL PLANT MATERIAL TO BE FLORIDA NO. 1 OR BETTER FLORIDA DEPARTMENT OF AGRICULTURE GRADES AND STANDARDS PARTS 1 AND 11, 2ND EDITION: FEBRUARY 1998, RESPECTIVELY.

2. ALL PLANTING BEDS TO BE TOPPED WITH 3" MULCH EXCLUDING TOP OF ROOT BALL (SEE PALM/ TREE PLANTING DETAIL).

3. ALLTREES TO BE STAKED IN A GOOD WORKMANLIKE MANNER, NO NAIL STAKING IN TRUNKS PERMITTED.

4. LANDSCAPE PLAN SHALL BE INSTALLED IN COMPLIANCE WITH ALL LOCAL CODES.

5. ALL SOD SHALL BE ST. AUGUSTINE 'FLORATAM' SOLID SOD, (UNLESS OTHERWISE NOTED) AND LAID WITH ALTERNATING AND ABUTTING JOINTS.


6. ALL PLANTING BEDS TO BE WEED AND GRASS FREE.

1. LANDSCAPE CONTRACTOR SHALL REVIEW ALL DRAWINGS AND PREPARE ONES OWN QUANTITY COUNTS(PRIOR TO BID COST AND COMPARE TO ARCHITECT'S PLANT LIST), LANDSCAPE CONTRACTOR IS RESPONSIBLE FOR ATTAINING ACCURATE COUNT OF PLANT MATERIALS SPECIFIED. IN THE EVENT OF DISCREPANCIES, LANDSCAPE CONTRACTORS SHALL BRING TO THE ATTENTION OF LANDSCAPE ARCHITECT. PLAN SHALL TAKE PRECEDENCE OVER PLANT LIST.


8. LANDSCAPE CONTRACTOR SHALL LOCATE AND VERIFY ALL UNDER-GROUND UTILITIES PRIOR TO DIGGING.

9. NO CHANGES SHALL BE MADE WITHOUT THE PRIOR CONSENT OF THE LANDSCAPE ARCHITECT.

10, ALL PLANTED AREAS TO RECEIVE 100% COVERAGE BY AN AUTOMATIC IRRIGATION SYSTEM, WITH A MINIMUM OF 50% OVERLAP, RAIN SENSOR TO BE PROVIDED.

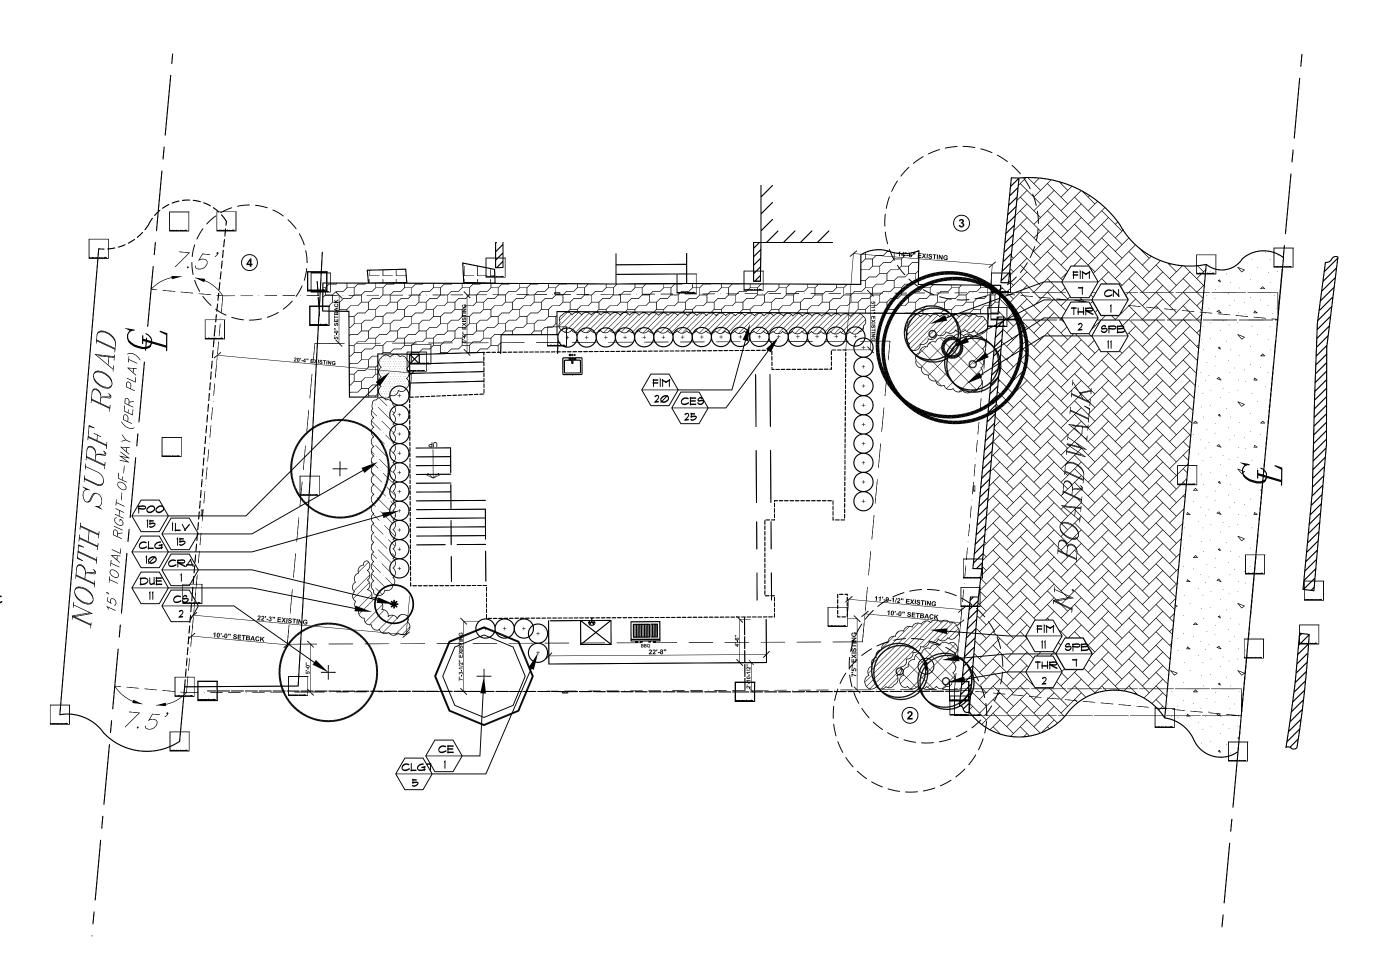

TREES	S & PA	LMS		
QTY	KEY	BOTANICAL NAME	COMMON NAME	DESCRIPTION
1	CN	Cocos nucifera	Coconut Palm	6' gw
1	CE	Conocarpus erectus	Green Buttonwood	12' ht
2	CS	Conocarpus erectus 'sericeus'	Silver Buttonwood	12' ht, std
4	THR	Thrinax radiata	Thatch Palm	6' oa ht
HRUI	3S & C	ROUNDCOVERS	•	•
QTY	KEY	BOTANICAL NAME	COMMON NAME	DESCRIPTION
10	CLG	Clusia guttifera	Clusia	3 gal, 24" ht. full to base
5	CLG7	Clusia guttifera	Clusia	7 gal, 36" ht. full to base
25	CES	Conocarpus erectus 'sericeus'	Silver Buttonwood	3 gal, 24" ht. full to base
1	CRA	Crinum 'red leaf'	Red Leaf Crinum	7 gal, 36" ht
11	DUE	Duranta erecta	Goldmound	3 gal
38	FIM	Ficus microcarpa 'green island'	Green Island Ficus	3 gal
15	ILV	llex vomitoria 'schilling's dwarf	Schilling's Dwarf	3 gal
15	POO	Portulaca 'puerto rico'	Puerto Rico Portulaca	1 gal
18	SPB	Spaerina bakeri	Sandcord Grass	3 gal

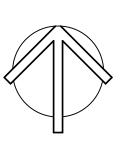

DIEGO J. VANDERBIEST, RLA

REVISIONS

ANDSCAPE PLAI

WRENCE RESIDENCE 2740 NORTH SURF ROAD

12950 Northwest 113 Ct.
Miami, FL 33178
305-884-5700 F. 305-884-8843
wing is the property of Dixie Landscape Co., Inc., an instrument of service not to be reproduced in or in part without the express written permission of

Date 3/5/18

Scale 1"=10'-0"

Drawn DV

Check DV

Sheet

LA 1

Of Sheets



LAWRENCE RESIDENCE

2740 NORTH SURF ROAD HOLLYWOOD, FLORIDA



