

# STORMWATER MANAGEMENT REPORT

PROJECT:

## MEMORIAL REGIONAL HOSPITAL O.R. EXPANSION

Hollywood, Florida

Prepared For:

## THE MEMORIAL HEALTHCARE SYSTEM

Prepared By:

**Calvin, Giordano & Associates, Inc.**



Calvin, Giordano & Associates, Inc.  
EXCEPTIONAL SOLUTIONS™  
1800 Eller Drive, Suite 600 · Fort Lauderdale, FL 33316  
(phone) 954.921.7781 · (fax) 954.266.6487  
Certificate of Authorization #514

**May 2024**

---

**James D. Messick , P.E.**  
**License Number 70870**

This item has been digitally signed and sealed by James D. Messick on the date adjacent to the seal. Printed copies of this document are not considered signed and sealed and the seal must be verified on any electronic copies.

## TABLE OF CONTENTS

	Page
<b>1.0 INTRODUCTION.....</b>	<b>2</b>
<b>2.0 PROJECT BACKGROUND.....</b>	<b>2</b>
<b>3.0 EXISTING CONDITIONS .....</b>	<b>2</b>
<b>4.0 DESIGN CRITERIA AND OVERVIEW.....</b>	<b>4</b>
<b>6.0 CONCLUSION / RECOMMENDATION.....</b>	<b>7</b>
<b>7.0 REFERENCE MATERIAL.....</b>	<b>7</b>

### EXHIBITS

- Exhibit 1            Drainage Area
- Exhibit 2            Broward FEMA Flood map (effective August 18, 2014)
- Exhibit 3            Broward County Future Conditions Average Wet Season Groundwater  
Elevation Map (5/5/2017)
- Exhibit 4            Site Plan
- Exhibit 5            USDA Soil Survey Map
- Exhibit 6            Existing Permits

### APPENDICES

- Appendix-A            Drainage Calculations

## **1.0 INTRODUCTION**

The Memorial Healthcare Systems (the “Owner”) is proposing to expand the existing hospital structure to an additional building area of  $\pm 0.44$  AC (the “Project”). The Project’s scope of work includes associated site infrastructure together with improvements to the existing stormwater management system. The existing Memorial Regional Hospital is located at 3501 Johnson St., Hollywood, FL 33021, with an existing master stormwater license permit for an overall project area of  $\pm 20.80$  AC, the Project site specific area is of  $\pm 4.67$  AC. The proposed improvements to the Memorial Regional Hospital complex are specifically located at the intersection of Hospital Drive and N 37<sup>th</sup> Avenue.

The existing stormwater management system consists of interconnected pipes, structures and exfiltration trench. The proposed stormwater management system includes an exfiltration trench length for the Project site specific area, in addition to the existing underground storage system in place.

This report has been prepared to define and analyze the site conditions and stormwater peak stages that would occur as a result of the post-development site runoff. This report analyzes a pre-development vs post-development scenario for the permitted drainage criterion to establish the requirements for this project. This report describes related information discovered during site reconnaissance and project research.

## **2.0 PROJECT BACKGROUND**

### **2.1 Location**

The proposed project is located in Section 8, Township 51 South, Range 42, Broward County, Florida. The enclosed Location Map includes the approximate limits of the proposed project site.

The Memorial Regional Hospital complex has a Broward County parcel identification number 51-42-07-02-10-00. The complex has a total contributing drainage area of  $\pm 20.80$  AC. The subject property is located within the jurisdiction of South Florida Water Management District (SFWMD), Broward County Environmental Resources and Growth Management Division (BCERGMD), and the City of Hollywood. The subject property is located at the northwest corner of the intersection between Johnson St. and N 35<sup>th</sup> Ave.

### **2.2 Project Description**

The Owner is proposing to expand the existing hospital structure to an additional building area of  $\pm 0.44$  AC. The Project’s scope of work includes associated site infrastructure together with improvements to the existing stormwater management system. The proposed stormwater management system includes an exfiltration trench length for the Project site specific area, in addition to the existing underground storage system in place.

## **3.0 EXISTING CONDITIONS**

### **3.1 Topography**

For the purposes of consistency, the remainder of this report and plans have been prepared utilizing the North American Vertical Datum of 1988 (NAVD).

The existing topography is highly impervious and is relatively flat where the elevations range between 12.60 and 8.50. Refer to the Paving, Grading, & Drainage Plan enclosed.

The FEMA FIRMette Map 12011C0568H indicates that the site is in Zone AH, elevation 10. Refer to Broward FEMA flood map enclosed in the attachments.

### 3.2 USDA Soil Survey

Based on a review of the Custom Soil Survey by the Natural Resources Conservation Service (NRCS) of the United States Department of Agriculture (USDA), there is one (1) type of soil onsite. The site is defined as Urban land. The USDA soil survey map is enclosed. Flatwoods is the soil type used to calculate the site soil storage depth.

### 3.3 Wet Season Water Table/ Control Elevation

According to the Broward County Future Conditions Average Wet Season Groundwater Elevation Map, enclosed, the wet season water table, or control elevation, is 1.50 feet.

### 3.4 Previously Approved Drainage Conditions per BCERGMMD

The Memorial Regional Hospital complex is part of a master permit granted by BCERGMMD SWM1990-088 for a total area of ±20.80 AC. Since the approval of the master permit there have been several modifications to the stormwater license. There are three (3) modifications that are directly associated to the system in the Project site specific area. These are: a. SWM1993-059-0 (related to the parking garage south of Garfield), b. SWM1992-019-6 (related to the central energy plant project on N 37<sup>th</sup> Ave.) and c. SWM1992-019-7 (related to the parking garage west of N 37<sup>th</sup> Ave.)

The permit in place does not limit the exfiltration trench credit to the SFWMD 3.28” maximum exfiltration trench credit rule; therefore, it was not included as part of this analysis.

Permits a, b and c listed above include an exfiltration trench system that provides a total volume of 0.38 ac-ft to the Project site specific area, see enclosed calculations. Finally, the aforementioned permits have an established finished floor elevation (F.F.E.) of 12.60.

The pre-development drainage area includes +/- 0.47 AC of existing roof area runoff attenuation of which +/- 0.19 AC will be redirected to a different stormwater system on the complex under separate permit SWM1992-019-3, by others.

Based on the findings of the existing permits Geotechnical investigations included double-ring infiltration tests, the results obtained revealed an infiltration rate averaging  $6.23 \times 10^{-4}$  cfs/sqft per ft head which is utilized for the exfiltration trench calculations.

**4.0 DESIGN CRITERIA AND OVERVIEW**

**4.1 Proposed Drainage System**

The proposed stormwater management design for the Project site specific area will utilize site grading strategies, series of interconnected inlets, underground drainage exfiltration trench and pipe system to satisfy the stormwater quantity requirements.

**4.2 Water Quality Treatment Volume**

Per Environmental Resource Permit Applicant's Handbook Volume II, Part IV- Stormwater Quality Section 4.2.1.a; the required design treatment volume for new development is the greater of the following:

- a. The first inch of runoff from the entire contributing area
- b. 2.5 inches times the percentage of imperviousness for the contributing area.

**Post-Development Land Uses**

Post-development Land Uses	Area (AC)
Buildings	0.81
Pavement Areas (Roads, sidewalks, misc. impervious)	3.29
Garage Ramp	0.28
Landscape/Grass	0.21
Total Impervious	4.38
Total Pervious	0.21
Total	4.59

**Post-Development Stage Storage**

Post-development Stage Storage Elevation	Site Storage Volume (ac-ft)
1.00	0.00
1.50	0.21
2.00	0.41
2.50	0.62
3.00	0.82
3.50	1.03
4.00	1.23
4.50	1.44
5.00	1.65
5.50	1.85
6.00	2.06
6.50	2.26
7.00	2.47
7.50	2.68
8.00	2.88
8.50	3.09
9.00	3.29
9.50	3.50
10.00	3.63
10.50	3.64
11.00	3.90
11.50	4.62
12.00	5.73
12.50	7.23
13.00	9.40

For the subject property, the greater of the two above-mentioned options is option (b). Based on the post-development land values above, a treatment volume of 0.74 ac-ft is required. This treatment volume corresponds with stage elevation 2.80, which can be found using interpolation of the stage storage table within the exfiltration trench cross section. The calculations for these design parameters are available in the Drainage Calculations enclosed in the Appendices of this report.

#### 4.4 Water Quantity

The storm events utilized to determine minimum inlet elevation, perimeter berm elevation, and FFE are as follows:

- The 5-year/24-hour storm (3.20 inches) was used to determine the minimum inlet grate elevation.
- The 10-year/24-hour storm (9.30 inches) was used to determine minimum road crown elevation.
- The 25-year/72-hour storm (14.41 inches) was used to determine the minimum perimeter berm elevation (for informational purposes; not required).
- The 100-year/72-hour storm (19.37 inches) was used to verify the minimum FFE of 12.60 is adequate.

The TR-55 calculations with no discharge, were completed for the post-development site conditions with the aforementioned details. See the appendices of this report for the Drainage Calculations. Exfiltration trench is utilized for both water quality and water quantity purposes.

### 5.0 DESIGN MODELING, SUMMARY, AND RESULTS

The rainfall data for the 5-year/1-hour, 10-year/24-hour, and 100-year/72-hour has been incorporated in determining the stormwater design for the post-development site conditions in order to attenuate the runoff effectively. The Project has a minimum inlet grates elevation of 10.65, and minimum crown of road elevation of 11.39 with the Finished Floor Elevation at 12.60 and the site will be graded accordingly. The inlets catch runoff from the site and allow it to be routed and treated in the exfiltration trench.

<b>Storm Frequency (Duration-Hour)</b>	<b>Pre-Development Routed Peak Stage Elevation</b>	<b>Post-Development Routed Peak Stage Elevation</b>	<b>Post-Development Design Grading Parameter Elevation</b>
5-year/1-hour	<b>10.95</b>	<b>3.65</b>	10.65 (Min. Inlet)
10-year/24-hour	<b>11.66</b>	<b>9.31</b>	11.39 (Min. Crown of Road)
100-year/72-hour	<b>12.54</b>	<b>12.51</b>	12.60 (Finished Floor Elevation)

These results demonstrate that the proposed elevations meet the requirements set forth by BCERGM.

## **6.0 CONCLUSION / RECOMMENDATION**

The post-development site conditions have been designed with provisions for the safe and efficient control of stormwater runoff in a manner that will not adversely impact the pre-development drainage patterns, adjacent roadways or adjacent parcels. We respectfully request your review and approval of the requested stormwater permits for construction.




## **7.0 REFERENCE MATERIAL**

1. USDA Urban Hydrology for Small Watersheds TR-55
2. SFWMD Environmental Resource Permit Information Manual 2014
3. BCERGMD Design Criteria

REVISION

JAMES D. MESSICK, REGISTERED PROFESSIONAL ENGINEER #70870  
I HEREBY APPROVE AND DIGITALLY SIGN AND SEAL THIS DOCUMENT ON THE DATE INDICATED HERE.  
PRINTED COPIES OF THIS DOCUMENT ARE NOT CONSIDERED SIGNED AND SEALED AND THE SIGNATURE MUST BE VERIFIED ON ANY ELECTRONIC COPIES.

HKS PROJECT NUMBER  
**23459.000**  
DATE  
**JUNE 26, 2023**  
ISSUE  
**DESIGN DEVELOPMENT  
PROGRESS PRINT**  
SHEET TITLE  
**PAVING, GRADING, &  
DRAINAGE PLAN**

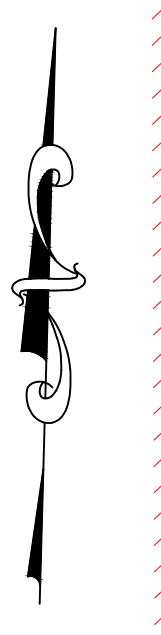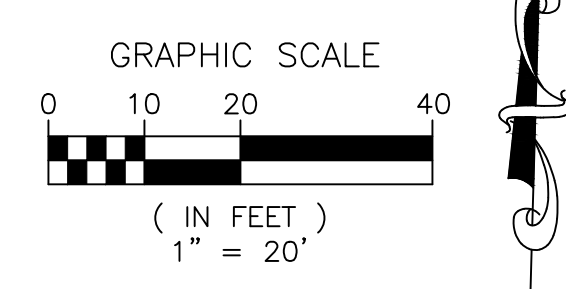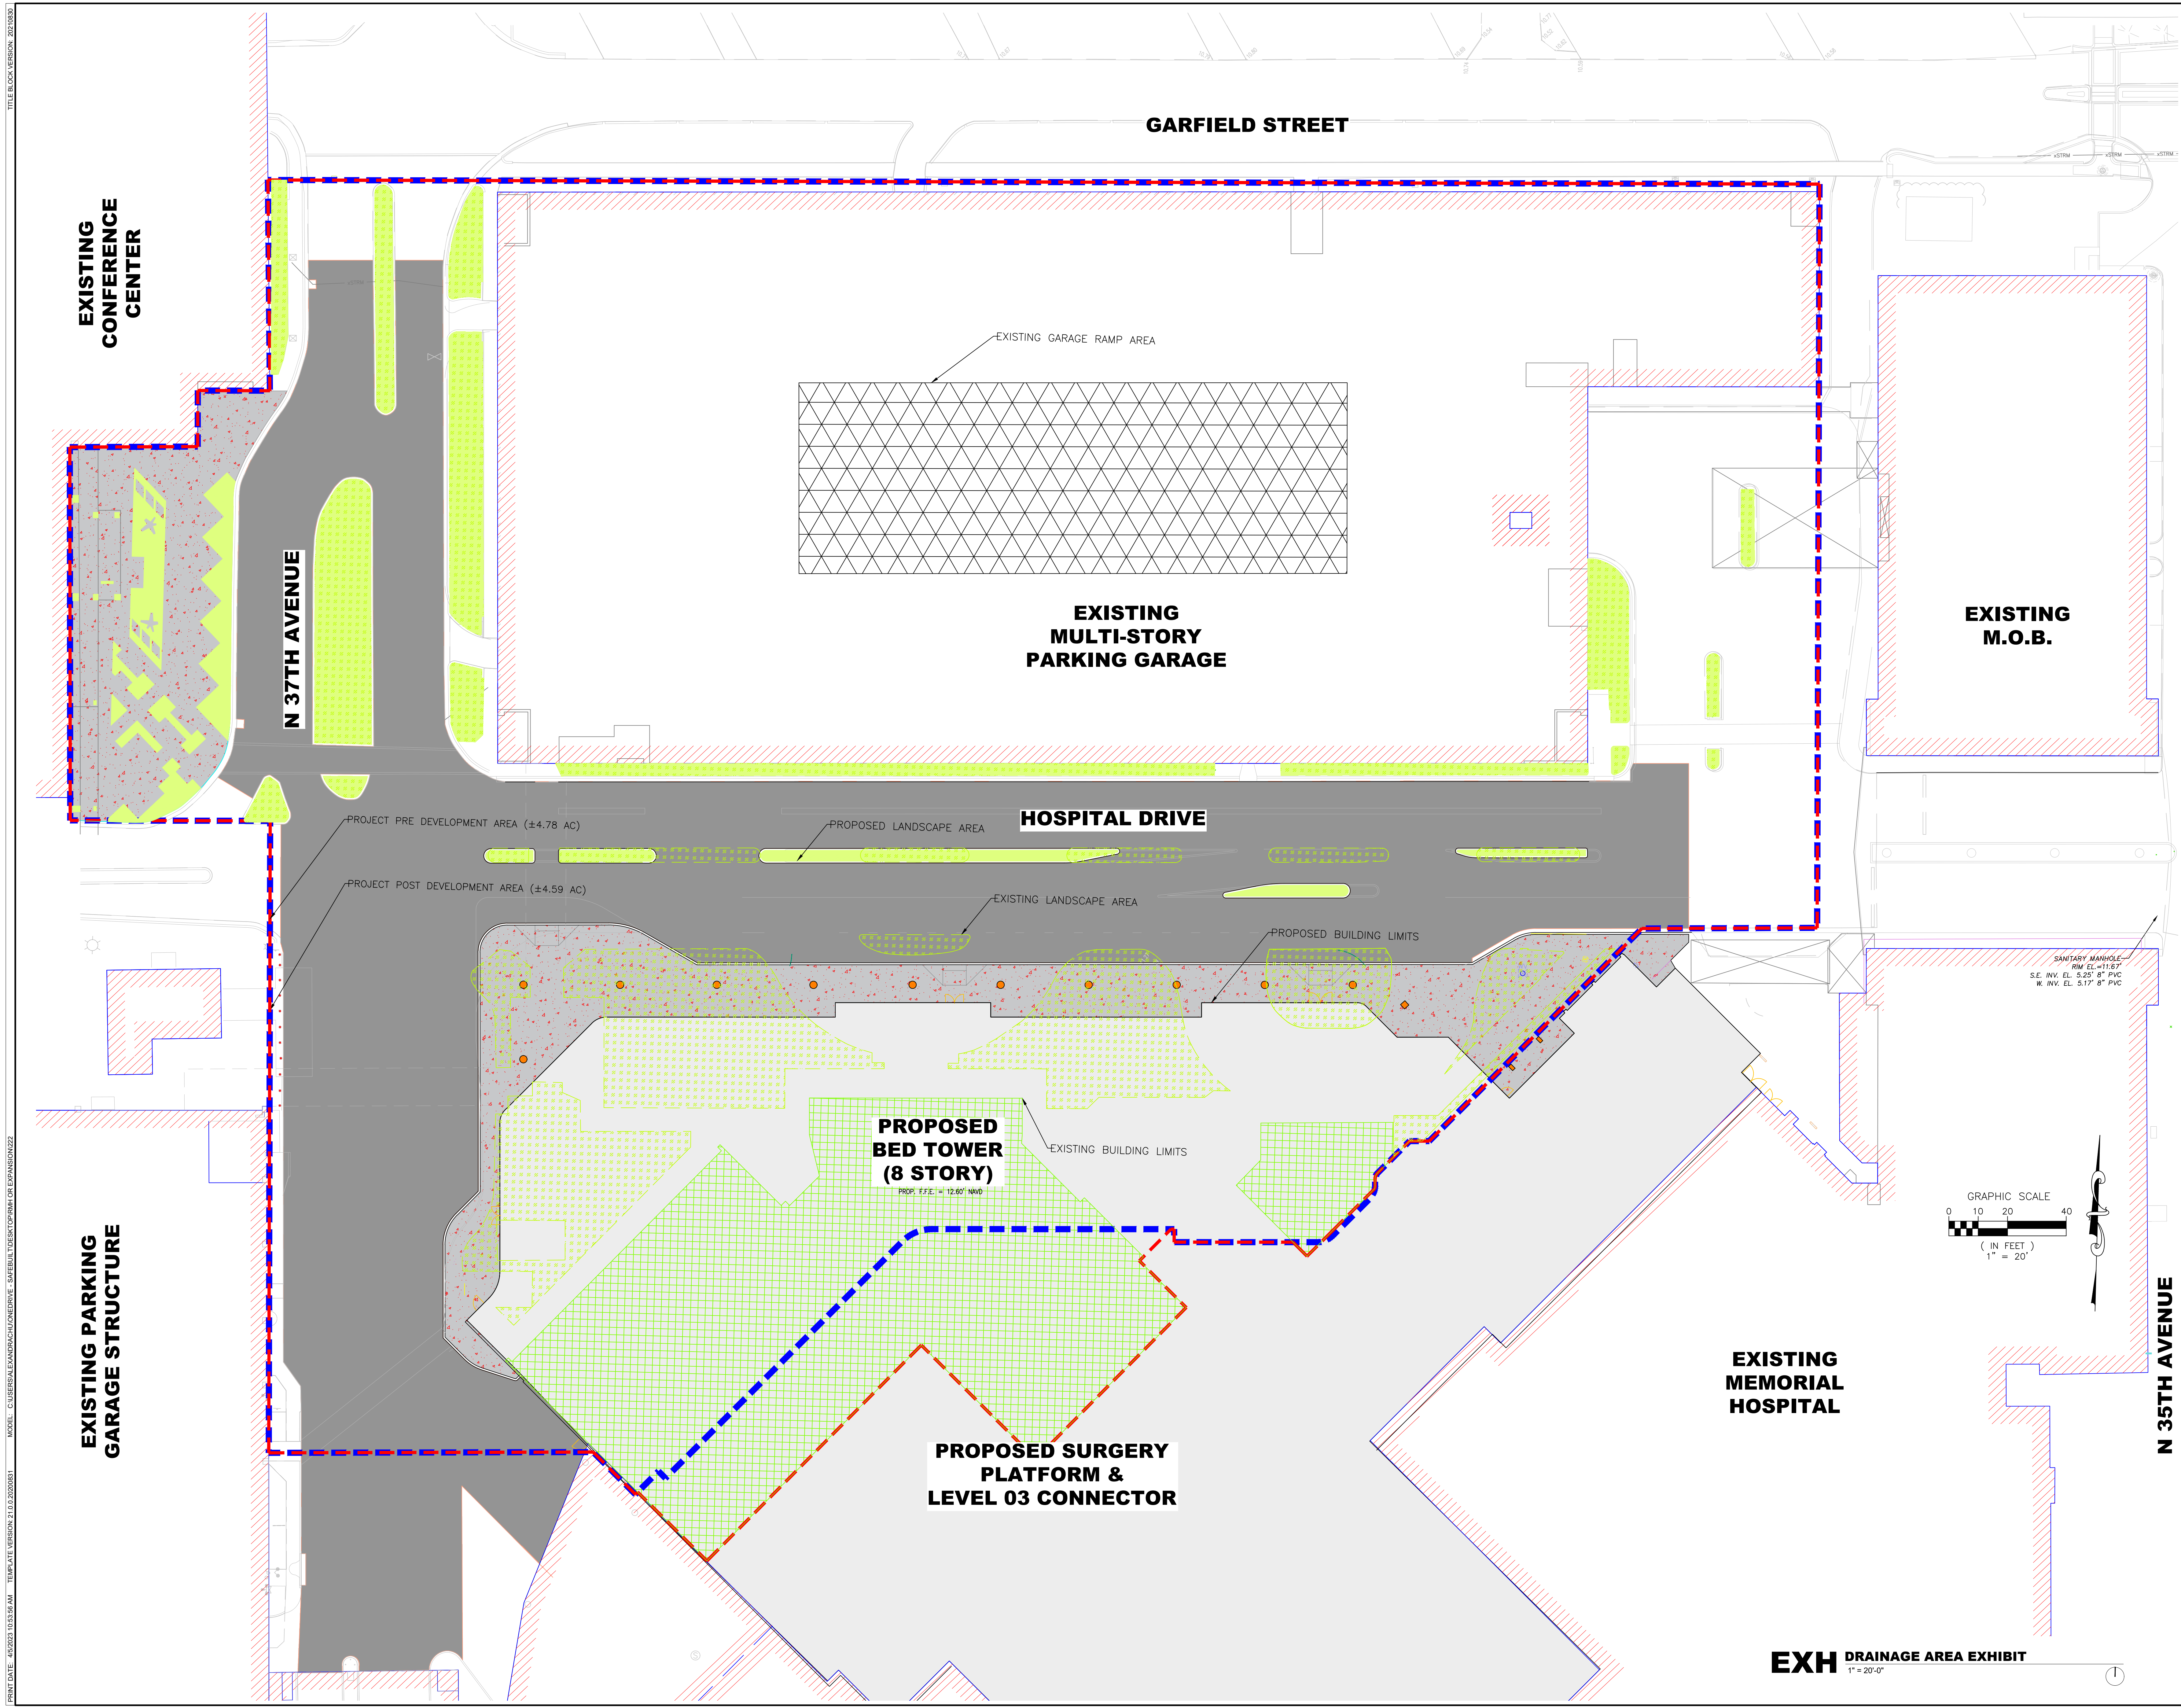

**EXH DRAINAGE AREA EXHIBIT**  
1" = 20'-0"

PRINT DATE: 06/26/2023 10:55:56 AM  
MODEL: C:\USERS\ALEXANDRA\ONE\DRIVE - SATELLITE\DESIGN\PRM OR EXPANSION\222  
TEMPLATE VERSION: 21.0.2020\081






# Broward FEMA Flood Map Effective August 18, 2014

**PLEASE NOTE:**

This map went into effect on August 18, 2014.

**DIRECTIONS:**

- Type in your address in the Find Address box in the upper right hand corner. (Example: 1 NE 5th Street, 33060)
- Once the pop-up box designating the approximate location of your address on the map appears, find your house and click it.
- A new pop-up window will appear with the old and new FEMA flood zone designations for your address. The old zones were in effect prior to August 18, 2014. The new flood zone map was adopted on that date.

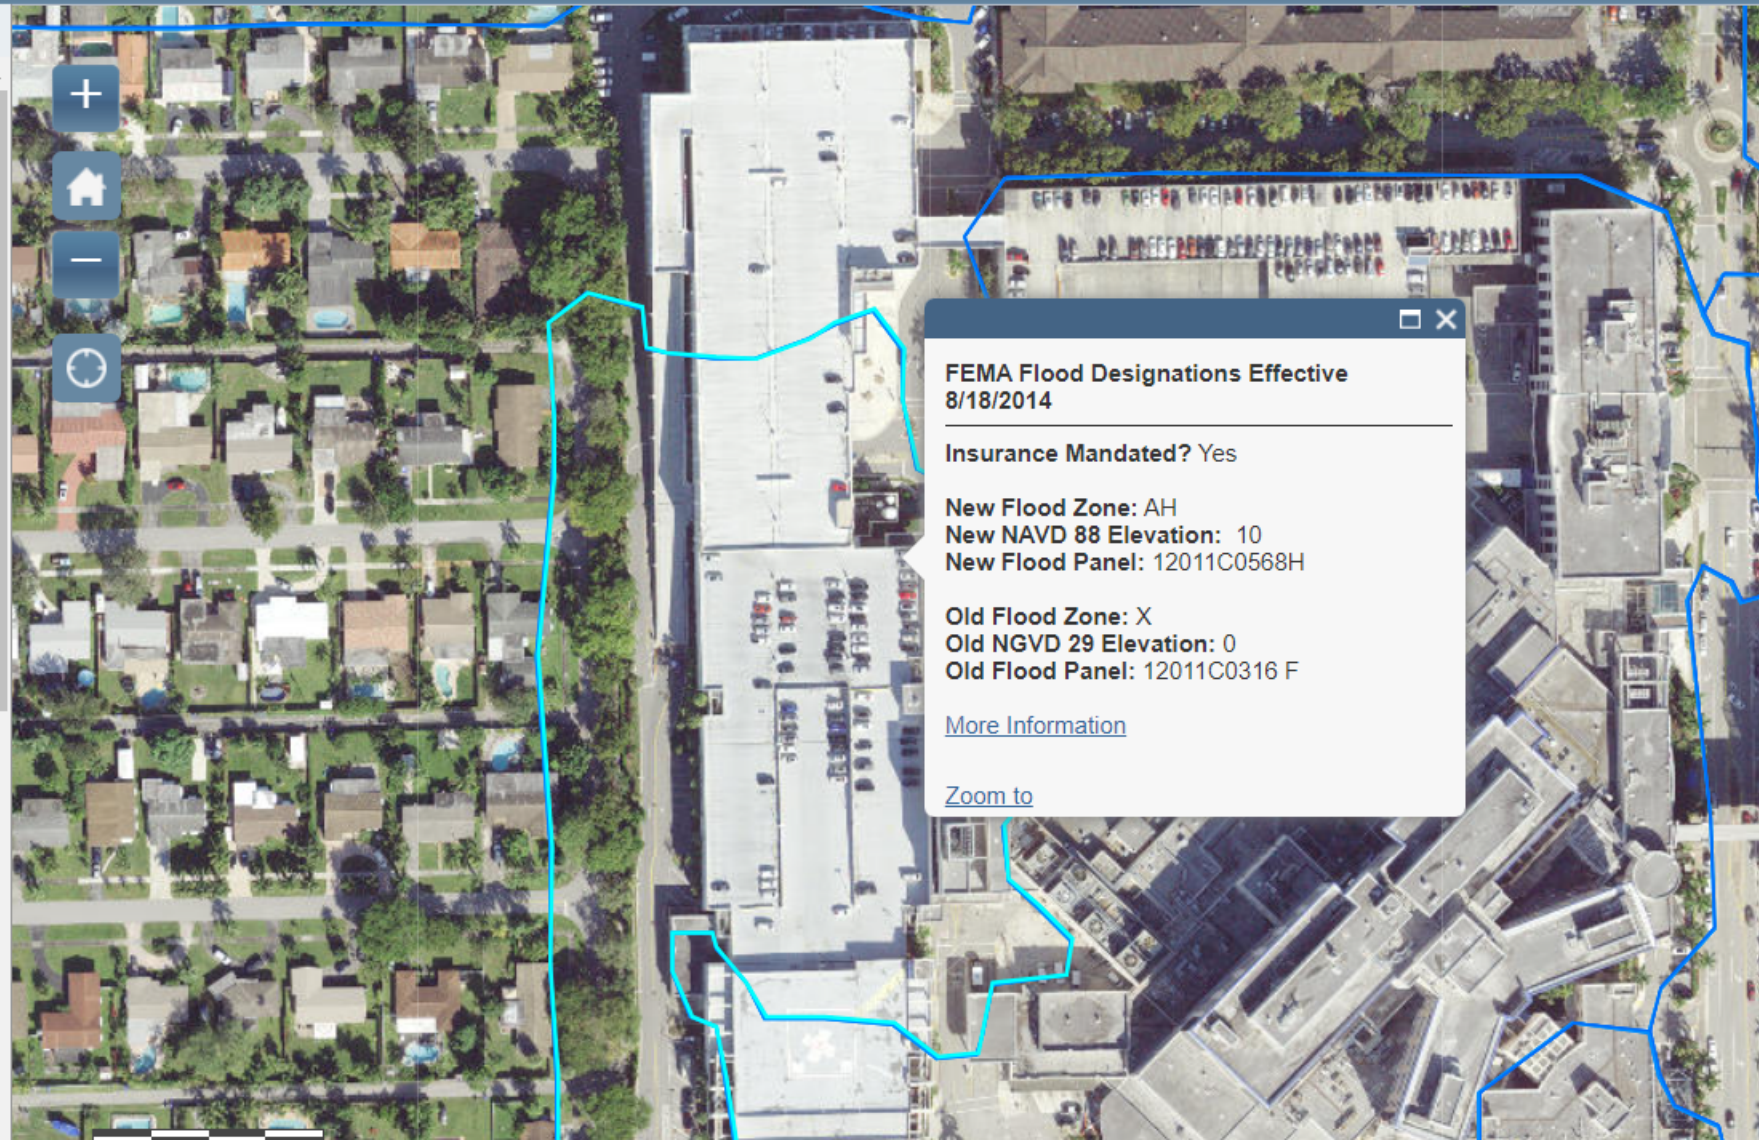

**FEMA Flood Designations Effective 8/18/2014**

---

**Insurance Mandated?** Yes


**New Flood Zone:** AH  
**New NAVD 88 Elevation:** 10  
**New Flood Panel:** 12011C0568H

**Old Flood Zone:** X  
**Old NGVD 29 Elevation:** 0  
**Old Flood Panel:** 12011C0316 F

[More Information](#)

[Zoom to](#)

# MRH OR Expansion - Broward County Future Conditions Average Wet Season Groundwater Elevation Map

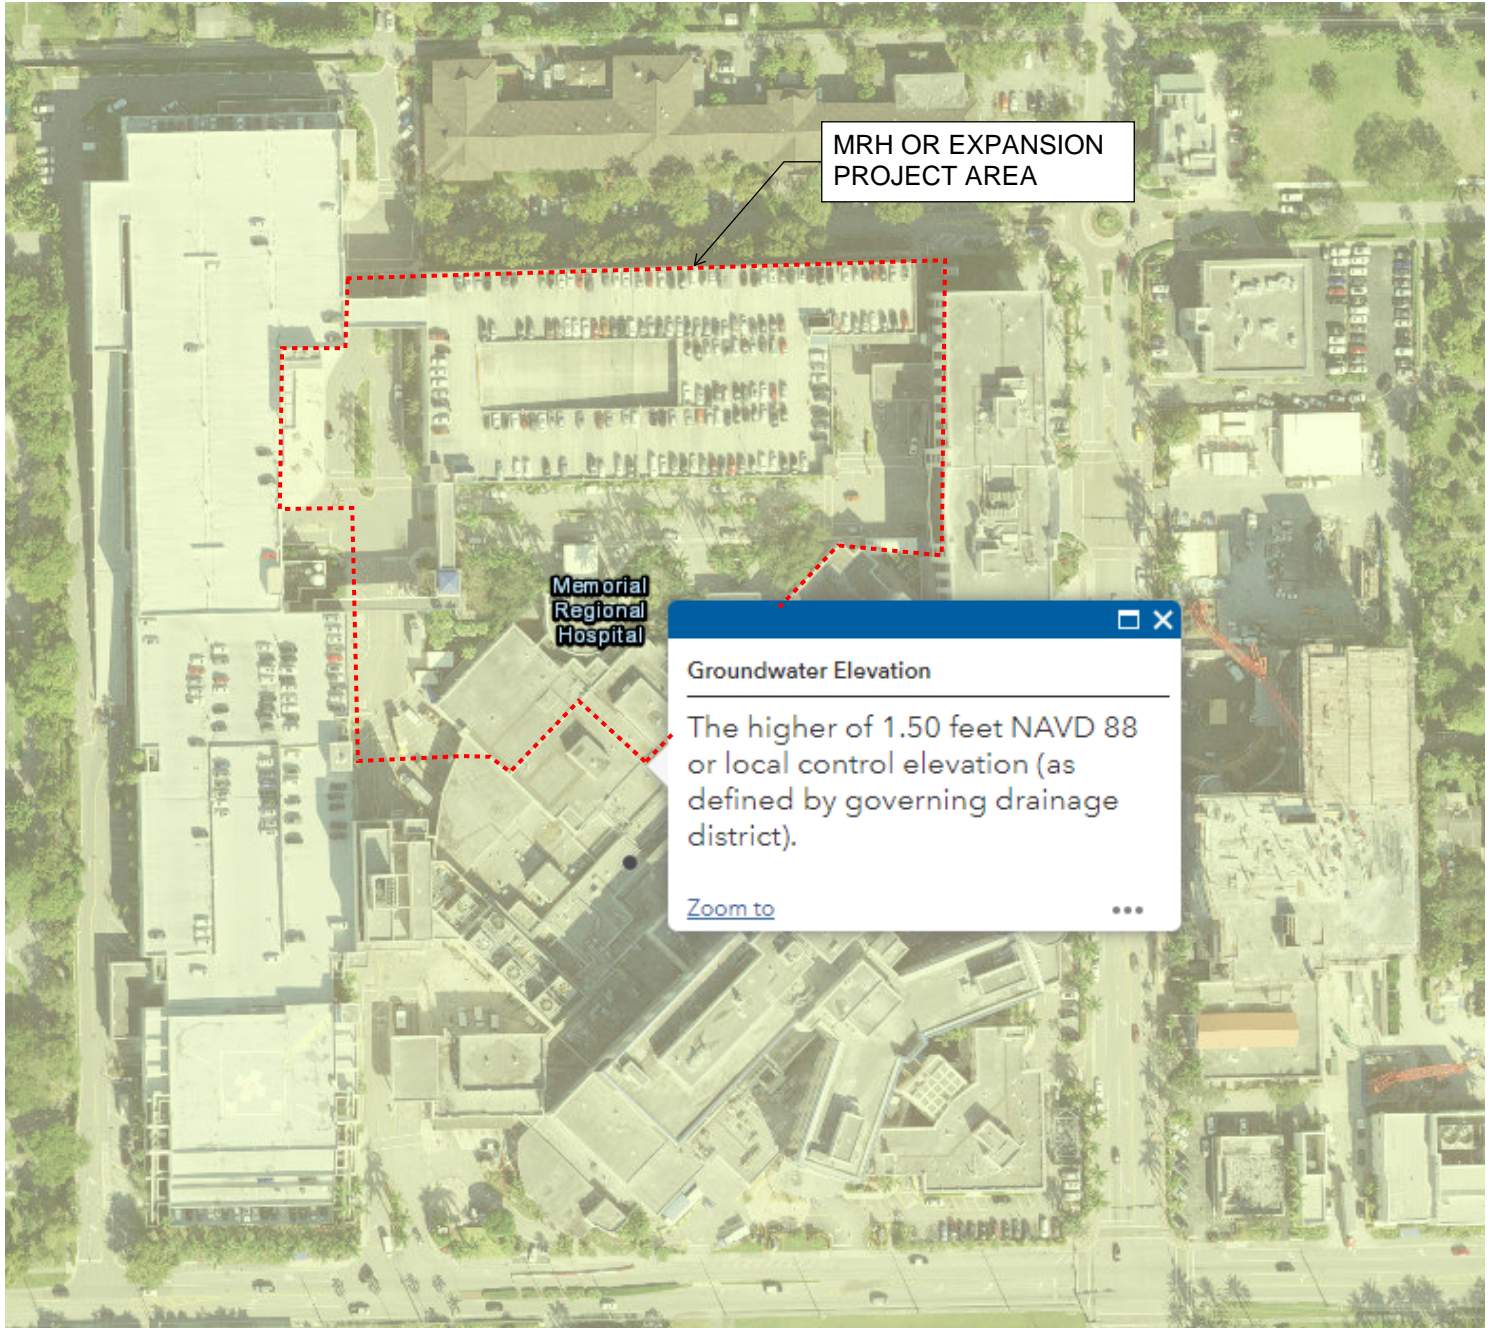




United States  
Department of  
Agriculture

**NRCS**

Natural  
Resources  
Conservation  
Service

A product of the National  
Cooperative Soil Survey,  
a joint effort of the United  
States Department of  
Agriculture and other  
Federal agencies, State  
agencies including the  
Agricultural Experiment  
Stations, and local  
participants

# Custom Soil Resource Report for **Broward County, Florida, East Part**

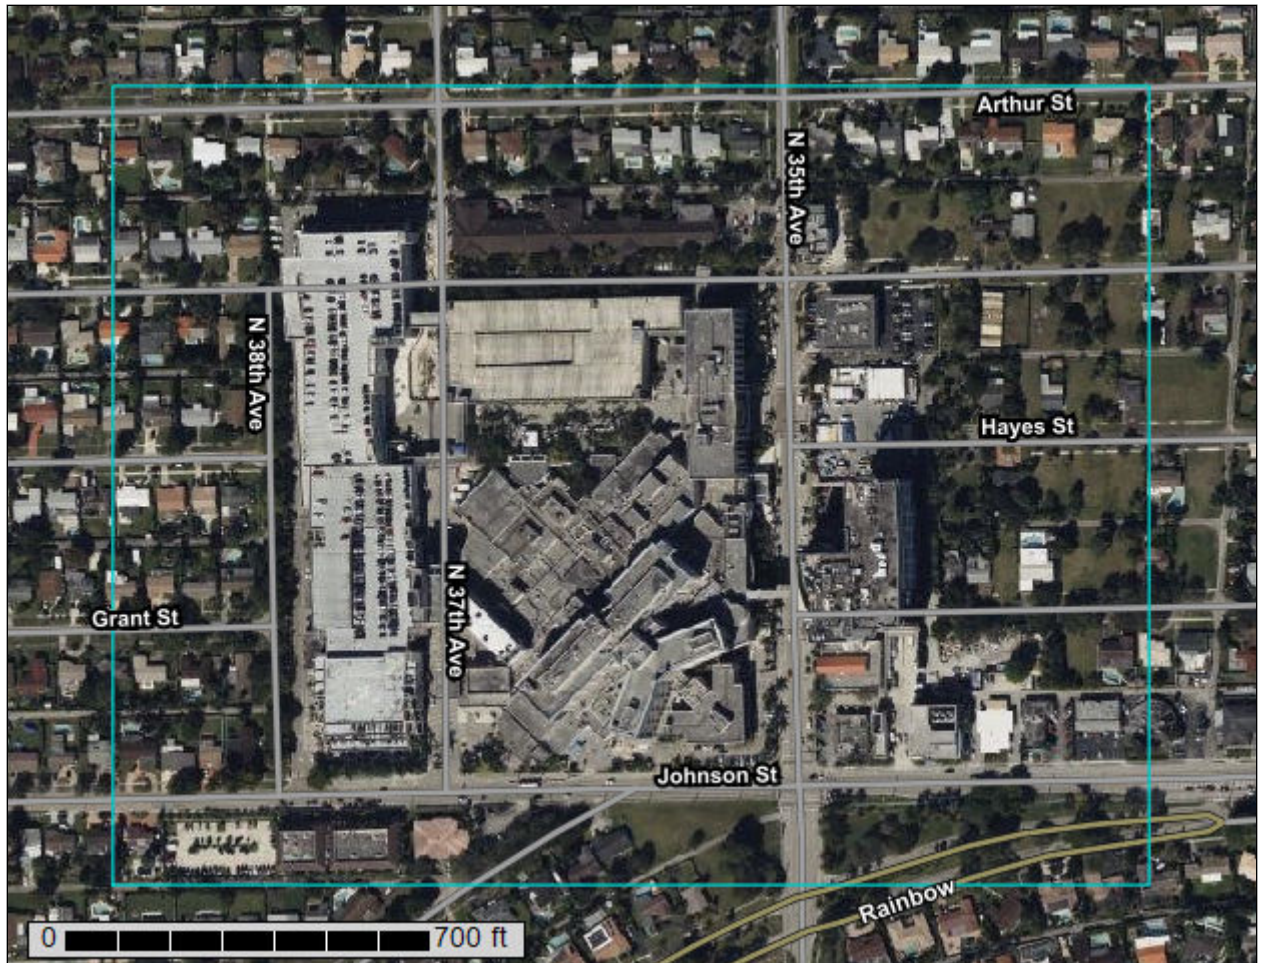

# Preface

---

Soil surveys contain information that affects land use planning in survey areas. They highlight soil limitations that affect various land uses and provide information about the properties of the soils in the survey areas. Soil surveys are designed for many different users, including farmers, ranchers, foresters, agronomists, urban planners, community officials, engineers, developers, builders, and home buyers. Also, conservationists, teachers, students, and specialists in recreation, waste disposal, and pollution control can use the surveys to help them understand, protect, or enhance the environment.

Various land use regulations of Federal, State, and local governments may impose special restrictions on land use or land treatment. Soil surveys identify soil properties that are used in making various land use or land treatment decisions. The information is intended to help the land users identify and reduce the effects of soil limitations on various land uses. The landowner or user is responsible for identifying and complying with existing laws and regulations.

Although soil survey information can be used for general farm, local, and wider area planning, onsite investigation is needed to supplement this information in some cases. Examples include soil quality assessments (<http://www.nrcs.usda.gov/wps/portal/nrcs/main/soils/health/>) and certain conservation and engineering applications. For more detailed information, contact your local USDA Service Center (<https://offices.sc.egov.usda.gov/locator/app?agency=nrcs>) or your NRCS State Soil Scientist ([http://www.nrcs.usda.gov/wps/portal/nrcs/detail/soils/contactus/?cid=nrcs142p2\\_053951](http://www.nrcs.usda.gov/wps/portal/nrcs/detail/soils/contactus/?cid=nrcs142p2_053951)).

Great differences in soil properties can occur within short distances. Some soils are seasonally wet or subject to flooding. Some are too unstable to be used as a foundation for buildings or roads. Clayey or wet soils are poorly suited to use as septic tank absorption fields. A high water table makes a soil poorly suited to basements or underground installations.

The National Cooperative Soil Survey is a joint effort of the United States Department of Agriculture and other Federal agencies, State agencies including the Agricultural Experiment Stations, and local agencies. The Natural Resources Conservation Service (NRCS) has leadership for the Federal part of the National Cooperative Soil Survey.

Information about soils is updated periodically. Updated information is available through the NRCS Web Soil Survey, the site for official soil survey information.

The U.S. Department of Agriculture (USDA) prohibits discrimination in all its programs and activities on the basis of race, color, national origin, age, disability, and where applicable, sex, marital status, familial status, parental status, religion, sexual orientation, genetic information, political beliefs, reprisal, or because all or a part of an individual's income is derived from any public assistance program. (Not all prohibited bases apply to all programs.) Persons with disabilities who require

alternative means for communication of program information (Braille, large print, audiotape, etc.) should contact USDA's TARGET Center at (202) 720-2600 (voice and TDD). To file a complaint of discrimination, write to USDA, Director, Office of Civil Rights, 1400 Independence Avenue, S.W., Washington, D.C. 20250-9410 or call (800) 795-3272 (voice) or (202) 720-6382 (TDD). USDA is an equal opportunity provider and employer.

# Contents

---

<b>Preface</b> .....	2
<b>How Soil Surveys Are Made</b> .....	5
<b>Soil Map</b> .....	8
Soil Map.....	9
Legend.....	10
Map Unit Legend.....	11
Map Unit Descriptions.....	11
Broward County, Florida, East Part.....	13
11—Dade-Urban land complex.....	13
40—Urban land, 0 to 2 percent slopes.....	15
<b>References</b> .....	18

# How Soil Surveys Are Made

---

Soil surveys are made to provide information about the soils and miscellaneous areas in a specific area. They include a description of the soils and miscellaneous areas and their location on the landscape and tables that show soil properties and limitations affecting various uses. Soil scientists observed the steepness, length, and shape of the slopes; the general pattern of drainage; the kinds of crops and native plants; and the kinds of bedrock. They observed and described many soil profiles. A soil profile is the sequence of natural layers, or horizons, in a soil. The profile extends from the surface down into the unconsolidated material in which the soil formed or from the surface down to bedrock. The unconsolidated material is devoid of roots and other living organisms and has not been changed by other biological activity.

Currently, soils are mapped according to the boundaries of major land resource areas (MLRAs). MLRAs are geographically associated land resource units that share common characteristics related to physiography, geology, climate, water resources, soils, biological resources, and land uses (USDA, 2006). Soil survey areas typically consist of parts of one or more MLRA.

The soils and miscellaneous areas in a survey area occur in an orderly pattern that is related to the geology, landforms, relief, climate, and natural vegetation of the area. Each kind of soil and miscellaneous area is associated with a particular kind of landform or with a segment of the landform. By observing the soils and miscellaneous areas in the survey area and relating their position to specific segments of the landform, a soil scientist develops a concept, or model, of how they were formed. Thus, during mapping, this model enables the soil scientist to predict with a considerable degree of accuracy the kind of soil or miscellaneous area at a specific location on the landscape.

Commonly, individual soils on the landscape merge into one another as their characteristics gradually change. To construct an accurate soil map, however, soil scientists must determine the boundaries between the soils. They can observe only a limited number of soil profiles. Nevertheless, these observations, supplemented by an understanding of the soil-vegetation-landscape relationship, are sufficient to verify predictions of the kinds of soil in an area and to determine the boundaries.

Soil scientists recorded the characteristics of the soil profiles that they studied. They noted soil color, texture, size and shape of soil aggregates, kind and amount of rock fragments, distribution of plant roots, reaction, and other features that enable them to identify soils. After describing the soils in the survey area and determining their properties, the soil scientists assigned the soils to taxonomic classes (units). Taxonomic classes are concepts. Each taxonomic class has a set of soil characteristics with precisely defined limits. The classes are used as a basis for comparison to classify soils systematically. Soil taxonomy, the system of taxonomic classification used in the United States, is based mainly on the kind and character of soil properties and the arrangement of horizons within the profile. After the soil



## Custom Soil Resource Report

scientists classified and named the soils in the survey area, they compared the individual soils with similar soils in the same taxonomic class in other areas so that they could confirm data and assemble additional data based on experience and research.

The objective of soil mapping is not to delineate pure map unit components; the objective is to separate the landscape into landforms or landform segments that have similar use and management requirements. Each map unit is defined by a unique combination of soil components and/or miscellaneous areas in predictable proportions. Some components may be highly contrasting to the other components of the map unit. The presence of minor components in a map unit in no way diminishes the usefulness or accuracy of the data. The delineation of such landforms and landform segments on the map provides sufficient information for the development of resource plans. If intensive use of small areas is planned, onsite investigation is needed to define and locate the soils and miscellaneous areas.

Soil scientists make many field observations in the process of producing a soil map. The frequency of observation is dependent upon several factors, including scale of mapping, intensity of mapping, design of map units, complexity of the landscape, and experience of the soil scientist. Observations are made to test and refine the soil-landscape model and predictions and to verify the classification of the soils at specific locations. Once the soil-landscape model is refined, a significantly smaller number of measurements of individual soil properties are made and recorded. These measurements may include field measurements, such as those for color, depth to bedrock, and texture, and laboratory measurements, such as those for content of sand, silt, clay, salt, and other components. Properties of each soil typically vary from one point to another across the landscape.

Observations for map unit components are aggregated to develop ranges of characteristics for the components. The aggregated values are presented. Direct measurements do not exist for every property presented for every map unit component. Values for some properties are estimated from combinations of other properties.

While a soil survey is in progress, samples of some of the soils in the area generally are collected for laboratory analyses and for engineering tests. Soil scientists interpret the data from these analyses and tests as well as the field-observed characteristics and the soil properties to determine the expected behavior of the soils under different uses. Interpretations for all of the soils are field tested through observation of the soils in different uses and under different levels of management. Some interpretations are modified to fit local conditions, and some new interpretations are developed to meet local needs. Data are assembled from other sources, such as research information, production records, and field experience of specialists. For example, data on crop yields under defined levels of management are assembled from farm records and from field or plot experiments on the same kinds of soil.

Predictions about soil behavior are based not only on soil properties but also on such variables as climate and biological activity. Soil conditions are predictable over long periods of time, but they are not predictable from year to year. For example, soil scientists can predict with a fairly high degree of accuracy that a given soil will have a high water table within certain depths in most years, but they cannot predict that a high water table will always be at a specific level in the soil on a specific date.

After soil scientists located and identified the significant natural bodies of soil in the survey area, they drew the boundaries of these bodies on aerial photographs and

## Custom Soil Resource Report


identified each as a specific map unit. Aerial photographs show trees, buildings, fields, roads, and rivers, all of which help in locating boundaries accurately.

# Soil Map

---


The soil map section includes the soil map for the defined area of interest, a list of soil map units on the map and extent of each map unit, and cartographic symbols displayed on the map. Also presented are various metadata about data used to produce the map, and a description of each soil map unit.

# Custom Soil Resource Report Soil Map

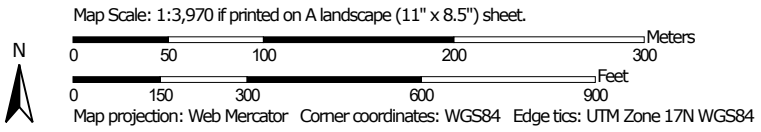

### MAP LEGEND

**Area of Interest (AOI)**

 Area of Interest (AOI)




















**Soils**

 Soil Map Unit Polygons

 Soil Map Unit Lines


 Soil Map Unit Points

**Special Point Features**






-  Blowout
-  Borrow Pit
-  Clay Spot
-  Closed Depression
-  Gravel Pit
-  Gravelly Spot
-  Landfill
-  Lava Flow
-  Marsh or swamp
-  Mine or Quarry
-  Miscellaneous Water
-  Perennial Water
-  Rock Outcrop
-  Saline Spot
-  Sandy Spot
-  Severely Eroded Spot
-  Sinkhole
-  Slide or Slip
-  Sodic Spot

-  Spoil Area
-  Stony Spot
-  Very Stony Spot
-  Wet Spot
-  Other
-  Special Line Features

**Water Features**

 Streams and Canals

**Transportation**

-  Rails
-  Interstate Highways
-  US Routes
-  Major Roads
-  Local Roads

**Background**

 Aerial Photography

### MAP INFORMATION

The soil surveys that comprise your AOI were mapped at 1:20,000.

Warning: Soil Map may not be valid at this scale.

Enlargement of maps beyond the scale of mapping can cause misunderstanding of the detail of mapping and accuracy of soil line placement. The maps do not show the small areas of contrasting soils that could have been shown at a more detailed scale.

Please rely on the bar scale on each map sheet for map measurements.

Source of Map: Natural Resources Conservation Service  
 Web Soil Survey URL:  
 Coordinate System: Web Mercator (EPSG:3857)

Maps from the Web Soil Survey are based on the Web Mercator projection, which preserves direction and shape but distorts distance and area. A projection that preserves area, such as the Albers equal-area conic projection, should be used if more accurate calculations of distance or area are required.

This product is generated from the USDA-NRCS certified data as of the version date(s) listed below.

Soil Survey Area: Broward County, Florida, East Part  
 Survey Area Data: Version 18, Sep 1, 2022

Soil map units are labeled (as space allows) for map scales 1:50,000 or larger.

Date(s) aerial images were photographed: Jan 14, 2022—Jan 24, 2022

The orthophoto or other base map on which the soil lines were compiled and digitized probably differs from the background imagery displayed on these maps. As a result, some minor shifting of map unit boundaries may be evident.

## Map Unit Legend

Map Unit Symbol	Map Unit Name	Acres in AOI	Percent of AOI
11	Dade-Urban land complex	38.9	55.2%
40	Urban land, 0 to 2 percent slopes	31.6	44.8%
<b>Totals for Area of Interest</b>		<b>70.6</b>	<b>100.0%</b>

## Map Unit Descriptions

The map units delineated on the detailed soil maps in a soil survey represent the soils or miscellaneous areas in the survey area. The map unit descriptions, along with the maps, can be used to determine the composition and properties of a unit.

A map unit delineation on a soil map represents an area dominated by one or more major kinds of soil or miscellaneous areas. A map unit is identified and named according to the taxonomic classification of the dominant soils. Within a taxonomic class there are precisely defined limits for the properties of the soils. On the landscape, however, the soils are natural phenomena, and they have the characteristic variability of all natural phenomena. Thus, the range of some observed properties may extend beyond the limits defined for a taxonomic class. Areas of soils of a single taxonomic class rarely, if ever, can be mapped without including areas of other taxonomic classes. Consequently, every map unit is made up of the soils or miscellaneous areas for which it is named and some minor components that belong to taxonomic classes other than those of the major soils.

Most minor soils have properties similar to those of the dominant soil or soils in the map unit, and thus they do not affect use and management. These are called noncontrasting, or similar, components. They may or may not be mentioned in a particular map unit description. Other minor components, however, have properties and behavioral characteristics divergent enough to affect use or to require different management. These are called contrasting, or dissimilar, components. They generally are in small areas and could not be mapped separately because of the scale used. Some small areas of strongly contrasting soils or miscellaneous areas are identified by a special symbol on the maps. If included in the database for a given area, the contrasting minor components are identified in the map unit descriptions along with some characteristics of each. A few areas of minor components may not have been observed, and consequently they are not mentioned in the descriptions, especially where the pattern was so complex that it was impractical to make enough observations to identify all the soils and miscellaneous areas on the landscape.

The presence of minor components in a map unit in no way diminishes the usefulness or accuracy of the data. The objective of mapping is not to delineate pure taxonomic classes but rather to separate the landscape into landforms or landform segments that have similar use and management requirements. The delineation of such segments on the map provides sufficient information for the development of resource plans. If intensive use of small areas is planned, however,

## Custom Soil Resource Report

onsite investigation is needed to define and locate the soils and miscellaneous areas.

An identifying symbol precedes the map unit name in the map unit descriptions. Each description includes general facts about the unit and gives important soil properties and qualities.

Soils that have profiles that are almost alike make up a *soil series*. Except for differences in texture of the surface layer, all the soils of a series have major horizons that are similar in composition, thickness, and arrangement.

Soils of one series can differ in texture of the surface layer, slope, stoniness, salinity, degree of erosion, and other characteristics that affect their use. On the basis of such differences, a soil series is divided into *soil phases*. Most of the areas shown on the detailed soil maps are phases of soil series. The name of a soil phase commonly indicates a feature that affects use or management. For example, Alpha silt loam, 0 to 2 percent slopes, is a phase of the Alpha series.

Some map units are made up of two or more major soils or miscellaneous areas. These map units are complexes, associations, or undifferentiated groups.

A *complex* consists of two or more soils or miscellaneous areas in such an intricate pattern or in such small areas that they cannot be shown separately on the maps. The pattern and proportion of the soils or miscellaneous areas are somewhat similar in all areas. Alpha-Beta complex, 0 to 6 percent slopes, is an example.

An *association* is made up of two or more geographically associated soils or miscellaneous areas that are shown as one unit on the maps. Because of present or anticipated uses of the map units in the survey area, it was not considered practical or necessary to map the soils or miscellaneous areas separately. The pattern and relative proportion of the soils or miscellaneous areas are somewhat similar. Alpha-Beta association, 0 to 2 percent slopes, is an example.

An *undifferentiated group* is made up of two or more soils or miscellaneous areas that could be mapped individually but are mapped as one unit because similar interpretations can be made for use and management. The pattern and proportion of the soils or miscellaneous areas in a mapped area are not uniform. An area can be made up of only one of the major soils or miscellaneous areas, or it can be made up of all of them. Alpha and Beta soils, 0 to 2 percent slopes, is an example.

Some surveys include *miscellaneous areas*. Such areas have little or no soil material and support little or no vegetation. Rock outcrop is an example.

## Broward County, Florida, East Part

### 11—Dade-Urban land complex

#### Map Unit Setting

*National map unit symbol:* 1hn8q  
*Elevation:* -20 to 30 feet  
*Mean annual precipitation:* 60 to 68 inches  
*Mean annual air temperature:* 72 to 79 degrees F  
*Frost-free period:* 358 to 365 days  
*Farmland classification:* Not prime farmland

#### Map Unit Composition

*Dade and similar soils:* 55 percent  
*Urban land:* 40 percent  
*Minor components:* 5 percent  
*Estimates are based on observations, descriptions, and transects of the mapunit.*

#### Description of Dade

##### Setting

*Landform:* Rises on marine terraces  
*Landform position (three-dimensional):* Interfluve, rise  
*Down-slope shape:* Convex  
*Across-slope shape:* Linear  
*Parent material:* Sandy marine deposits over soft limestone

##### Typical profile

*A - 0 to 8 inches:* gravelly sand  
*E - 8 to 27 inches:* fine sand  
*Bh - 27 to 35 inches:* fine sand  
*Cr - 35 to 39 inches:* weathered bedrock

##### Properties and qualities

*Slope:* 0 to 2 percent  
*Depth to restrictive feature:* 20 to 40 inches to paralithic bedrock  
*Drainage class:* Well drained  
*Runoff class:* Negligible  
*Capacity of the most limiting layer to transmit water (Ksat):* High to very high (1.98 to 19.98 in/hr)  
*Depth to water table:* About 60 to 72 inches  
*Frequency of flooding:* None  
*Frequency of ponding:* None  
*Maximum salinity:* Nonsaline to very slightly saline (0.0 to 2.0 mmhos/cm)  
*Sodium adsorption ratio, maximum:* 4.0  
*Available water supply, 0 to 60 inches:* Very low (about 1.2 inches)

##### Interpretive groups

*Land capability classification (irrigated):* None specified  
*Land capability classification (nonirrigated):* 6s  
*Hydrologic Soil Group:* A  
*Forage suitability group:* Forage suitability group not assigned (G156AC999FL)  
*Other vegetative classification:* Forage suitability group not assigned (G156AC999FL)  
*Hydric soil rating:* No



## Description of Urban Land

### Setting

*Landform:* Marine terraces

*Landform position (three-dimensional):* Interfluve, talf

*Down-slope shape:* Linear

*Across-slope shape:* Linear

### Interpretive groups

*Land capability classification (irrigated):* None specified

*Forage suitability group:* Forage suitability group not assigned (G156AC999FL)

*Other vegetative classification:* Forage suitability group not assigned  
(G156AC999FL)

*Hydric soil rating:* Unranked

## Minor Components

### Basinger

*Percent of map unit:* 2 percent

*Landform:* Drainageways on marine terraces

*Landform position (three-dimensional):* Dip

*Down-slope shape:* Linear

*Across-slope shape:* Concave

*Other vegetative classification:* Forage suitability group not assigned  
(G156AC999FL)

*Hydric soil rating:* Yes

### Immokalee, limestone substratum

*Percent of map unit:* 2 percent

*Landform:* Flatwoods on marine terraces

*Landform position (three-dimensional):* Talf

*Down-slope shape:* Convex

*Across-slope shape:* Linear

*Other vegetative classification:* Forage suitability group not assigned  
(G156AC999FL)

*Hydric soil rating:* No

### Margate

*Percent of map unit:* 1 percent

*Landform:* Drainageways on marine terraces

*Landform position (three-dimensional):* Dip

*Down-slope shape:* Linear

*Across-slope shape:* Concave

*Other vegetative classification:* Forage suitability group not assigned  
(G156AC999FL)

*Hydric soil rating:* Yes

## 40—Urban land, 0 to 2 percent slopes

### Map Unit Setting

*National map unit symbol:* 2x9fc

*Elevation:* 0 to 200 feet

*Mean annual precipitation:* 40 to 68 inches

*Mean annual air temperature:* 68 to 79 degrees F

*Frost-free period:* 345 to 365 days

*Farmland classification:* Not prime farmland

### Map Unit Composition

*Urban land:* 85 percent

*Minor components:* 15 percent

*Estimates are based on observations, descriptions, and transects of the mapunit.*

### Description of Urban Land

#### Setting

*Landform:* Flatwoods on marine terraces, rises on marine terraces, knolls on marine terraces, ridges on marine terraces, hills on marine terraces

*Landform position (two-dimensional):* Summit, backslope

*Landform position (three-dimensional):* Interfluve, side slope, riser, talf, rise

*Down-slope shape:* Linear, convex

*Across-slope shape:* Linear

*Parent material:* No parent material

#### Interpretive groups

*Land capability classification (irrigated):* None specified

*Forage suitability group:* Forage suitability group not assigned (G155XB999FL)

*Other vegetative classification:* Forage suitability group not assigned (G155XB999FL)

*Hydric soil rating:* Unranked

### Minor Components

#### St. augustine

*Percent of map unit:* 3 percent

*Landform:* Marine terraces

*Landform position (three-dimensional):* Tread, rise

*Down-slope shape:* Linear

*Across-slope shape:* Convex

*Other vegetative classification:* Forage suitability group not assigned (G155XB999FL)

*Hydric soil rating:* No

#### Matlacha

*Percent of map unit:* 3 percent

*Landform:* Flats on marine terraces

*Landform position (three-dimensional):* Tread, talf

## Custom Soil Resource Report

*Down-slope shape:* Convex, linear  
*Across-slope shape:* Linear  
*Other vegetative classification:* Forage suitability group not assigned  
(G155XB999FL)  
*Hydric soil rating:* No

### **Adamsville**

*Percent of map unit:* 1 percent  
*Landform:* Knolls on marine terraces, rises on marine terraces  
*Landform position (three-dimensional):* Tread, rise  
*Down-slope shape:* Convex  
*Across-slope shape:* Linear  
*Other vegetative classification:* Sandy soils on rises and knolls of mesic uplands  
(G155XB131FL), Upland Hardwood Hammock (R155XY008FL)  
*Hydric soil rating:* No

### **Eaugallie**

*Percent of map unit:* 1 percent  
*Landform:* Flatwoods on marine terraces  
*Landform position (three-dimensional):* Tread, talf  
*Down-slope shape:* Convex  
*Across-slope shape:* Linear  
*Other vegetative classification:* South Florida Flatwoods (R155XY003FL), Sandy  
soils on flats of mesic or hydric lowlands (G155XB141FL)  
*Hydric soil rating:* No

### **Paola**

*Percent of map unit:* 1 percent  
*Landform:* Knolls on marine terraces, ridges on marine terraces  
*Landform position (two-dimensional):* Summit, backslope  
*Landform position (three-dimensional):* Interfluve, side slope, riser  
*Down-slope shape:* Convex, linear  
*Across-slope shape:* Linear  
*Other vegetative classification:* Sandy soils on ridges and dunes of xeric uplands  
(G155XB111FL), Sand Pine Scrub (R155XY001FL)  
*Hydric soil rating:* No

### **Immokalee**

*Percent of map unit:* 1 percent  
*Landform:* Flatwoods on marine terraces  
*Landform position (three-dimensional):* Riser, talf  
*Down-slope shape:* Linear  
*Across-slope shape:* Linear  
*Other vegetative classification:* Sandy soils on flats of mesic or hydric lowlands  
(G155XB141FL), South Florida Flatwoods (R155XY003FL)  
*Hydric soil rating:* No

### **Brynwood**

*Percent of map unit:* 1 percent  
*Landform:* Flatwoods on marine terraces  
*Landform position (three-dimensional):* Tread, talf  
*Down-slope shape:* Linear  
*Across-slope shape:* Linear  
*Other vegetative classification:* Sandy soils on flats of mesic or hydric lowlands  
(G155XB141FL), South Florida Flatwoods (R155XY003FL)  
*Hydric soil rating:* Yes

## Custom Soil Resource Report

### **Myakka**

*Percent of map unit:* 1 percent

*Landform:* Drainageways on flatwoods on marine terraces

*Landform position (three-dimensional):* Tread, talf, dip

*Down-slope shape:* Linear

*Across-slope shape:* Linear, concave

*Other vegetative classification:* Sandy soils on flats of mesic or hydric lowlands (G155XB141FL), South Florida Flatwoods (R155XY003FL)

*Hydric soil rating:* No

### **Pomello**

*Percent of map unit:* 1 percent

*Landform:* Knolls on marine terraces, ridges on marine terraces

*Landform position (two-dimensional):* Summit, backslope

*Landform position (three-dimensional):* Interfluve, side slope, riser

*Down-slope shape:* Convex, linear

*Across-slope shape:* Linear

*Other vegetative classification:* Sandy soils on rises and knolls of mesic uplands (G155XB131FL), Sand Pine Scrub (R155XY001FL)

*Hydric soil rating:* No

### **Apopka**

*Percent of map unit:* 1 percent

*Landform:* Ridges on marine terraces, hills on marine terraces

*Landform position (two-dimensional):* Summit, backslope

*Landform position (three-dimensional):* Interfluve, side slope, riser

*Down-slope shape:* Convex

*Across-slope shape:* Linear

*Other vegetative classification:* Sandy soils on ridges and dunes of xeric uplands (G155XB111FL), Longleaf Pine-Turkey Oak Hills (R155XY002FL)

*Hydric soil rating:* No

### **Cypress lake**

*Percent of map unit:* 1 percent

*Landform:* Drainageways on marine terraces, flats on marine terraces

*Landform position (three-dimensional):* Tread, dip, talf

*Down-slope shape:* Linear, convex

*Across-slope shape:* Concave, linear

*Other vegetative classification:* Sandy over loamy soils on flats of hydric or mesic lowlands (G155XB241FL), South Florida Flatwoods (R155XY003FL)

*Hydric soil rating:* Yes

# References

---

- American Association of State Highway and Transportation Officials (AASHTO). 2004. Standard specifications for transportation materials and methods of sampling and testing. 24th edition.
- American Society for Testing and Materials (ASTM). 2005. Standard classification of soils for engineering purposes. ASTM Standard D2487-00.
- Cowardin, L.M., V. Carter, F.C. Golet, and E.T. LaRoe. 1979. Classification of wetlands and deep-water habitats of the United States. U.S. Fish and Wildlife Service FWS/OBS-79/31.
- Federal Register. July 13, 1994. Changes in hydric soils of the United States.
- Federal Register. September 18, 2002. Hydric soils of the United States.
- Hurt, G.W., and L.M. Vasilas, editors. Version 6.0, 2006. Field indicators of hydric soils in the United States.
- National Research Council. 1995. Wetlands: Characteristics and boundaries.
- Soil Survey Division Staff. 1993. Soil survey manual. Soil Conservation Service. U.S. Department of Agriculture Handbook 18. [http://www.nrcs.usda.gov/wps/portal/nrcs/detail/national/soils/?cid=nrcs142p2\\_054262](http://www.nrcs.usda.gov/wps/portal/nrcs/detail/national/soils/?cid=nrcs142p2_054262)
- Soil Survey Staff. 1999. Soil taxonomy: A basic system of soil classification for making and interpreting soil surveys. 2nd edition. Natural Resources Conservation Service, U.S. Department of Agriculture Handbook 436. [http://www.nrcs.usda.gov/wps/portal/nrcs/detail/national/soils/?cid=nrcs142p2\\_053577](http://www.nrcs.usda.gov/wps/portal/nrcs/detail/national/soils/?cid=nrcs142p2_053577)
- Soil Survey Staff. 2010. Keys to soil taxonomy. 11th edition. U.S. Department of Agriculture, Natural Resources Conservation Service. [http://www.nrcs.usda.gov/wps/portal/nrcs/detail/national/soils/?cid=nrcs142p2\\_053580](http://www.nrcs.usda.gov/wps/portal/nrcs/detail/national/soils/?cid=nrcs142p2_053580)
- Tiner, R.W., Jr. 1985. Wetlands of Delaware. U.S. Fish and Wildlife Service and Delaware Department of Natural Resources and Environmental Control, Wetlands Section.
- United States Army Corps of Engineers, Environmental Laboratory. 1987. Corps of Engineers wetlands delineation manual. Waterways Experiment Station Technical Report Y-87-1.
- United States Department of Agriculture, Natural Resources Conservation Service. National forestry manual. [http://www.nrcs.usda.gov/wps/portal/nrcs/detail/soils/home/?cid=nrcs142p2\\_053374](http://www.nrcs.usda.gov/wps/portal/nrcs/detail/soils/home/?cid=nrcs142p2_053374)
- United States Department of Agriculture, Natural Resources Conservation Service. National range and pasture handbook. <http://www.nrcs.usda.gov/wps/portal/nrcs/detail/national/landuse/rangepasture/?cid=stelprdb1043084>

## Custom Soil Resource Report


United States Department of Agriculture, Natural Resources Conservation Service. National soil survey handbook, title 430-VI. [http://www.nrcs.usda.gov/wps/portal/nrcs/detail/soils/scientists/?cid=nrcs142p2\\_054242](http://www.nrcs.usda.gov/wps/portal/nrcs/detail/soils/scientists/?cid=nrcs142p2_054242)

United States Department of Agriculture, Natural Resources Conservation Service. 2006. Land resource regions and major land resource areas of the United States, the Caribbean, and the Pacific Basin. U.S. Department of Agriculture Handbook 296. [http://www.nrcs.usda.gov/wps/portal/nrcs/detail/national/soils/?cid=nrcs142p2\\_053624](http://www.nrcs.usda.gov/wps/portal/nrcs/detail/national/soils/?cid=nrcs142p2_053624)

United States Department of Agriculture, Soil Conservation Service. 1961. Land capability classification. U.S. Department of Agriculture Handbook 210. [http://www.nrcs.usda.gov/Internet/FSE\\_DOCUMENTS/nrcs142p2\\_052290.pdf](http://www.nrcs.usda.gov/Internet/FSE_DOCUMENTS/nrcs142p2_052290.pdf)

GARFIELD STREET

PROPERTY LINE REF. POINT

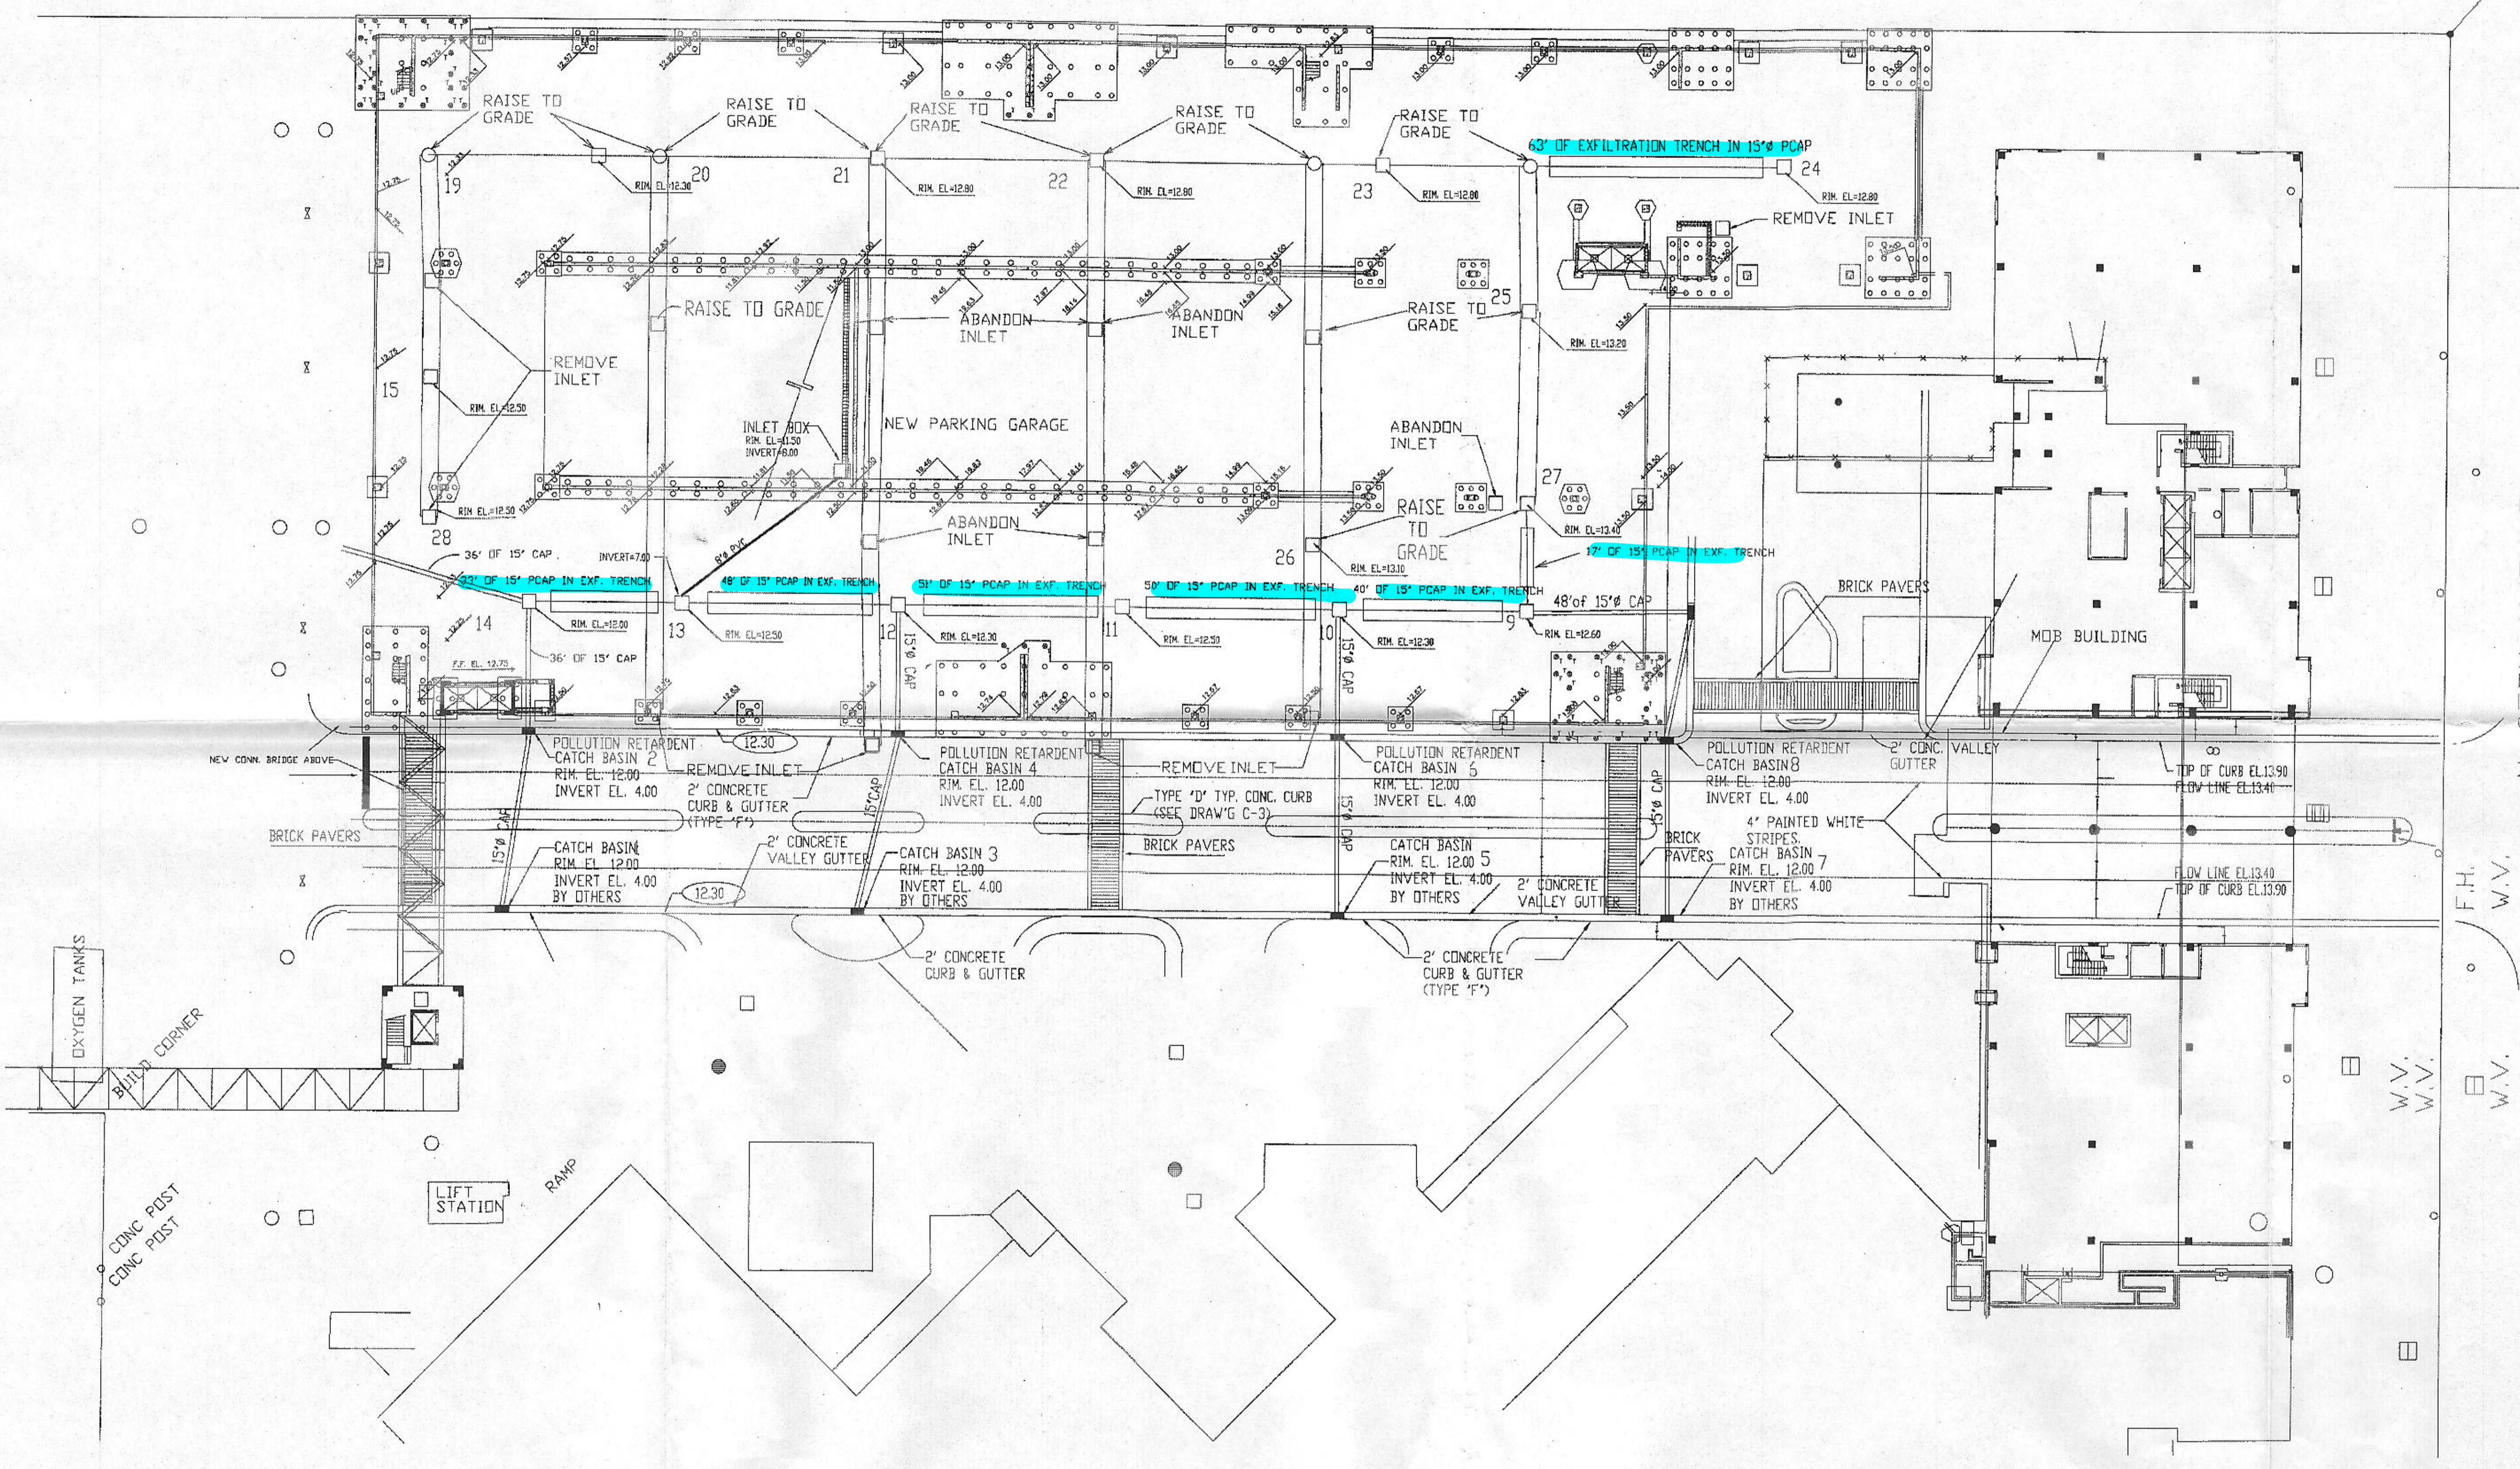

REVISIONS		
Date	Issued For	By
7/23/93	PERMITTING	SP
1/20/94	REVISED DRAINAGE	

I, the undersigned, being a duly licensed Professional Engineer in the State of Florida, do hereby certify that I am the author of the above design and that it was prepared by me or under my direct supervision and that I am a duly licensed Professional Engineer in the State of Florida.

**CHARLES WALTER, P.E., INC.**  
 STRUCTURAL ENGINEERING  
 13230 N.W. 7th Court, Suite 107  
 Fort Lauderdale, Florida 33309  
 Phone (305) 551-1715 Fax (305) 551-1708

**PARKER ENGINEERING COMPANY, INC.**  
 Engineering, Planning and Surveying  
 1027 N.W. 14th Street  
 Fort Lauderdale, Florida 33301  
 Phone (305) 551-1715 Fax (305) 551-1708

**Architecture**  
 Parking Consultants  
 Engineering  
 2540 Lamar Road, Suite 2  
 Fort Lauderdale, Florida 33309  
 Phone (305) 551-1715 Fax (305) 551-1708

**RICH AND ASSOCIATES**  
 ARCHITECTS  
 310 West 1st St., Suite 101  
 Fort Lauderdale, Florida 33301  
 Phone (305) 551-1715 Fax (305) 551-1708

PROPOSED PARKING STRUCTURE FOR  
 MEMORIAL HOSPITAL  
 HOLLYWOOD FLORIDA

**DRAINAGE**

Drawn By	
Checked By	
Approved By	
Approved For	
Construction By	
Date Plotted	

Detail Number	
Sheet	
Location	
Sheet	

File No	2/28/94
Date	2/28/94
Scale	1"=20'
Last Rev.	
Drawn No	

C-1

**RECORD SET  
AS-BUILT DRWGS.**

## MEMORIAL REGIONAL HOSPITAL OR EXPANSION

### SWM1993-059-0 WATER QUALITY CALCULATIONS:

Permitted under Broward County Stormwater License No. SWM1993-059-0 the volume of first inch of runoff from the entire contributing area:

$$= 1.00 \text{ inch} \quad \times \quad 0.540 \text{ acres} \quad \times \quad (1 \text{ foot} / 12 \text{ inches})$$

$$= \mathbf{0.045 \text{ ac-ft for the first inch of runoff required of wet detention storage}}$$

The first inch of runoff from the entire developed site = **0.045 ac-ft**

**The volume permitted is 0.045 ac-ft**

### EXFILTRATION TRENCH CALCULATIONS

Design Formula:  $L = 2 * (0.5 * V_{wq} + V_{add}) / (K * (H_2 * W) + (2 * H_2 * D_u) - (D_u^2) + (2 * H_2 * D_s)) + (1.39 * 10^4 * W * D_u)$   
 Exfiltration Trench Section:

**0.50** Control Water Elevation (NAVD)

Weir Proposed:	<b>No</b>
Weir Elevation:	<b>0.00</b>
$V_{wq}$ = Water Quality Vol. to be Exfiltrated:	<b>0.54 ac-in</b>
W = Trench Width:	<b>6.00 ft.</b>
K = Hydraulic Conductivity:	<b>4.900E-05 cfs/sq-ft per ft head</b>
H <sub>2</sub> = Depth of Water Table:	<b>6.00 ft.</b>
D <sub>u</sub> = Non-Saturated Trench Depth:	<b>6.50 ft.</b>
D <sub>s</sub> = Saturated Trench Depth:	<b>1.00 ft.</b>
Total Exfiltration Trench Depth:	<b>7.50 ft.</b>



Exfiltration Trench Required (Quality):	<b><u>57 ft.</u></b>
Total Maximum Effective Exfiltration Trench Required:	<b><u>57 ft.</u></b>

Exfiltration Trench Provided:	<b><u>309 ft.</u></b>		Per SWM1992-019-0 As-built survey of record
-------------------------------	-----------------------	--	---

Storage/Treatment Volume Provided:



<b>Total Exfiltration Trench Detention Volume:</b>	<b><u>0.045 ac-ft</u></b>
(50% Volume in Pipes) + (50% Voids for length beyond maximum effective length):	<b><u>0.117 ac-ft</u></b>
<b>Total Storage Volume Provided in Exfiltration Trench</b>	<b><u>0.162 ac-ft</u></b>



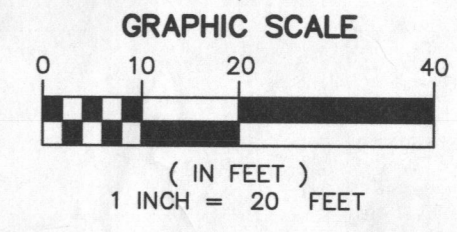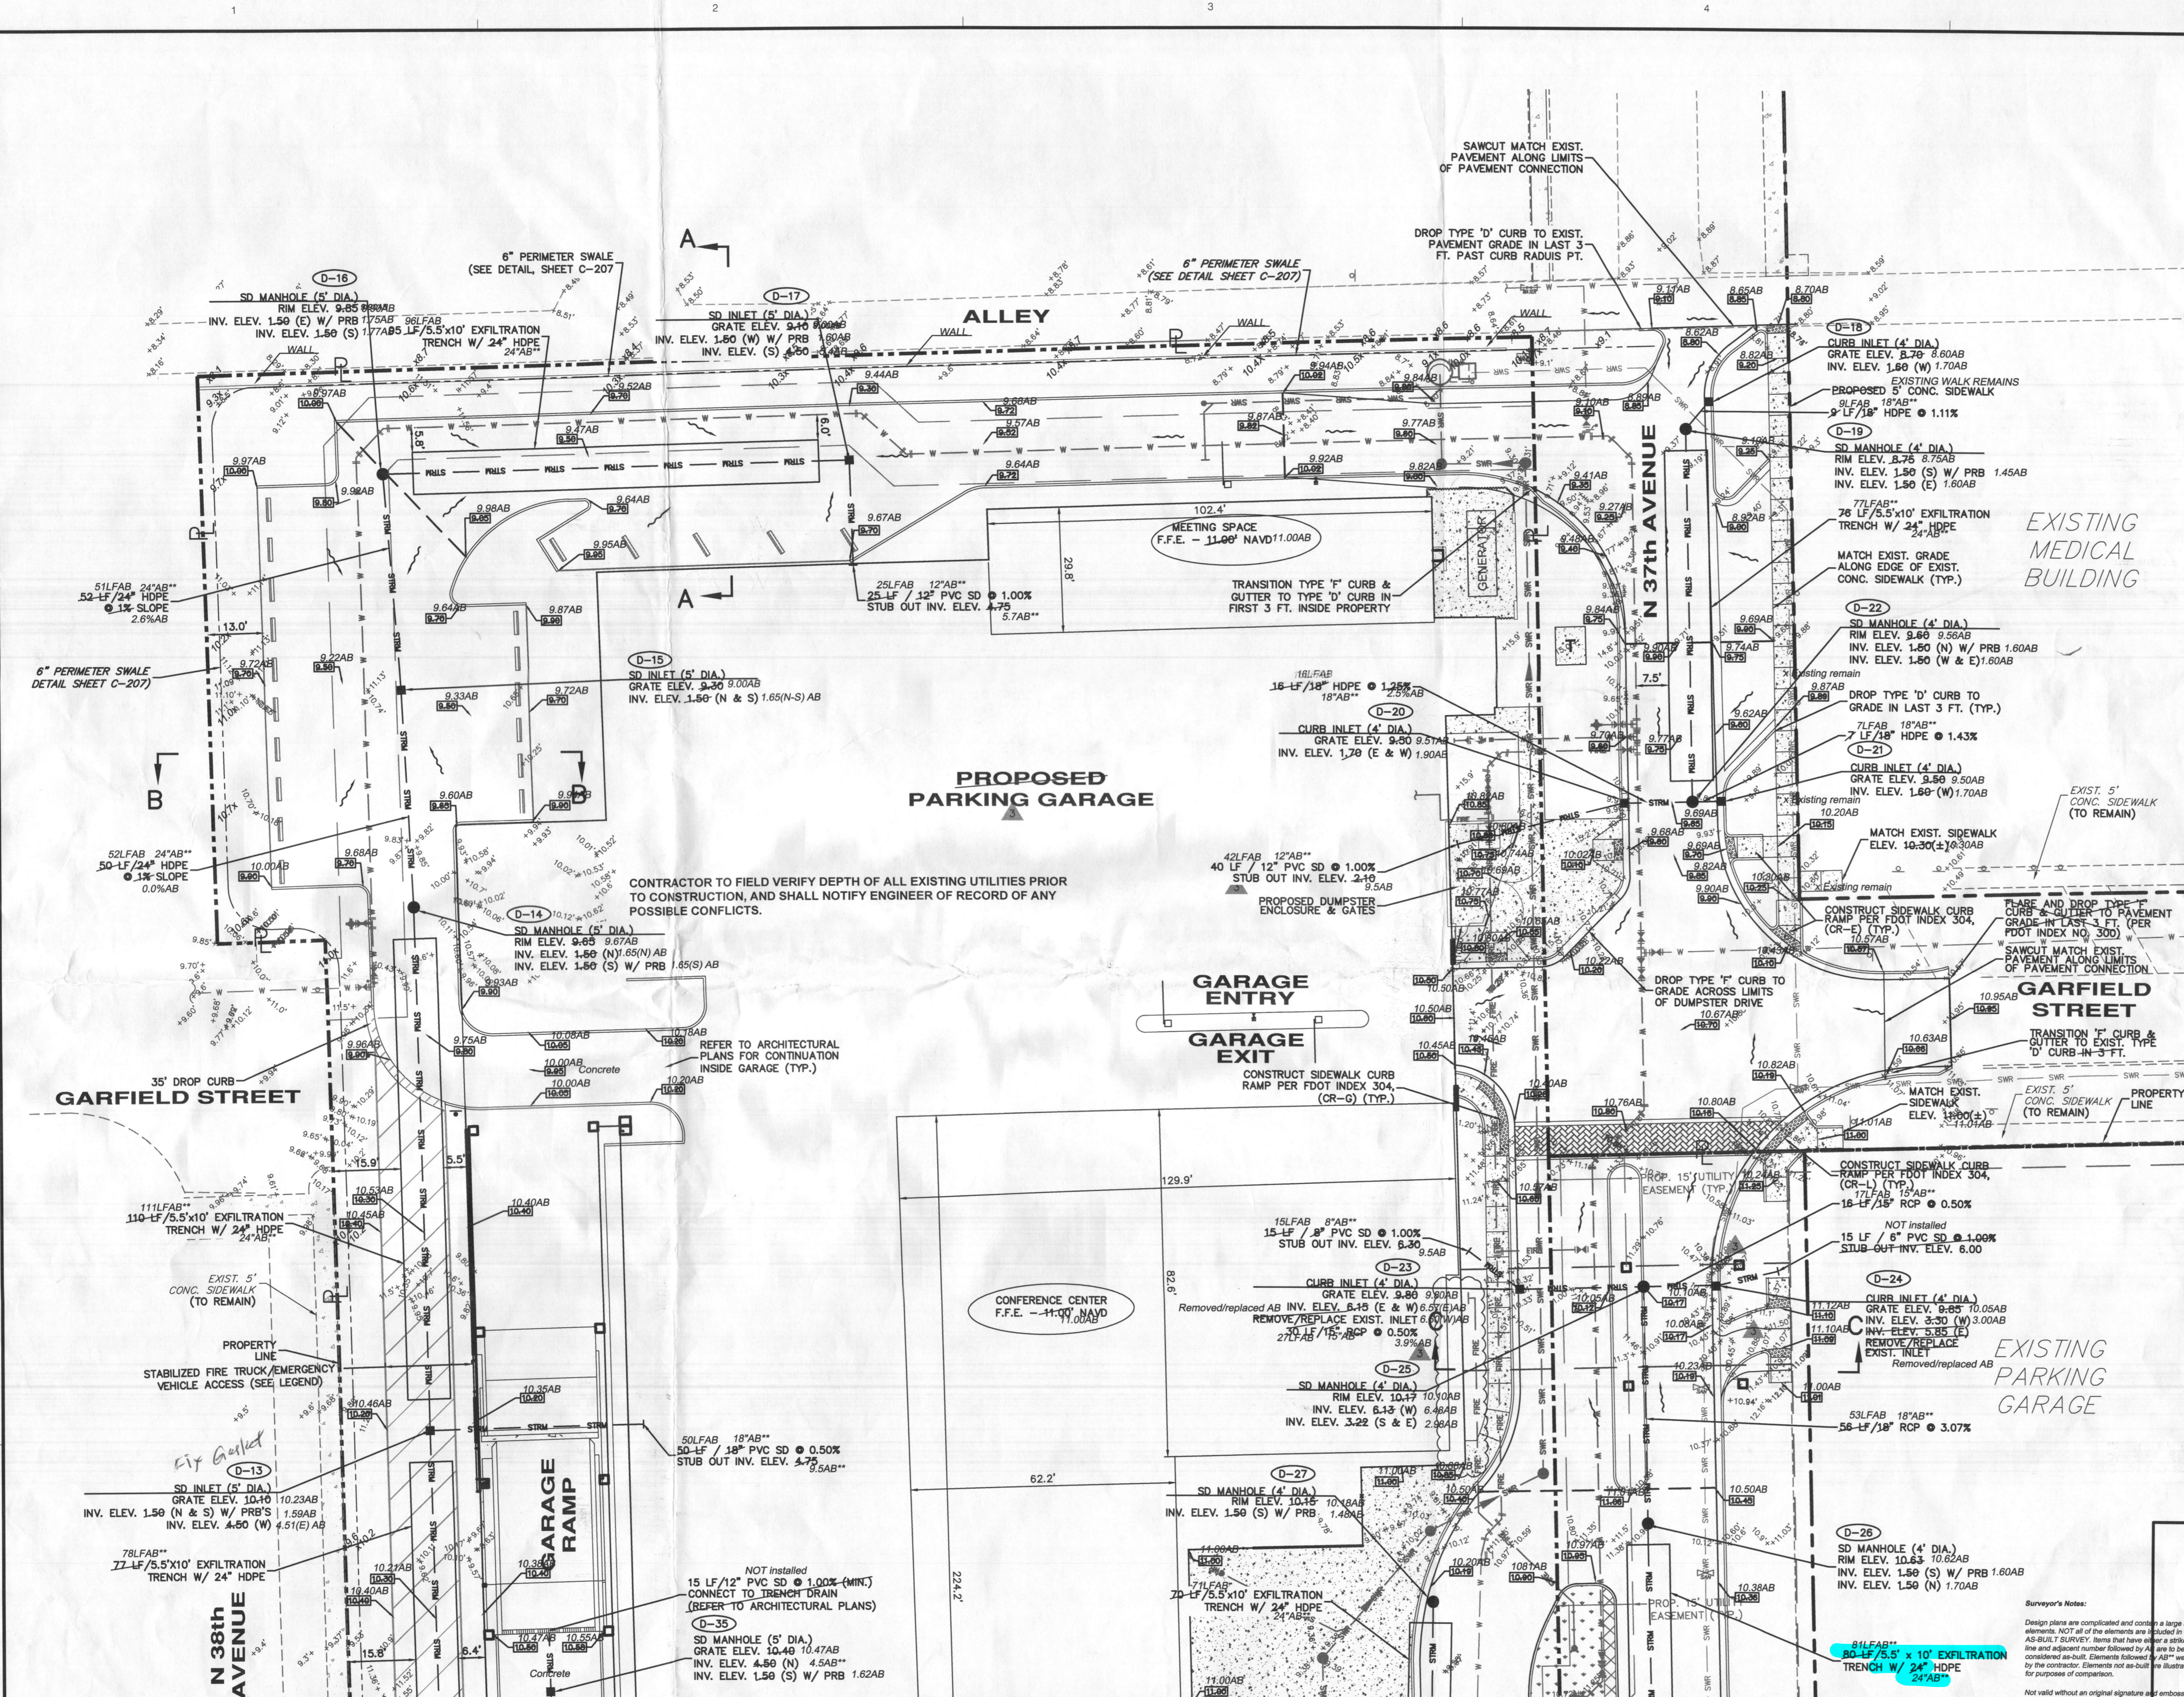

---	---	EXISTING GAS LINE
---	---	EXISTING COMMUNICATION LINE
---	---	EXISTING ELECTRIC LINE
---	---	EXISTING SANITARY SEWER
---	---	EXISTING WATER LINE
---	---	EXISTING STORM DRAIN LINE
---	---	EXISTING ELEVATION FROM SURVEY
---	---	PROPERTY LINE
---	---	RIGHT-OF-WAY LINE
---	---	CENTER LINE OF ROAD
---	---	PROPOSED GAS LINE
---	---	PROPOSED COMMUNICATION LINE
---	---	PROPOSED ELECTRIC LINE
---	---	PROPOSED SANITARY SEWER
---	---	PROPOSED WATER LINE
---	---	PROPOSED STORM DRAIN LINE
---	---	PROPOSED STORM INFILTRATION TRENCH
---	---	PROPOSED FIRE LINE
---	---	GRADE BREAK
---	---	SURFACE FLOW ARROW
---	---	PROPOSED FINISHED PAVEMENT ELEVATION
---	---	PROPOSED CURB INLET / SD INLET
---	---	PROPOSED STORM MANHOLE
---	---	PROPOSED CONCRETE SIDEWALK WITH SCOREMARKS
---	---	PROPOSED ASPHALT PAVEMENT
---	---	STABILIZED FIRE TRUCK / EMERGENCY VEHICLE ACCESS LANE (MIN. 16' WIDE) HAVING GRADE SURF REINFORCED BY CONCRETE GRIDS CAPABLE OF SUPPORTING FIRE TRUCK / APPARATUS WEIGHTING 32 TONS (H=20 WHEEL LOADING)

- PERMIT APPROVALS:
- BROWARD COUNTY ERP NO. 06-03944-P
  - BROWARD COUNTY LICENSE NO. SWM1992-019-7

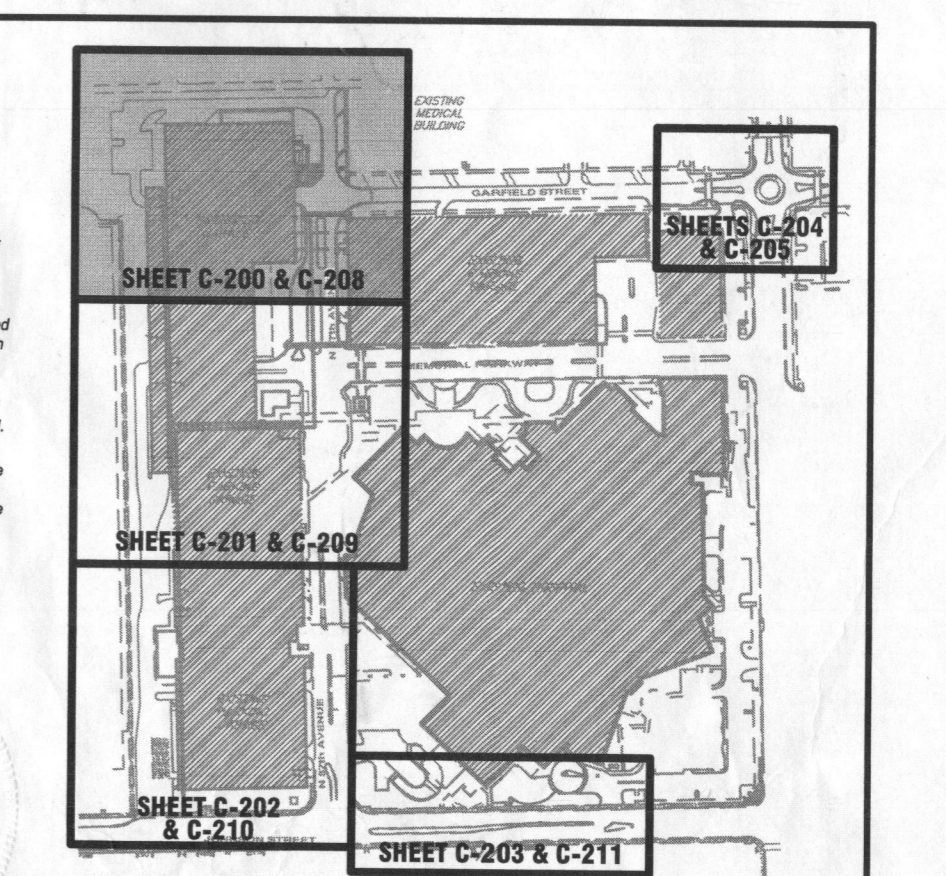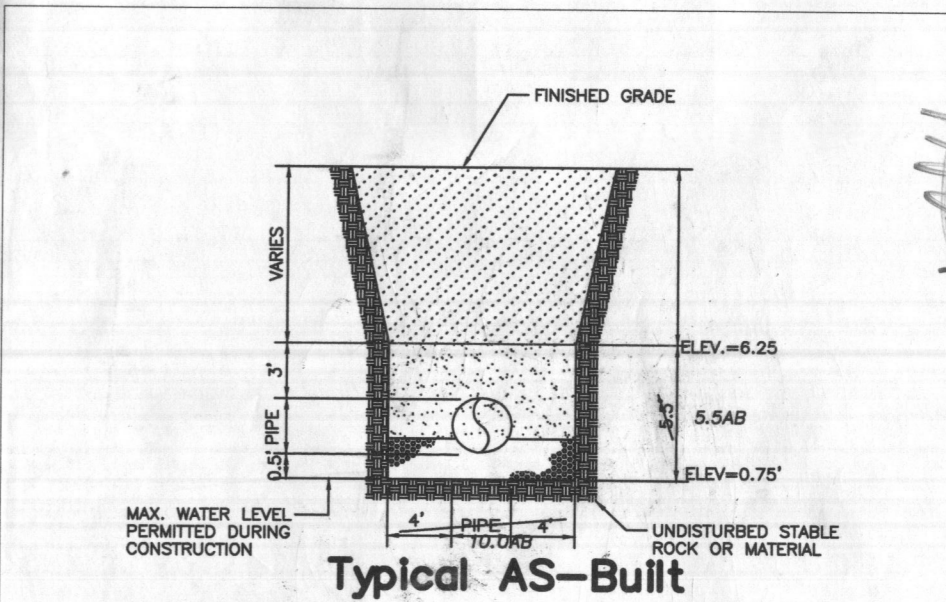

SEE SHEET C-201 FOR CONTINUATION

**AS-BUILT prepared by:**  
**TEAM SURVEYING SOLUTIONS**  
 1120 Southwest 19th Avenue  
 Fort Lauderdale, Florida 33312  
 (954) 709-5995

Structural Engineers  
**DDA ENGINEERS, P.A.**  
 4830 SW 74th Ct. Suite 600  
 Miami, FL 33155  
 (305) 666-0711 Tel  
 (305) 666-5959 Fax

M/E/P Engineers  
**JOHNSON, LEWIS, RAGAN, DAVILA, Inc.**  
 1450 Centre Park Blvd. Suite 350  
 West Palm Beach, FL 33401  
 (561) 682-2303 Tel  
 (561) 682-2302 Fax

Civil/Landscape  
**MILLER LEGG**  
 5747 Norm Andrews Way  
 Fort Lauderdale, FL 33309  
 (954) 938-7000 Tel  
 (954) 483-6539 Fax

Parking Consultant  
**TIMOTHY HARRIS & ASSOCIATES, Inc.**  
 40 NW 3rd St. Suite 1102  
 Miami, FL 33128  
 (305) 322-3233 Tel  
 (305) 322-7113 Fax

**Memorial Healthcare System**  
**Memorial Regional Hospital**  
**NEW PARKING GARAGE**  
 3501 Johnson Street / Hollywood, Florida 33021

Design Build Team  
**STILES | THORNTON**  
**ZYSKOVICH**  
 ARCHITECTS  
 (Miami, FL 33134) (Tel: 305.442.1111) (Fax: 305.442.1111)

Professional Engineer Seal  
**JOAQUIN ANIMADUEBA, P.E.**  
 Reg. No. 60488

Copyright © 2015 ZYSKOVICH, INC.  
 ALL RIGHTS RESERVED. THESE DRAWINGS AND SPECIFICATIONS ARE INSTRUMENTS OF SERVICE AND SHALL REMAIN THE PROPERTY OF ZYSKOVICH, INC. WHETHER THE PROJECT FOR WHICH THEY WERE PREPARED IS EXECUTED OR NOT. THEY ARE NOT TO BE USED IN ANY MANNER ON OTHER PROJECTS OR EXTENDING TO THIS PROJECT EXCEPT BY THE AGREEMENT IN WRITING AND WITH THE APPROPRIATE PERMISSION OF ZYSKOVICH, INC. REPRODUCTION OF SPECIFICATIONS WITHOUT THE WRITTEN CONSENT OF ZYSKOVICH, INC. IS PROHIBITED.

Rev	Date	Note
D	06-24-16	PERMITTING REVISIONS
E	08-04-16	ADD. PERMITTING REVS
1	11-10-16	REVISION #1

**SCANNED**

**PAVING, GRADING AND DRAINAGE PLAN**

1582MRHP 06/24/2016

SEP 06 2017  
**C-200**  
 SURFACE LICENSING PROGRAM

## MEMORIAL REGIONAL HOSPITAL OR EXPANSION

### SWM1992-019-7 WATER QUALITY CALCULATIONS:

Permitted under Broward County Stormwater License No. SWM1992-019-7 the volume of first inch of runoff from the entire contributing area:

$$= 1.00 \text{ inch} \quad \times \quad 0.08 \text{ acres} \quad \times \quad (1 \text{ foot} / 12 \text{ inches})$$

$$= \mathbf{0.007 \text{ ac-ft for the first inch of runoff required of wet detention storage}}$$

The first inch of runoff from the entire developed site = **0.007 ac-ft**

**The volume permitted is 0.007 ac-ft**

### EXFILTRATION TRENCH CALCULATIONS

Design Formula:  $L = 2 * (0.5 * V_{wq} + V_{add}) / (K * (H_2 * W) + (2 * H_2 * D_u) - (D_u^2) + (2 * H_2 * D_s)) + (1.39 * 10^4 * W * D_u)$   
 Exfiltration Trench Section:

**0.50** Control Water Elevation (NAVD)


Weir Proposed:	<b>No</b>
Weir Elevation:	<b>0.00</b>
$V_{wq}$ = Water Quality Vol. to be Exfiltrated:	<b>0.08 ac-in</b>
W = Trench Width:	<b>10.00 ft.</b>
K = Hydraulic Conductivity:	<b>3.910E-04 cfs/sq-ft per ft head</b>
H <sub>2</sub> = Depth of Water Table:	<b>7.50 ft.</b>
D <sub>u</sub> = Non-Saturated Trench Depth:	<b>6.50 ft.</b>
D <sub>s</sub> = Saturated Trench Depth:	<b>0.00 ft.</b>
Total Exfiltration Trench Depth:	<b>5.50 ft.</b>

Exfiltration Trench Required (Quality):	<b><u>1 ft.</u></b>
Total Maximum Effective Exfiltration Trench Required:	<b><u>1 ft.</u></b>

Exfiltration Trench Provided:	<b><u>81 ft.</u></b>		Per SWM1992-019-7 As-built survey of record
-------------------------------	----------------------	--	---

Storage/Treatment Volume Provided:

<b>Total Exfiltration Trench Detention Volume:</b>	<b><u>0.007 ac-ft</u></b>
(50% Volume in Pipes) + (50% Voids for length beyond maximum effective length):	<b><u>0.061 ac-ft</u></b>
<b>Total Storage Volume Provided in Exfiltration Trench</b>	<b><u>0.067 ac-ft</u></b>

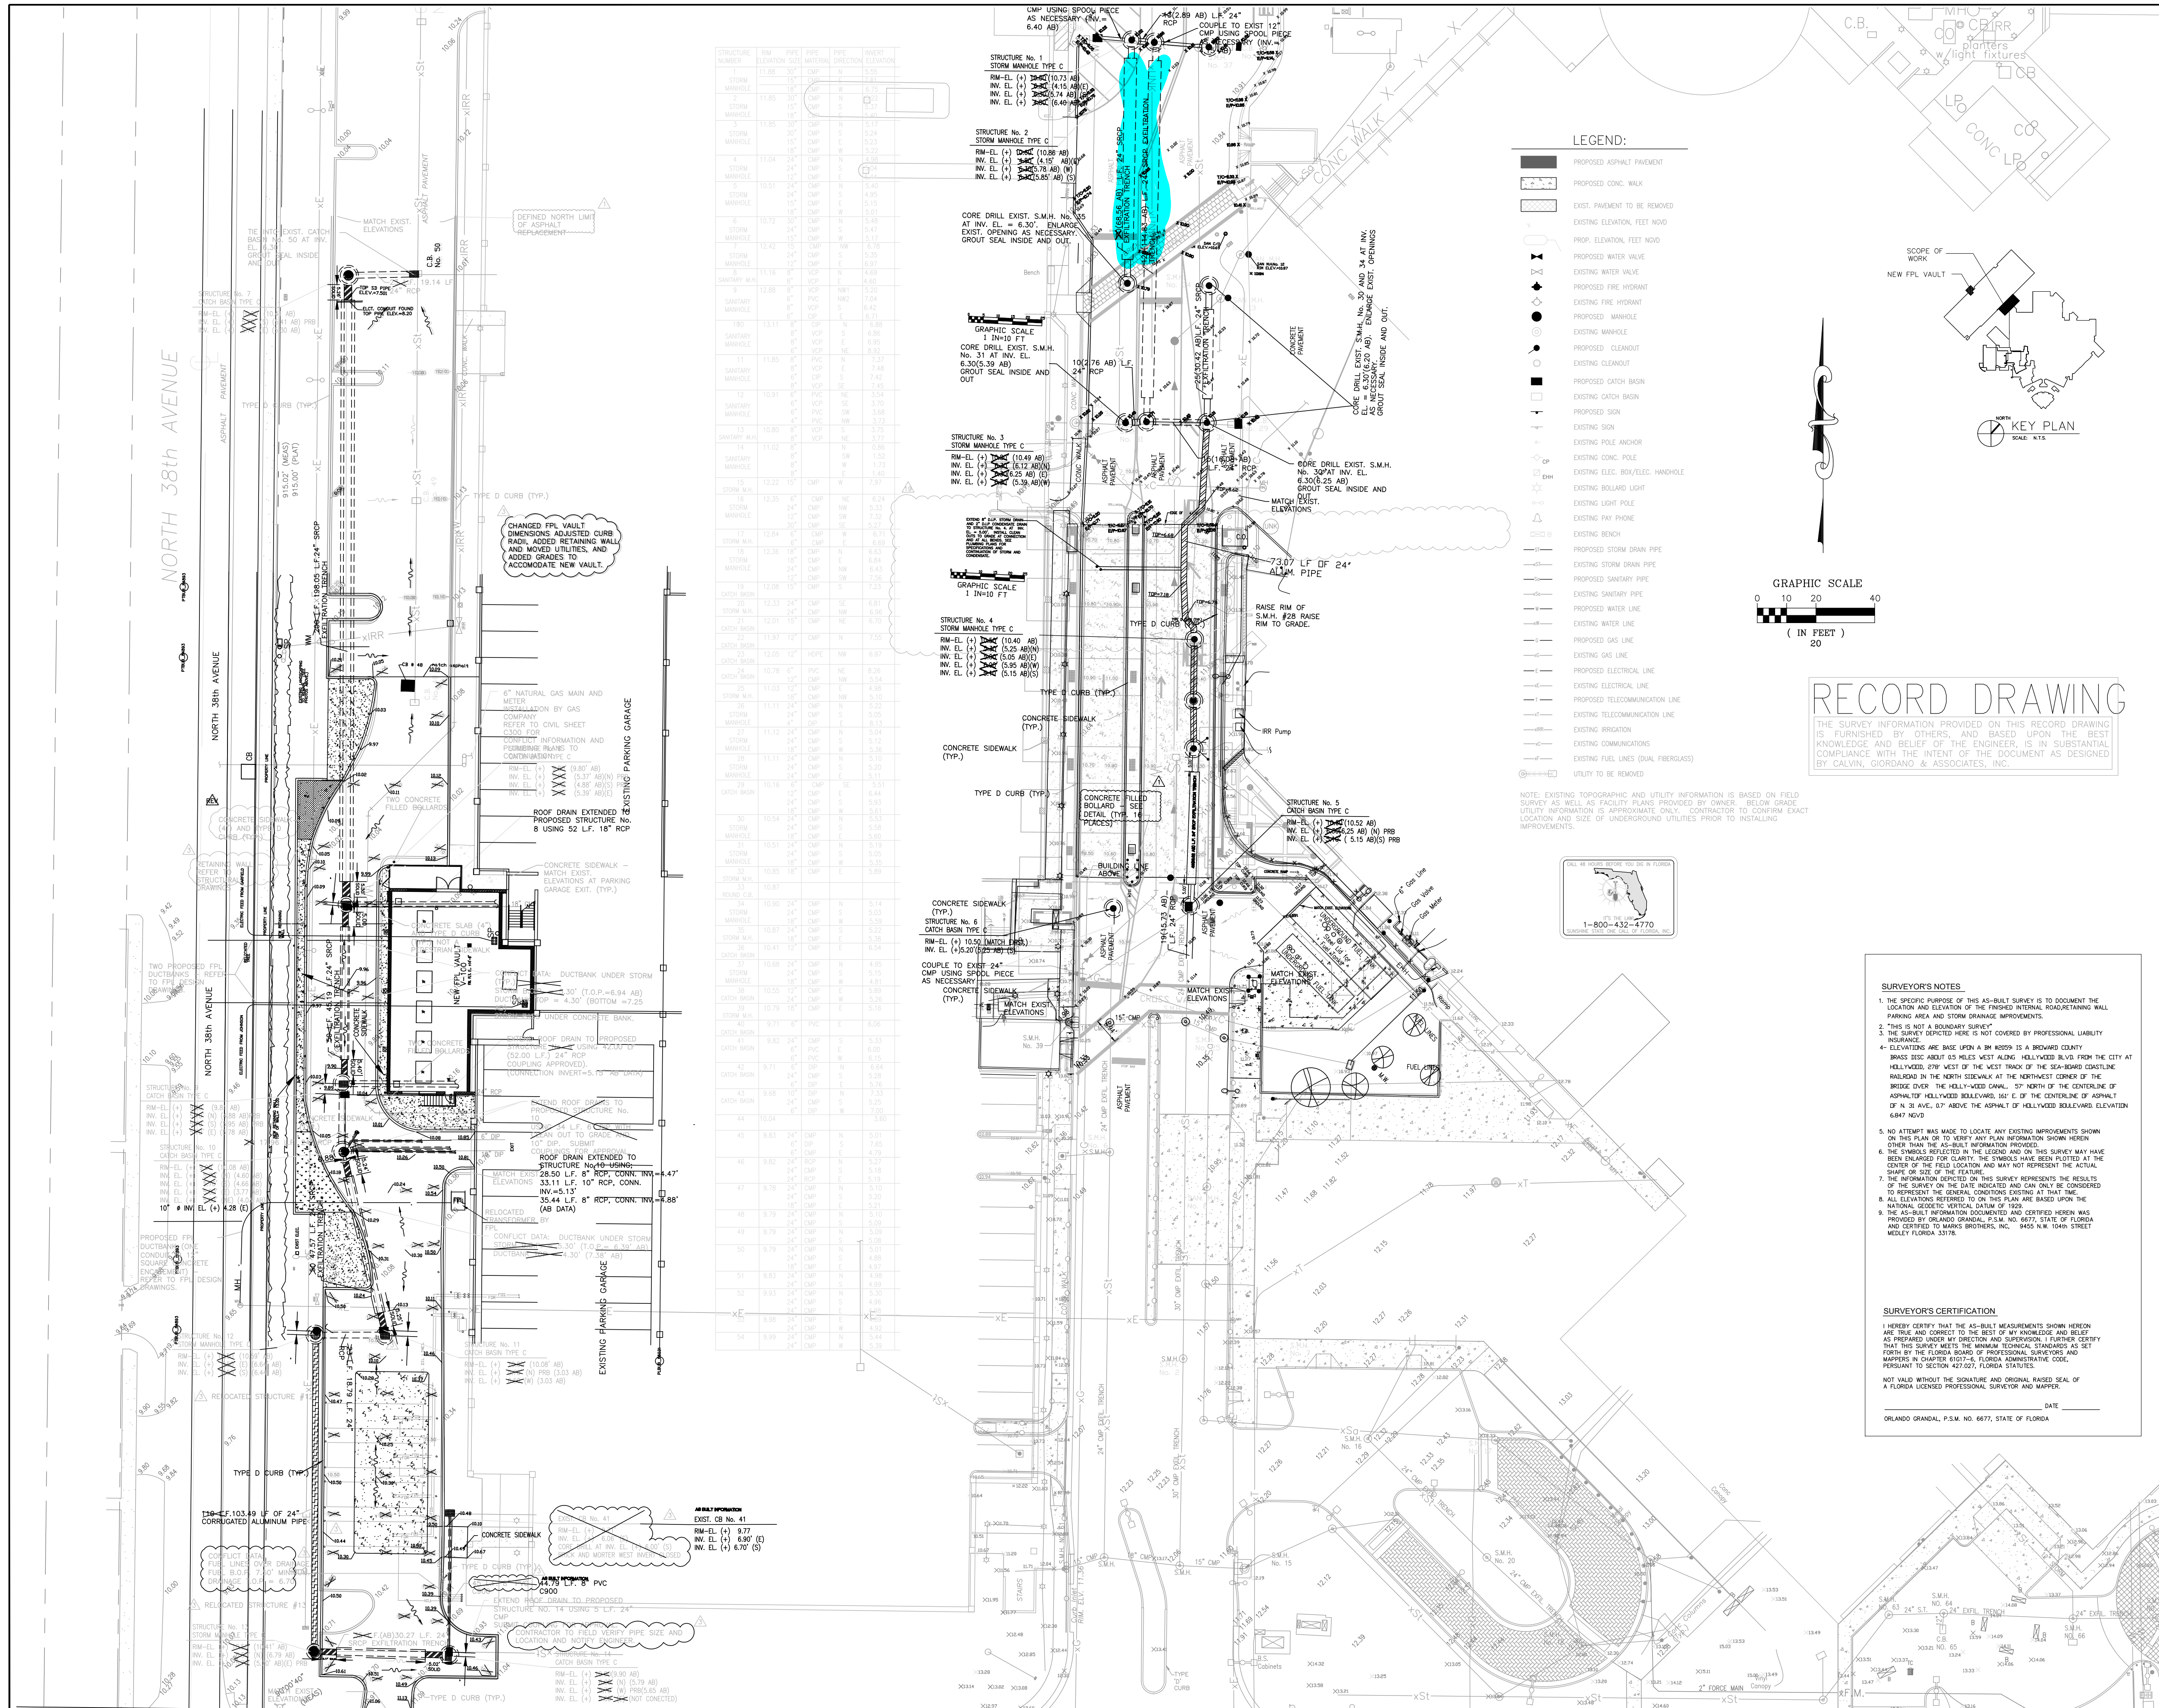

Design Services For  
The Built Environment

Nashville Fort Lauderdale  
Louisville Tampa Charlotte  
Jacksonville Indianapolis  
Dallas Columbus Atlanta  
Richmond Birmingham

**GRESHAM  
SMITH AND  
PARTNERS**

6030 Hollywood Blvd., Suite 210  
Hollywood, FL 33024  
Phone: 954-961-0100  
Fax: 954-961-0164  
WWW.GS&P.COM

Firm Certification Numbers  
AAP-000468500560

**SSR**

Smith Seckman Reid, Inc.  
CONSULTING  
ENGINEERS

600 N. Hillboro Blvd., Suite 300  
Deerfield Beach, FL 33441  
(954) 421-1260  
http://www.ssr-inc.com  
Firm Certification - EB-0000557  
Alfred Esquivel PE #5563  
John E. Moulder PE #3220  
SSR Job # 0420703

**BRILL RODRIGUEZ SALAS**  
REGISTERED PROFESSIONAL ENGINEER  
P.E. No. 0000553  
P.L.A. No. 0000553  
P.A.C. No. 0000553  
P.A.C. No. 0000553

**LUIS M. RODRIGUEZ PE No. 22132**

**Memorial  
Healthcare System  
Memorial Regional Hospital  
CENTRAL ENERGY PLANT  
PHASE 1**

3501 JOHNSON STREET HOLLYWOOD, FLORIDA 33021

JONATHAN N. COOPER, P.E. 09/15/06  
PROFESSIONAL ENGINEER #45140  
CERTIFICATE OF AUTHORIZATION #514

NO.	REVISION	DATE

PAVING AND DRAINAGE PLAN

**C200**

PROJECT: 24380-00  
DATE: MARCH 31, 2006  
ARC# 23190638-144

**RECORD DRAWING**

THE SURVEY INFORMATION PROVIDED ON THIS RECORD DRAWING IS FURNISHED BY OTHERS, AND BASED UPON THE BEST KNOWLEDGE AND BELIEF OF THE ENGINEER, IS IN SUBSTANTIAL COMPLIANCE WITH THE INTENT OF THE DOCUMENT AS DESIGNED BY CALVIN, GIORDANO & ASSOCIATES, INC.

**SURVEYOR'S NOTES**

1. THE SPECIFIC PURPOSE OF THIS AS-BUILT SURVEY IS TO DOCUMENT THE LOCATION AND ELEVATION OF THE PROPOSED INTERNAL ROAD/RETAINING WALL PARKING AREA AND STORM DRAINAGE IMPROVEMENTS.
2. THIS IS NOT A BOUNDARY SURVEY.
3. THE SURVEY CONDUCTED HEREIN IS NOT COVERED BY PROFESSIONAL LIABILITY INSURANCE.

5. NO ATTEMPT WAS MADE TO LOCATE ANY EXISTING IMPROVEMENTS SHOWN ON THIS PLAN OR TO VERIFY ANY PLAN INFORMATION SHOWN HEREIN OTHER THAN THE BEST AVAILABLE INFORMATION PROVIDED.
6. THE SYMBOLS REFLECTED IN THE LEGEND AND ON THIS SURVEY MAY HAVE BEEN CHANGED FOR CLARITY. THE SYMBOLS HAVE BEEN PLOTTED AT THE CENTER OF THE FIELD LOCATION AND MAY NOT REPRESENT THE ACTUAL SHAPE OR SIZE OF THE FEATURE.
7. THE INFORMATION DEPICTED ON THIS SURVEY REPRESENTS THE RESULTS OF THE SURVEY ON THE DATE INDICATED AND CAN ONLY BE CONSIDERED TO REPRESENT THE GENERAL CONDITIONS EXISTING ON THAT DATE.
8. ALL ELEVATIONS REFERRED TO ON THIS PLAN ARE BASED UPON THE NATIONAL GEODESIC DATUM OF 1983.
9. THE AS-BUILT INFORMATION DOCUMENTED AND CERTIFIED HEREIN WAS PROVIDED BY ORLANDO GRANDAL, P.E., NO. 9675, STATE OF FLORIDA, AND CERTIFIED TO MARIS BROTHERS, INC. 3455 N.W. 104th STREET MEELE, FLORIDA 33178.

**SURVEYOR'S CERTIFICATION**

I HEREBY CERTIFY THAT THE AS-BUILT MEASUREMENTS SHOWN HEREON ARE TRUE AND CORRECT TO THE BEST OF MY KNOWLEDGE AND BELIEF AS PREPARED UNDER MY DIRECTION AND SUPERVISION. I FURTHER CERTIFY THAT THE SURVEY MEETS THE MINIMUM TECHNICAL CRITERIA AS SET FORTH BY THE FLORIDA BOARD OF PROFESSIONAL SURVEYORS AND MAPPING AS CHARTER 95074-FL, FLORIDA ADMINISTRATIVE CODE, PURSUANT TO SECTION 427.027, FLORIDA STATUTES.

NOT VALID WITHOUT THE SIGNATURE AND ORIGINAL RAISED SEAL OF A FLORIDA LICENSED PROFESSIONAL SURVEYOR AND MAPPING.

DATE \_\_\_\_\_

ORLANDO GRANDAL, P.E. NO. 9675, STATE OF FLORIDA

## MEMORIAL REGIONAL HOSPITAL OR EXPANSION

### SWM1992-019-6 WATER QUALITY CALCULATIONS:

Permitted under Broward County Stormwater License No. SWM1992-019-6 the volume of first inch of runoff from the entire contributing area:

$$= 1.00 \text{ inch} \quad \times \quad 0.96 \text{ acres} \quad \times \quad (1 \text{ foot} / 12 \text{ inches})$$

$$= \mathbf{0.080 \text{ ac-ft for the first inch of runoff required of wet detention storage}}$$

The first inch of runoff from the entire developed site = **0.080 ac-ft**

**The volume permitted is 0.080 ac-ft**

### EXFILTRATION TRENCH CALCULATIONS

Design Formula:  $L = 2 * (0.5 * V_{wq} + V_{add}) / (K * (H_2 * W) + (2 * H_2 * D_u) - (D_u^2) + (2 * H_2 * D_s)) + (1.39 * 10^4 * W * D_u)$   
 Exfiltration Trench Section:

**0.50** Control Water Elevation (NAVD)

Weir Proposed:	<b>No</b>
Weir Elevation:	<b>0.00</b>
$V_{wq}$ = Water Quality Vol. to be Exfiltrated:	<b>0.96 ac-in</b>
W = Trench Width:	<b>6.00 ft.</b>
K = Hydraulic Conductivity:	<b>3.910E-04 cfs/sq-ft per ft head</b>
H <sub>2</sub> = Depth of Water Table:	<b>8.80 ft.</b>
D <sub>u</sub> = Non-Saturated Trench Depth:	<b>5.80 ft.</b>
D <sub>s</sub> = Saturated Trench Depth:	<b>0.00 ft.</b>
Total Exfiltration Trench Depth:	<b>5.80 ft.</b>

Exfiltration Trench Required (Quality):	<b><u>18 ft.</u></b>
Total Maximum Effective Exfiltration Trench Required:	<b><u>18 ft.</u></b>

Exfiltration Trench Provided:	<b><u>182 ft.</u></b>		Per SWM1992-019-6 As-built survey of record
-------------------------------	-----------------------	--	---

Storage/Treatment Volume Provided:

<b>Total Exfiltration Trench Detention Volume:</b>	<b><u>0.080 ac-ft</u></b>
(50% Volume in Pipes) + (50% Voids for length beyond maximum effective length):	<b><u>0.068 ac-ft</u></b>
<b>Total Storage Volume Provided in Exfiltration Trench</b>	<b><u>0.148 ac-ft</u></b>

Drainage Calculations  
For  
Broward County Resilient  
Environmental Department  
Memorial Regional Hospital OR Expansion  
3501 Jonhson St., Hollywood, FL 33021

CGA Project Number 215560

Prepared by:



Calvin, Giordano & Associates, Inc.

A SAFEBUILT COMPANY

---

James D. Messick, P.E.  
FLORIDA REGISTRATION No. 70870  
6/5/2024

## Table of Contents

---

Project Narrative  
Summary of Stage Calculations

### Section

I - Site Data

II - Design Criteria

III - Computations

- A. Quality
- B. SCS Curve Number
- C. Soil Storage
- D. Surface Storage
- E. Stage-Storage

IV - Supporting Documentation

- A. Exfiltration Computations
- B. Pipe Storage
- C. Trench Storage
- D. Structure Storage
- E. Exfiltration Credit

Project Name: Memorial Regional Hospital OR Expansion  
 Project Number: 215560

Designed:	SRS
Checked:	JDM

**I. Site Data**

	Pre	Post
<b>A. Acreage</b>		
<b>Total</b>	5.60	5.60 ac
<b>1. Impervious</b>		
a. Buildings (roofs)	1.04	1.49 ac
b. Pavement Areas (Roads, sidewalk, misc. impervious)	3.87	3.46 ac
c. Garage Ramp	0.28	0.28 ac
<b>Total Impervious</b>	5.18	5.22 ac
<b>3. Pervious</b>		
a. Landscape/ Grass	0.42	0.38 ac
<b>Total Pervious</b>	0.42	0.38 ac
<b>B. Minimum Elevations</b>		
1. Road Crown		11.39 ft-NAVD
2. Finished Floor		12.60 ft-NAVD
<b>C. Allowable Discharge</b>		
1. On-Site Retention		N/A CSM
<b>D. Water Level Elevation (per Broward County Future Conditions Map, Plate WM 2.2)</b>		
1. Wet season water table		1.50 ft-NAVD
2. Control elevation		1.50 ft-NAVD
3. Receiving body water level		N/A ft-NAVD
<b>E. Rainfall Amounts (per NOAA Atlas 14)</b>		
1. Exfiltration (5-year 1-Hour)		3.20 inches
2. Roadway (10-year 1-Day)		9.30 inches
3. Design Storm (25-year 3-Day)		14.41 inches
4. Finish Floor (100-year 3-Day)		19.37 inches

Project Name: Memorial Regional Hospital OR Expansion  
Project Number: 215560

Designed:	SRS
Checked:	JDM

## **II. Water Quality Design Criteria**

---

A. Water Quality Retention / Detention Criteria (Taken from Section 4.2, Environmental Resource Permit Applicants Handbook (AH) Vol. II (August 10, 2014. Refer to original document for further information.)

### **Volumetric Requirements (4.2.1)**

(a) Retention, detention or both retention and detention in the overall system, including swales, lakes, canals, greenways, etc., shall be provided for one of the three following criteria or equivalent combinations thereof:

1. Wet detention volume shall be provided for the first inch of runoff from the development project, or the total runoff of 2.5 inches times the percentage of imperviousness, whichever is greater.
2. Dry detention volume shall be provided equal to 75 % of the above amounts computed for wet detention.
3. Retention volume shall be provided equal to 50 % of the above amounts computed for wet detention. Retention volume included in flood protection calculations requires a guarantee of long term operation and maintenance of the system bleed-down ability. Examples of such guarantee include evidence of excellent soil percolation rates, such as coastal ridge sands, or an operations entity which specifically reserves funds for operation maintenance and replacement..

b. Systems with inlets in grassed areas will be credited with up to 0.2 inches of required wet detention amount for the contributing areas. Full credit will be based on a ratio of 10:1 impervious area (paved or building area) to pervious area (i.e. the grassed area) with proportionately less credit granted for greater ratios.

### **Land Use and Coverage Criteria (4.2.2)**

(a) Commercial or industrial zoned projects shall provide at least 1/2 inch of dry detention, unless reasonable assurances can be offered that hazardous materials will not enter the project's surface water management system.

(b) Project having greater than 40% impervious area and which discharge directly to the following receiving waters shall provide at least 1/2 inch of dry detention or retention pretreatment as part of the required retention/detention.

(c) Water surface and roofed areas can be deducted from site areas only for water quality pervious/impervious calculations. The water surface area meeting dimensional criteria may also be subtracted from the total site area when making final water quality treatment calculations.



Project Name: Memorial Regional Hospital OR Expansion  
Project Number: 215560

Designed: 

SRS
-----

  
Checked: 

JDM
-----

### III. Computations

---

#### A. Water Quality Retention / Detention Criteria (Section 4.2, AH Vol. II - August 10, 2014)

##### **Volumetric Requirements (4.2.1)**

1. Wet detention volume shall be provided for the first inch of runoff from the developed project, or the total runoff of 2.5 inches times the percentage imperviousness, whichever is greater.

A. Compute the first inch of runoff from the developed project for wet detention:

$$\begin{aligned} &= 1 \text{ in} \times \text{Total Area} - \text{Lake Area} \times (1\text{ft}/12\text{in}) \\ &= 0.47 \text{ ac-ft. for the first inch of runoff} \end{aligned}$$

B. Compute 2.5 inches times the percentage of imperviousness for wet detention:

1. Site area for water quality pervious/impervious calculations only:

$$\begin{aligned} &= \text{Total Area} - \text{Roof Area} - \text{Lake Area} \times (1\text{ft}/12\text{in}) \\ &= 4.11 \text{ ac of site area for water quality pervious/impervious} \end{aligned}$$

2. Impervious area for water quality pervious/impervious calculation only:

$$\begin{aligned} &= (\text{site area for water quality pervious/impervious}) \times \text{pervious} \\ &= 3.74 \text{ ac of impervious area for water quality pervious/impervious} \end{aligned}$$

3. Percentage of imperviousness for water quality:

$$\begin{aligned} &= (\text{Impervious area for water quality}/\text{site area for water quality}) \times 100\% \\ &= 90.86 \text{ \% impervious} \end{aligned}$$

4. For 2.5 inches times the percentage impervious:

$$\begin{aligned} &= 2.5 \times \text{percent impervious} \\ &= 2.27 \text{ inches to be treated} \end{aligned}$$

5. Compute volume required for water quality detention:

$$\begin{aligned} &= \text{Inches to be treated} \times (\text{Total site} - \text{Lake}) \\ &= 0.78 \text{ ac-ft. for the 2.5 inches times the percentage imperviousness} \end{aligned}$$

6. Compare the first inch of runoff to 2.5 times the percentage imperviousness.

$$\begin{aligned} &0.78 \text{ ac-ft. for the 2.5 inches times the percentage imperviousness} \\ &0.47 \text{ ac-ft. for the first inch of runoff} \\ &0.78 \text{ ac-ft. of wet detention is required.} \end{aligned}$$

Project Name: Memorial Regional Hospital OR Expansion  
Project Number: 215560

Designed: 

SRS
-----

  
Checked: 

JDM
-----

### III. Computations

---

#### B. SCS Curve Number

1. The wet season water/control elevation and the control elevation 1.50 ft-NAVD
  
2. Average site finished grade - Refer to "Storage" tab.  
Weighted Site Grade = 11.97 ft-NAVD
  
3. Average depth to water table will be  
= Weighted site grade - average water table/control elevation  
= 10.47 ft
  
4. Soil type: Flatwoods
  
5. From the soil storage calculation sheet, inches of moisture stored under the pervious areas for this type of soil is: 6.75 inches
  
6. Compute available soil storage  
= Storage available X pervious area  
= 0.21 ac-ft available soil storage onsite
  
7. Convert available soil storage to site-wide moisture storage, S  
= Available soil storage onsite/site area  
= 0.45 inches of site-wide storage, S
  
6. SCS Curve Number, CN  
=  $1000/(S+10)$   
= 96 SCS Curve Number

Project Name: Memorial Regional Hospital OR Expansion  
 Project Number: 215560

Designed: SRS  
 Checked: JDM

**III. Computations**

C. Soil Storage

Depth to Water Table (feet)	Coastal (1)		Flatwoods (2)		Depressional (3)	
	Cumulative Water Storage (inches)	Compacted Water Storage (inches)	Cumulative Water Storage (inches)	Compacted Water Storage (inches)	Cumulative Water Storage (inches)	Compacted Water Storage (inches)
1	0.60	0.45	0.60	0.45	0.60	0.45
2	2.50	1.88	2.50	1.88	2.10	1.58
3	6.60	4.95	5.40	4.05	4.40	3.30
4*	10.90	8.18	9.00	6.75	6.80	5.10

(1) Sandy Soil 0-40" thick with water tables dropping below 40" - St. Lucie series is representative.

(2) Water tables 15"-40" - Immokalee series is representative

(3) Water tables above ground - 15" - Riviera and Pompano series are representative

\*4 feet is the maximum depth of percolation assumed possible in three days for any soil.

- A. From the calculation the average depth to the water table is 10.47 ft
- B. The Soil Type is Flatwoods (2)
- C. Assuming 25% compaction
- D. Inches of moisture stored under pervious area

Depth to Water Table (feet)	Compacted Water Storage (inches)
4.00	6.75
10.47	6.75
4.00	6.75

**III. Computations**

**D. Surface Storage (PRE)**

1. Assumptions


(weighted values)

Land Use	Start	End	Average	Area	AreaXAvg
Buildings (roofs)	11.03	12.57	11.80	1.04	12.26
Pavement Areas (Roads, sidewalk, misc. impervious)	10.12	11.52	10.82	3.87	41.82
Garage Ramp	11.93	20.67	16.30	0.28	4.55
Landscape/ Grass	10.62	11.52	11.07	0.42	4.61
	Total =			5.60	63.24
	Weighted Site Grade =				11.29

2. For Stage-Storage curve data, please refer to table attached.

3. Stage-Storage curve.

STAGE-STORAGE CURVE

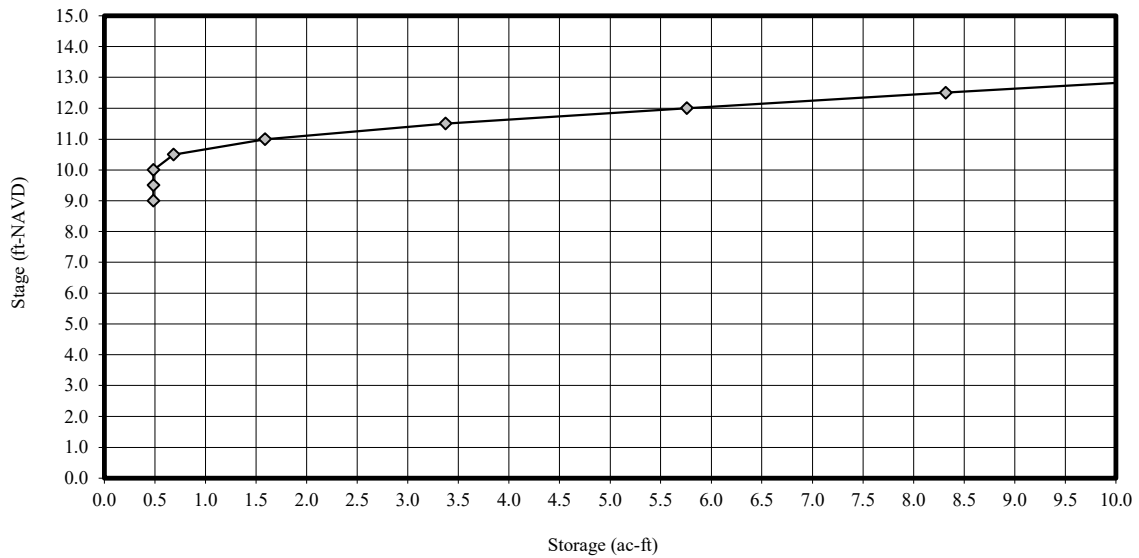

### III. Computations

#### D. Surface Storage (POST)


##### 1. Assumptions (weighted values)

Land Use	Start	End	Average	Area	AreaXAvg
Buildings (roofs)	12.57	12.60	12.59	1.49	18.73
Pavement Areas (Roads, sidewalk, misc. impervious)	10.39	12.58	11.48	3.46	39.70
Garage Ramp	11.93	20.67	16.30	0.28	4.55
Landscape/ Grass	10.65	11.00	10.83	0.38	4.07
		pr	Total =	5.60	67.04
			Weighted Site Grade =		11.97

2. For Stage-Storage curve data, please refer to table attached.

3. Stage-Storage curve.

STAGE-STORAGE CURVE

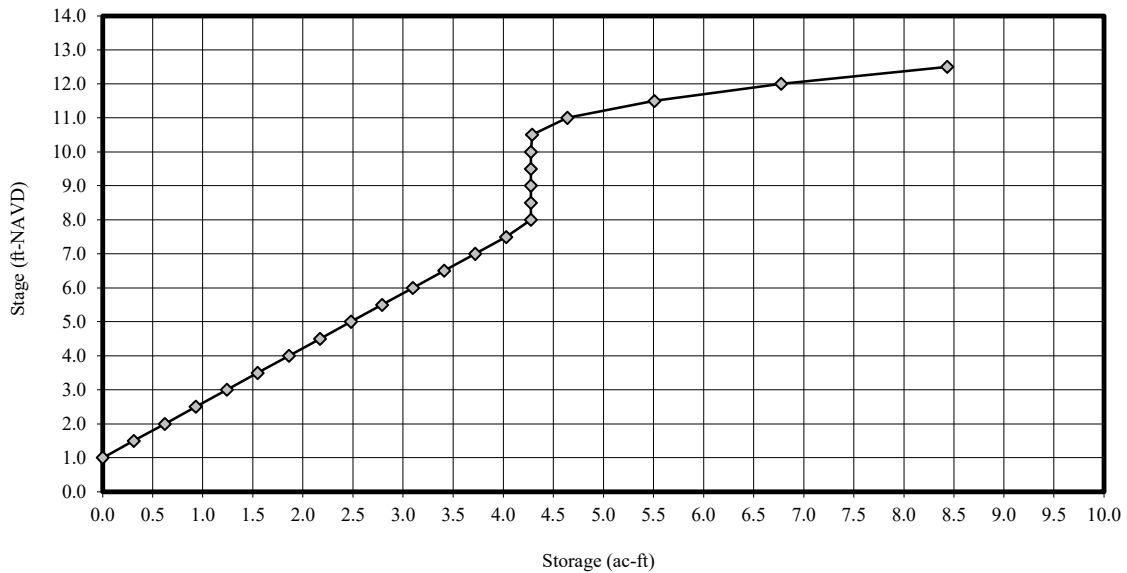

Project Name: Memorial Regional Hospital OR Expansion  
 Project Number: 215560

Designed: SRS  
 Checked: JDM

**III. Computations**

E. Stage-Storage (PRE)

**Stage-Storage Curve Data**

Area (ac)	1.04	3.87	0.28	0.00	0.00	0.00	0.00	0.00	0.00	0.00	0.42	0.00	N/A	N/A	
Start (ft-NAVD)	11.03	10.12	11.93	9.30	0.00	0.00	0.00	0.00	0.00	0.00	10.62	8.90	0.00	0.00	
Ends (ft-NAVD)	12.57	11.52	20.67	9.35	0.00	0.00	0.00	0.00	0.00	0.00	11.52	9.20	0.00	0.00	
Difference	1.54	1.40	8.74	0.05	0.00	0.00	0.00	0.00	0.00	0.00	0.90	0.30	0.00	0.00	
Stage (ft-NAVD)	Buildings (roofs)	Pavement Areas (Roads, sidewalk, misc. impervious)	Garage Ramp	Sidewalk Site	Sidewalk Park	Wet detention	Wet detention slopes	Dry detention	Dry detention slopes	Landscape / Grass	Asphalt Swales	Trench Storage	Exfiltration Credit	Total	
9.00	0.00	0.00	0.00	0.00	0.00	0.00	0.00	0.00	0.00	0.00	0.00	0.49	0.00	0.49	
9.50	0.00	0.00	0.00	0.00	0.00	0.00	0.00	0.00	0.00	0.00	0.00	0.49	0.00	0.49	
10.00	0.00	0.00	0.00	0.00	0.00	0.00	0.00	0.00	0.00	0.00	0.00	0.49	0.00	0.49	
10.50	0.00	0.20	0.00	0.00	0.00	0.00	0.00	0.00	0.00	0.00	0.00	0.49	0.00	0.68	
11.00	0.00	1.07	0.00	0.00	0.00	0.00	0.00	0.00	0.00	0.03	0.00	0.49	0.00	1.59	
11.50	0.07	2.64	0.00	0.00	0.00	0.00	0.00	0.00	0.00	0.18	0.00	0.49	0.00	3.37	
12.00	0.32	4.57	0.00	0.00	0.00	0.00	0.00	0.00	0.00	0.39	0.00	0.49	0.00	5.76	
12.50	0.73	6.50	0.01	0.00	0.00	0.00	0.00	0.00	0.00	0.60	0.00	0.49	0.00	8.32	
13.00	1.25	8.43	0.02	0.00	0.00	0.00	0.00	0.00	0.00	0.80	0.00	0.49	0.00	10.99	
13.50	1.77	10.37	0.04	0.00	0.00	0.00	0.00	0.00	0.00	1.01	0.00	0.49	0.00	13.67	
14.00	2.29	12.30	0.07	0.00	0.00	0.00	0.00	0.00	0.00	1.22	0.00	0.49	0.00	16.36	

Project Name: Memorial Regional Hospital OR Expansion  
 Project Number: 215560

Designed: SRS  
 Checked: JDM

**III. Computations**

**E. Stage-Storage (POST)**

**Stage-Storage Curve Data**

Area (ac)	1.49	3.46	0.28	0.00	0.00	0.00	0.00	0.00	0.00	0.00	0.38	0.00	N/A	N/A	
Start (ft-NAVD)	12.57	10.39	11.93	9.30	0.00	0.00	0.00	0.00	0.00	0.00	10.65	8.90	-2.10	-2.10	
Ends (ft-NAVD)	12.60	12.58	20.67	9.35	0.00	0.00	0.00	0.00	0.00	0.00	11.00	9.20	8.40	8.40	
Difference	0.03	2.20	8.74	0.05	0.00	0.00	0.00	0.00	0.00	0.00	0.35	0.30	10.50	10.50	
Stage (ft-NAVD)	Buildings (roofs)	Pavement Areas (Roads, sidewalk, misc. impervious)	Garage Ramp	Sidewalk Site	Sidewalk Park	Wet detention	Wet detention slopes	Dry detention	Dry detention slopes	Landscape / Grass	Asphalt Swales	Trench Storage	Exfiltration Credit	Total	
1.00	0.00	0.00	0.00	0.00	0.00	0.00	0.00	0.00	0.00	0.00	0.00	0.00	0.00	0.00	
1.50	0.00	0.00	0.00	0.00	0.00	0.00	0.00	0.00	0.00	0.00	0.00	0.03	0.28	0.31	
2.00	0.00	0.00	0.00	0.00	0.00	0.00	0.00	0.00	0.00	0.00	0.00	0.06	0.56	0.62	
2.50	0.00	0.00	0.00	0.00	0.00	0.00	0.00	0.00	0.00	0.00	0.00	0.09	0.84	0.93	
3.00	0.00	0.00	0.00	0.00	0.00	0.00	0.00	0.00	0.00	0.00	0.00	0.13	1.11	1.24	
3.50	0.00	0.00	0.00	0.00	0.00	0.00	0.00	0.00	0.00	0.00	0.00	0.16	1.39	1.55	
4.00	0.00	0.00	0.00	0.00	0.00	0.00	0.00	0.00	0.00	0.00	0.00	0.19	1.67	1.86	
4.50	0.00	0.00	0.00	0.00	0.00	0.00	0.00	0.00	0.00	0.00	0.00	0.22	1.95	2.17	
5.00	0.00	0.00	0.00	0.00	0.00	0.00	0.00	0.00	0.00	0.00	0.00	0.25	2.23	2.48	
5.50	0.00	0.00	0.00	0.00	0.00	0.00	0.00	0.00	0.00	0.00	0.00	0.28	2.51	2.79	
6.00	0.00	0.00	0.00	0.00	0.00	0.00	0.00	0.00	0.00	0.00	0.00	0.31	2.79	3.10	
6.50	0.00	0.00	0.00	0.00	0.00	0.00	0.00	0.00	0.00	0.00	0.00	0.34	3.06	3.41	
7.00	0.00	0.00	0.00	0.00	0.00	0.00	0.00	0.00	0.00	0.00	0.00	0.38	3.34	3.72	
7.50	0.00	0.00	0.00	0.00	0.00	0.00	0.00	0.00	0.00	0.00	0.00	0.41	3.62	4.03	
8.00	0.00	0.00	0.00	0.00	0.00	0.00	0.00	0.00	0.00	0.00	0.00	0.43	3.84	4.28	
8.50	0.00	0.00	0.00	0.00	0.00	0.00	0.00	0.00	0.00	0.00	0.00	0.43	3.84	4.28	
9.00	0.00	0.00	0.00	0.00	0.00	0.00	0.00	0.00	0.00	0.00	0.00	0.43	3.84	4.28	
9.50	0.00	0.00	0.00	0.00	0.00	0.00	0.00	0.00	0.00	0.00	0.00	0.43	3.84	4.28	
10.00	0.00	0.00	0.00	0.00	0.00	0.00	0.00	0.00	0.00	0.00	0.00	0.43	3.84	4.28	
10.50	0.00	0.01	0.00	0.00	0.00	0.00	0.00	0.00	0.00	0.00	0.00	0.43	3.84	4.29	
11.00	0.00	0.30	0.00	0.00	0.00	0.00	0.00	0.00	0.00	0.07	0.00	0.43	3.84	4.64	
11.50	0.00	0.98	0.00	0.00	0.00	0.00	0.00	0.00	0.00	0.25	0.00	0.43	3.84	5.51	
12.00	0.00	2.05	0.00	0.00	0.00	0.00	0.00	0.00	0.00	0.44	0.00	0.43	3.84	6.77	
12.50	0.00	3.52	0.01	0.00	0.00	0.00	0.00	0.00	0.00	0.63	0.00	0.43	3.84	8.43	
13.00	0.74	5.25	0.02	0.00	0.00	0.00	0.00	0.00	0.00	0.82	0.00	0.43	3.84	11.11	

Project Name: Memorial Regional Hospital OR Expansion  
 Project Number: 215560

Designed: SRS  
 Checked: JDM

**IV. Flood Routing (PRE)**

**Design Storm Stages**

**A. Stage Summary**

Design Storm	Stage (ft)
10-Year 1-Day	11.65
5-Year 1-Hour	10.82
25-Year 72-Hour	12.14
100-Year 72-Hour	12.59

The following are zero discharge stages:

**B. Minimum Road Crown elevation**

- The rainfall of the 10-year 1-day storm = 9.30 inches
- Inches of runoff, Q =  $\frac{(P - 0.2 \times S)^2}{(P + (0.8 \times S))}$  = 8.78 inches of runoff
- Runoff Volume, V = Inches of runoff X Site area = 4.10 ac-ft runoff volume
- The zero-discharge stage corresponding to the volume of runoff = 11.65 feet, see table below

Stage (ft)	Storage (Ac-ft)
11.50	3.37
11.65	4.10
12.00	5.76

**C. Minimum Parking Lot Elevation (for informational purposes; not required)**

- The rainfall of the 5-year 1-hour storm = 3.20 inches
- Inches of runoff, Q =  $\frac{(P - 0.2 \times S)^2}{(P + (0.8 \times S))}$  = 2.71 inch of runoff
- Runoff Volume = Inches of runoff X Site area = 1.27 ac-ft runoff volume
- The zero-discharge stage corresponding to the volume of runoff = 10.82 feet, see table below

Stage (ft)	Storage (Ac-ft)
10.50	0.68
10.82	1.27
11.00	1.59



Project Name: Memorial Regional Hospital OR Expansion  
 Project Number: 215560

Designed: SRS  
 Checked: JDM

**D. Minimum Berm Elevation**

1. The rainfall of the 25-year 72-hour storm = 14.41 inches
2. Inches of runoff, Q =  $\frac{(P - 0.2 \times S)^2}{(P + (0.8 \times S))}$  = 13.88 inch of runoff
3. Runoff Volume = Inches of runoff X Site area = 6.48 ac-ft runoff volume
4. The zero-discharge stage corresponding to the volume of runoff = 12.14 feet, see table below

Stage (ft)	Storage (Ac-ft)
12.00	5.76
12.14	6.48
12.50	8.32

**E. Minimum Finished Floor**

1. The rainfall of the 100-year 72-hour storm = 19.37 inches
2. Inches of runoff, Q =  $\frac{(P - 0.2 \times S)^2}{(P + (0.8 \times S))}$  = 18.84 inch of runoff
3. Runoff Volume = Inches of runoff X Site area = 8.79 ac-ft runoff volume
4. The zero-discharge stage corresponding to the volume of runoff = 12.59 feet, see table below

Stage (ft)	Storage (Ac-ft)
12.50	8.32
12.59	8.79
13.00	10.99

Project Name: Memorial Regional Hospital OR Expansion  
 Project Number: 215560

Designed: SRS  
 Checked: JDM

**IV. Flood Routing (POST)**

**Design Storm Stages**

**A. Stage Summary**

Design Storm	Stage (ft)
10-Year 1-Day	7.63
5-Year 1-Hour	3.04
25-Year 72-Hour	11.88
100-Year 72-Hour	12.57

The following are zero discharge stages:

**B. Minimum Road Crown elevation**

- The rainfall of the 10-year 1-day storm = 9.30 inches
- Inches of runoff, Q =  $\frac{(P - 0.2 \times S)^2}{(P + (0.8 \times S))}$  = 8.78 inches of runoff
- Runoff Volume, V = Inches of runoff X Site area = 4.10 ac-ft runoff volume
- The zero-discharge stage corresponding to the volume of runoff = 7.63 feet, see table below

Stage (ft)	Storage (Ac-ft)
7.50	4.03
7.63	4.10
8.00	4.28

**C. Minimum Inlet Grate Elevation**

- The rainfall of the 5-year 1-hour storm = 3.20 inches
- Inches of runoff, Q =  $\frac{(P - 0.2 \times S)^2}{(P + (0.8 \times S))}$  = 2.71 inch of runoff
- Runoff Volume = Inches of runoff X Site area = 1.27 ac-ft runoff volume
- The zero-discharge stage corresponding to the volume of runoff = 3.04 feet, see table below

Stage (ft)	Storage (Ac-ft)
3.00	1.24
3.04	1.27
3.50	1.55

Project Name: Memorial Regional Hospital OR Expansion  
 Project Number: 215560

Designed: SRS  
 Checked: JDM

**D. Minimum Berm Elevation (for informational purposes; not required)**

1. The rainfall of the 25-year 72-hour storm = 14.41 inches
2. Inches of runoff, Q =  $\frac{(P - 0.2 \times S)^2}{(P + (0.8 \times S))}$  = 13.88 inches of runoff
3. Runoff Volume, V = Inches of runoff X Site area = 6.48 ac-ft runoff volume
4. The zero-discharge stage corresponding to the volume of runoff = 11.88 feet, see table below

Stage (ft)	Storage (Ac-ft)
11.50	5.51
11.88	6.48
12.00	6.77

**E. Minimum Finished Floor**

1. The rainfall of the 100-year 72-hour storm = 19.37 inches
2. Inches of runoff, Q =  $\frac{(P - 0.2 \times S)^2}{(P + (0.8 \times S))}$  = 18.84 inch of runoff
3. Runoff Volume = Inches of runoff X Site area = 8.79 ac-ft runoff volume
4. The zero-discharge stage corresponding to the volume of runoff = 12.57 feet, see table below

Stage (ft)	Storage (Ac-ft)
12.50	8.43
12.57	8.79
13.00	11.11

**V. Supporting Documentation**

**A. Exfiltration Computations**

Exfiltration Parameters		Hydraulic Conductivity	
		(See SWM 1992-019-6 Permit)	
Catch Basin Grate Elevation	10.40 ft-NAVD	K1	1.43E-03 cfs/ft <sup>2</sup> -ft Head
Minimum Cover Required	24 Inches	K2	3.91E-04 cfs/ft <sup>2</sup> -ft Head
Top of Trench Elevation	8.40 ft-NAVD	K3	4.90E-05 cfs/ft <sup>2</sup> -ft Head
Control Structure Weir Elevation	-- ft-NAVD	K4	cfs/ft <sup>2</sup> -ft Head
Pipe Invert	2.50 ft-NAVD	K5	cfs/ft <sup>2</sup> -ft Head
Pipe Diameter	24.00 Inches	K6	cfs/ft <sup>2</sup> -ft Head
Control Elevation	1.50 ft-NAVD	K7	cfs/ft <sup>2</sup> -ft Head
Top of Pipe Elevation	4.50 ft-NAVD	K8	cfs/ft <sup>2</sup> -ft Head
Minimum Pipe Cover	5.90 ft	K9	cfs/ft <sup>2</sup> -ft Head
Depth to Water Table H <sub>2</sub>	8.90 ft	K10	cfs/ft <sup>2</sup> -ft Head
Non-Saturated Depth D <sub>u</sub>	6.90 ft	K11	cfs/ft <sup>2</sup> -ft Head
Saturated Trench Depth D <sub>s</sub>	3.60 ft	K12	cfs/ft <sup>2</sup> -ft Head
Trench Width W	10.00 ft		
Bottom of Trench Elevation	-2.10 ft-NAVD		
Trench Depth	10.50 ft		
		Average K = 6.23E-04 cfs/ft <sup>2</sup> -ft Head	

A) Exfiltration Quality Volume for Water Quality, Vwq = 0.78 acre-feet (Refer to Quality calculations.) X 12 inches /ft = 9.34 acre-inches

% WQ = 50% for dry retention  
 FS = 2.0

$$*L_1 = FS (\%WQ)(Vwq) / [(K * ((H_2 * W) + (2 * H_2 * Du) - (Du^2) + (2 * H_2 * D_s))) + (1.39 * 10^{-4} * W * Du)]$$

\*For use when Saturated Depth is less than or equal to Non-Saturated Depth, and when Trench Width is less than or equal to two times Trench Depth.

Required Length (L<sub>1</sub>) = 61 ft

$$**L_2 = FS (\%WQ)(Vwq) / [(K * ((2 * H_2 * Du) - (Du^2) + (2 * H_2 * D_s))) + (1.39 * 10^{-4} * W * Du)]$$

\*\*For use when Saturated Depth is greater than Non-Saturated Depth, or when Trench Width is greater than two times Trench Depth.

Required Length (L<sub>2</sub>) = 108 ft

Required Length (Either L<sub>1</sub> or L<sub>2</sub>) Based on Trench Dimensions = 61 ft

Provided Length = 61 ft or 0.78 Acre-ft of exfiltration

B) Exfiltration Quantity Volume Provided by Additional Length of Trench =

Provided Additional Length = 485 ft or 3.07 Acre-ft of exfiltration

C) Total Length of Exfiltration Trench Provided = 546 ft or 3.84 Acre-ft of exfiltration

Project Name: Memorial Regional Hospital OR Expansion  
 Project Number: 215560

Designed: SRS  
 Checked: JDM

**V. Supporting Documentation**

---

**C. Trench Storage**

Trench Depth Du (ft) *1	Trench Width W (ft)	Trench Length L (ft)	Stage (ft-NAVD)	Increment (ft)	Trench Area (sf) / 2	Trench Volume (cf)	Storage Volume (ac-ft)
6.90	10.00	546	1.50	0.00	0.00	0.00	0.00
			2.00	0.50	2.50	1365.00	0.03
			2.50	1.00	5.00	2730.00	0.06
			3.00	1.50	7.50	4095.00	0.09
			3.50	2.00	10.00	5460.00	0.13
			4.00	2.50	12.50	6825.00	0.16
			4.50	3.00	15.00	8190.00	0.19
			5.00	3.50	17.50	9555.00	0.22
			5.50	4.00	20.00	10920.00	0.25
			6.00	4.50	22.50	12285.00	0.28
			6.50	5.00	25.00	13650.00	0.31
			7.00	5.50	27.50	15015.00	0.34
			7.50	6.00	30.00	16380.00	0.38
			8.00	6.50	32.50	17745.00	0.41
			8.50	6.90	34.50	18837.00	0.43
			9.00	6.90	34.50	18837.00	0.43
			9.50	6.90	34.50	18837.00	0.43
			10.00	6.90	34.50	18837.00	0.43
			10.50	6.90	34.50	18837.00	0.43
			11.00	6.90	34.50	18837.00	0.43
			11.50	6.90	34.50	18837.00	0.43
			12.00	6.90	34.50	18837.00	0.43
			12.50	6.90	34.50	18837.00	0.43
			13.00	6.90	34.50	18837.00	0.43
			13.50	6.90	34.50	18837.00	0.43
			14.00	6.90	34.50	18837.00	0.43

1: Refer to exfiltration calculation.  
 2: Area is calculated at 50% POROSITY.

Project Name: Memorial Regional Hospital OR Expansion  
 Project Number: Mar-90

Designed:	SRS
Checked:	JDM

**V. Supporting Documentation**

---

**D. Exfiltration Credit**

Trench Depth Du (ft)	5-year 1-hour Rainfall (inches) *	Site Exfiltration (ac-ft)	Stage (ft-NAVD)	Saturation Increment (ft)	Exfiltration Volume (ac-ft)
6.90	3.20	3.84	1.00	0.00	0.00
			1.50	0.50	0.28
			2.00	1.00	0.56
			2.50	1.50	0.84
			3.00	2.00	1.11
			3.50	2.50	1.39
			4.00	3.00	1.67
			4.50	3.50	1.95
			5.00	4.00	2.23
			5.50	4.50	2.51
			6.00	5.00	2.79
			6.50	5.50	3.06
			7.00	6.00	3.34
			7.50	6.50	3.62
			8.00	6.90	3.84
			8.50	6.90	3.84
			9.00	6.90	3.84
			9.50	6.90	3.84
			10.00	6.90	3.84
			10.50	6.90	3.84
			11.00	6.90	3.84
			11.50	6.90	3.84
			12.00	6.90	3.84
			12.50	6.90	3.84
			13.00	6.90	3.84